



ARABIAN INDUSTRIAL FIBERS COMPANY

IR-II AROMATICS PROJECT

PROJECT NO. 10E0541A01

DOCUMENT TITLE:

REFORMATE FEED TANK DATA SHEET

DOCUMENT NO:

DS-56-FA-501

						ابن رشيد ibn rushid	ARABIAN INDUSTRIAL FIBERS COMPANY YANBU, KINGDOM OF SAUDI ARABIA	 CTCI CORPORATION
						CERTIFIED		
2	Revised as Marked	LSH	SYL	YSL	22-Apr-11	PROJ.		
1	Issued for Design	LSH	SYL	YSL	22-Apr-11	MGR	DATE	
0	Issue For Approval	LSH	SYL	YSL	23-Mar-11	CLIENT	DATE	
REV	DESCRIPTION	BY	CHK.	APPR.	DATE	PAGE 1 OF 2		XC32C-56-501

CONTENTS

<u>ITEM</u>	<u>EQUIPMENT NO.</u>	<u>SHEET NO.</u>	<u>REV. NO.</u>	<u>REV. DATE</u>
1.	56-F-01	1 THRU 3 OF 3	2	09-Aug-2011

Attachment total 7 pages.

ابن رشيد
ibn rushd

STORAGE TANK DATASHEET

Contract: 10E0541A01
Equip. No.: 56-F-01
Revision : 2 Date: 09-Aug-2011
Unit : 56 - Sulfolane
P.O. No.:
Document No. : DS-56-FA-501
Sheet 1 of 3

سابك
SABIC




CTCI CORPORATION

REV

Client: Arabian Industrial Fibers Company
Service: Reformate Feed Tank
Plant: Sulfolane
Site: Yanbu, Kingdom of Saudi Arabia

DESIGN SKETCH

VESSEL DIMENSIONS: ID: 34200 T/T: 18000 QTY: 1

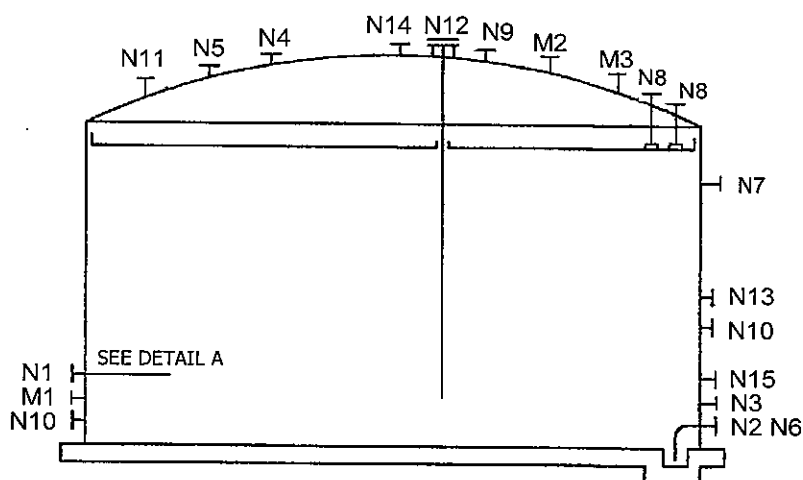

DESIGN CONDITIONS

Pressure:	254.0	mmH2O(g)
At:	85	°C
Vacuum:	100.0	mmH2O(g)
At:	°C	
Min. Design Metal Temp:	Existing (Note 10)	°C
At:	bar(g)	
Liquid Level:		mm
Specific Gravity of Liquid:	0.762	
At:	15	°C

CONSTRUCTION

MATERIALS	CORROSION ALLOWANCE
Roof: C.S.	NONE mm
Shell: C.S.	1.5 mm
Internal:	mm

OPERATING CONDITIONS

Fluid:	Aromatic Hydrocarbon	
Pressure + :	12.7	mmH2O(g)
At:	50	°C
Vacuum - :		mmH2O(g)
At:		°C
Low Temperature:		°C
At:		mmH2O(g)
Hydrogen Partial Pressure:		mmH2O(g)
At:		°C

NOTES & SPECIAL CONDITIONS

Roof Type:	Internal Floating Roof
Stress Relieve (Process Reason Only):	-
Earthquake Design:	-
Roof Tie Rods:	-
Seismic Zone:	-
Essential Facilities Factor:	-
Site Amplification Factor:	-
Zone Coefficient:	-
Roof Tie Rods:	-

INSULATION

Type:	
Req'd Thickness:	
Fireproofing:	

STORAGE TANK
DATASHEET

Contract: 10E0541A01
Equip. No.: 56-F-01
Revision : 2 Date: 09-Aug-2011
Unit : 56 - Sulfolane
P.O. No.:
Document No. : DS-56-FA-501
Sheet 2 of 3



NOZZLE SCHEDULE

TAG	QTY	SIZE in	PRESSURE RATING	DESCRIPTION
M1	2	24	150#RF	Shell Manhole
M2	1	24	150#RF	Roof Manhole
M3	1	36	150#RF	Roof Manhole
N1	1	10	150#RF	Filling Nozzle
N2	1	4	150#RF	Spare Nozzle
N3	1	1	150#RF	Temperature Indicator Nozzle
N4	1	1	150#RF	Gas Blanketing Nozzle
N5	1	4	150#RF	Gas Blanketing Nozzle
N6	1	4	150#RF	Drain Nozzle W/ Sump
N7	9	2 1/2	150#RF	Foam Nozzle
N8	2	1 1/2	150#RF	Level Indicator
N9	1	8	150#RF	Pressure / Vacuum Vent (Note 6)
N10	1	4	150#RF	Filling Nozzle
N11	1	20	150#RF	Emergency Vent
N12	1	8	150#RF	Gauge Hatch W/6" Slot Dipping Device
N13	1	4	150#RF	Spare Nozzle
N14	1	2	150#RF	Gas Transfer Nozzle
N15	1	10	150#RF	Suction Nozzle

NOTES:

- Formerly Aromatics Storage Tank, 58-F-02.
- Locating filling and suction nozzles 180° apart to allow sufficient residence time for water settling and thermal equilibrium.
- Flash point = -17°C.
- Nominal Capacity = 16500 m³, Working Capacity = 14238 m³.
- Pump In Rate = 308.9 (m³/h) & Pump Out Rate = 255 (m³/h).
- CTCI shall confirm PSV nozzle size.
- Vapor Pressure : 0.496 bar(a) @ 38°C
- Support shall be confirmed by manufacturer.
- Liquid level: HHLL: 16500 mm HLL: 14400 mm, LLL: 3600mm, LLLL: 1000mm.
- The Min. Design Ambient Temperature should be 6 °C.
- Dimensions are in millimeter unless otherwise noted.
- Add 10" new nozzle N15 for pump suction.
- Limit the inlet velocity to 3 ft/s(1 m/s) until inlet pipe is submerged. Add new distributor at N1 nozzle as detail A.
- Add new one (1) N8 nozzle.
- Existing design pressure : 254 mmH₂O(g)@85°C, New design condition : same as existing.

1

2

2

1

1

1



SPECIFICATION

FOR

58-F-01 A, B
58-F-02

FOR CONSTRUCTION

ALL RIGHTS RESERVED
THIS DOCUMENT AND ANY DATA AND INFORMATION CONTAINED THEREIN ARE CONFIDENTIAL AND THE PROPERTY OF CHIYODA CORPORATION. NO PART OF THIS DOCUMENT, DATA OR INFORMATION SHALL BE REPRODUCED OR TRANSMITTED IN ANY FORM OR BY ANY MEANS, ELECTRONIC OR MECHANICAL, INCLUDING PHOTOCOPYING, RECORDING, OR BY ANY INFORMATION STORAGE AND RETRIEVAL SYSTEM, WITHOUT THE WRITTEN PERMISSION OF CHIYODA CORPORATION.

◇					
◇					
◇					
◇	As per ACL-185	K. Harada	M	1 Aug '91	
MARK	DESCRIPTION	BY	CHKD	APVD	DATE
REVISIONS					
CLIENT :	ARABIAN INDUSTRIAL FIBERS COMPANY (IBN RUSHD)			APVD	M. Deyla
PROJECT TITLE:	IBN RUSHD PTA & AROMATICS PROJECT - AROMATICS			CHKD	
JOB NO. :	51046			MADE	K. Harada
DOC NO. :	SP-58-F-001 (/)			DATE	22 Apr. '96

**UOP**

25 East Algonquin Road - PO Box 5017 - Des Plaines, Illinois 60017-5017 - USA

CTCI CORPORATION

PROJECT SPECIFICATION

560696 - 306 - 1 SHEET 1

ATMOSPHERIC STORAGE TANKS

REV	DATE	BY	APPD	REV	DATE	BY	APPD
0	4/10/75	SAW					
1	5/15/75	SAW	NK				

Benzene/Toluene Fractionation Unit

Item Number	Service	Sheet
	References	2
	General Notes	2
	Specific Notes	3
F-5801A,B 58-F-01A,B	Benzene Day Tank	4
F-5802 58-F-02	Aromatics Storage Tank	5

NOTE - These data are confidential and the property of UOP and shall not be disclosed to others or reproduced in any manner or used for any purpose whatsoever except by written permission or as provided in a signed agreement with UOP relating to such data.

- ① This equipment shall be designed and constructed in accordance with the following UOP Standard Specifications: 3-16-3, 7-11-0, 9-11-1, 9-16-1



uop

25 East Algonquin Road • PO Box 5017 • Des Plaines, Illinois 60017-5017 • USA

CTCI CORPORATION

PROJECT SPECIFICATION

560696 - 306 - 1 SHEET 2

REV	DATE	BY	APPD	REV	DATE	BY	APPD
0	4/10/95						
1	5/15/95	SMW	NK				

ATMOSPHERIC STORAGE TANKS

I. References

- A. UOP Standard Specification 3-16 Storage Tanks Atmospheric
- B. UOP Standard Specification 7-11 Electrical (For Tank Grounding)
- C. UOP Standard Specification 9-11 External Thermal Insulation
- D. UOP Standard Specification 9-16 Painting
- E. UOP Standard Specification 9-21 Fire Protection
- F. API 650 Welded Steel for Oil Storage

◇ Tanks

II. General Notes

- A. Tanks shall be designed, fabricated and tested in accordance with the above references, except as modified in this specification.

◇ Deleted

- B. ~~Alternate tank sizing may be offered if a cost saving to the owner can be demonstrated. Nominal tank capacity must be maintained. Any alternate must be approved by the owner.~~

- C. ~~Alternate dome or umbrella roof may be offered in place of cone roof, where feasible, and where a cost saving to the owner can be demonstrated. Nominal tank capacity must be maintained. Any alternate must be approved by the owner.~~

◇ Deleted

- D. All tanks shall be grounded.

- E. See Project Specification 614 included under same project number as this specification for level gauges that will be used and furnished by others.

- F. Where gas blanketing is used see Project Specification 617 included under same project number as this specification for gas blanketing control valves that will be used and furnished by others.

- G. Where propeller type tank mixers are required see Project Specification 316 included under same project number as this specification for the mixer that will be provided and furnished by others.

- H. Where tank heaters are required see Project Specification 318 included under same project number as this specification for the type of heater that will be used and furnished by others.

- I. All connections shall be flanged.

- J. Working capacity must be maintained.

- ① K. Fixed roof tank and internal floating roof tanks shall be provided with a subsurface or semi-fixed foam injection system, type II discharge outlet, suitable foam maker, and connecting piping. Piping terminates outside the tank dike walls.

◇ (For the Type II, refer to the attached Figure A-1-4 (P) of NFPA 11.)

NOTE - These data are confidential and the property of UOP and shall not be disclosed to others or reproduced in any manner or used for any purpose whatsoever except by written permission or as provided in a signed agreement with UOP relating to such data.

Rev. 1
3/85

509308

7-2



CTCI CORPORATION

UOP

25 East Algonquin Road • PO Box 5017 • Des Plaines, Illinois 60017-5017 • USA

PROJECT SPECIFICATION

560696 - 306 0 SHEET 3

ATMOSPHERIC STORAGE TANKS

REV	DATE	BY	APPD	REV	DATE	BY	APPD
0	4/10/75						

III. Specific Notes (See Specific Tank Sheets for Notes that Apply)

1. Filling and suction nozzles to be located 180 degrees apart to allow sufficient residence time for water settling and thermal equilibrium.
2. Provide one 4 inch gas tight gauging and sampling device including all necessary accessories, to permit gauging and sampling without venting gas to atmosphere.
3. Tank shall be designed with a frangible joint ^{per API-650} and an emergency manhole cover ^{with}.
4. The tank shell thickness shall be calculated in accordance with the applicable requirements of API 650 using the minimum corrosion allowance as 1/16 inch (1.5 mm) for all rings. The minimum corrosion allowance used shall be 1/16 inch (1.5 mm) for the tank bottoms.
5. Inlet velocity shall be limited to three feet per second (one meter per second) until inlet pipe is submerged. Inlet distributors may have to be added to limit the inlet velocity.
6. The filling rate and the pumpout rate are based on maximum rates. The contractor shall design the venting system based on 1.5 times the filling/pumpout rates shown. The contractor shall adjust the pumpout rate to account for the flow rate that occurs when the tank is drained.
7. The tanks shall be furnished with an internal floating roof as per API Standard 650 "Welded Steel Tanks for Oil Storage" Appendix H. Each internal floating roof shall be equipped with a liquid mounted primary seal, a wiper type secondary seal made of a resilient material and gasketed fittings. The tank will be gas blanketed and equipped with pressure/vacuum vents on all openings in outer shell of roof.

NOTE - These data are confidential and the property of UOP and shall not be disclosed to others or reproduced in any manner or used for any purpose whatsoever except by written permission or as provided in a signed agreement with UOP relating to such data.



CTCI CORPORATION

uop

25 East Algonquin Road • PO Box 5017 • Des Plaines, Illinois 60017-5017 • USA

ATMOSPHERIC STORAGE TANKS

PROJECT SPECIFICATION

560696 — 306 — 4 SHEET 4

REV	DATE	BY	APVD	REV	DATE	BY	APVD
0	4/10/95			4	1/5/96	ASA	ASA
1	4/12/95	NK	NK				
2	5/15/95	SMW	NK				
3	7/2/95	SMW	NK				

Tank Name		Benzene Day Tank
Item Number		58-F01A, B-F-5801A, B
Number of Tanks		2
Tank Size	Nominal Capacity, m ³	1830
	Diameter, m ID	13.4
	Height, m	13.0
Working Capacity, m ³		1418
Material of Construction		Carbon Steel
Design Pressure, mmH ₂ O(g)		254
Design Vacuum, mmH ₂ O(g)		100
Design Temperature, °C		85
Roof Type: C = Cone F = Floating IF = Internal Floating		① C IF
Tank Contents	Material Stored	Benzene
	Density kg/m ³ @ 15°C	859
Flash Point (above or below 38°C)		Below
Storage Temperature, °C		40 max
Filling Nozzle		1 @ 6"
Suction Nozzle		1 @ 16"
Temperature Indicator Nozzle		1 @ 1" ①
Recirculation Nozzle		1 @ 6"
Gas Blanketing Nozzle (Roof)		1 @ 1"
Gas Blanketing Nozzle (Roof)		④ 1 @ 2"
Drain Valve Nozzle		1 @ 4"
Foam Chambers		Provide
Level Indicator Nozzle		1 @ 1-1/2"
Pressure/Vacuum Vent Nozzle		Provide
Filling Rate, m ³ /h		50.9
Pumpout Rate, m ³ /h		609.5
Notes - See Sheet 3		1,2,3,4,5,6,7

NOTE: All data are confidential and the property of UOP and shall be disclosed to others or reproduced in any manner or used in written permission or as provided in a signed agreement with UOP relating to such data.

by purpose whatsoever except by

509310



UOP CORPORATION

uop

25 East Algonquin Road • PO Box 5017 • Des Plaines, Illinois 60017-5017 • USA

ATMOSPHERIC STORAGE TANKS

PROJECT SPECIFICATION

560696 — 306 — 4

SHEET 5

REV	DATE	BY	APVD	REV	DATE	BY	APVD
0	4/10/95			4	1/5/96	ASA	ASA
1	4/12/95	NK	NK				
2	5/15/95	SMW	NK				
3	7/2/95	SMW	NK				

Tank Name		Aromatics Storage Tank	
Item Number		58-F-02 F-5802	
Number of Tanks		1	
Tank Size	Nominal Capacity, m ³	16500	
	Diameter, m ID	34.2	
	Height, m	18.0	
Working Capacity, m ³		13800	
Material of Construction		Carbon Steel	
Design Pressure, mmH ₂ O(g)		254	
Design Vacuum, mmH ₂ O(g)		100	
Design Temperature, °C		85	
Roof Type: C = Cone F = Floating IF = Internal Floating		① Dome & IF	
Tank Contents	Material Stored	Aromatics	
	Density kg/m ³ @ 15°C	854	
Flash Point (above or below 38°C)		Below	
Storage Temperature, °C		40 max	
Filling Nozzle		④ 1 @ 10"	
Filling Nozzle (from desorbent surge drum at MX Sorbex Unit)		④ 1 @ 4"	
Suction Nozzle		1 @ 4"	
Temperature Indicator Nozzle		1 @ 1" ④	
Gas Blanketing Nozzle (Roof)		1 @ 1"	
Gas Blanketing Nozzle (Roof)		1 @ 4"	
Drain Valve Nozzle		1 @ 4"	
Level Indicator Nozzle		1 @ 1-1/2"	
Foam Chambers		Provide	
Pressure/Vacuum Vent Nozzle		Provide	
Filling Rate, m ³ /h		④ 262	
Pumpout Rate, m ³ /h		14.4	
Notes - See Sheet 3		1,2,3,4,5,6,7	

NOTE - All data are confidential and the property of UOP and shall be disclosed to others or reproduced in any manner or used for any purpose whatsoever except by written permission or as provided in a signed agreement with UOP relating to such data.

509311

2-4
4

◇ New sheet added

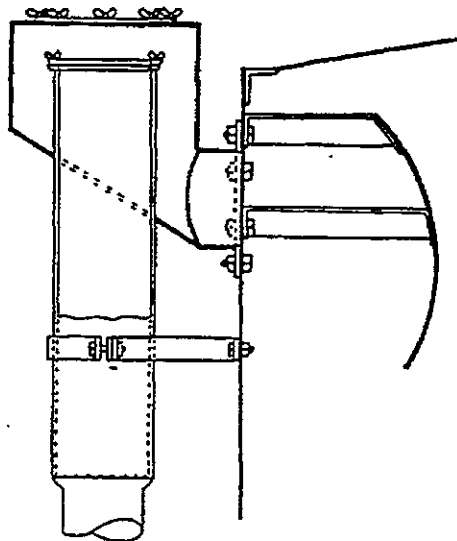


Figure A-1-4(p) Air foam chamber with Type II outlet.

NFPA

TECHNICAL & CONSTRUCTION INFORMATION


DESIGN CODE	ASME SEC VIII, DIV 2, 95 ED & 95 ADD
CUSTOMER SPEC.	22854-SP-000-D-003
SPECIFIC GRAVITY	0.52
SERVICE	PROPANE
MAX DESIGN METAL TEMP.	85°C
MIN DESIGN METAL TEMP.	-46°C
DESIGN PRESSURE	20 barg AT 85°C
TEST PRESSURE	25 barg PER AT-301
ALLOWABLE VACUUM	1.034 barg
DESIGN WIND VELOCITY	125 km/h (ASCE 7-88)
SEISMIC	ZONE 1 (ASCE 7-88)
FOUNDATION	BY OTHERS
CONSTRUCTION	BY ACBI
CORROSION ALLOWANCE	
SHELL	1.0 mm
FITTINGS	1.0 mm
RADIOGRAPHY	FULL (100% JOINT EFF.)
IMPACT TESTING	ALL PRESSURE ENVELOPE MATERIALS
CAPACITY	2145 m ³
TOLERANCES	PER APPENDIX C OF CUSTOMER SPEC.

MATERIAL SPEC	
SHELL PLATES	SA537 - CLASS 2
COLUMN STUBS	SA537 - CLASS 2
LOWER COLUMNS	A36
FORGINGS	SA350 - LF2 (IMPACTS AT -48°C)
INTERNAL PIPE	A333 GR6
BRACING	A36
BASE PLATES	A36
GASKETS	316 STN STL SPIRAL WOUND GRAPHITE FILLED (ASBESTOS FREE)
STUD BOLTS	SA320-L7
NUTS	SA194-GR4
FIELD PWHT	ENTIRE SPHERE
INSULATION	NONE
FIRE PROOFING	COLUMNS ONLY TO FULL HEIGHT

MARK	NO. REQ'D	THK'S
1	1	46.37
2	2	46.37
3	4	46.31
4	9	46.21
4P	9	46.21
5	4	45.06
6	2	44.89
7	1	44.89

LIST OF FITTINGS

CUST. MARK	ACBI MARK	QUANT	SIZE	RATING	DESCRIPTION
J1	9-1	1	4"	300# RF	TOP NOZZLE W/INTERNAL (LIC)
J2	6-1	1	8"	300# RF	TOP NOZZLE W/INTERNAL (LI)
J3	8-1	1	4"	300# RF	TOP NOZZLE W/INTERNAL (LALL)
J4	7-1	1	4"	300# RF	TOP NOZZLE W/INTERNAL (LAHH)
J5	5-1	1	2"	300# RF	TOP NOZZLE W/INTERNAL (TI)
M1	11-A	1	24"	300# RF	TOP MANHOLE W/DAVIT
N1	4-1	1	8"	300# RF	TOP NOZZLE W/INTERNAL (LIQ. IN)
N2	10-A	1	24"/12"	STUB END	BOTTOM NOZZLE W/VORTEX BREAKER (LIQ. OUT)
N3	3-1	1	8"	300# RF	TOP NOZZLE (RELIEF)
	14-A	1			NAMEPLATE
	15-1	2			EARTHING LUGS
		1			FIREWATER SPRAY SYSTEM

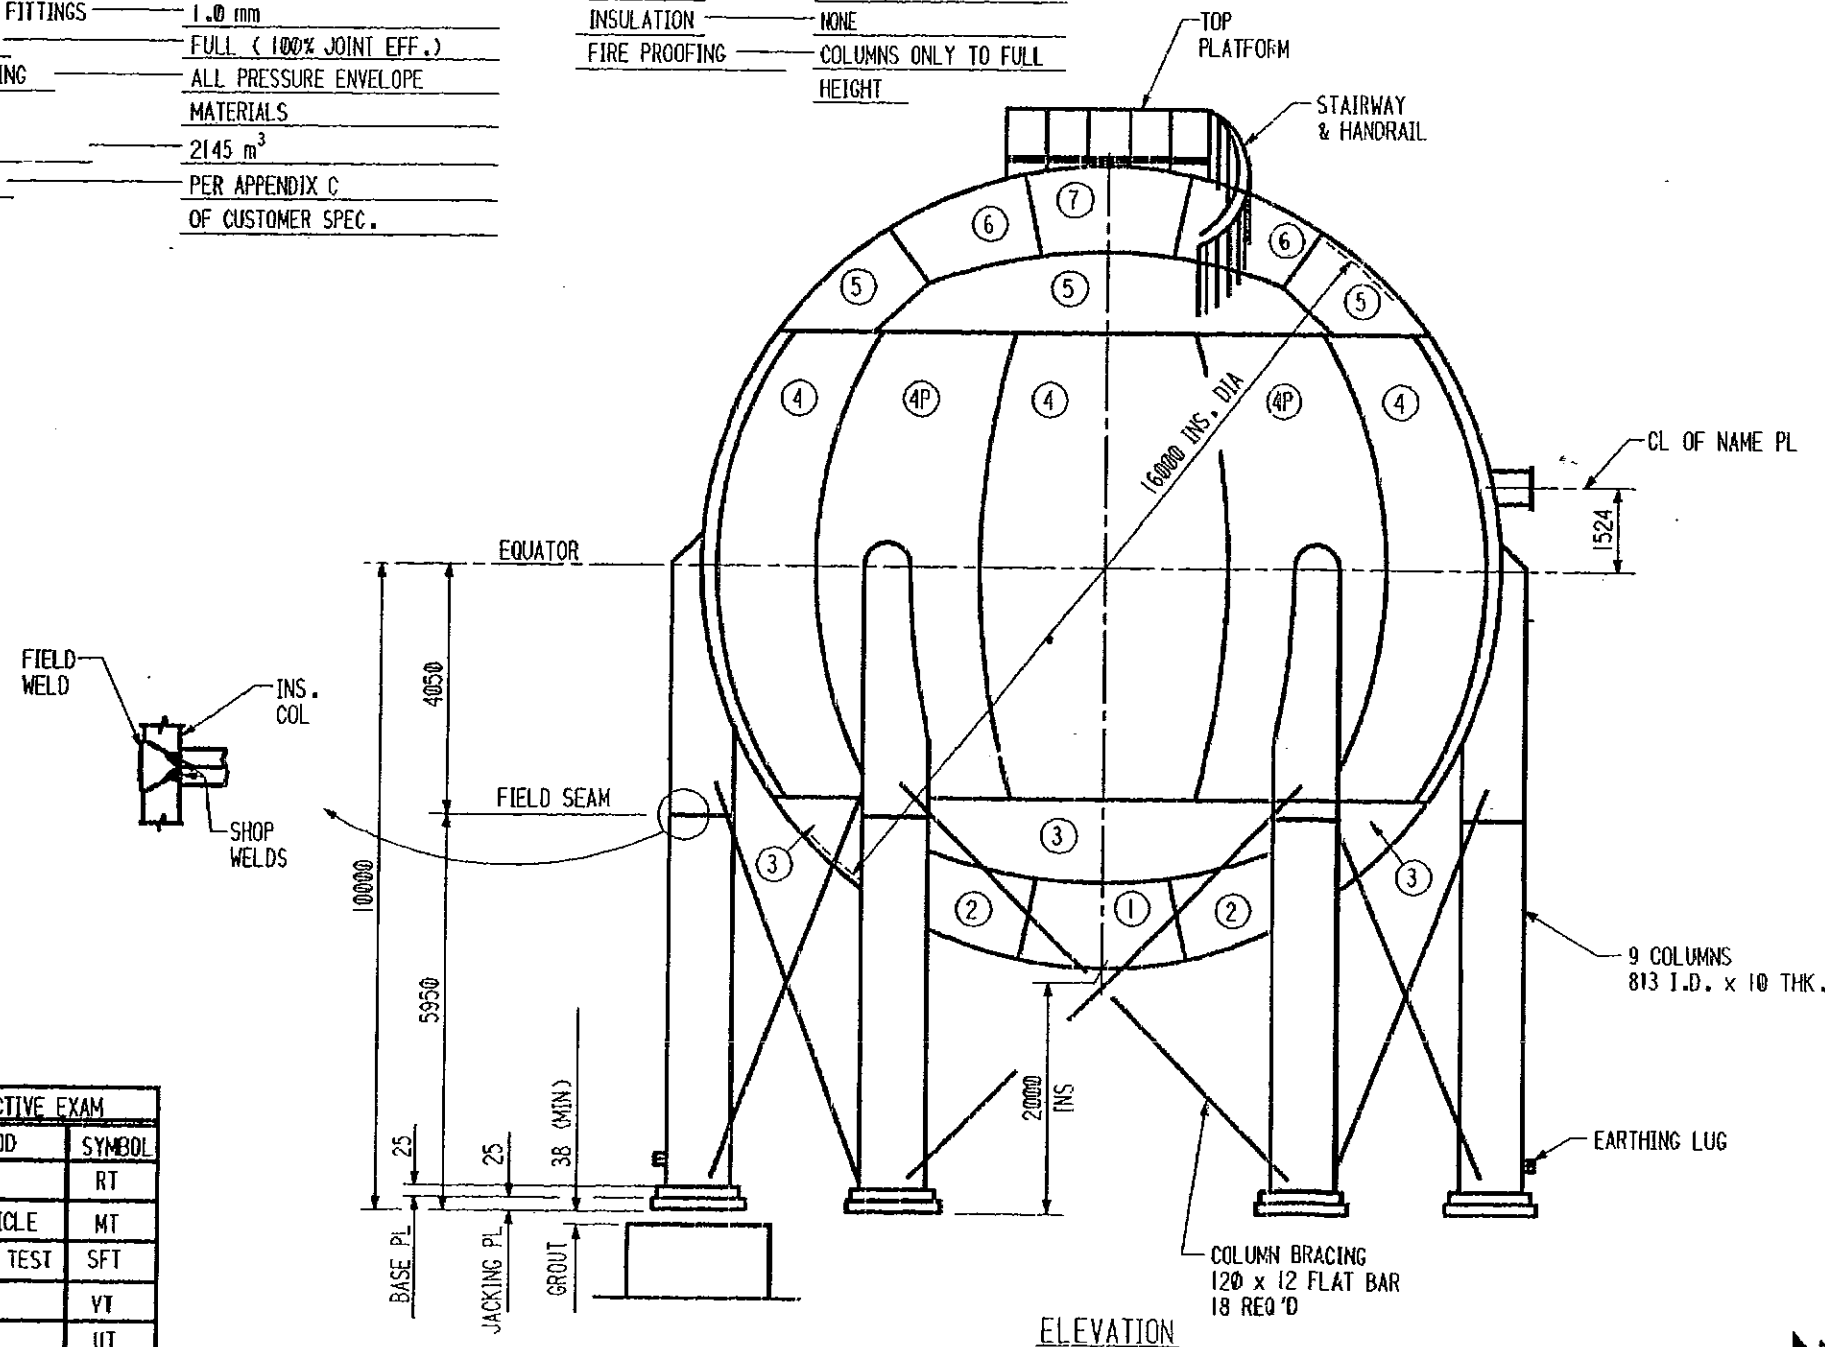

AS - BUILT

NOTES:

- SEE DWG #2 FOR NOZZLE ORIENTATION.
- SEE DWG # 35 FOR STAIRWAY KEY PLAN.
- SEE DWG # F1 FOR FOUNDATION LOADS AND COLUMN LOCATIONS.




NON-DESTRUCTIVE EXAM	
METHOD	SYMBOL
RADIOGRAPHIC	RT
MAGNETIC PARTICLE	MT
SOLUTION FILM TEST	SFT
VISUAL	VT
ULTRASONIC	UT

ARABIAN CBI LTD. GENERAL ARRANGEMENT 16.0 M ID PROPANE SPHERE IBN RUSHD PTA AND AROMATICS PLANT PROJECT ARABIAN INDUSTRIAL FIBERS CO. LTD YANBU, SAUDIA ARABIA	
ITEM NO. 181-D-001 BY DRW CHKD WJH DATE 11/5/96 R L HERBERT ENGINEERING SUPERVISOR	CONTRACT NO. ED965212 DWG 1 REV 2 SHT
This drawing is the property of ACBI and is to be used only in conjunction with the performance of work by ACBI. Reproduction in whole or in part is expressly forbidden.	

INDICATES CHANGE FROM PREVIOUS ISSUE

08:30:07 Oct. 9, 1996


65212002.DGN

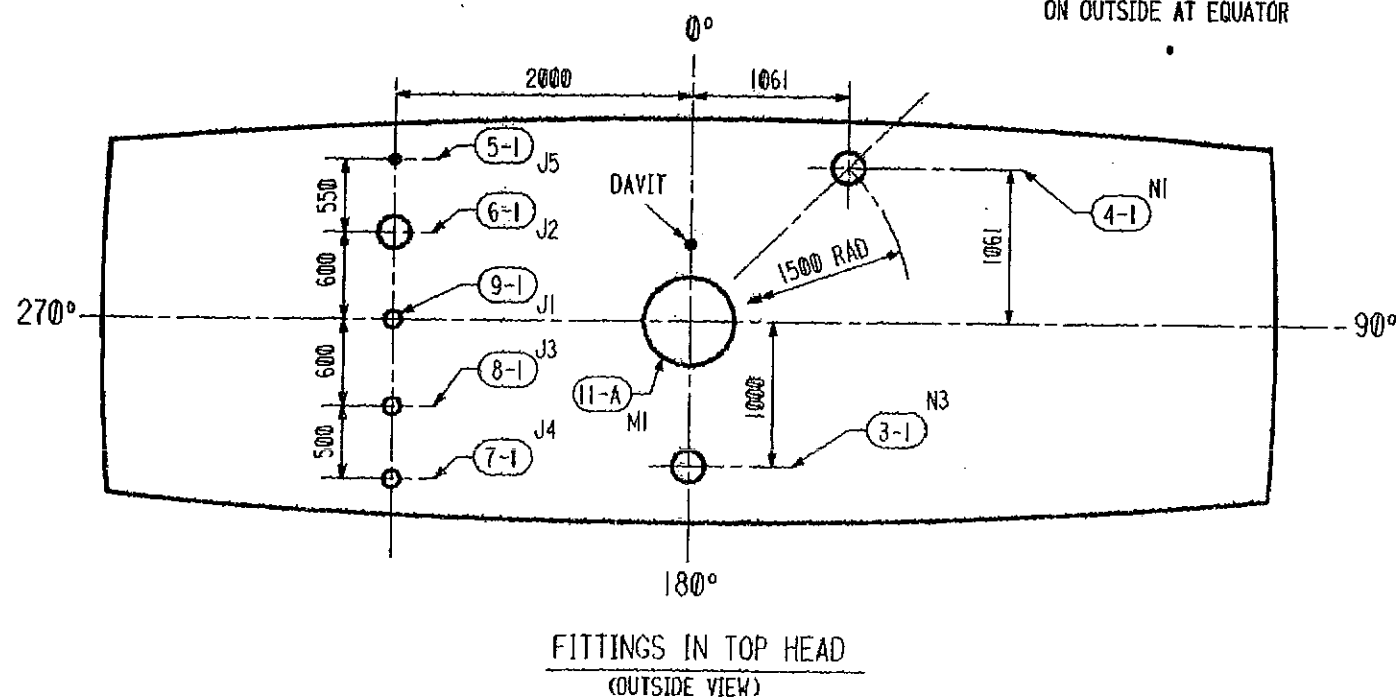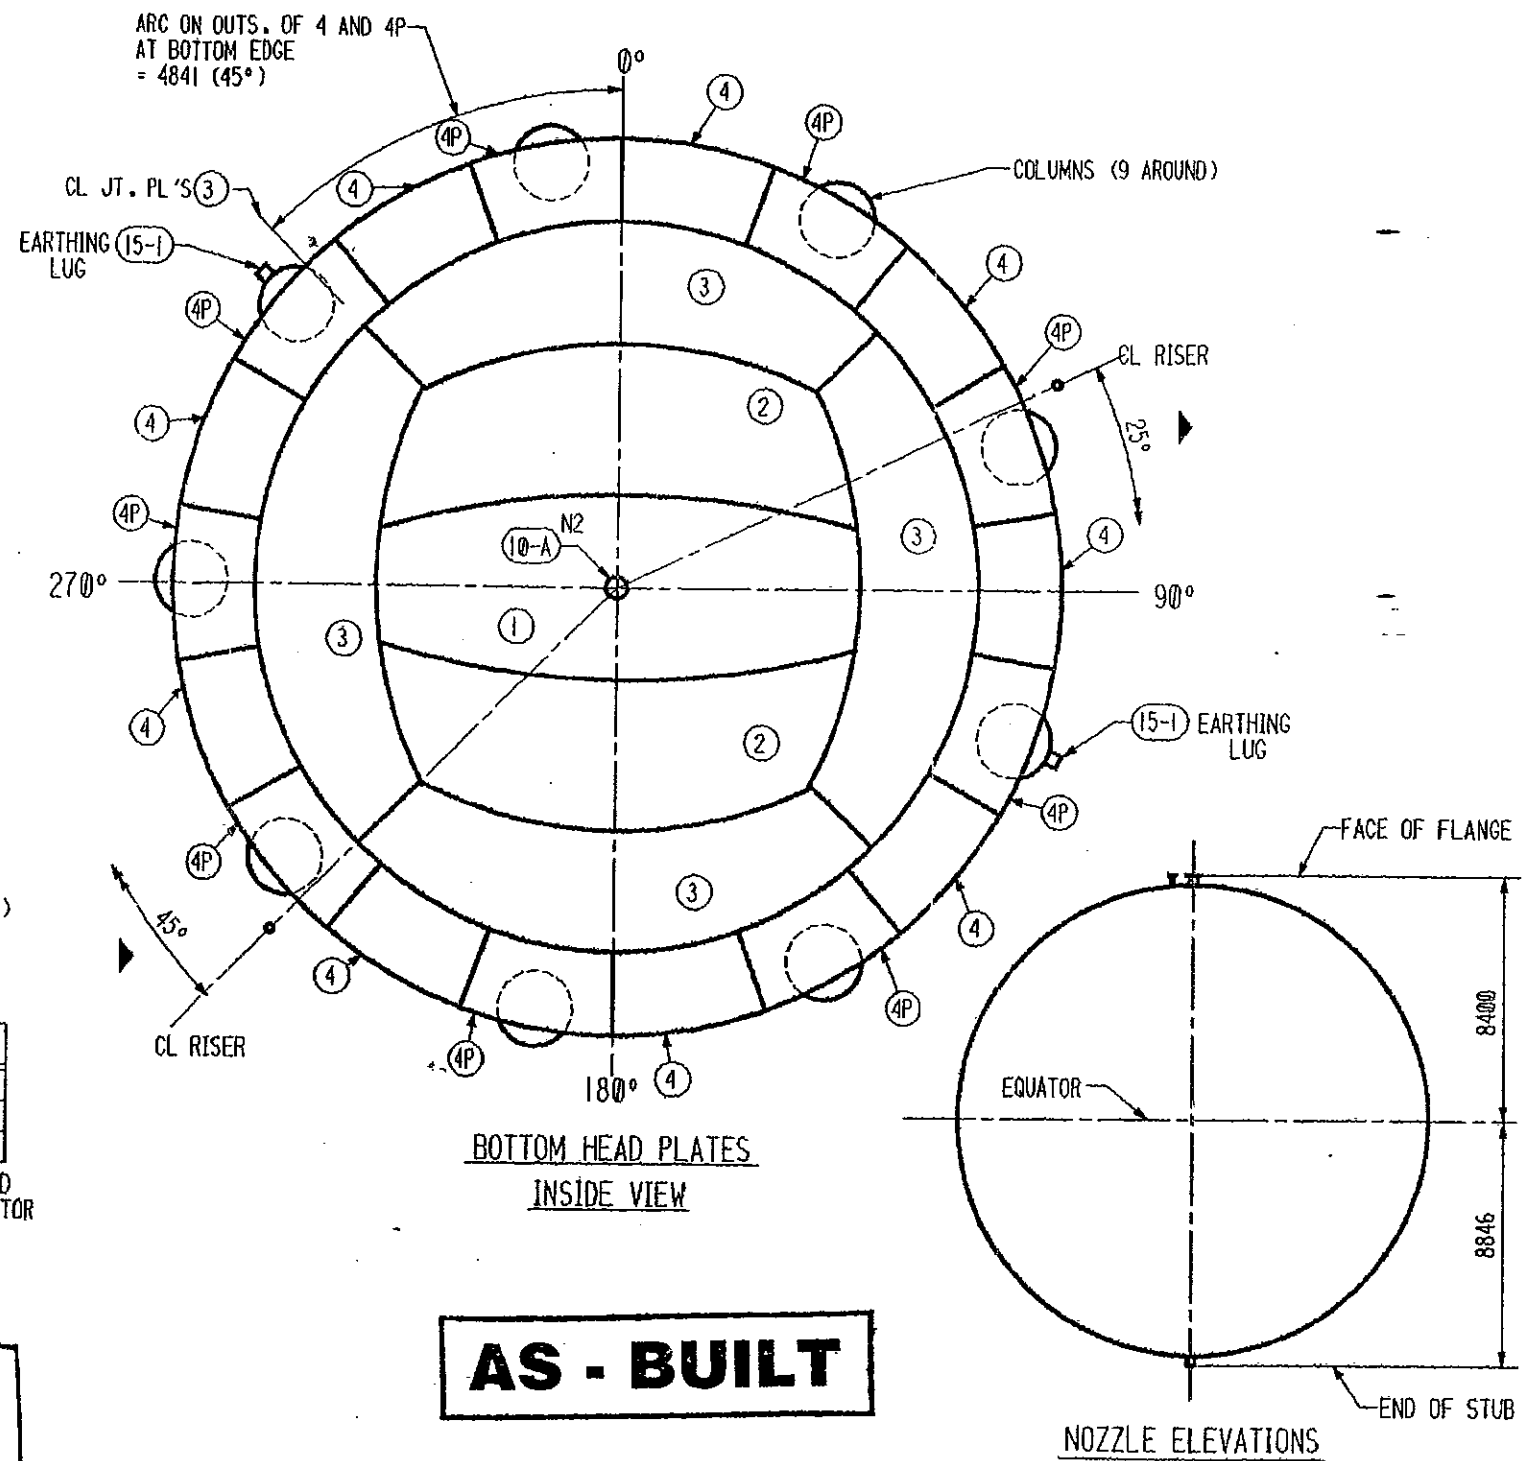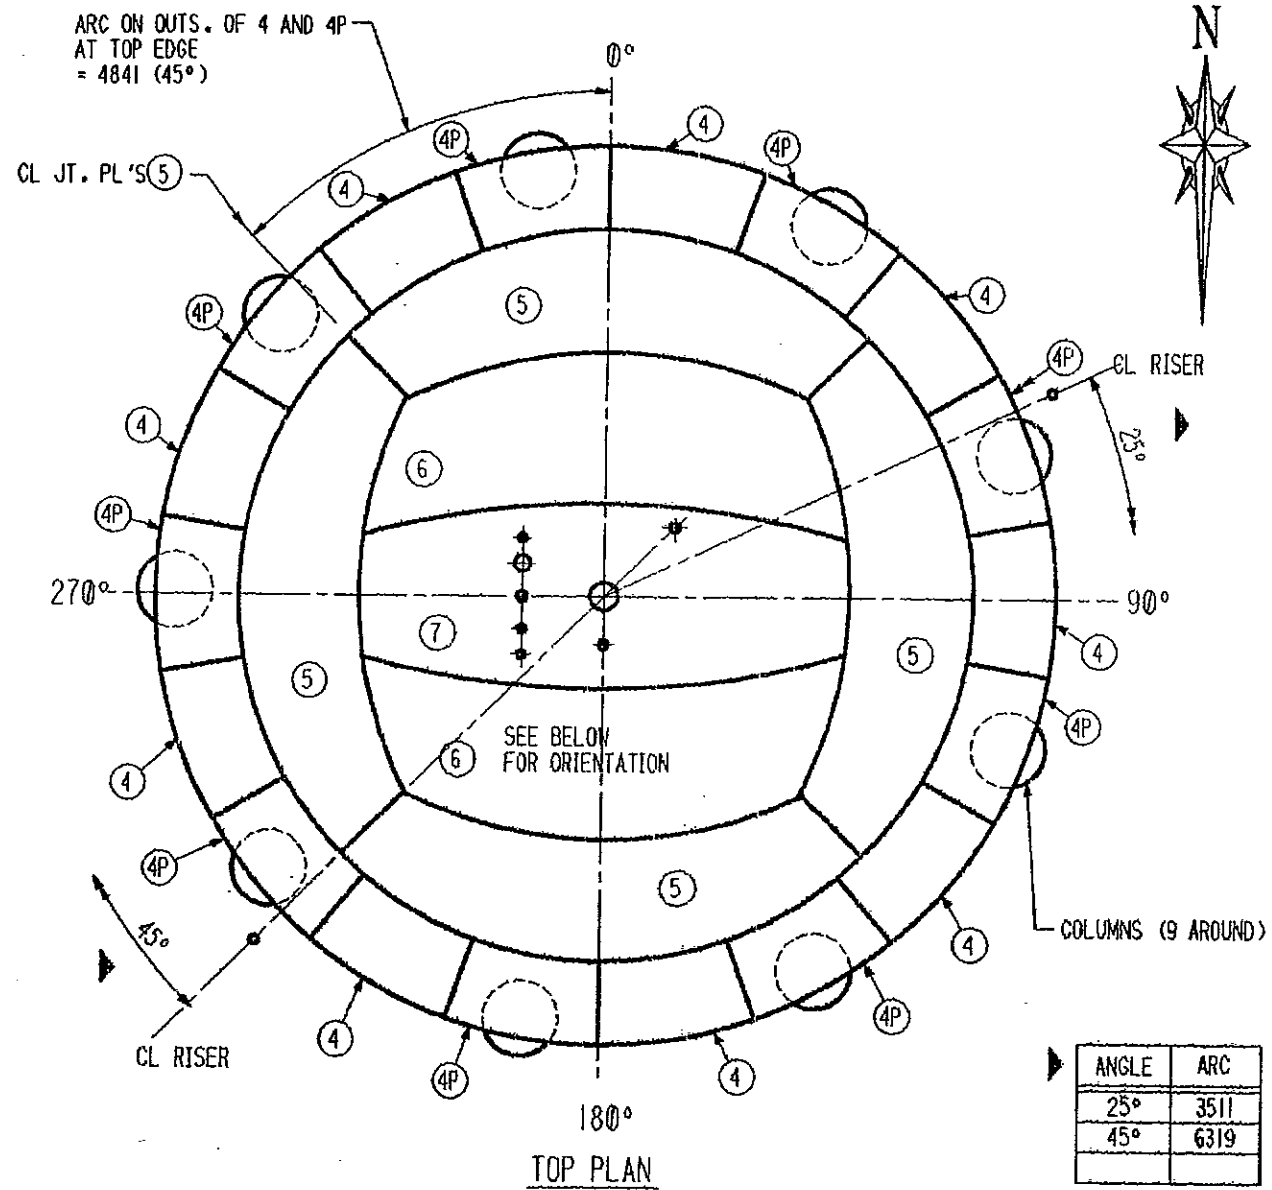


INDICATES CHANGE FROM PREVIOUS ISSUE

ARABIAN CBI LTD.	
ORIENTATION	
16.0 M ID PROPANE SPHERE	
IBN RUSHD PTA AND AROMATICS PLANT PROJECT	
ARABIAN INDUSTRIAL FIBERS CO. LTD	
YANBU, SAUDIA ARABIA	
ITEM NO	101-D-001
CONTRACT NO	965212
BY	DRW
CHKD	W.H.
DATE	11/5/96
ENGINEERING SUPERVISOR	R.L. HERBERT
SHIT	2
REV	2

This drawing is the property of ACBI and is to be used only in conjunction with the performance of work by ACBI. Reproduction in whole or in part is expressly forbidden.

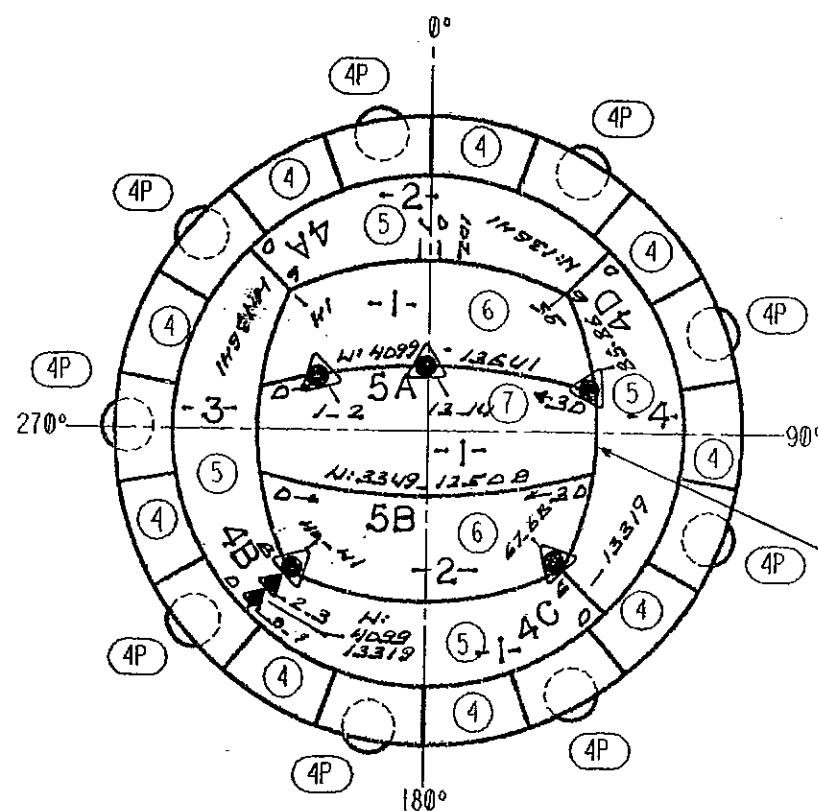


TOP PLAN

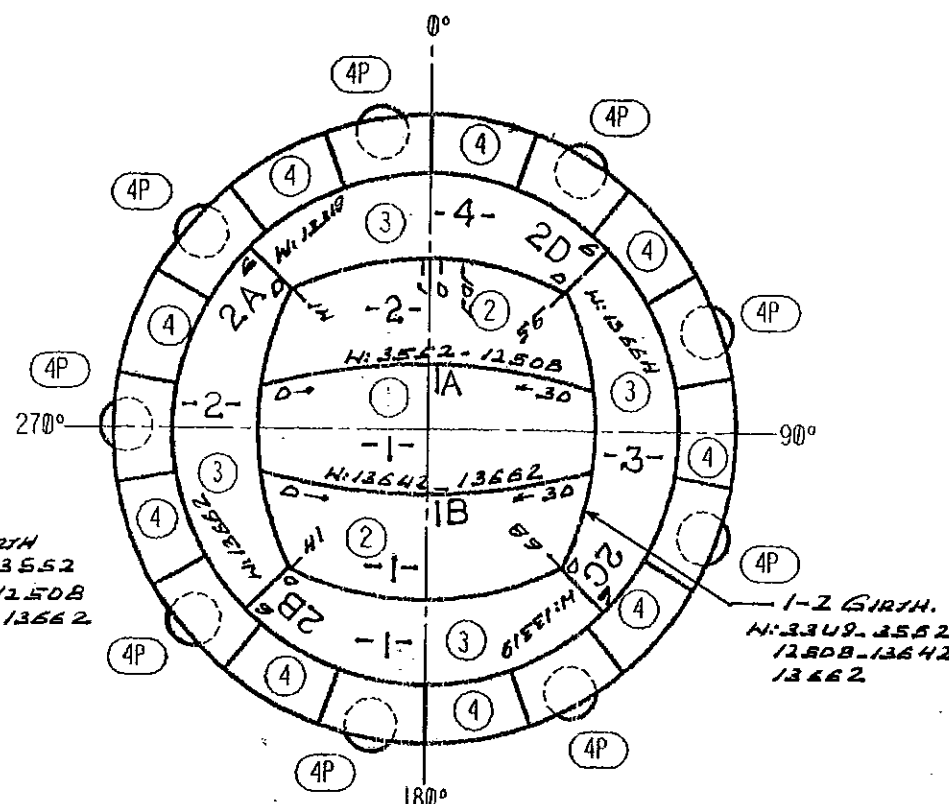


BOTTOM PLAN

(INSIDE VIEW)

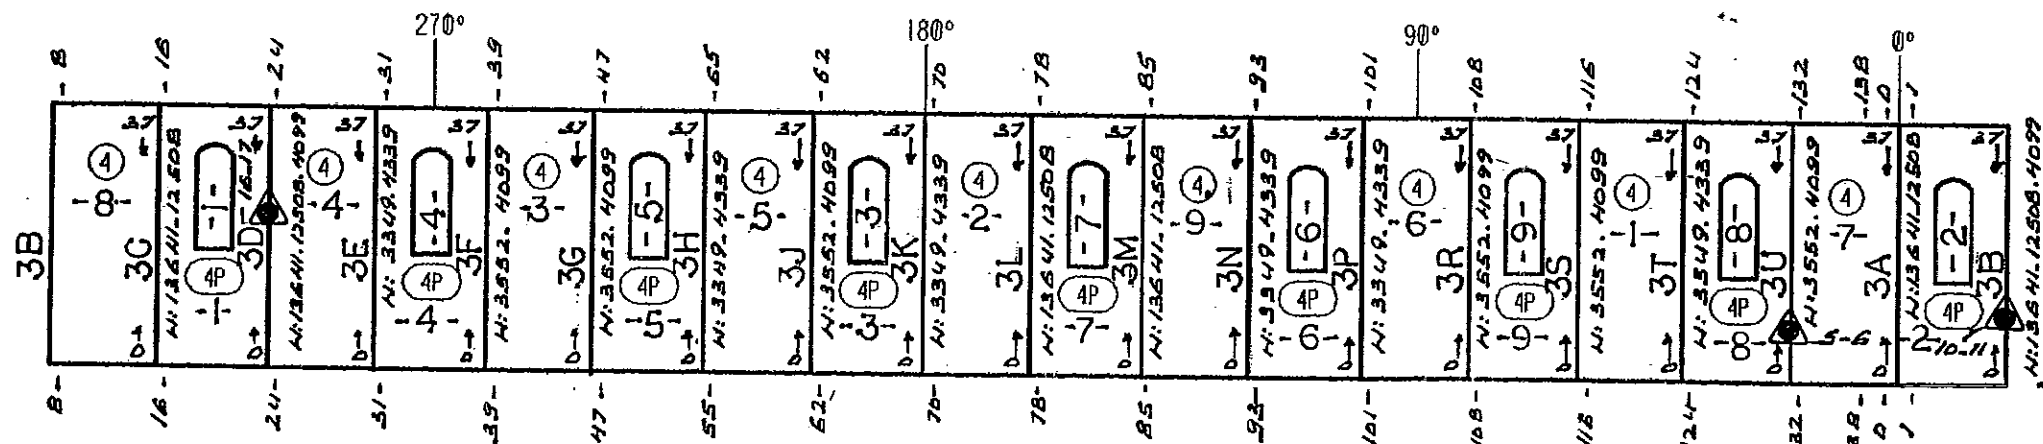

DEVELOPED ELEVATION OF EQUATOR PL'S


(OUTSIDE VIEW)

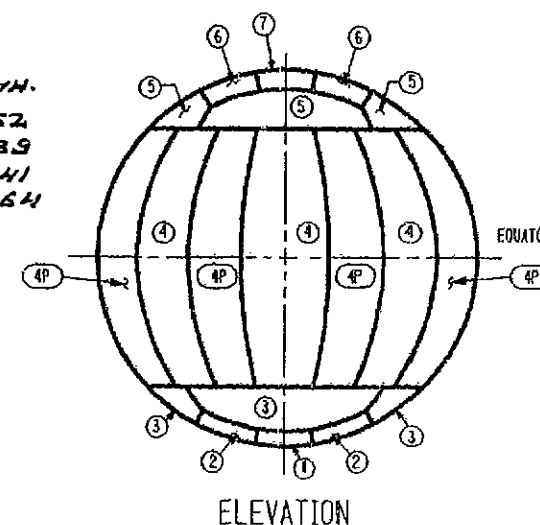

ELEVATION

INSTRUCTIONS:


- 1.) RECORD WELDERS I.D. ON EACH JOINT.
- 2.) RECORD JOINT I.D. & R.T. INTERVALS (FIRST & LAST FOR 100%) OR LOCATION FOR SPOT.
- 3.) RECORD MATERIAL I.D. FOR EACH PIECE OR ASSEMBLY.

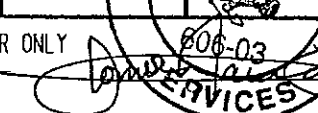NDE PERSONNEL (MT & PT ONLY)		NAME OF WELDER	I.D.
F. E. KHAN	LEVEL II	M. S. SIDDIQUE	3349
K. M. WARGHSE	LEVEL II	M. S. KARIM	3552
		M. LATIF DIN	4099
		CHUNN MOHD.	4339
		N. H. LERNO	12508
LIST NDE PROCEDURES USED - (MT & PT ONLY)	JOINT I.D. IF REQ'D	A. DEAMPO	13319
		R. B. BRICAL	13641
PT 5W REV. B		R. J. ROJAS	13642
PT 5W REV. 7		R. T. MANALO	13662
PT 5W REV. B		J. R. MARQUEZ	13664
LIST WELD PROCEDURE	JOINT I.D. IF REQ'D		
WPS BO/BCL REV. D			
FOR AUTHORIZED INSPECTOR ONLY			
 11-6-97 ROMEO M. LACASANDILE MD#1074			

FOR CONSTRUCTION

VESSEL DIAMETER / mm	
VERTICAL	15960
HORIZONTAL N/S	16010
HORIZONTAL E/W	15975

RECORD VESSEL FINAL
AS-BUILT DIMENSIONS



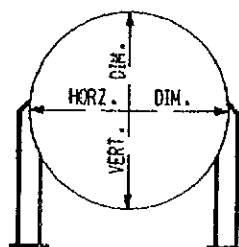


WHEN COMPLETE
FOREMAN: SEND CONSTRUCTION OFFICE ONE LEGIBLE AND WORK COPIES IF ANY
CONSTRUCTION OFFICE: KEEP ONE COPY IN CONSTRUCTION OFFICE FILE
SEND LEGIBLE COPY TO ENGINEERING ASSIGNED

I CERTIFY THAT THIS RECORD IS COMPLETE AND ACCURATE
IN ACCORDANCE WITH SECTION 5 OF DIVISION 4 OF THE
O.C. MANUAL
AL HAYNES
WELDING & Q.A. SUPERVISOR
7 JUNE 97
DATE

ARABIAN CBI LTD.	
RECORD DRAWING	
16.0 M ID PROPANE SPHERE	
IBN RUSHD PTA AND AROMATICS PLANT PROJECT	
ARABIAN INDUSTRIAL FIBERS CO. LTD	
YANBU, SAUDIA ARABIA	
ITEM NO. 101-0-001	CONTRACT NO. 965212
BY KT CKD WJH DATE 3-05-97	DWG RI REV 0
R. L. HERBERT	ENGINEERING SUPERVISOR
This drawing is the property of CBI and is to be used only in conjunction with the performance of work by CBI. Reproduction in whole or in part is expressly forbidden.	

INDICATES CHANGE FROM PREVIOUS ISSUE

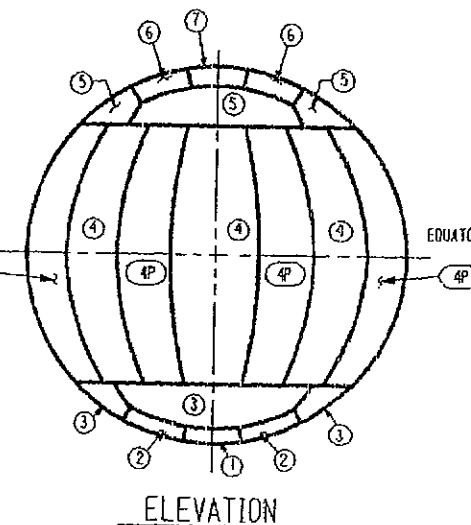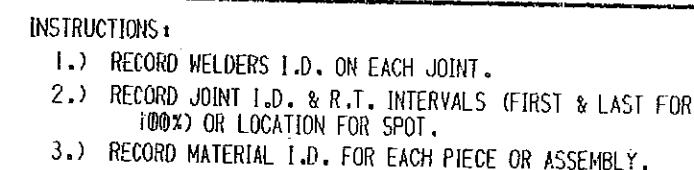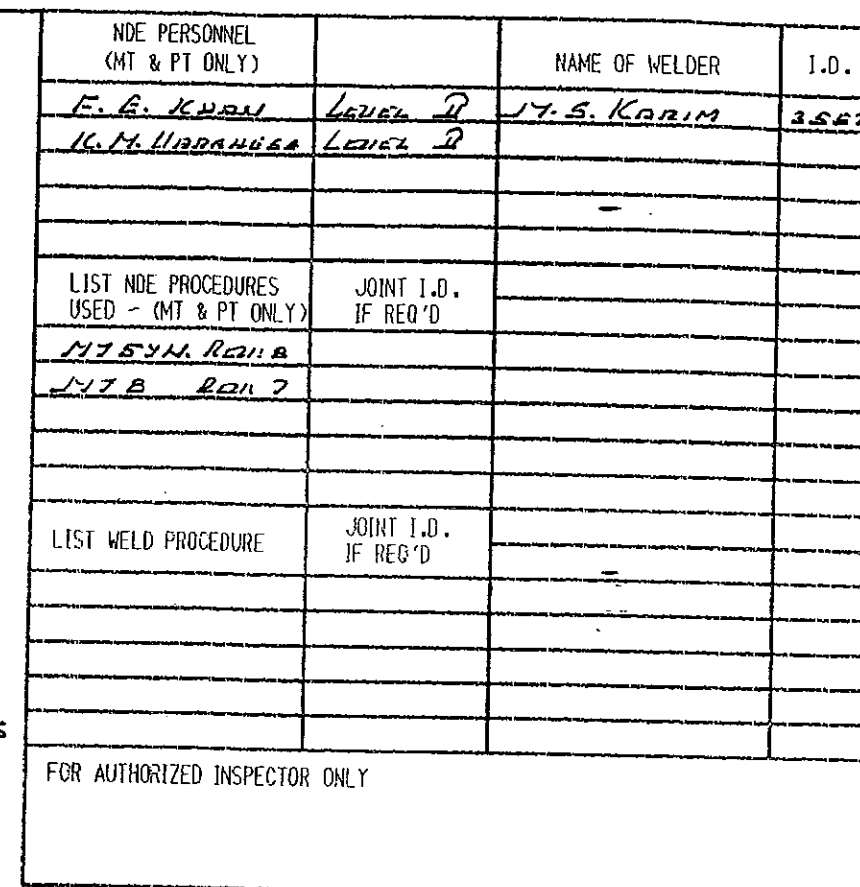

A diagram of a circular tank. A horizontal line with arrows at both ends is labeled "HORIZ. DIM.". A vertical line with arrows at both ends is labeled "VERT. DIM.". The tank is supported by two vertical legs on the left and two vertical legs on the right.

WHEN COMPLETE
FOREMAN: SEND CONSTRUCTION OFFICE ONE LEGIBLE AND WORK COPIES IF ANY
CONSTRUCTION OFFICE: KEEP ONE COPY IN CONSTRUCTION OFFICE FILE SEND LEGIBLE COPY TO ENGINEERING ASSIGNED

Al Payne
WELDING & O.A. SUPERVISOR

10 JUNE 97
DATE


										 ARABIAN CBI LTD.			
										RECORD DRAWING 16.0 M ID PROPANE SPHERE IBN RUSHD PTA AND AROMATICS PLANT PROJECT ARABIAN INDUSTRIAL FIBERS CO. LTD YANBU, SAUDIA ARABIA			
MODIFICATION/REMARKS 										ITEM NO <u>101-D-001</u>		CONTRACT NO <u>965212</u>	
										BY <u>KT</u> CHKD <u>NJH</u> DATE <u>3-05-97</u> <u>R L HERBERT</u> ENGINEERING SUPERVISOR		DWG <u>RI</u> REV <u>Q</u> SHT	
BY	CHKD	DATE	REV	DESCRIPTION	This drawing is the property of ACBI and is to be used only in conjunction with the performance of work by ACBI. Reproduction in whole or in part is expressly forbidden.								

TECHNICAL & CONSTRUCTION INFORMATION


SPECIFICATIONS	API 650-9th ED. (1993/94 ADD.)
	APP. E, F.1.2, & S (NON CERTIFIED)
SPECIFIC GRAVITY	1.050
SERVICE	ACETIC ACID
MAX DESIGN METAL TEMP.	85°C
MIN DESIGN METAL TEMP.	17°C
DESIGN PRESSURE	0.025 bar (g)
DESIGN VACUUM	0.006 bar (g)
DESIGN LIQUID LEVEL	15000 mm
DESIGN WIND VELOCITY	140 km/h (PER API 650)
SEISMIC	ZONE I (I=1.0, S=1.2)
	PER API 650
ROOF LIVE LOAD	1.2 KPa PLUS VACUUM
NOMINAL CAPACITY	4710 m ³
PUMP IN RATE	120 m ³ /hr
PUMP OUT RATE	85 m ³ /hr
FOUNDATION	BY OTHERS
CONSTRUCTION	BY ARABIAN CBI
CORROSION ALLOWANCE	
BOTTOM	1.0 mm
SHELL	1.0 mm
ROOF	1.0 mm
STRUCTURAL	1.0 mm

MATERIAL SPEC	
BOTTOM RECT.	A240-316L
BOTTOM SKETCHES	A240-316L
SHELL PLATES	A240-316L
ROOF PLATES	A240-316L
STRUCTURAL	A479-316L & A36
FLANGES	A182-F316L
NOZZLE NECKS	A312-TP316L
INTERNAL PIPE	A312-TP316L
INSPECTION - MILL	CTR'S
SHOP	ACBI
FIELD	ACBI & CUSTOMER
SURFACE PREPARATION	YES
PAINTING	YES
PWHT	NONE
INSULATION	YES
MISC.	
GASKETS	REINZ-AMF34
BOLTS & NUTS	A193-B8M & A194-BM
RADIOGRAPHY	PER CODE
JOINT EFFICIENCY	N/A

RING NO.	CORR. ALLOW. mm	DESIGN FOR PRODUCT SG=1.850		DESIGN FOR TEST SG=1.0		THK. USED mm	MATERIAL SPECIFICATION	API MAT'L GROUP NO.
		ALLOWABLE STRESS MPa	REQUIRED THK. mm	ALLOWABLE STRESS MPa	REQUIRED THK. mm			
1	1.0	131.1	12.54	155.1	9.29	12.54	A240-316L	N/A
2	1.0	131.1	10.14	155.1	7.38	10.14	A240-316L	N/A
3	1.0	131.1	7.84	155.1	5.53	8.00	A240-316L	N/A
4	1.0	131.1	5.54	155.1	3.67	6.00	A240-316L	N/A
5	1.0	131.1	3.26	155.1	1.83	6.00	A240-316L	N/A

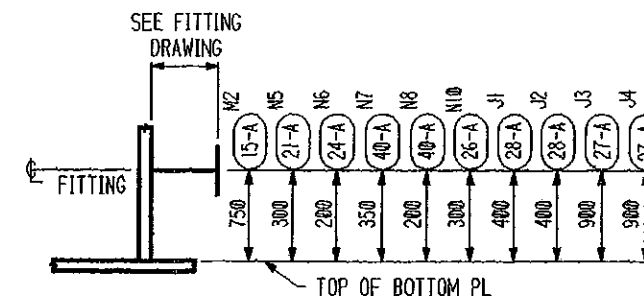

SHELL FITTING ELEVATION

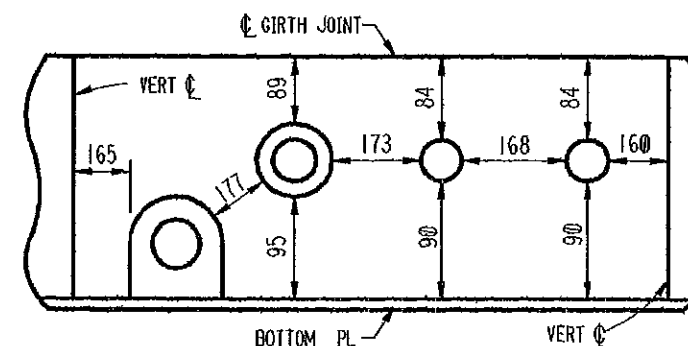

SKETCH 'A'
(BOTTOM RING ONLY)

GENERAL NOTES:


1. FITTINGS TO BE LOCATED AS SHOWN ON ORIENTATION DRAWING(S). IF LOCATIONS ARE NOT GIVEN, LOCATE IN FIELD TO SUIT CUSTOMER MAINTAINING MINIMUM SPACING SHOWN IN SKETCH 'A'. DIMENSIONS GIVEN ARE FROM EDGE TO EDGE OF REINFORCING PL OR FROM CL OF BUTT WELD TO EDGE OF REINFORCING PL.
2. FLANGE BOLT HOLES TO STRADDLE VERTICAL CENTERLINE FOR SHELL NOZZLES.
3. FLANGE BOLT HOLES TO STRADDLE 0°-180° CENTERLINE FOR ROOF NOZZLES.
4. SEE SHEETS 800 & 802 FOR MATERIAL MANAGEMENT.

STEVE COYLE
SABCO QA/QC
16 MAY 1999

AS-BUILT
RTT ACB2

LIST OF FITTINGS

CUST. MARK	ACBI MARK	QUANT	SIZE	RATING	DESCRIPTION
M1	30-A	1	24"	API	ROOF MANWAY
M2	15-A	1	24"	API	SHELL MANHOLE
N1	39-A	1	8"	150 RF	ROOF NOZZLE ACID FILL W/INT.
N2	36-A	1	3"	150 RF	ROOF NOZZ PUMP SPILLBACK W/INT.
N3	31-A	1	6"	150 RF	ROOF NOZZ VENT
N4	38-A	1	3"	150 RF	ROOF NOZZLE VAPOUR RETURN
N5	21-A	1	6"	150 RF	SHELL NOZZLE PUMP SUCTION
N6	24-A	1	3"	150 RF	SHELL NOZZLE DRAIN W/INT.
N7	40-A	1	2"	150 RF	SHELL NOZZLE STEAM IN
N8	40-A	1	2"	150 RF	SHELL NOZZLE STEAM OUT
N9	35-A	1	8"	150 RF	ROOF NOZZ LEVEL TEMP SERVO W/INT.
N10	26-A	1	6"	150 RF	SHELL NOZZLE SPARE
J8	42-A	1	12"	150 RF	ROOF NOZZLE (EMERGENCY VENT)
J1	28-A	1	4"	150 RF	SHELL NOZZLE LT
J2	28-A	1	4"	150 RF	SHELL NOZZLE LT
J3	27-A	1	2"	150 RF	SHELL NOZZLE TIC
J4	27-A	1	2"	150 RF	SHELL NOZZLE TI
J5	33-A	1	2"	150 RF	ROOF NOZZ (N ₂ BLANKETING)
J6A/B	33-A	2	3/4"	3000 CL	ROOF NOZZ (N ₂ BLANKETING)
J7	32-A	1	3"	150 RF	ROOF NOZZLE PSV
J7A	43-A	1	6"	150 RF	ROOF NOZZLE VAC. VENT
DWG#18		1			NAMEPLATE
		1			ROOF PLATFORM
		1			PERIPHERAL HANDRAIL
DWG#50		1			SPIRAL STAIRWAY
DWG#29		4			GROUNDING LUG
DWG#41					HEATER COIL
17-A		1	36"		SUMP
DWG#19					ANCHOR CHAIRS
DWG#12/13					INSULATION SUPPORTS
		1			DRIP RING
		1 SET			CATHODIC PROTECTION (EXT.)
DWG#35		1			STILLING WELL

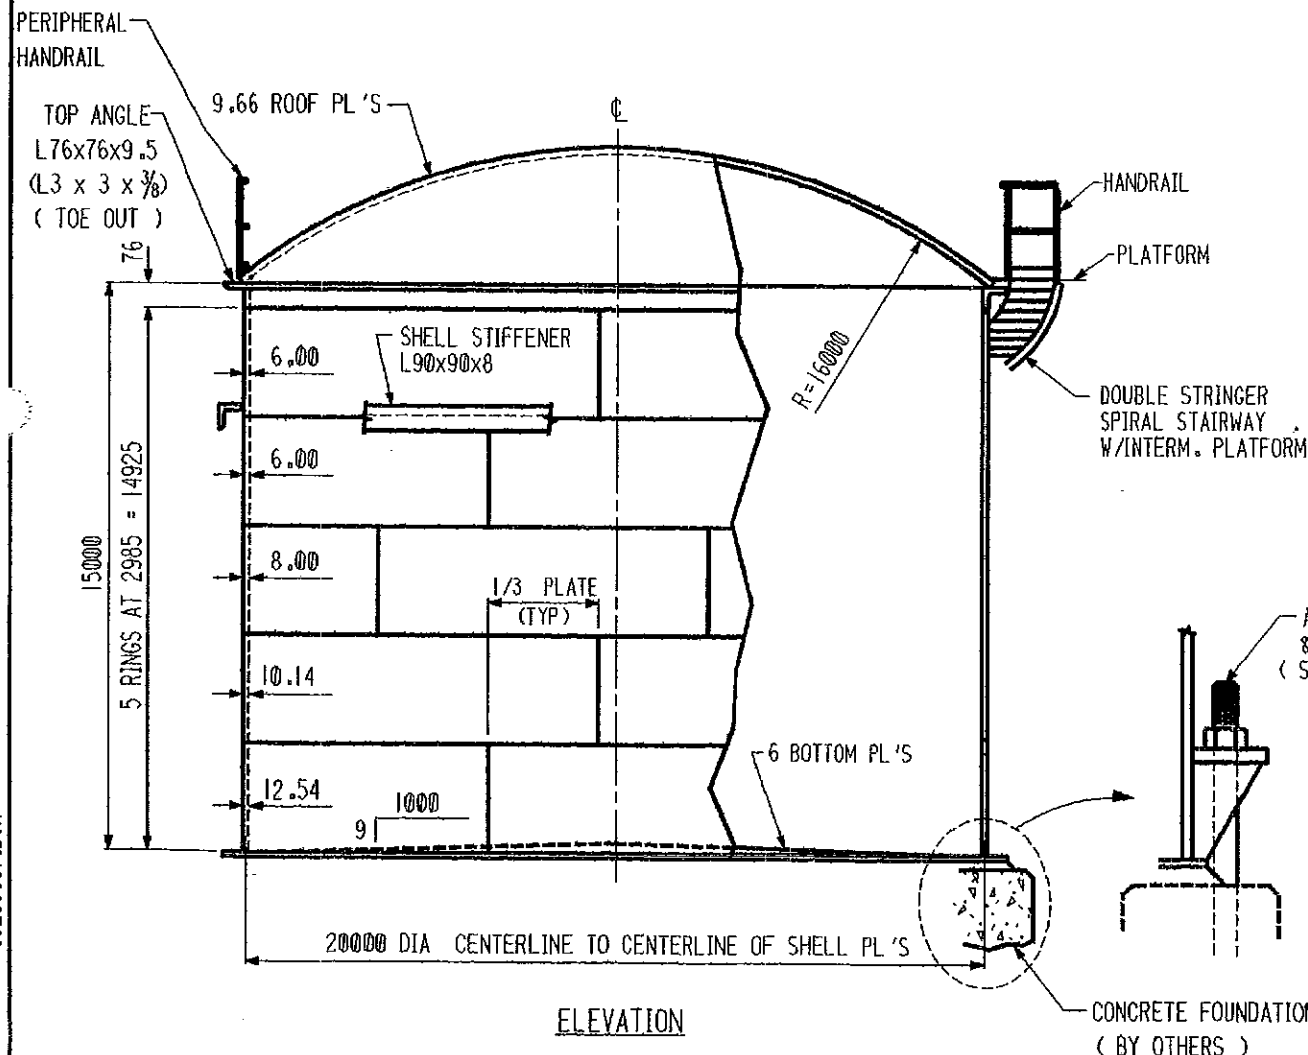




ELEVATION

ACETIC ACID STORAGE TANK

BECHTEL LTD CONTRACT No. 22854-LCC-005
(22854-000-F-001)


ARABIAN CBI LTD.	
GENERAL ARRANGEMENT	
20.0m DIA. x 15.0m HIGH SS DRT	
IBN RUSHD PTA AND AROMATICS PLANT PROJECT	
ARABIAN INDUSTRIAL FIBERS CO. LTD	
YANBU, SAUDI ARABIA	
ITEM NO 102-F-001	CONTRACT NO ED 965205
BY Key CHKD MSG DATE 3/15/96	DWG 1 REV 8
R L HERBERT	ENGINEERING SUPERVISOR
This drawing is the property of ACBI and is to be used only in conjunction with the performance of work by ACBI. Reproduction in whole or in part is expressly forbidden.	

INDICATES CHANGE FROM PREVIOUS ISSUE

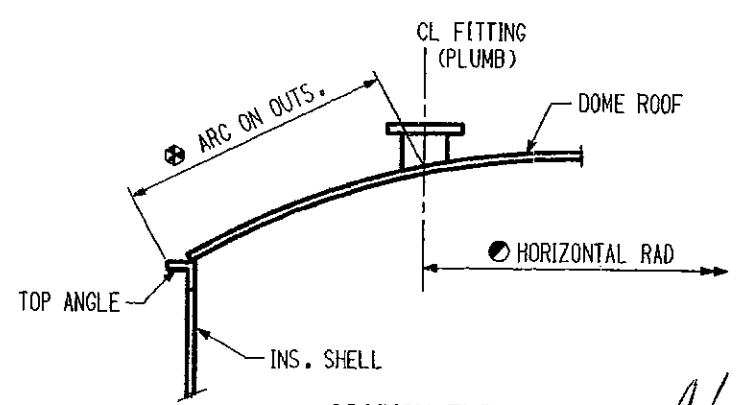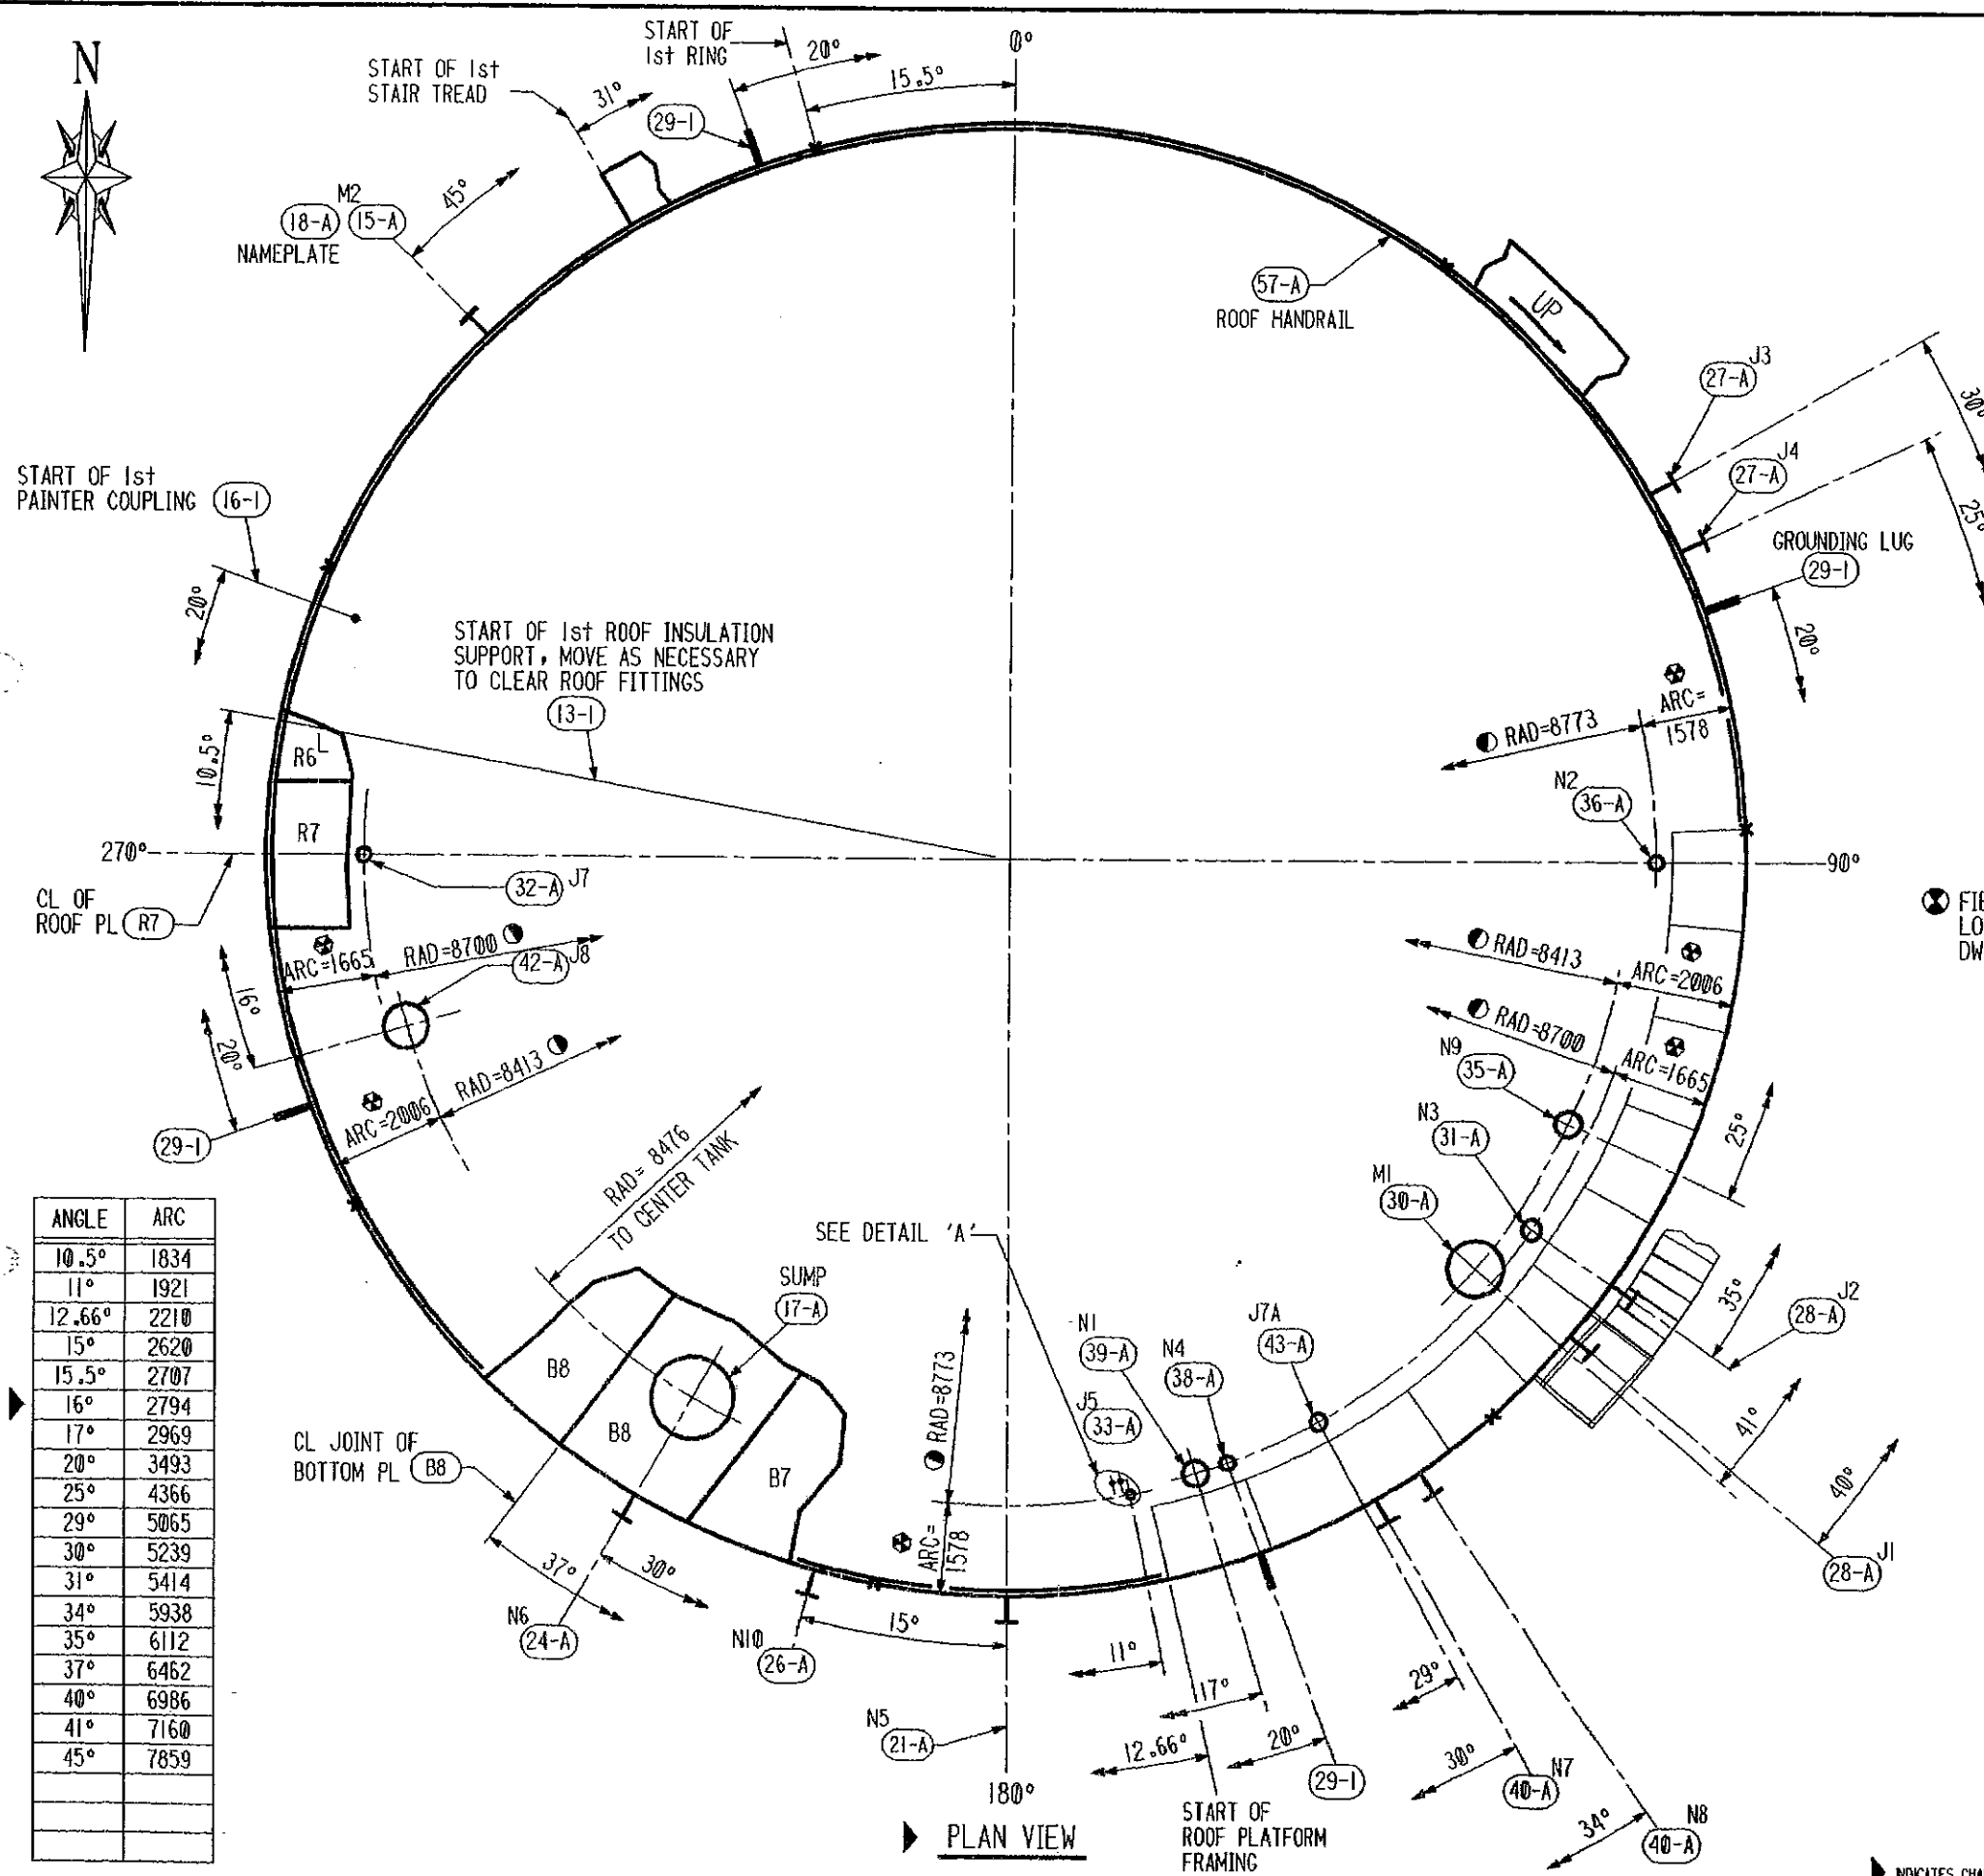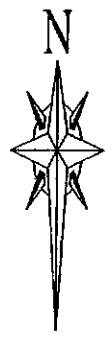

AS - BUILT
KTT ACBI

STEVE COYLE
SABCO DA/QC
18 MAY 1999

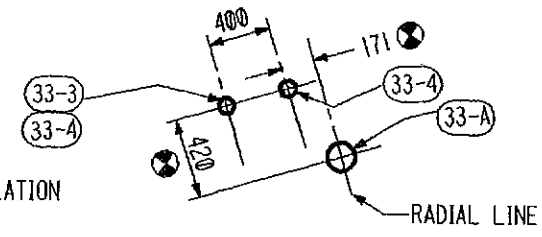

NOTES:



1. ALL ARC'S ARE MEASURED ON OUTSIDE OF FIRST SHELL RING UNLESS OTHERWISE NOTED.
2. ROOF NOZZLE BOLT HOLES TO STRADDLE 0°-180° CL
3. 'X' DENOTES FIRST SHELL RING JOINTS.
4. SEE DWG # F1 FOR ANCHOR CHAIRS LOCATION

ACETIC ACID STORAGE TANK
BECHTEL LTD CONTRACT No. 22854-LCC-005
(22854-000-F-001)

ARABIAN CBI LTD.	
ORIENTATION 20.0m DIA. x 15.0m HIGH SS DRT IBN RUSHD PTA AND AROMATICS PLANT PROJECT ARABIAN INDUSTRIAL FIBERS CO. LTD YANBU, SAUDI ARABIA	
ITEM NO 102-F-001	CONTRACT NO ED 965205
BY KT CHKD MSTG DATE 5-28-96 R L HERBERT ENGINEERING SUPERVISOR	DWG 2 REV 4
This drawing is the property of ACBI and is to be used only in conjunction with the performance of work by ACBI. Reproduction in whole or in part is expressly forbidden.	

ANGLE	ARC
10.5°	1834
11°	1921
12.66°	2210
15°	2620
15.5°	2707
16°	2794
17°	2969
20°	3493
25°	4366
29°	5065
30°	5239
31°	5414
34°	5938
35°	6112
37°	6462
40°	6986
41°	7160
45°	7859

100% 2000/07/20 11:00 AM

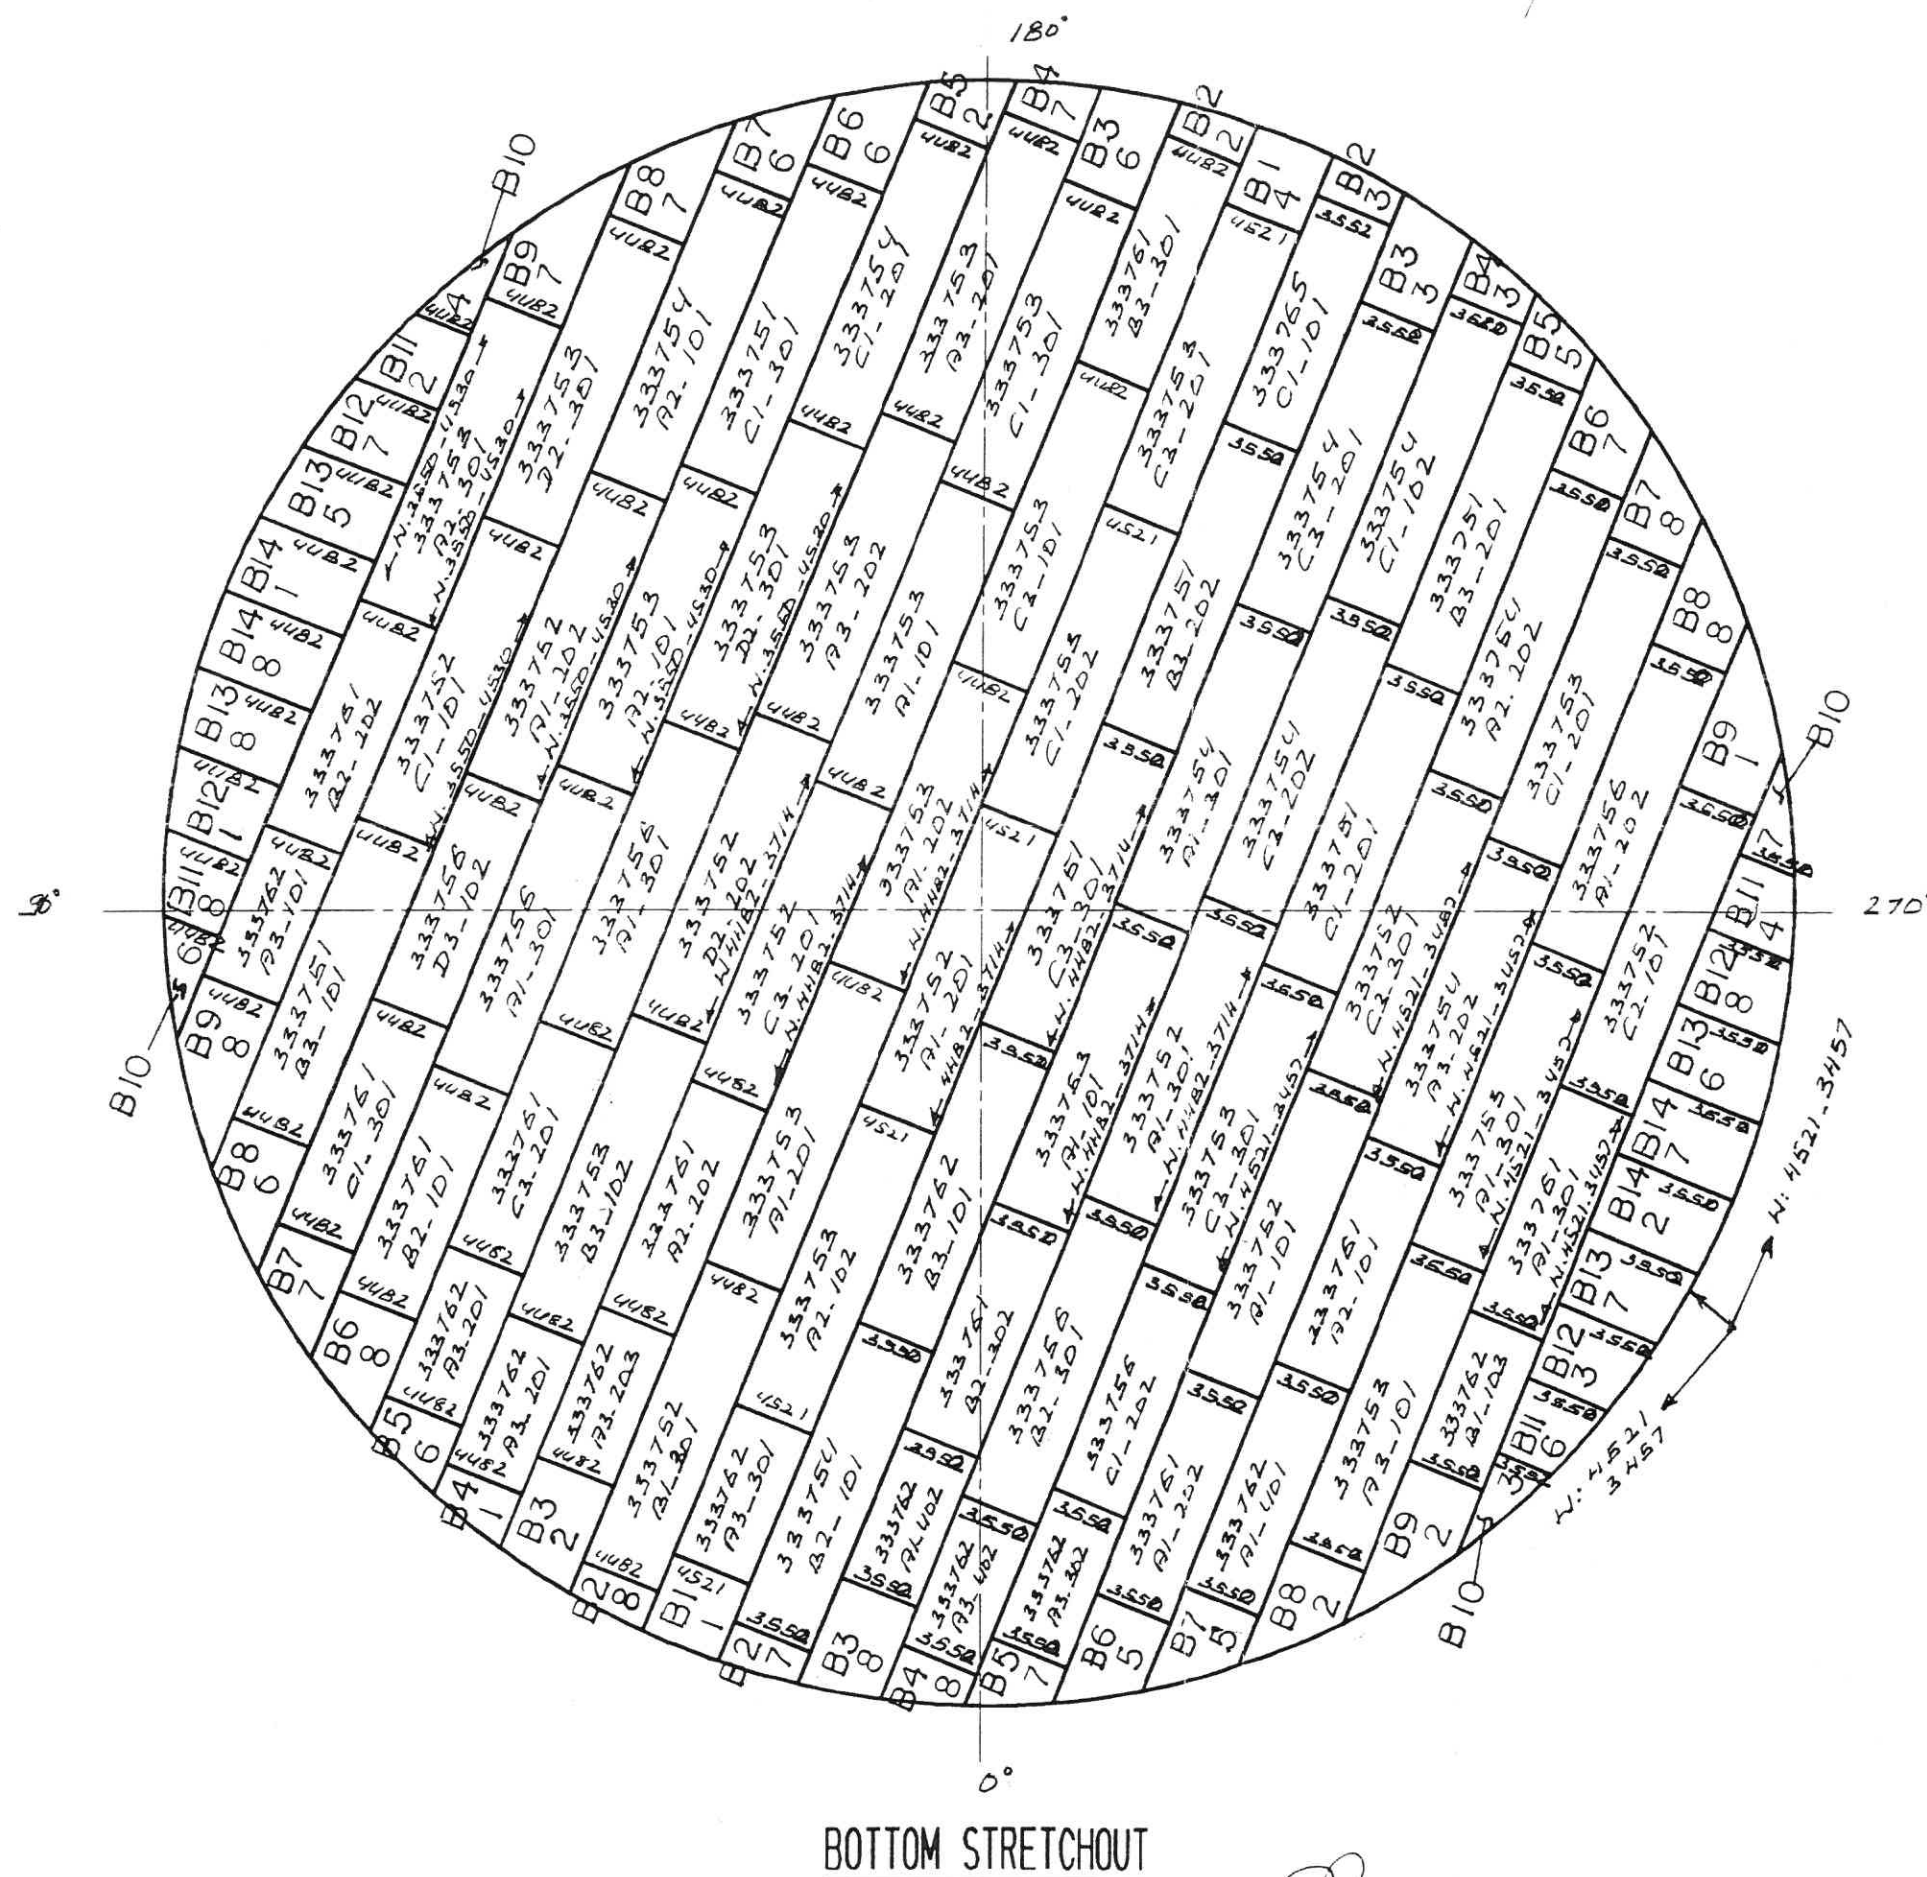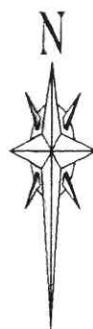

BOTTOM STRETCHOUT

NAME OF WELDER	I.D.
M. KHAN	3550
Z. KHATTAK	3457
M.M. HARIZ	3714
S. KHAN	4482
M. SARFARAZ	4521
N. MIR	4530

FOREMAN:

1. RECORD WELDERS' I.D. ON EACH JOINT.
2. RECORD JOINT ID AND RT INTERVALS (FIRST & LAST FOR 100%) OR LOCATION FOR SPOT RADIOGRAPHS OR PLUGS.

WHEN COMPLETE**FOREMAN:**

SEND CONSTRUCTION OFFICE ONE
LEGIBLE COPY AND WORK COPIES IF ANY

FOR CONSTRUCTION


BENZENE STORAGE TANK

BECHTEL LTD CONTRACT No. 22854-LCC-005


ARABIAN CBI LTD.	
BOTTOM STRETCHOUT 51.0m DIA. x 22.0m HIGH URT IBN RUSHD PTA AND AROMATICS PLANT PROJECT ARABIAN INDUSTRIAL FIBERS CO. LTD YANBU, SAUDI ARABIA	
ITEM NO. 103-F-001	CONTRACT NO. ED 965202
BY ZW CHKD RLH DATE 7/8/96	DWG R2A REV 0
R L HERBERT ENGINEERING SUPERVISOR	SHT
This drawing is the property of ACBI and is to be used only in conjunction with the performance of work by ACBI. Reproduction in whole or in part is expressly forbidden.	

INDICATES CHANGE FROM PREVIOUS ISSUE

11-2-97

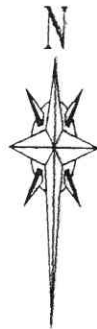

NAME OF WELDER	I.D.
C. K. PATHAN	3807
M. KHAN	3550
J. H. PATEL	17625

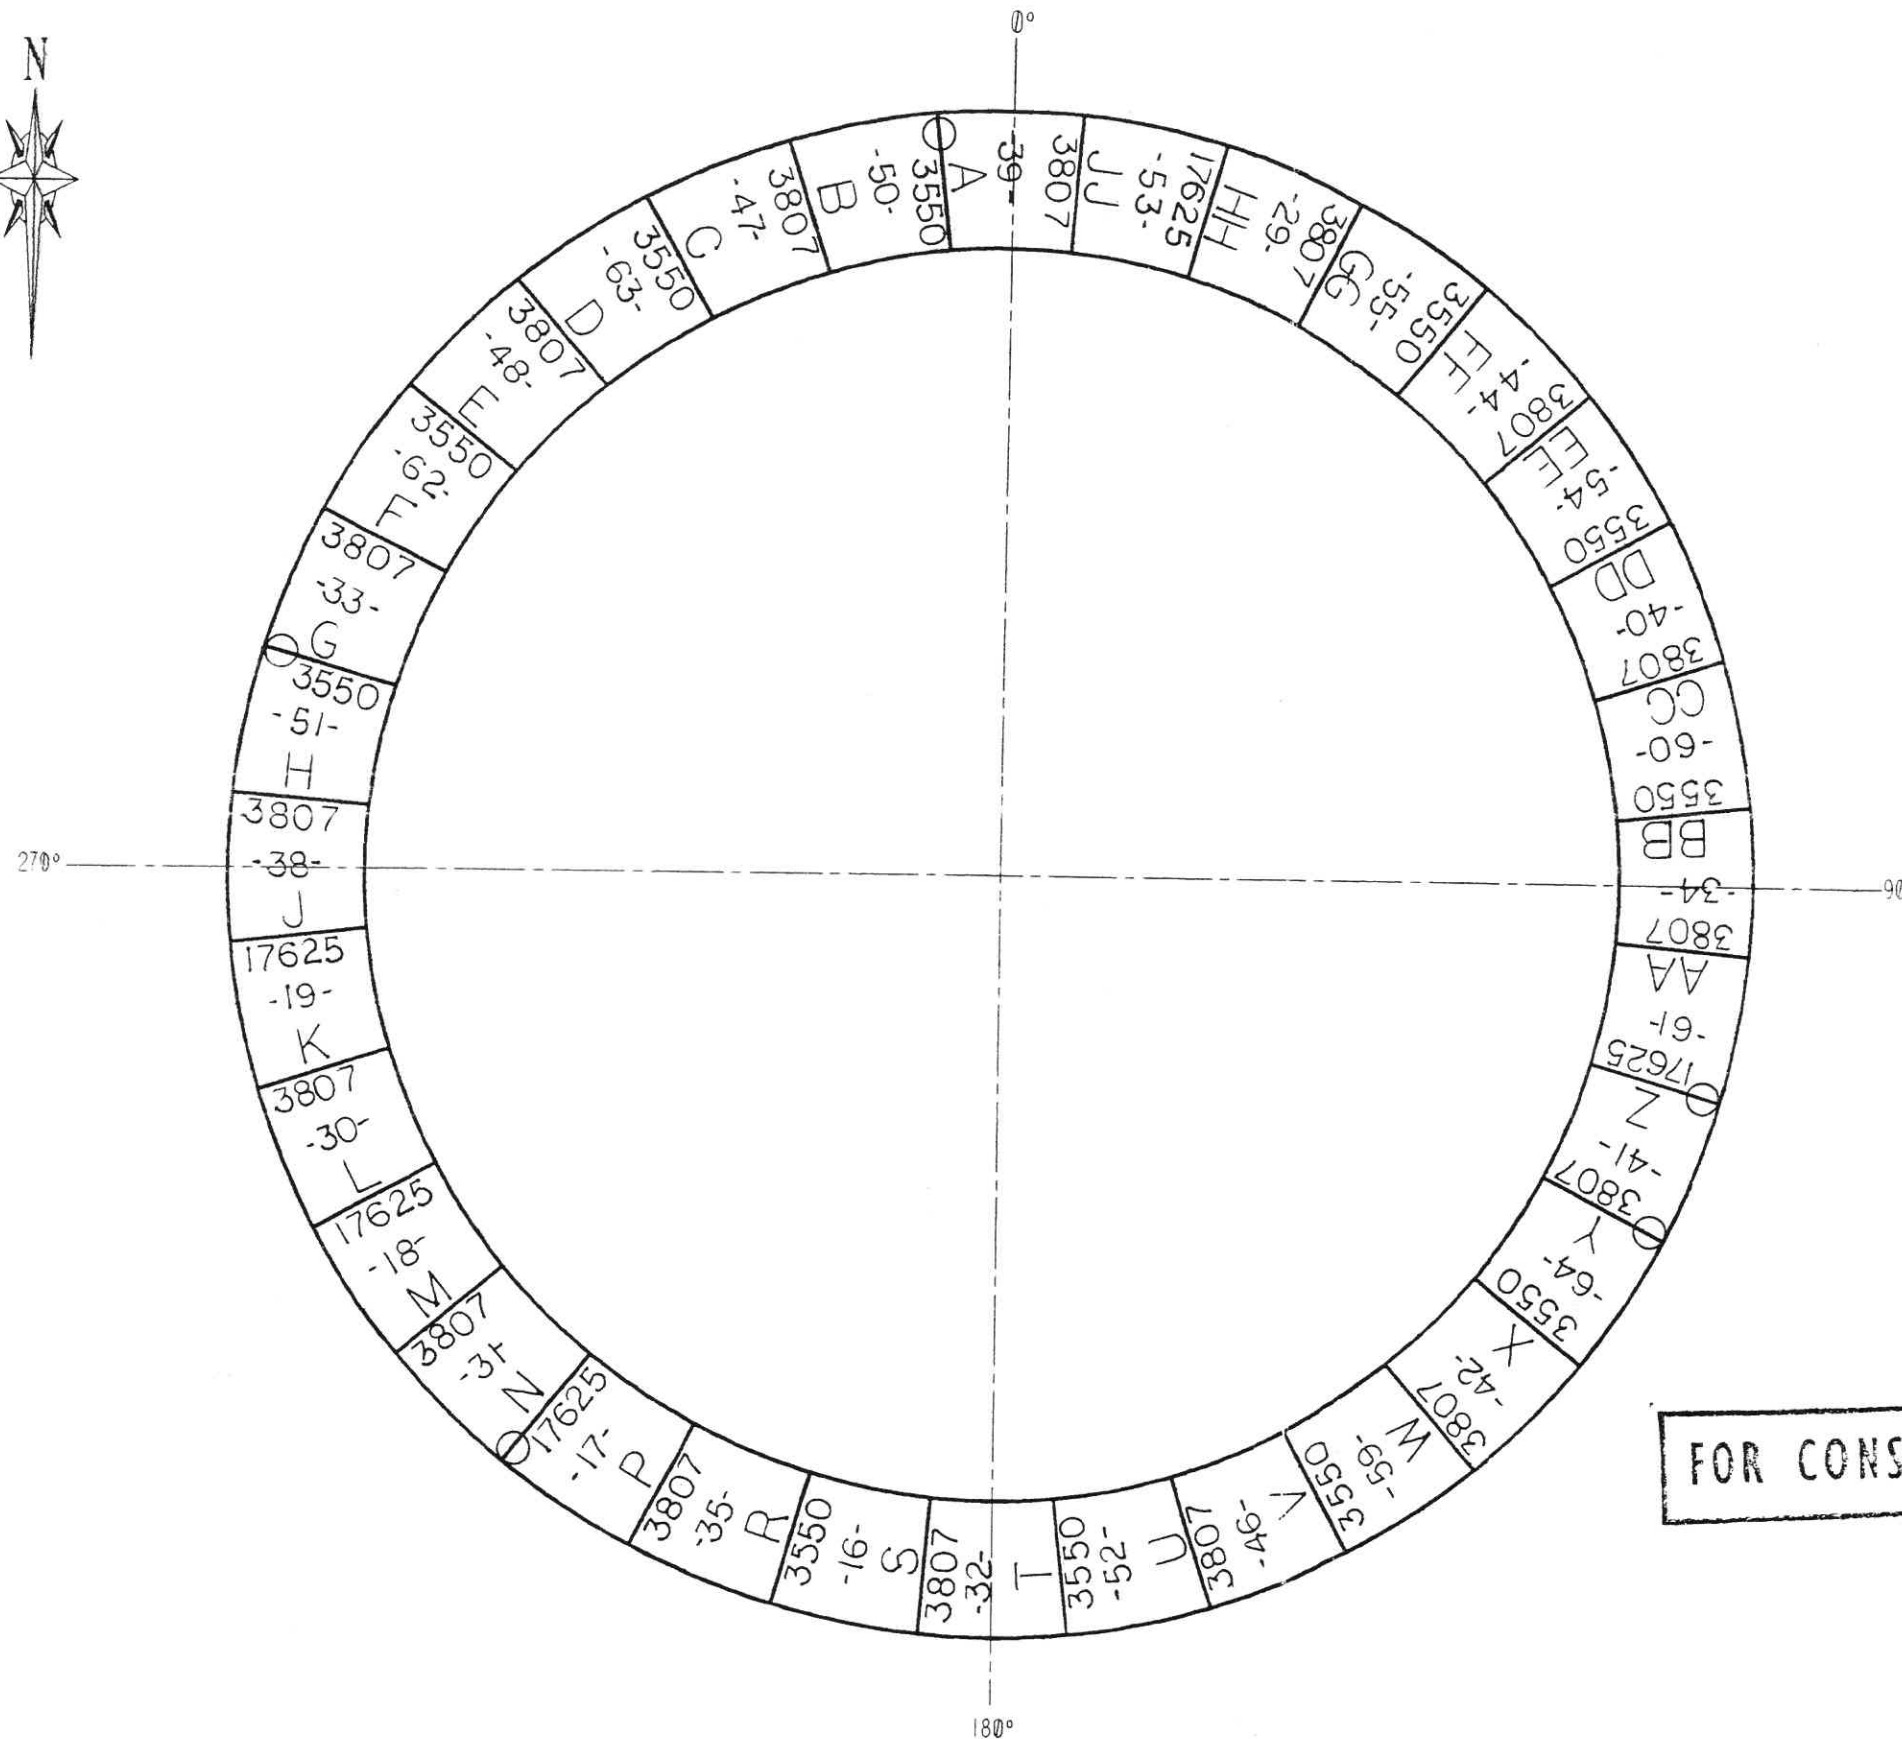

FOREMAN:

1. RECORD WELDERS' I.D. ON EACH JOINT.
2. RECORD JOINT ID AND RT INTERVALS (FIRST & LAST FOR 100%) OR LOCATION FOR SPOT RADIOGRAPHS OR PLUGS.

WHEN COMPLETE

FOREMAN:

SEND CONSTRUCTION OFFICE ONE LEGIBLE COPY AND WORK COPIES IF ANY

N. A. UMANI
SAJCO

FOR CONSTRUCTION

BENZENE STORAGE TANK

BECHTEL LTD CONTRACT No. 22854-LCC-005

ANNULAR PLATE STRETCHOUT

		ARABIAN CBI LTD.	
		ANNULAR PLATE STRETCHOUT 51.0m DIA. x 22.0m HIGH URT IBN RUSHO PTA AND AROMATICS PLANT PROJECT ARABIAN INDUSTRIAL FIBERS CO. LTD YANBU, SAUDI ARABIA	
ITEM NO	103-F-001	CONTRACT NO	ED 965202
BY	ZW CHKD RLH DATE 7/8/96	DWG	R3A
ENGINEERING SUPERVISOR	R L HERBERT	REV	1
THIS DRAWING IS THE PROPERTY OF ACBI AND IS TO BE USED ONLY IN CONJUNCTION WITH THE PERFORMANCE OF WORK BY ACBI. REPRODUCTION IN WHOLE OR IN PART IS EXPRESSLY FORBIDDEN.		INDICATES CHANGE FROM PREVIOUS ISSUE	

TECHNICAL & CONSTRUCTION INFORMATION

SPECIFICATIONS

SPECIFIC GRAVITY	API 650-9th ED. (1993/94 ADD.)
SERVICE	APP. E.F. 1.2 & H
MAX DESIGN METAL TEMP.	85°C
MIN DESIGN METAL TEMP.	17°C
DESIGN PRESSURE	0.025 bar (g)
DESIGN VACUUM	0.006 bar (g)
DESIGN LIQUID LEVEL	19600 mm
DESIGN WIND VELOCITY	140 km/h (PER API 650)
SEISMIC	ZONE I (I=1.0, S=1.2)
ROOF LIVE LOAD	PER API 650
NOMINAL CAPACITY	1.2 KPa PLUS VACUUM
PUMP IN RATE	40030 m ³
PUMP OUT RATE	51 m ³ /hr
FOUNDATION	BY OTHERS
CONSTRUCTION	BY ARABIAN CBI
EROSION ALLOWANCE	
BOTTOM	1.0 mm
SHELL	1.0 mm
ROOF	1.0 mm
STRUCTURAL	1.0 mm (TOTAL)


MATERIAL SPEC

BOTTOM RECT.	A36
BOTTOM SKETCHES	A36
ANNULAR PLATES	A36
SHELL PLATES	ISO 630-FE510C & A36
ROOF PLATES	A36
STRUCTURAL	A36
FLANGES	A105
NOZZLE NECKS	A106B
INTERNAL PIPE	A106B
INSPECTION - MILL	CTR'S
SHOP	ACBI
FIELD	ACBI & CUSTOMER
SURFACE PREPARATION	YES
PAINTING	YES
PWHT	ALL REINF. NOZZ. IN 15" RING
INSULATION	NO
MISC.	
GASKETS	REINZ-AFM37
BOLTS & NUTS	A193-B7 & A194-2H
RADIOGRAPHY	PER CODE
JOINT EFFICIENCY	N/A



DESIGN DATA

DESIGN DATA								
RING NO.	CORR. ALLOW. mm	DESIGN FOR PRODUCT PRODUCT SG = 0.857		DESIGN FOR TEST SG = 1.0		THK. USED mm	MATERIAL SPECIFICATION	API MAT'L GROUP NO
		ALLOWABLE STRESS MPa	REQUIRED THK. mm	ALLOWABLE STRESS MPa	REQUIRED THK. mm			
1	1.0	206.8	21.30	221.6	22.10	22.10	ISO 630-FE510C	IV
2	1.0	206.8	17.95	221.6	18.42	18.42	ISO 630-FE510C	IV
3	1.0	206.8	15.19	221.6	15.41	15.41	ISO 630-FE510C	IV
4	1.0	206.8	12.43	221.6	12.42	12.45	ISO 630-FE510C	IV
5	1.0	206.8	9.69	221.6	9.43	10.21	ISO 630-FE510C	IV
6	1.0	160.0	8.97	171.7	8.68	10.00	A36	I
7	1.0	160.0	5.09	171.7	4.43	10.00	A36	I
8	1.0	160.0	1.69	171.7	0.74	10.00	A36	I

SEE FITTING DRAWING

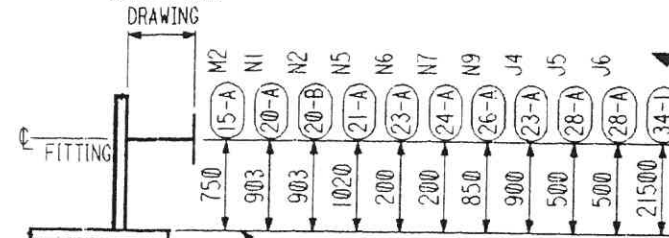

SHELL FITTING ELEVATION

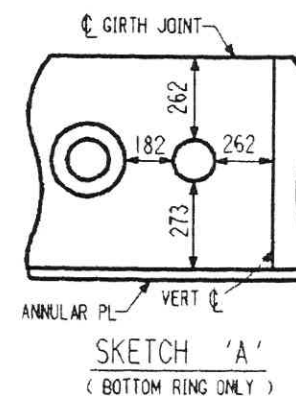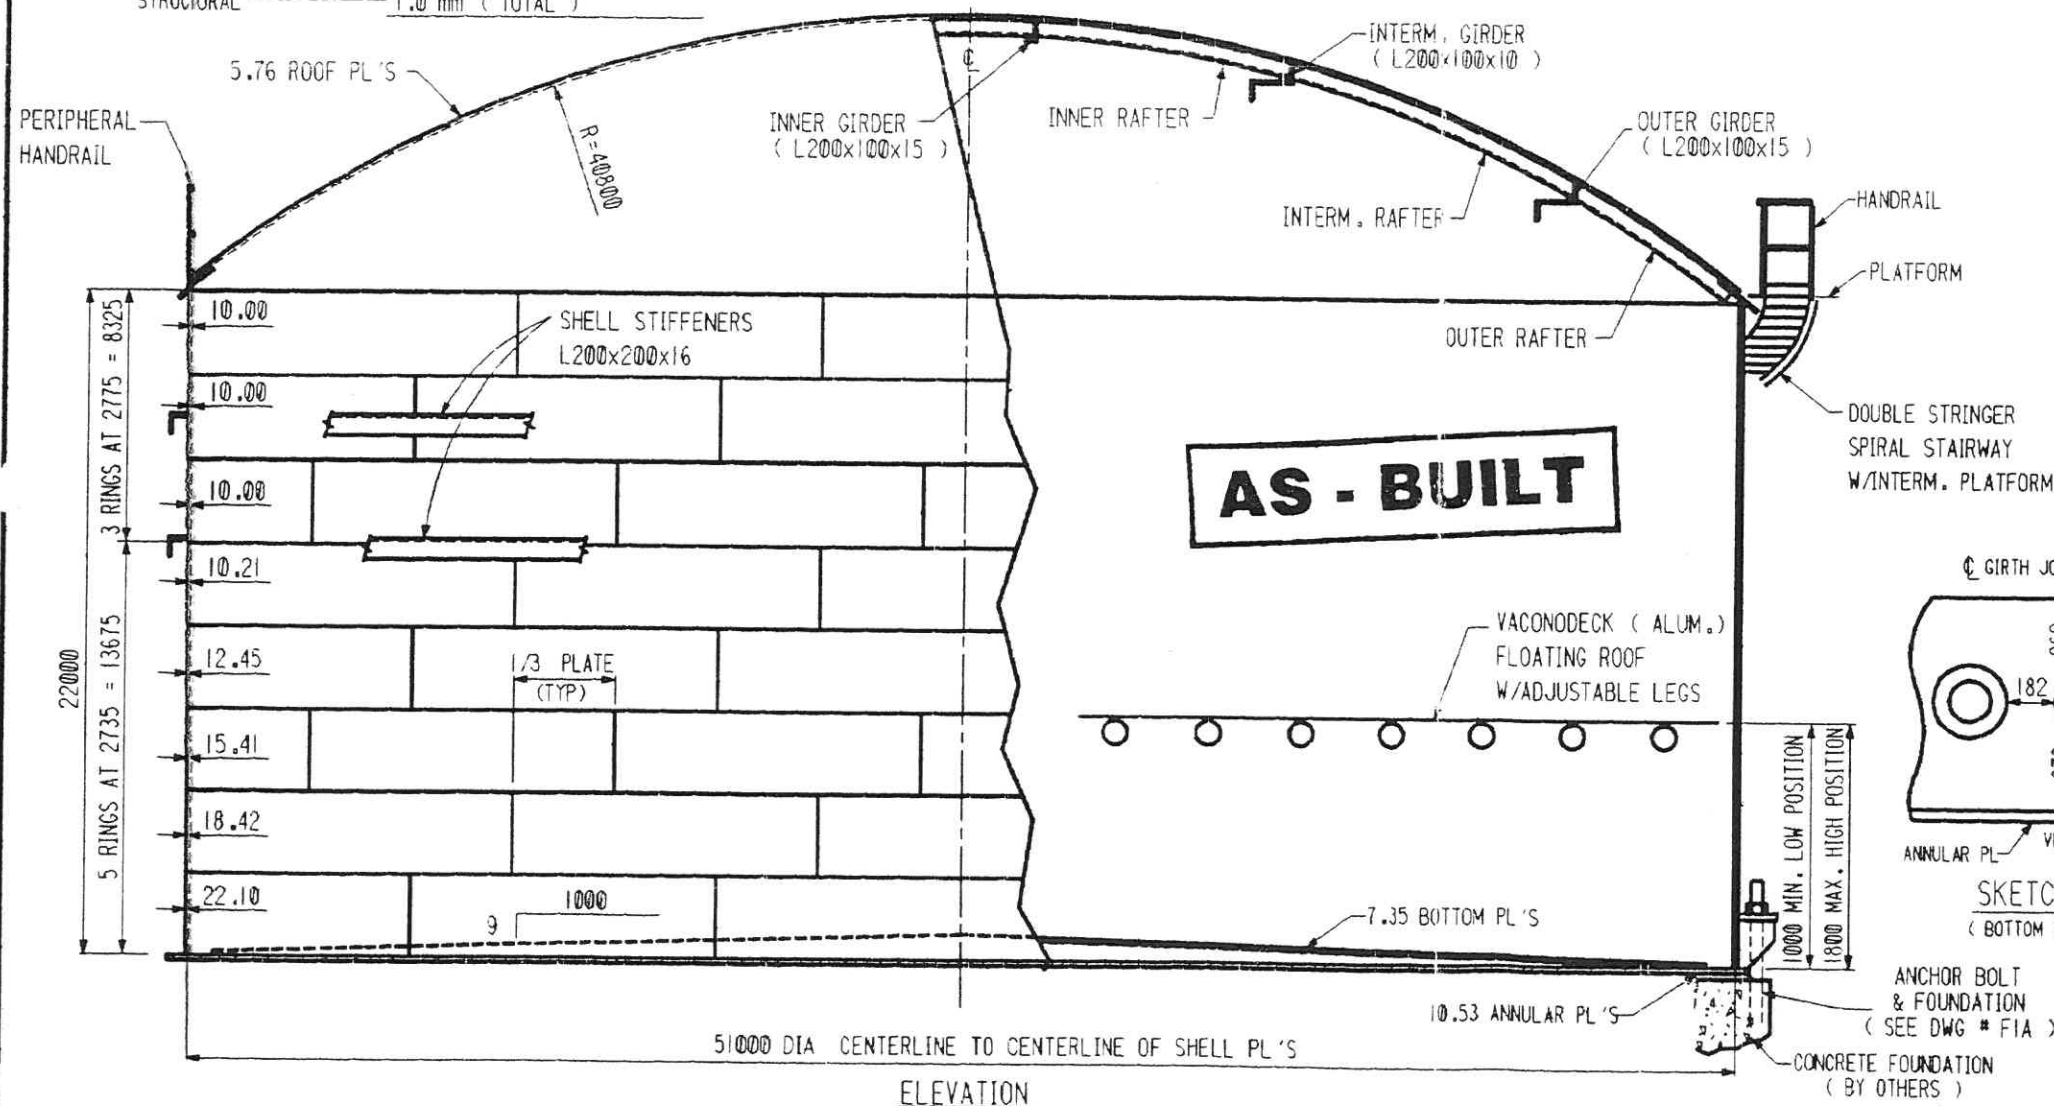SKETCH 'A'
(BOTTOM RING ONLY)ANCHOR BOLT
& FOUNDATION
(SEE DWG # FIA)CONCRETE FOUNDATION
(BY OTHERS)

INDICATES CHANGE FROM PREVIOUS ISSUE

LIST OF FITTINGS

CUST. MARK	ACBI MARK	QUANT	SIZE	RATING	DESCRIPTION
M1	30-A	1	30"	API	ROOF MANWAY
M2	15-A	1	24"	API	SHELL MANHOLE
N1	20-A	1	10"	150 RF	SHELL NOZZLE INLET
N2	20-B	1	10"	300 RF	SHELL NOZZLE PUMP SPILLBACK
N3	31-A	1	6"	150 RF	ROOF NOZZLE VENT
J3A	39-A	1	12"	150 RF	VENT
N5	21-A	1	20"	150 RF	SHELL NOZZLE PUMP SUCTION W/INT.
N6	23-A	1	2"	150 RF	SHELL NOZZLE PURGE CONNECTION
N7	24-A	1	6"	150 RF	SHELL NOZZLE DRAIN W/INT.
N8	25-A	1	8"	150 RF	ROOF NOZZLE LEVEL SERVICE W/INT.
N9	26-A	1	6"	150 RF	SHELL NOZZLE SPARE
-	34-I	5	8"	150 RF	FOAM CHAMBER
J1	33-A	1	2"	150 RF	ROOF NOZZLE (N ₂ BLANKETING)
J2A/B	33-4	2	3/4"	3000 CL	ROOF NOZZLE (N ₂ BLANKETING)
J3	32-A	1	10"	150 RF	ROOF NOZZLE (PSV)
J4	23-A	1	2"	150 RF	SHELL NOZZLE TI
J5	28-A	1	4"	150 RF	SHELL NOZZLE LI
J6	28-A	1	4"	150 RF	SHELL NOZZLE LALL/AHH
17-A	1	1	60"		SUMP
DWG#18	1	1			NAMEPLATE
	1	1			PERIPHERAL HANDRAIL
DWG#50	1	1			SPIRAL STAIRWAY
	1	1			VACONODECK
DWG#19	1	1			ANCHOR CHAIRS
	1 SET	1			CATHODIC PROTECTION (EXT.)
DWG#45					DELUGE SYSTEM
DWG#29	4				GROUNDING LUGS
DWG#35	1				STILLING WELL
J7	12-A	1	12"		ROOF NOZZLE (EMERGENCY VENT)

GENERAL NOTES:

- FITTINGS TO BE LOCATED AS SHOWN ON ORIENTATION DRAWING(S). IF LOCATIONS ARE NOT GIVEN, LOCATE IN FIELD TO SUIT CUSTOMER MAINTAINING MINIMUM SPACING SHOWN IN SKETCH 'A'. DIMENSIONS GIVEN ARE FROM EDGE TO EDGE OF REINFORCING PL OR FROM CL OF BUTT WELD TO EDGE OF REINFORCING PL. THE LOCATION DIMENSION SHOWN IN SKETCH 'A' ARE ONLY FOR NOZZLES 2" DIA AND LESS
- FLANGE BOLT HOLES TO STRADDLE VERTICAL CENTERLINE FOR SHELL NOZZLES.
- FLANGE BOLT HOLES TO STRADDLE 0°-180° CENTERLINE FOR ROOF NOZZLES
- SEE SHEETS 800 & 802 FOR MATERIAL MANAGEMENT.

DETAILED FOR (1) TANK - (1) TANK REQUIRED

BENZENE STORAGE TANK

BECHTEL LTD CONTRACT No. 22854-LCC-005
(22854-000-F-001)

ARABIAN CBI LTD.

GENERAL ARRANGEMENT

51.0m DIA. x 22.0m HIGH URT
 ISN RUSHD PTA AND AROMATICS PLANT PROJECT
 ARABIAN INDUSTRIAL FIBERS CO. LTD
 YANBU, SAUDI ARABIA

ITEM NO 103-F-001

BY KEY CHKD MSTRG DATE 3/15/96

R.L. HERBERT

ENGINEERING SUPERVISOR

CONTRACT NO

ED 965202

SHT


REV 5

This drawing is the property of ACBI and is to be used only in conjunction with the performance of work by ACBI. Reproduction in whole or in part is expressly forbidden.


TECHNICAL & CONSTRUCTION INFORMATION

SPECIFICATIONS	API 650-9th ED.(1993/94 ADD)	MATERIAL SPEC
SPECIFIC GRAVITY	0.846	BOTTOM RECT. A36
SERVICE	PARA-XYLENE	BOTTOM SKETCHES A36
MAX DESIGN METAL TEMP.	85°C	ANNULAR PLATES A36
MIN DESIGN METAL TEMP.	17°C	SHELL PLATES ISO 630-FE510C & A36
DESIGN PRESSURE	0.025 bar (g)	ROOF PLATES A36
DESIGN VACUUM	0.006 bar (g)	STRUCTURAL A36
DESIGN LIQUID LEVEL	19100 mm	FLANGES A105
DESIGN WIND VELOCITY	140 km/h (PER API 650)	NOZZLE NECKS A106B
SEISMIC	ZONE I (I=1.0, S=1.2)	INTERNAL PIPE A106B
ROOF LIVE LOAD	PER API 650	INSPECTION - MILL CTR'S
NOMINAL CAPACITY	24000 m ³	SHOP ACBI
PUMP IN RATE	55 m ³ /hr	FIELD ACBI & CUSTOMER
PUMP OUT RATE	1000 m ³ /hr	SURFACE PREPARATION YES
FOUNDATION	BY OTHERS	PAINTING YES
CONSTRUCTION	BY ARABIAN CBI	PWHT ALL REINF. NOZZ. IN 1st RING
CORROSION ALLOWANCE		INSULATION YES
BOTTOM	1.0 mm	MISC.
SHELL	1.0 mm	GASKETS REINZ-AFM37
ROOF	1.0 mm	BOLTS & NUTS A193-B7 & A194-2H
STRUCTURAL	1.0 mm (TOTAL)	RADIOGRAPHY PER CODE
		JOINT EFFICIENCY N/A

RING NO.	CORR. ALLOW. mm	DESIGN FOR PRODUCT SG=0.846		DESIGN FOR TEST SG=1.0		THK. USED mm	MATERIAL SPECIFICATION	API MAT'L GROUP NO.
		ALLOWABLE STRESS MPa	REQUIRED THK. mm	ALLOWABLE STRESS MPa	REQUIRED THK. mm			
1	1.0	206.8	16.31	221.6	16.89	16.89	ISO 630-FE510C	IV
2	1.0	206.8	13.87	221.6	14.17	14.17	ISO 630-FE510C	IV
3	1.0	206.8	11.72	221.6	11.80	11.80	ISO 630-FE510C	IV
4	1.0	206.8	9.57	221.6	9.44	9.57	ISO 630-FE510C	IV
5	1.0	206.8	7.43	221.6	7.08	8.20	ISO 630-FE510C	IV
6	1.0	160.0	6.58	171.7	6.14	8.20	A36	I
7	1.0	160.0	3.76	171.7	3.03	8.20	A36	I
8	1.0	160.0	1.12	171.7	0.13	8.20	A36	I

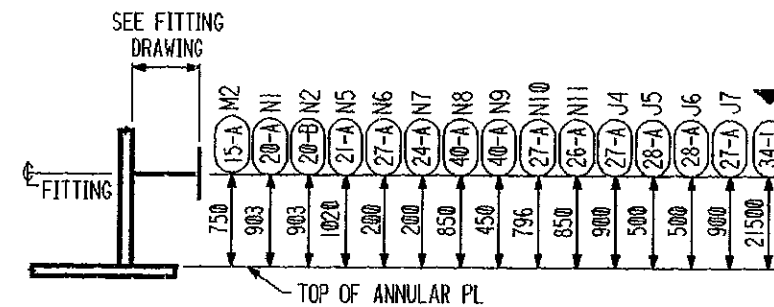

SHELL FITTING ELEVATION

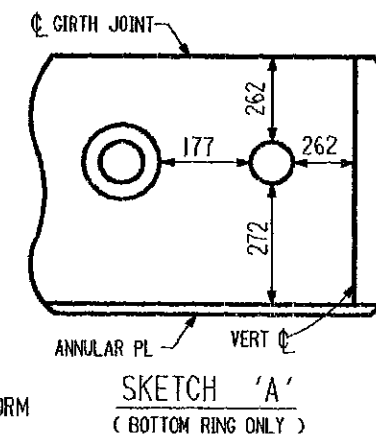


AS-BUILT

GENERAL NOTES:

- FITTINGS TO BE LOCATED AS SHOWN ON ORIENTATION DRAWING(S). IF LOCATIONS ARE NOT GIVEN, LOCATE IN FIELD TO SUIT CUSTOMER MAINTAINING MINIMUM SPACING SHOWN IN SKETCH 'A'. DIMENSIONS GIVEN ARE FROM EDGE TO EDGE OF REINFORCING PL OR FROM CL OF BUTT WELD TO EDGE OF REINFORCING PL. THE LOCATION DIMENSION SHOWN IN SKETCH 'A' ARE ONLY FOR NOZZLES 2" DIA AND LESS
- FLANGE BOLT HOLES TO STRADDLE VERTICAL CENTERLINE FOR SHELL NOZZLES.
- FLANGE BOLT HOLES TO STRADDLE 0°-180° CENTERLINE FOR ROOF NOZZLES.
- SEE SHEETS 800 & 802 FOR MATERIAL MANAGEMENT.

10000 MIN. LOW POSITION
18000 MAX. HIGH POSITION

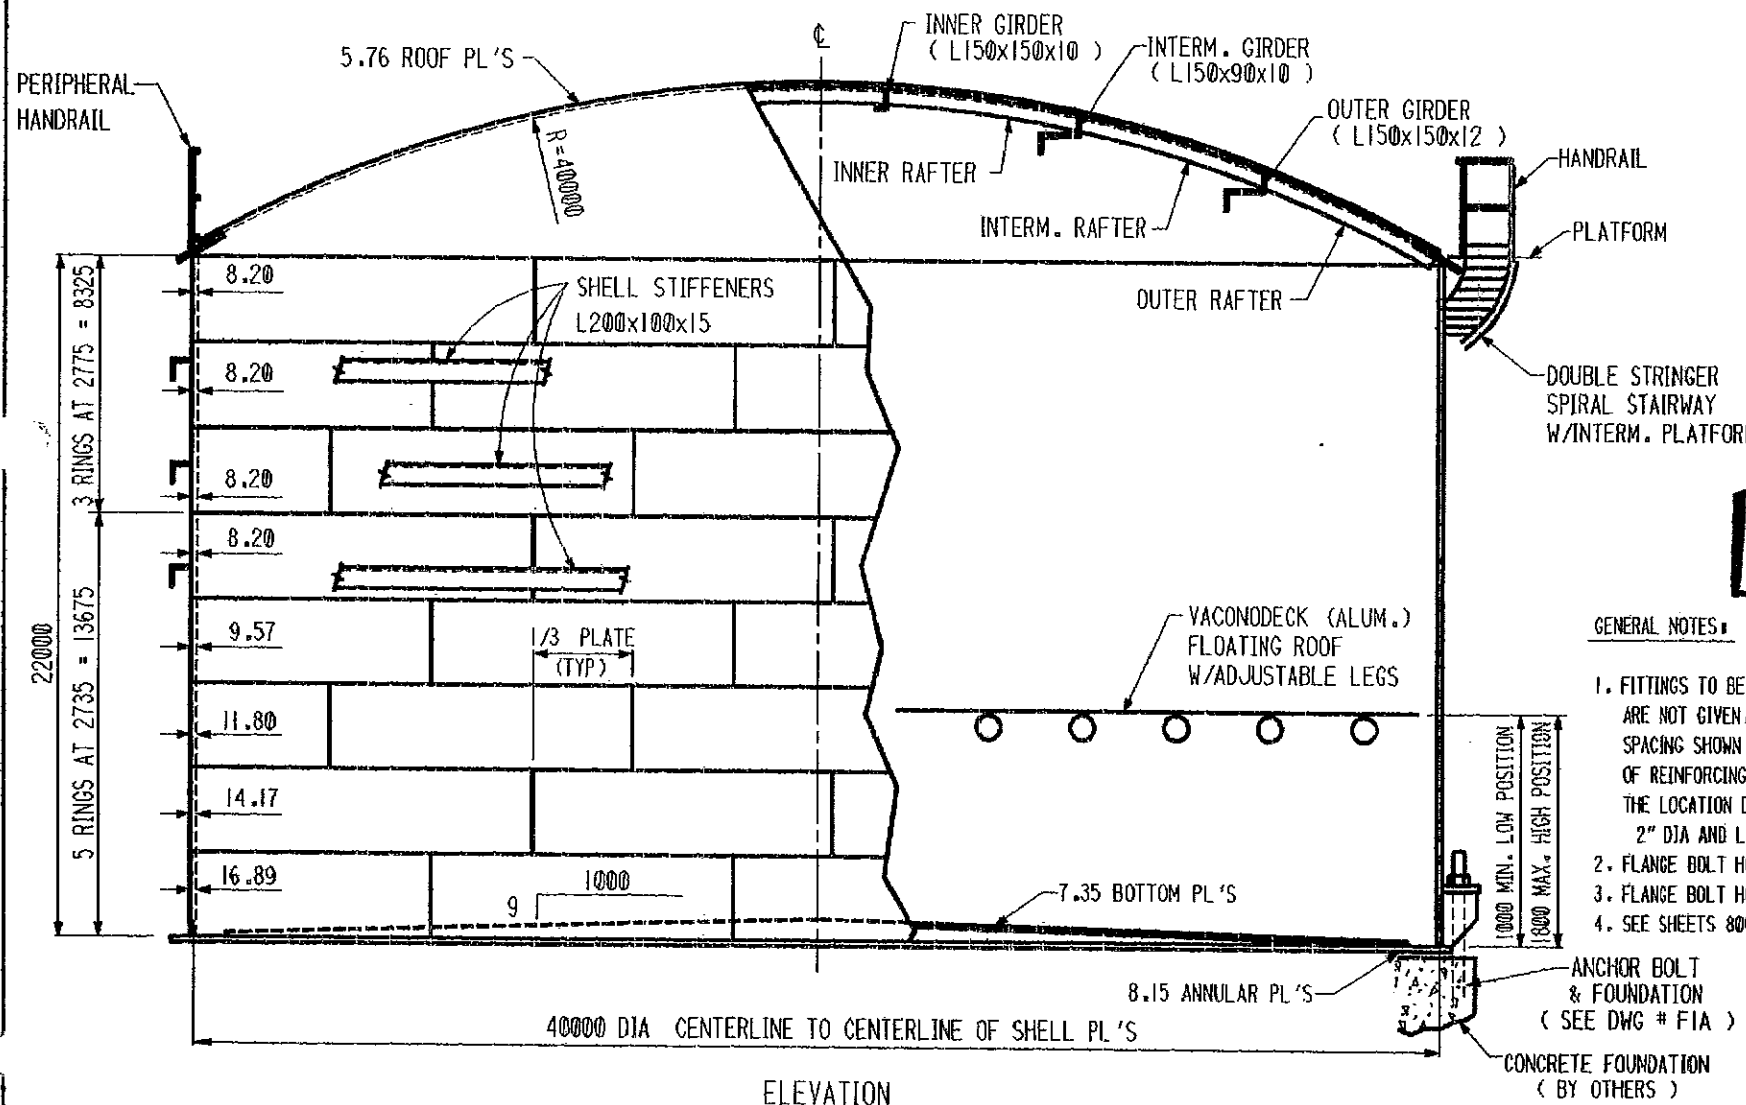

ELEVATION

LIST OF FITTINGS

CUST. MARK	ACBI MARK	QUANT	SIZE	RATING	DESCRIPTION
M1	30-A	1	30"	API	ROOF MANWAY
M2	15-A	1	24"	API	SHELL MANHOLE
N1	20-A	1	10"	150 RF	SHELL NOZZLE INLET
N2	20-B	1	10"	300 RF	SHELL NOZZLE PUMP SPILLBACK
N3	31-A	1	6"	150 RF	ROOF NOZZLE VENT
J3A	39-A	1	6"	150 RF	ROOF P/V VENT
N5	21-A	1	20"	150 RF	SHELL NOZZLE PUMP SUCTION W/INT.
N6	27-A	1	2"	150 RF	SHELL NOZZLE PURGE CONNECTION
N7	24-A	1	6"	150 RF	SHELL NOZZLE DRAIN W/INT.
N8	40-A	1	2"	150 RF	SHELL NOZZLE STEAM COIL INLET
N9	40-A	1	2"	150 RF	SHELL NOZZLE STEAM COIL OUTLET
N10	27-A	1	2"	150 RF	SHELL NOZZLE PUMP SPILLBACK
N11	26-A	1	6"	150 RF	SHELL NOZZLE SPARE
N12	35-A	1	8"	150 RF	ROOF NOZZLE LEVEL SERVO W/INT.
-	34-I	3	8"	150 RF	FOAM CHAMBER CONNECTION
J1	33-A	1	2"	150 RF	ROOF NOZZLE (N ₂ BLANKETING)
J2A/B	33-4	2	3/4"	3000 CL	ROOF NOZZLE (N ₂ BLANKETING)
J3	32-A	1	12"	150 RF	ROOF NOZZLE (PSV)
J4	27-A	1	2"	150 RF	SHELL NOZZLE TIC
J5	28-A	1	4"	150 RF	SHELL NOZZLE LT
J6	28-A	1	4"	150 RF	SHELL NOZZLE LALL/AAH
J7	27-A	1	2"	150 RF	SHELL NOZZLE TI
DWG#29	4				GROUNDING LUGS
DWG#18	1				NAMEPLATE
DWG#57	1				PERIPHERAL HANDRAIL
DWG#50	1				SPIRAL STAIRWAY
	1				VACONODECK
17-A	1		60"		SUMP
DWG#40-41					HEATER COIL
DWG#45					DELUGE SYSTEM
DWG#2-13					INSULATION SUPPORTS
DWG#19					ANCHOR CHAIRS
	1				ROOF PLATFORM
	1 SET				CATHODIC PROTECTION EXT.
DWG#35	1				STILLING WELL
J8	42-A	1	12"		ROOF NOZZLE (EMERGENCY VENT)

STEVE
SABCO
MAK

DETAILED FOR (1) TANK - (1) TANK REQUIRED

PARA-XYLENE STORAGE TANK


BECHTEL LTD CONTRACT No. 22854-LCC-005
(22854-000-F-001)

ARABIAN CBI LTD.	
GENERAL ARRANGEMENT	
40.0m DIA. x 22.0m HIGH URT	
IBN RUSHD PTA & AROMATICS PLANT PROJECT	
ARABIAN INDUSTRIAL FIBERS CO. LTD	
YANBU, SAUDI ARABIA	
ITEM NO. 103-F-003	CONTRACT NO. ED 965201
BY Key, CHKD MSG, DATE 3/15/96	DWG IA REV 5
R L HERBERT	SHT
ENGINEERING SUPERVISOR	
This drawing is the property of ACBI and is to be used only in conjunction with the performance of work by ACBI. Reproduction in whole or in part is expressly forbidden.	

INDICATES CHANGE FROM PREVIOUS ISSUE

10:54:21 Oct. 2, 1996

65201010.DGN

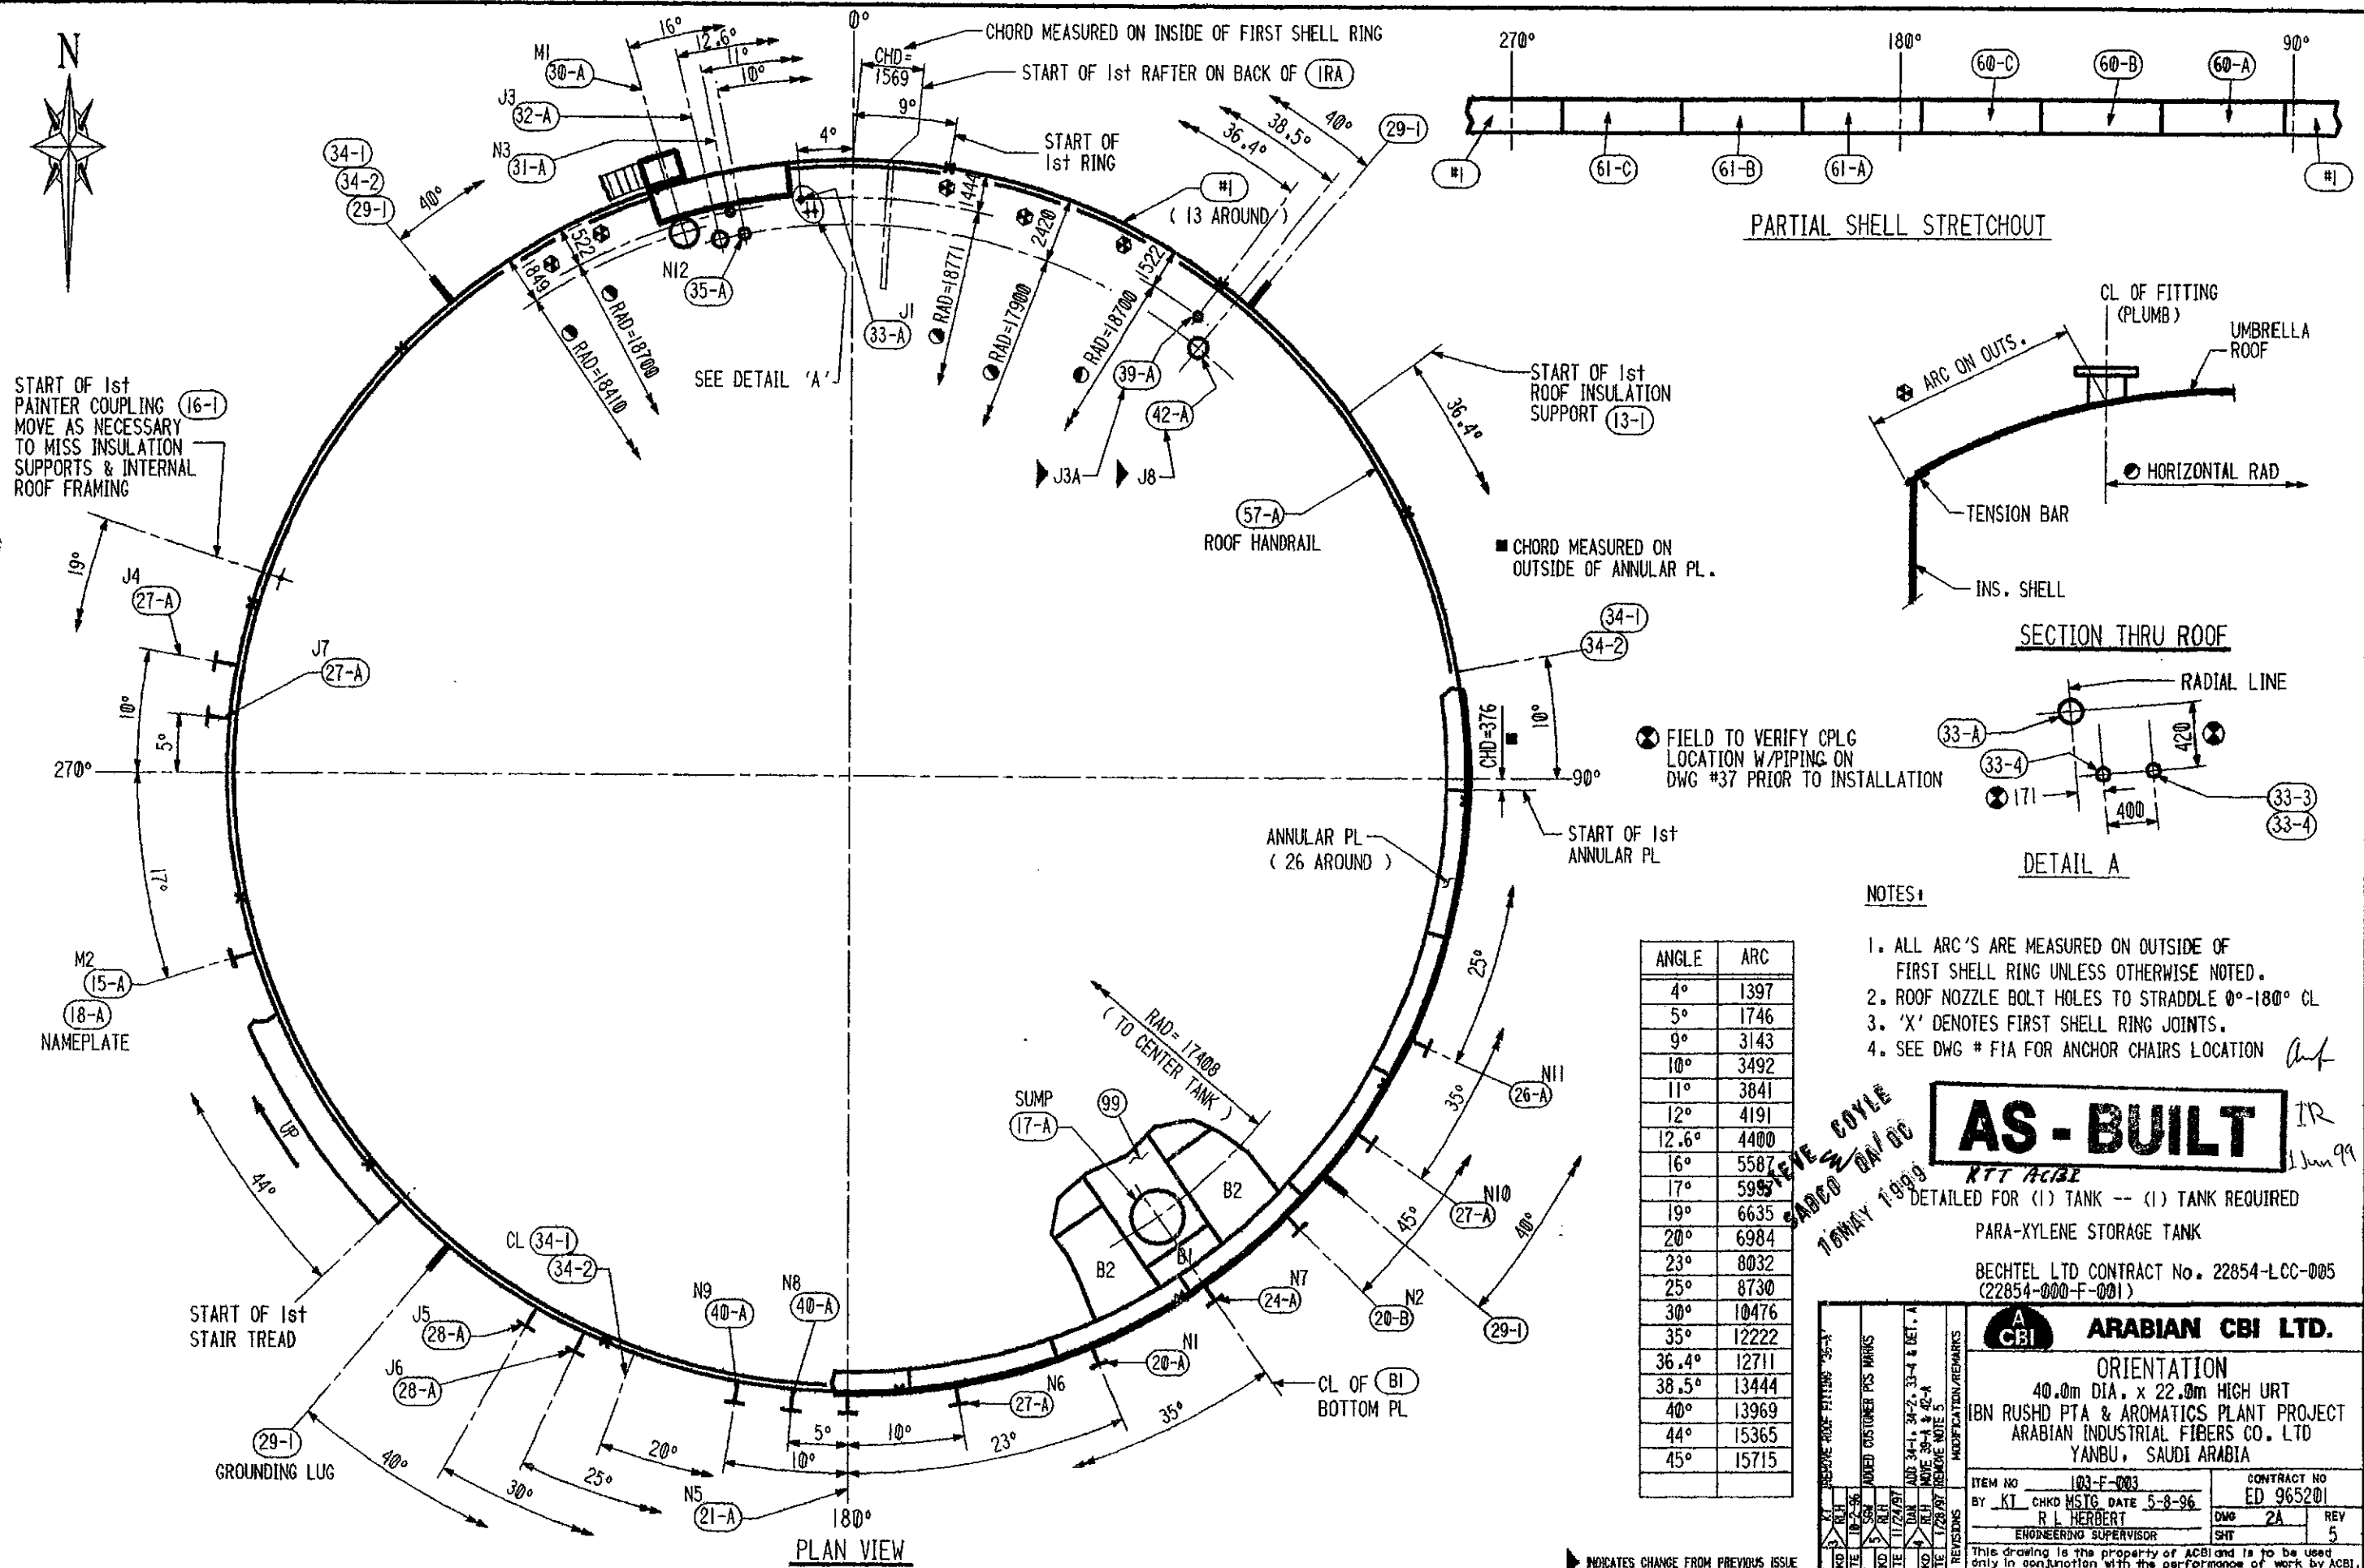

NOTES:

1. ALL ARC'S ARE MEASURED ON OUTSIDE OF FIRST SHELL RING UNLESS OTHERWISE NOTED.
2. ROOF NOZZLE BOLT HOLES TO STRADDLE 0°-180° CL
3. 'X' DENOTES FIRST SHELL RING JOINTS.
4. SEE DWG # FIA FOR ANCHOR CHAIRS LOCATION

AS - BUILT

RTT ACBI

DETAILED FOR (1) TANK -- (1) TANK REQUIRED

PARA-XYLENE STORAGE TANK

BECHTEL LTD CONTRACT No. 22854-LCC-005
(22854-000-F-001)

ARABIAN CBI LTD. ORIENTATION 40.0m DIA. x 22.0m HIGH URT IBN RUSHD PTA & AROMATICS PLANT PROJECT ARABIAN INDUSTRIAL FIBERS CO. LTD YANBU, SAUDI ARABIA	
ITEM NO 103-F-003 BY KI CHKD MSTRG DATE 5-8-96 R L HERBERT ENGINEERING SUPERVISOR	CONTRACT NO ED 965201 DWG 2A REV 5
This drawing is the property of ACBI and is to be used only in conjunction with the performance of work by ACBI. Reproduction in whole or in part is expressly forbidden.	

TECHNICAL & CONSTRUCTION INFORMATION

SPECIFICATIONS

API 650-9th ED. (1993/94 ADD.)	
APP E, F, I, 2, H	
SPECIFIC GRAVITY	0.88
SERVICE	ORTHOXYLENE
MAX DESIGN METAL TEMP.	85°C
MIN DESIGN METAL TEMP.	17°C
DESIGN PRESSURE	0.025 bar (g)
DESIGN VACUUM	0.006 bar (g)
DESIGN LIQUID LEVEL	16500 mm
DESIGN WIND VELOCITY	140 km/h (PER API 650)
SEISMIC	ZONE I (I=1.0, S=1.2)

ROOF LIVE LOAD	1.2 KPa PLUS VACUUM
NOMINAL CAPACITY	5180 m ³
PUMP IN RATE	37 m ³ /hr
PUMP OUT RATE	1000 m ³ /hr
FOUNDATION	BY OTHERS
CONSTRUCTION	BY ARABIAN CBI

CORROSION ALLOWANCE


BOTTOM	1.0 mm
SHELL	1.0 mm
ROOF	1.0 mm
STRUCTURAL	1.0 mm

MATERIAL SPEC


BOTTOM RECT.	A36
BOTTOM SKETCHES	A36
SHELL PLATES	A36
ROOF PLATES	A36
STRUCTURAL	A36
FLANGES	A105
NOZZLE NECKS	A53B SMLS OR A106B
INTERNAL PIPE	A53B SMLS OR A106B
INSPECTION - MILL	CTR'S
SHOP	ACBI
FIELD	ACBI & CUSTOMER
SURFACE PREPARATION	YES
PAINTING	YES
PWHT	NONE
INSULATION	NONE
MISC.	
GASKETS	REINZ-AFM37
BOLTS & NUTS	A193-B7 & A194-2H
RADIOGRAPHY	PER CODE
JOINT EFFICIENCY	N/A

RING NO.	CORR. ALLOW. mm	DESIGN FOR PRODUCT SG = 0.88		DESIGN FOR TEST SG = 1.0		THK. USED mm	MATERIAL SPECIFICATION	API MAT'L GROUP NO.
		ALLOWABLE STRESS MPa	REQUIRED THK. mm	ALLOWABLE STRESS MPa	REQUIRED THK. mm			
1	1.0	160.0	9.89	171.7	9.41	9.89	* A36	I
2	1.0	160.0	8.42	171.7	7.85	8.42	* A36	I
3	1.0	160.0	6.98	171.7	6.32	8.42	* A36	I
4	1.0	160.0	5.54	171.7	4.80	7.38	* A36	I
5	1.0	160.0	4.11	171.7	3.29	7.38	* A36	I
6	1.0	160.0	2.68	171.7	1.78	7.38	* A36	I
7	1.0	160.0	1.27	171.7	0.29	7.38	* A36	I

* KILLED OR SEMI KILLED

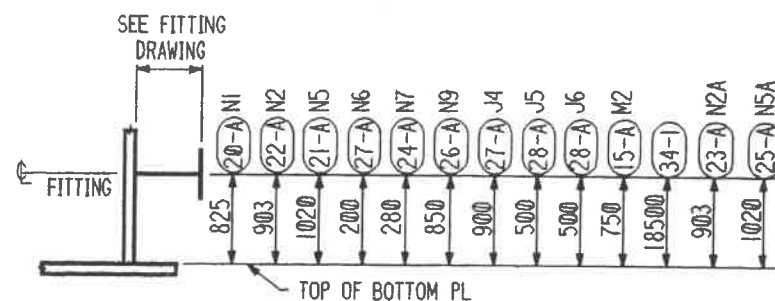

SHELL FITTING ELEVATION

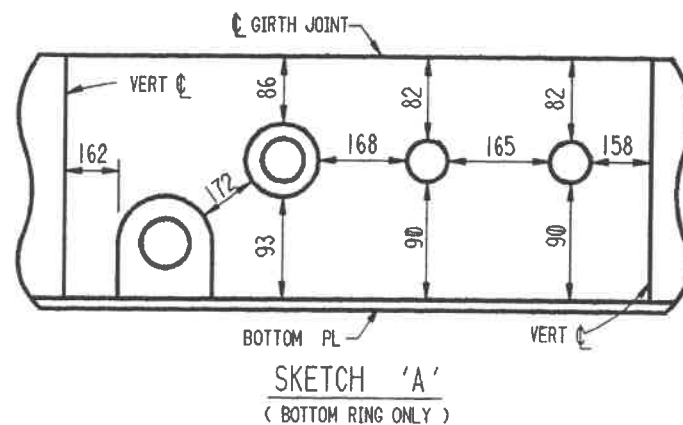SKETCH 'A'
(BOTTOM RING ONLY)

GENERAL NOTES:

1. FITTINGS TO BE LOCATED AS SHOWN ON ORIENTATION DRAWING(S). IF LOCATIONS ARE NOT GIVEN, LOCATE IN FIELD TO SUIT CUSTOMER MAINTAINING MINIMUM SPACING SHOWN IN SKETCH 'A'. DIMENSIONS GIVEN ARE FROM EDGE TO EDGE OF REINFORCING PL OR FROM CL OF BUTT WELD TO EDGE OF REINFORCING PL.
2. FLANGE BOLT HOLES TO STRADDLE VERTICAL CENTERLINE FOR SHELL NOZZLES.
3. FLANGE BOLT HOLES TO STRADDLE 0°-180° CENTERLINE FOR ROOF NOZZLES.
4. SEE SHEETS 800 & 802 FOR MATERIAL MANAGEMENT

AS - BUILTSTEVE COYLE
SABCO QA/QC
16 MAY 1999


INDICATES CHANGE FROM PREVIOUS ISSUE

LIST OF FITTINGS

CUST. MARK	ACBI MARK	QUANT	SIZE	RATING	DESCRIPTION
M1	30-A	1	30"	API	ROOF MANWAY
M2	15-A	1	24"	API	SHELL MANHOLE
N1	20-A	1	4"	150 RF	SHELL NOZZLE INLET
N2	22-A	1	10"	300 RF	SHELL NOZZLE SPARE W/BLIND
N3	31-A	1	6"	150 RF	ROOF NOZZLE VENT
N5	21-A	1	20"	150 RF	SHELL NOZZLE SPARE W/BLIND
N6	27-A	1	2"	150 RF	SHELL NOZZLE PURGE CONNECTION
N7	24-A	1	6"	150 RF	SHELL NOZZLE DRAIN W/INT.
N8	35-A	1	8"	150 RF	ROOF NOZZLE LEVEL SERVO W/INT.
N9	26-A	1	6"	150 RF	SHELL NOZZLE SPARE
	34-I	1	8"	150 RF	FOAM CHAMBER CONNECTION
J1	33-A	1	2"	150 RF	ROOF NOZZ (N ₂ BLANKETING)
J2A/B	33-4	2	3/4"	3000 CL	ROOF NOZZ (N ₂ BLANKETING)
J3	32-A	1	4"	150 RF	ROOF NOZZLE PSV
J4	27-A	1	2"	150 RF	SHELL NOZZLE TI
J5	28-A	1	4"	150 RF	SHELL NOZZLE LT
J6	28-A	1	4"	150 RF	SHELL NOZZLE LAHH/LALL
J3A	39-A	1	12"	150 RF	VENT
J7	42-A	1	12"	150 RF	ROOF NOZZLE (EMERGENCY VENT)
	DWG#18	1			NAMEPLATE
	DWG#38	1			INTERNAL LADDER
		1			PERIPHERAL HANDRAIL
	DWG#50	1			SPIRAL STAIRWAY
	DWG#29	4			GROUNDING LUG
		1			VACONODECK
	17-A	1	60"		SUMP
	DWG#45				DELUGE SYSTEM
	DWG#19				ANCHOR CHAIRS
	DWG#35	1			STILLING WELL
		1 SET			CATHODIC PROTECTION (EXT.)
N2A	23-A	1	10"	300 RF	SHELL NOZZLE PUMP SPILLBACK
N5A	25-A	1	20"	150 RF	SHELL NOZZLE PUMP SUCTION W/INT.

IR
1 Jun 99DETAILED FOR (1) TANK - (1) TANK REQUIRED
ORTHOXYLENE STORAGE TANKBECHTEL LTD CONTRACT No. 22854-LCC-005
(22854-000-F-001)

A CBI		ARABIAN CBI LTD.	
GENERAL ARRANGEMENT			
20.0m DIA. x 19.0m HIGH SS DRT			
IBN RUSHD PTA AND AROMATICS PLANT PROJECT			
ARABIAN INDUSTRIAL FIBERS CO. LTD			
YANBU, SAUDI ARABIA			
ITEM NO	103-F-005	CONTRACT NO	ED 965208
BY Key	CHKD MSG DATE 3/19/96	DWG	IA
R L HERBERT		REV	7
ENGINEERING SUPERVISOR		SHT	
This drawing is the property of ACBI and is to be used only in conjunction with the performance of work by ACBI. Reproduction in whole or in part is expressly forbidden.			

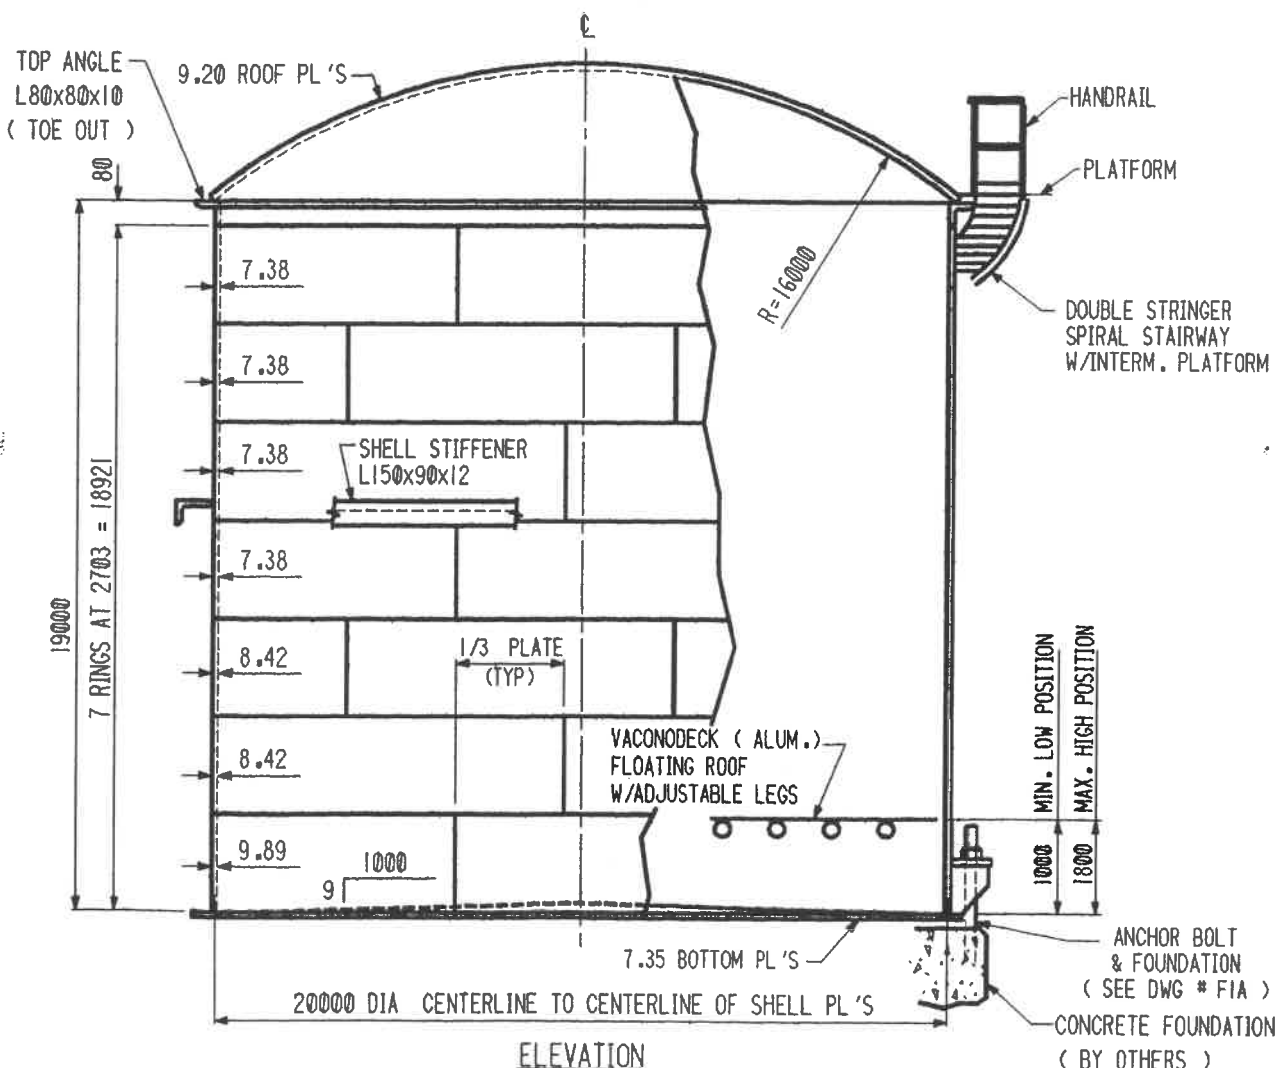

ELEVATION

07:53:14 Oct. 8, 1996


6520801b.DGN

TECHNICAL & CONSTRUCTION INFORMATION


SPECIFICATIONS		MATERIAL SPEC	
API 650-9th ED. (1993/94 ADD.)		BOTTOM RECT. — A36	
APP E, F, I.2, H		BOTTOM SKETCHES — A36	
SPECIFIC GRAVITY — 0.88		SHELL PLATES — A36	
SERVICE — ORTHOXYLENE		ROOF PLATES — A36	
MAX DESIGN METAL TEMP. — 85°C		STRUCTURAL — A36	
MIN DESIGN METAL TEMP. — 17°C		FLANGES — A105	
DESIGN PRESSURE — 0.025 bar (g)		NOZZLE NECKS — A53B SMLS OR A106B	
DESIGN VACUUM — 0.006 bar (g)		INTERNAL PIPE — A53B SMLS OR A106B	
DESIGN LIQUID LEVEL — 16500 mm		INSPECTION - MILL — CTR'S	
DESIGN WIND VELOCITY — 140 km/h (PER API 650)		SHOP — ACBI	
SEISMIC — ZONE I (I=1.0, S=1.2)		FIELD — ACBI & CUSTOMER	
PER API 650		SURFACE PREPARATION — YES	
ROOF LIVE LOAD — 1.2 KPa PLUS VACUUM		PAINTING — YES	
NOMINAL CAPACITY — 5180 m ³		PWHT — NONE	
PUMP IN RATE — 37 m ³ /hr		INSULATION — NONE	
PUMP OUT RATE — 1000 m ³ /hr		MISC. —	
FOUNDATION — BY OTHERS		GASKETS — REINZ-AFM37	
CONSTRUCTION — BY ARABIAN CBI		BOLTS & NUTS — A193-B7 & A194-2H	
CORROSION ALLOWANCE		RADIOGRAPHY — PER CODE	
BOTTOM — 1.0 mm		JOINT EFFICIENCY — N/A	
SHELL — 1.0 mm			
ROOF — 1.0 mm			
STRUCTURAL — 1.0 mm			

DESIGN DATA									
RING NO.	CORR. ALLOW. mm	DESIGN FOR PRODUCT ALLOWABLE STRESS MPa	DESIGN FOR TEST SG=0.88 REQUIRED THK. mm	DESIGN FOR TEST SG=1.0 ALLOWABLE STRESS MPa	DESIGN FOR TEST SG=1.0 REQUIRED THK. mm	THK. USED mm	MATERIAL SPECIFICATION	API MAT'L GROUP NO.	
1	1.0	160.0	9.89	171.7	9.41	9.89	* A36	I	
2	1.0	160.0	8.42	171.7	7.85	8.42	* A36	I	
3	1.0	160.0	6.98	171.7	6.32	8.42	* A36	I	
4	1.0	160.0	5.54	171.7	4.80	7.38	* A36	I	
5	1.0	160.0	4.11	171.7	3.29	7.38	* A36	I	
6	1.0	160.0	2.68	171.7	1.78	7.38	* A36	I	
7	1.0	160.0	1.27	171.7	0.29	7.38	* A36	I	

* KILLED OR SEMI KILLED

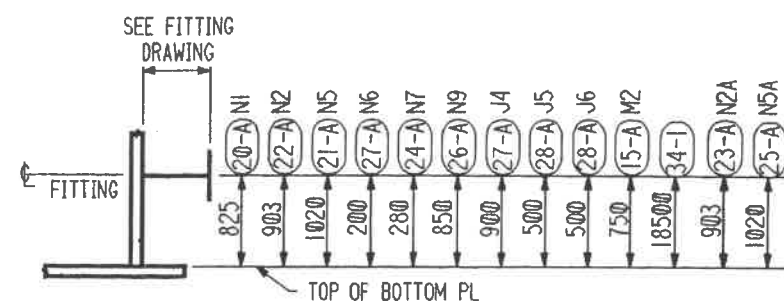

SHELL FITTING ELEVATION

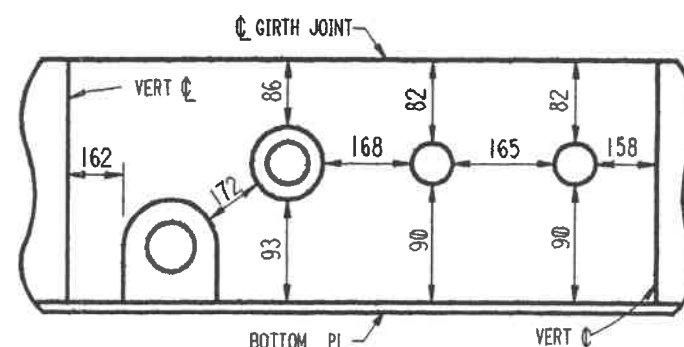SKETCH 'A'
(BOTTOM RING ONLY)

GENERAL NOTES:

1. FITTINGS TO BE LOCATED AS SHOWN ON ORIENTATION DRAWING(S). IF LOCATIONS ARE NOT GIVEN, LOCATE IN FIELD TO SUIT CUSTOMER MAINTAINING MINIMUM SPACING SHOWN IN SKETCH 'A'. DIMENSIONS GIVEN ARE FROM EDGE TO EDGE OF REINFORCING PL OR FROM CL OF BUTT WELD TO EDGE OF REINFORCING PL.
2. FLANGE BOLT HOLES TO STRADDLE VERTICAL CENTERLINE FOR SHELL NOZZLES.
3. FLANGE BOLT HOLES TO STRADDLE 0°-180° CENTERLINE FOR ROOF NOZZLES.
4. SEE SHEETS 800 & 802 FOR MATERIAL MANAGEMENT.

STEVE COYLE
SABCO QA/QC
16 MAY 1999

AS-BUILT

LIST OF FITTINGS


CUST. MARK	ACBI MARK	QUANT	SIZE	RATING	DESCRIPTION
M1	30-A	1	30"	API	ROOF MANWAY
M2	15-A	1	24"	API	SHELL MANHOLE
N1	20-A	1	4"	150 RF	SHELL NOZZLE INLET
N2	22-A	1	10"	300 RF	SHELL NOZZLE SPARE W/BLIND
N3	31-A	1	6"	150 RF	ROOF NOZZLE VENT
N5	21-A	1	20"	150 RF	SHELL NOZZ SPARE W/BLIND
N6	27-A	1	2"	150 RF	SHELL NOZZLE PURGE CONNECTION
N7	24-A	1	6"	150 RF	SHELL NOZZLE DRAIN W/INT.
N8	35-A	1	8"	150 RF	ROOF NOZZLE LEVEL SERVO W/INT.
N9	26-A	1	6"	150 RF	SHELL NOZZLE SPARE
J1	33-A	1	2"	150 RF	ROOF NOZZ (N2 BLANKETING)
J2A/B	33-4	2	3/4"	3000 CL	ROOF NOZZ (N2 BLANKETING)
J3	32-A	1	4"	150 RF	ROOF NOZZLE PSV
J4	27-A	1	2"	150 RF	SHELL NOZZLE TI
J5	28-A	1	4"	150 RF	SHELL NOZZLE LT
J6	28-A	1	4"	150 RF	SHELL NOZZLE LAHH/LALL
J3A	39-A	1	12"	150 RF	VENT
J7	42-A	1	12"	150 RF	ROOF NOZZLE (EMERGENCY VENT)
DWG#18	1				NAMEPLATE
DWG#38	1				INTERNAL LADDER
	1				PERIPHERAL HANDRAIL
DWG#50	1				SPIRAL STAIRWAY
DWG#29	4				GROUNDING LUG
	1				VACONODECK
17-A	1		60"		SUMP
DWG#45					DELUGE SYSTEM
DWG#19					ANCHOR CHAIRS
DWG#35	1				STILLING WELL
	1 SET				CATHODIC PROTECTION (EXT.)
N2A	23-A	1	10"	300 RF	SHELL NOZZLE PUMP SPILLBACK
N5A	25-A	1	20"	150 RF	SHELL NOZZLE PUMP SUCTION W/INT.

DETAILED FOR (1) TANK - (1) TANK REQUIRED
ORTHOXYLENE STORAGE TANK




BECHTEL LTD CONTRACT No. 22854-LCC-005
(22854-000-F-001)

ARABIAN CBI LTD. GENERAL ARRANGEMENT 20.0m DIA. x 19.0m HIGH SS DRT IBN RUSHD PTA AND AROMATICS PLANT PROJECT ARABIAN INDUSTRIAL FIBERS CO. LTD YANBU, SAUDI ARABIA	
ITEM NO 103-F-006 BY Key CHKD MSG DATE 3/19/96 R L HERBERT ENGINEERING SUPERVISOR	CONTRACT NO ED 965208 DWG 18 REV 7
This drawing is the property of ACBI and is to be used only in conjunction with the performance of work by ACBI. Reproduction in whole or in part is expressly forbidden.	

INDICATES CHANGE FROM PREVIOUS ISSUE

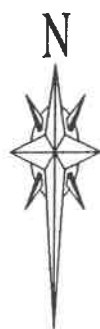

ANGLE	ARC
1°	175
10°	1746
10.5°	1834
11.5°	2008
15°	2619
20°	3492
23°	4016
25°	4365
29°	5064
30°	5239
32°	5588
35°	6112
37°	6461
39°	6810
40°	6985
41°	7159
44°	7683
45°	7858

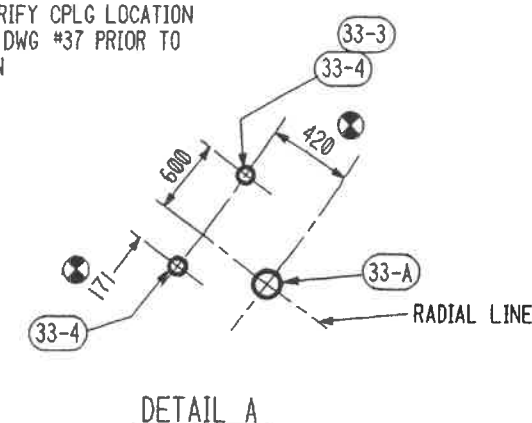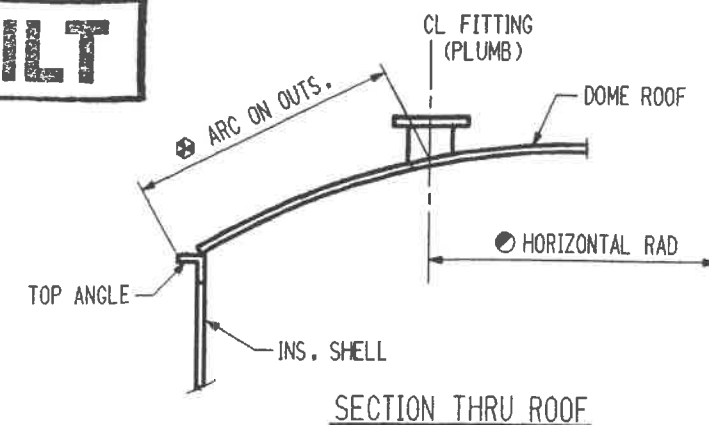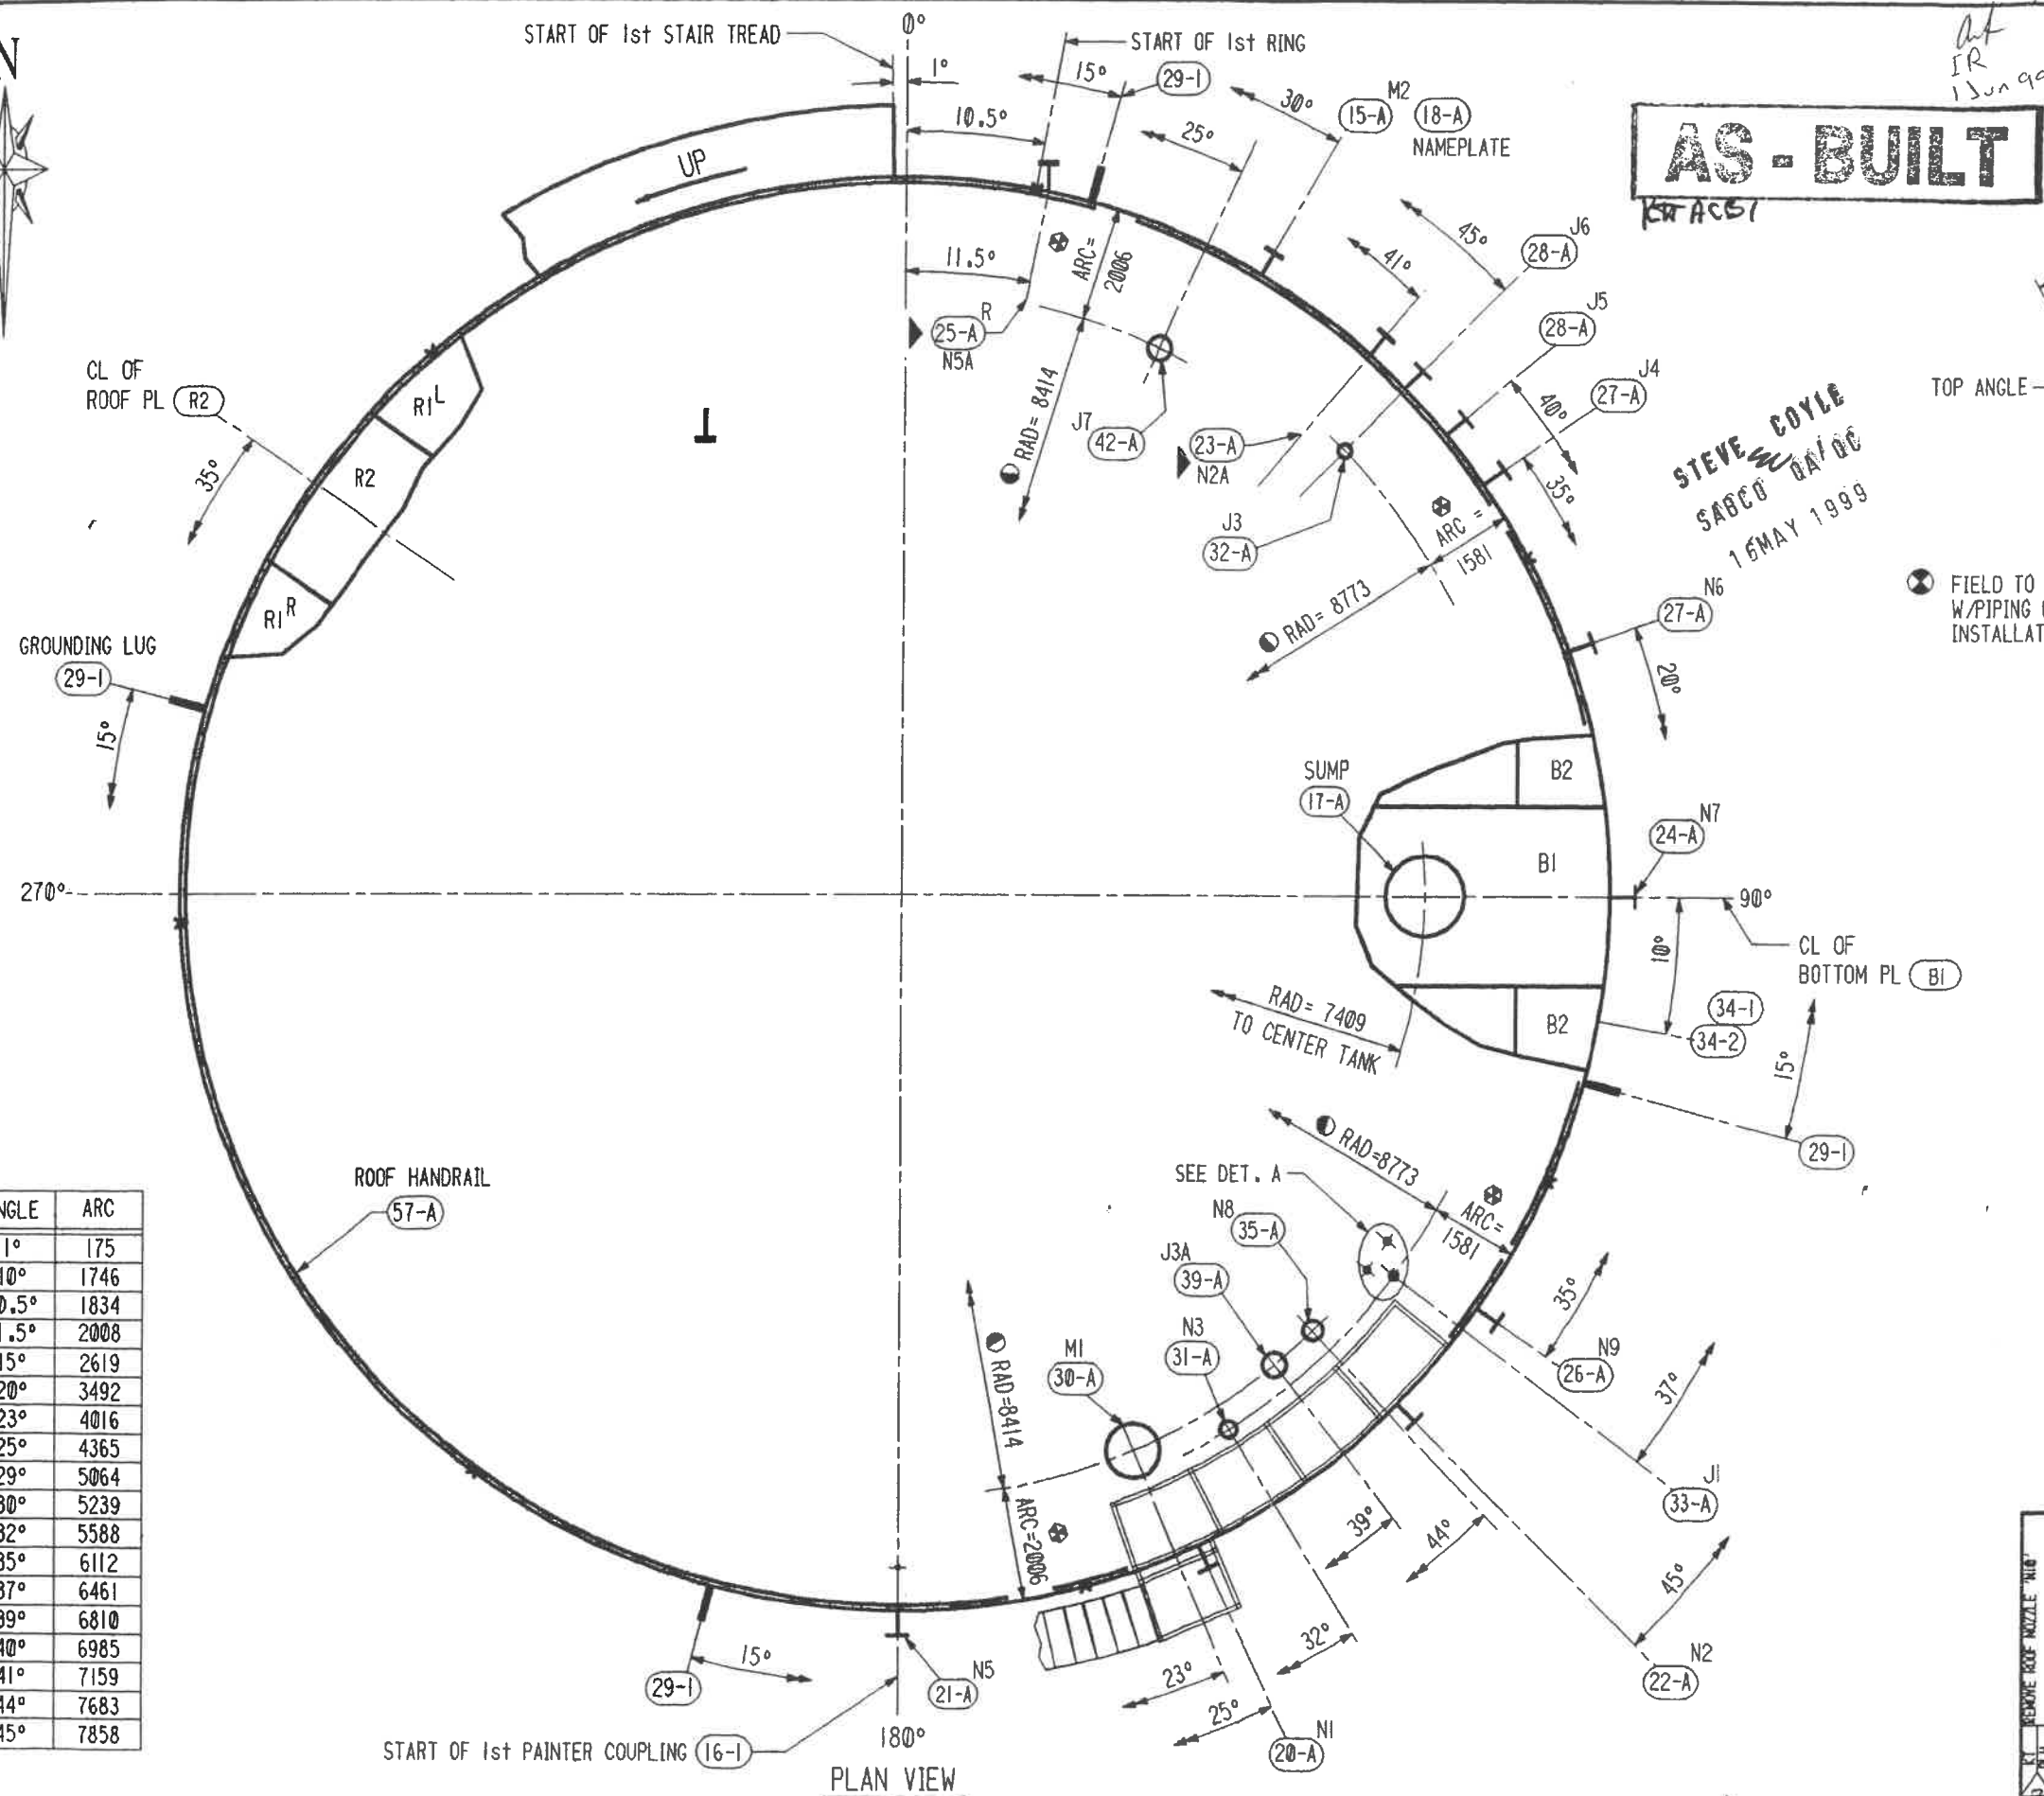

NOTES:

1. ALL ARC'S ARE MEASURED ON OUTSIDE OF FIRST SHELL RING UNLESS OTHERWISE NOTED.
2. ROOF NOZZLE BOLT HOLES TO STRADDLE 0°-180° CL
3. 'X' DENOTES FIRST SHELL RING JOINTS.
4. SEE DWG # FIA FOR ANCHOR CHAIRS LOCATION

DETAILED FOR (1) TANK -- (1) TANK REQUIRED
ORTHOXYLENE STORAGE TANK

BECHTEL LTD CONTRACT No. 22854-LCC-005
(22854-000-F-001)

ARABIAN CBI LTD.	
ORIENTATION	
20.0m DIA. x 19.0m HIGH SS DRT IBN RUSHD PTA AND AROMATICS PLANT PROJECT ARABIAN INDUSTRIAL FIBERS CO. LTD YANBU, SAUDI ARABIA	
ITEM NO. 103-F-005	CONTRACT NO. ED 965208
BY KI CHKD MSIG DATE 5-28-96	DWG 2A REV 5
R L HERBERT ENGINEERING SUPERVISOR	
This drawing is the property of ACBI and is to be used only in conjunction with the performance of work by ACBI. Reproduction in whole or in part is expressly forbidden.	

INDICATES CHANGE FROM PREVIOUS ISSUE

103-F-006

10:25:52 Oct. 30, 1996

6520802b.DGN



ANGLE	ARC
3°	524
5°	873
10°	1747
11.5°	2008
12°	2096
19°	3318
20°	3492
25°	4365
28°	4889
30°	5239
35°	6112
40°	6985
41°	7159
45°	7858

START OF 1st PAINTER COUPLING (16-1)


PLAN VIEW

START OF 1st STAIR TREAD


AS-BUILT

STEVE COYLE
SABCO QA/QC
1 MAY 1999

AT
IR
1 Jun 99

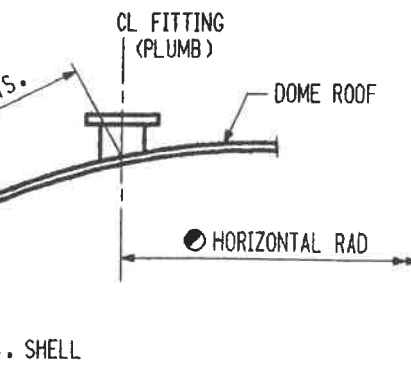

SECTION THRU ROOF

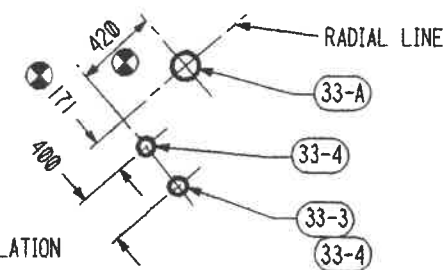

DETAIL A

FIELD TO VERIFY CPLG
LOCATION W/PIPING ON
DWG #37 PRIOR TO INSTALLATION

NOTES:

1. ALL ARC'S ARE MEASURED ON OUTSIDE OF FIRST SHELL RING UNLESS OTHERWISE NOTED.
2. ROOF NOZZLE BOLT HOLES TO STRADDLE 0°-180° CL
3. 'X' DENOTES FIRST SHELL RING JOINTS.
4. SEE DWG # FIB FOR ANCHOR CHAIRS LOCATION

DETAILED FOR (1) TANK -- (1) TANK REQUIRED


ORTHOXYLENE STORAGE TANK

BECHTEL LTD CONTRACT No. 22854-LCC-005
(22854-000-F-001)

A CBI ARABIAN CBI LTD. ORIENTATION 20.0m DIA. x 19.0m HIGH SS DRT IBN RUSHD PTA AND AROMATICS PLANT PROJECT ARABIAN INDUSTRIAL FIBERS CO. LTD YANBU, SAUDI ARABIA	
ITEM NO. 103-F-006 BY KT CHKD MSTG DATE 5-28-96 R L HERBERT ENGINEERING SUPERVISOR	CONTRACT NO. ED 965208 DWG 2B REV 6
This drawing is the property of ACBI and is to be used only in conjunction with the performance of work by ACBI. Reproduction in whole or in part is expressly forbidden.	


INDICATES CHANGE FROM PREVIOUS ISSUE

inf 103-F-005
South

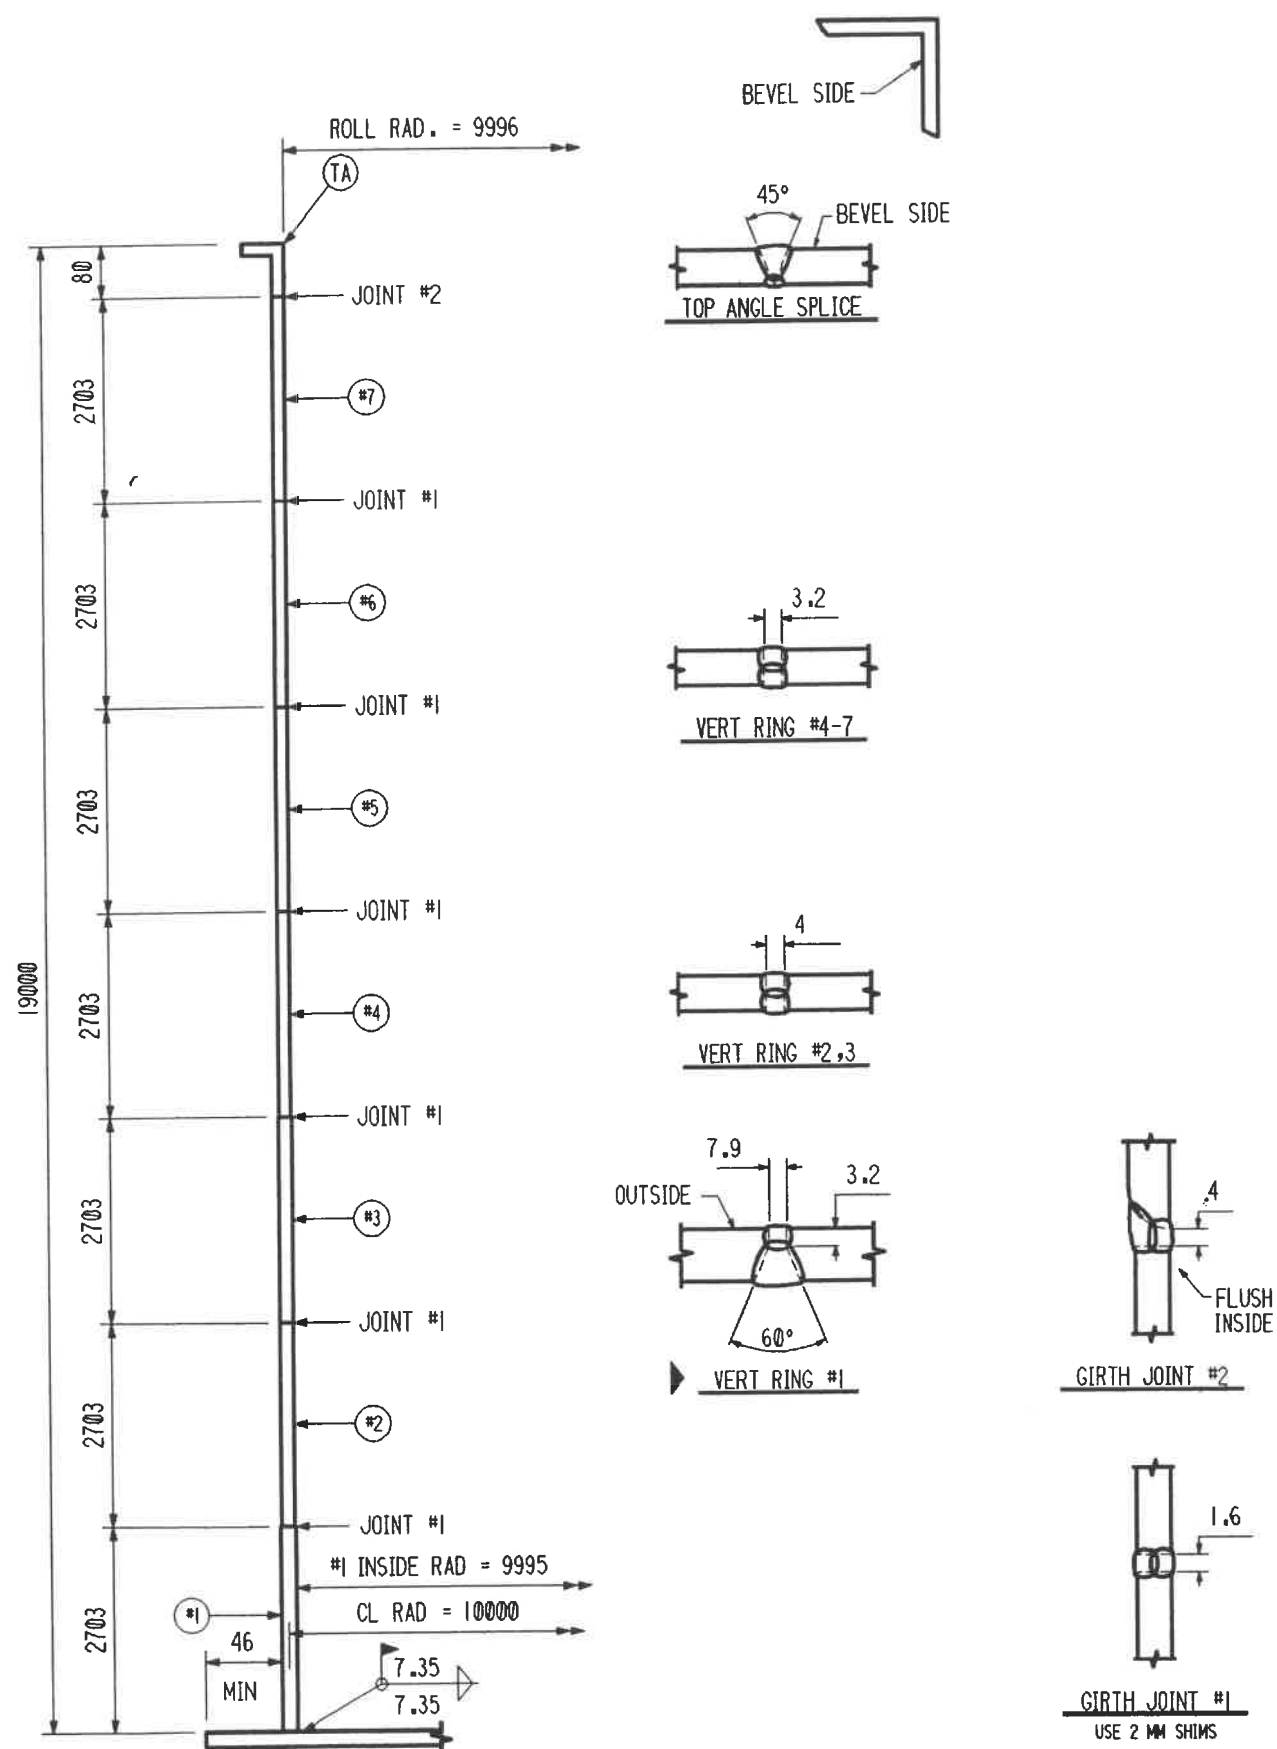

ALL PL CL STACKED
 OUTSIDE CIRC ON FIRST RING = 62863
 OUTSIDE CIRC ON TOP RING = 62855

SHIP PC	MARK	ASSM PC	DESCRIPTION	LENGTH MM	SPEC	ID
7	#1		SHELL SECTION			
			PL 2703 x 9.89	8974	A36	A
			(2719 x 8990)			
14	#2, #3		PL 2703 x 8.42	8974	A36	A
			(2719 x 8990)			
28	#4-#7		PL 2703 x 7.38	8974	A36	A
			(2719 x 8990)			
1	TA		L 80 x 80 x 10 * RUN	63176	A36	Ac
			ROLL SHR **			
			* 305 MM INCLUDED FOR FIELD TRIM			
			** ADD 914 MM TO EA. PIECE FOR SHEAR			

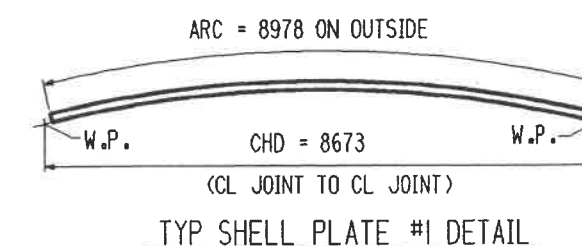

GENERAL NOTES :

1. BILLED PLATE LENGTHS ARE FINISHED 2 MM SHORTER THAN THEORETICAL LENGTH.

2. SHOP PUNCH MARK INSIDE TOP EDGE OF PLATES 2991 MM FROM EACH END.

STEVE 2.00

SABCO QA

16 MAY 1999


DETAILED & BILLED FOR (1) TANK - (2) TANKS REQUIRED

ORTHOXYLENE STORAGE TANK
 BECHTEL LTD CONTRACT No. 22854-LCC-005


AS-BUILT

A CBI		ARABIAN CBI LTD.	
SHELL SECTION			
20.0m DIA. x 19.0m HIGH SS DRT			
IBN RUSHD PTA AND AROMATICS PLANT PROJECT			
ARABIAN INDUSTRIAL FIBERS CO. LTD			
YANBU, SAUDI ARABIA			
ITEM NO	103-F-005 & 103-F-006	CONTRACT NO	ED 965208
BY	KOV	CHKD	MSIG
DATE	3/26/96	DATE	
R L HERBERT		DWG 3 REV 1	
ENGINEERING SUPERVISOR		SHT	
This drawing is the property of ACBI and is to be used only in conjunction with the performance of work by ACBI. Reproduction in whole or in part is expressly forbidden.			


INDICATES CHANGE FROM PREVIOUS ISSUE

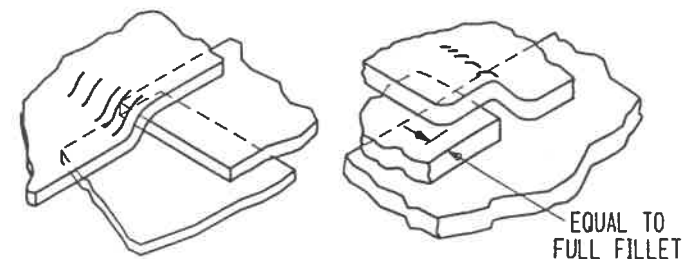

THREE-PLATE LAP DETAIL

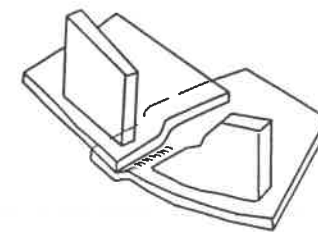EQUAL TO
FULL FILLET

BREAKDOWN LAP OF SKETCH PLATE

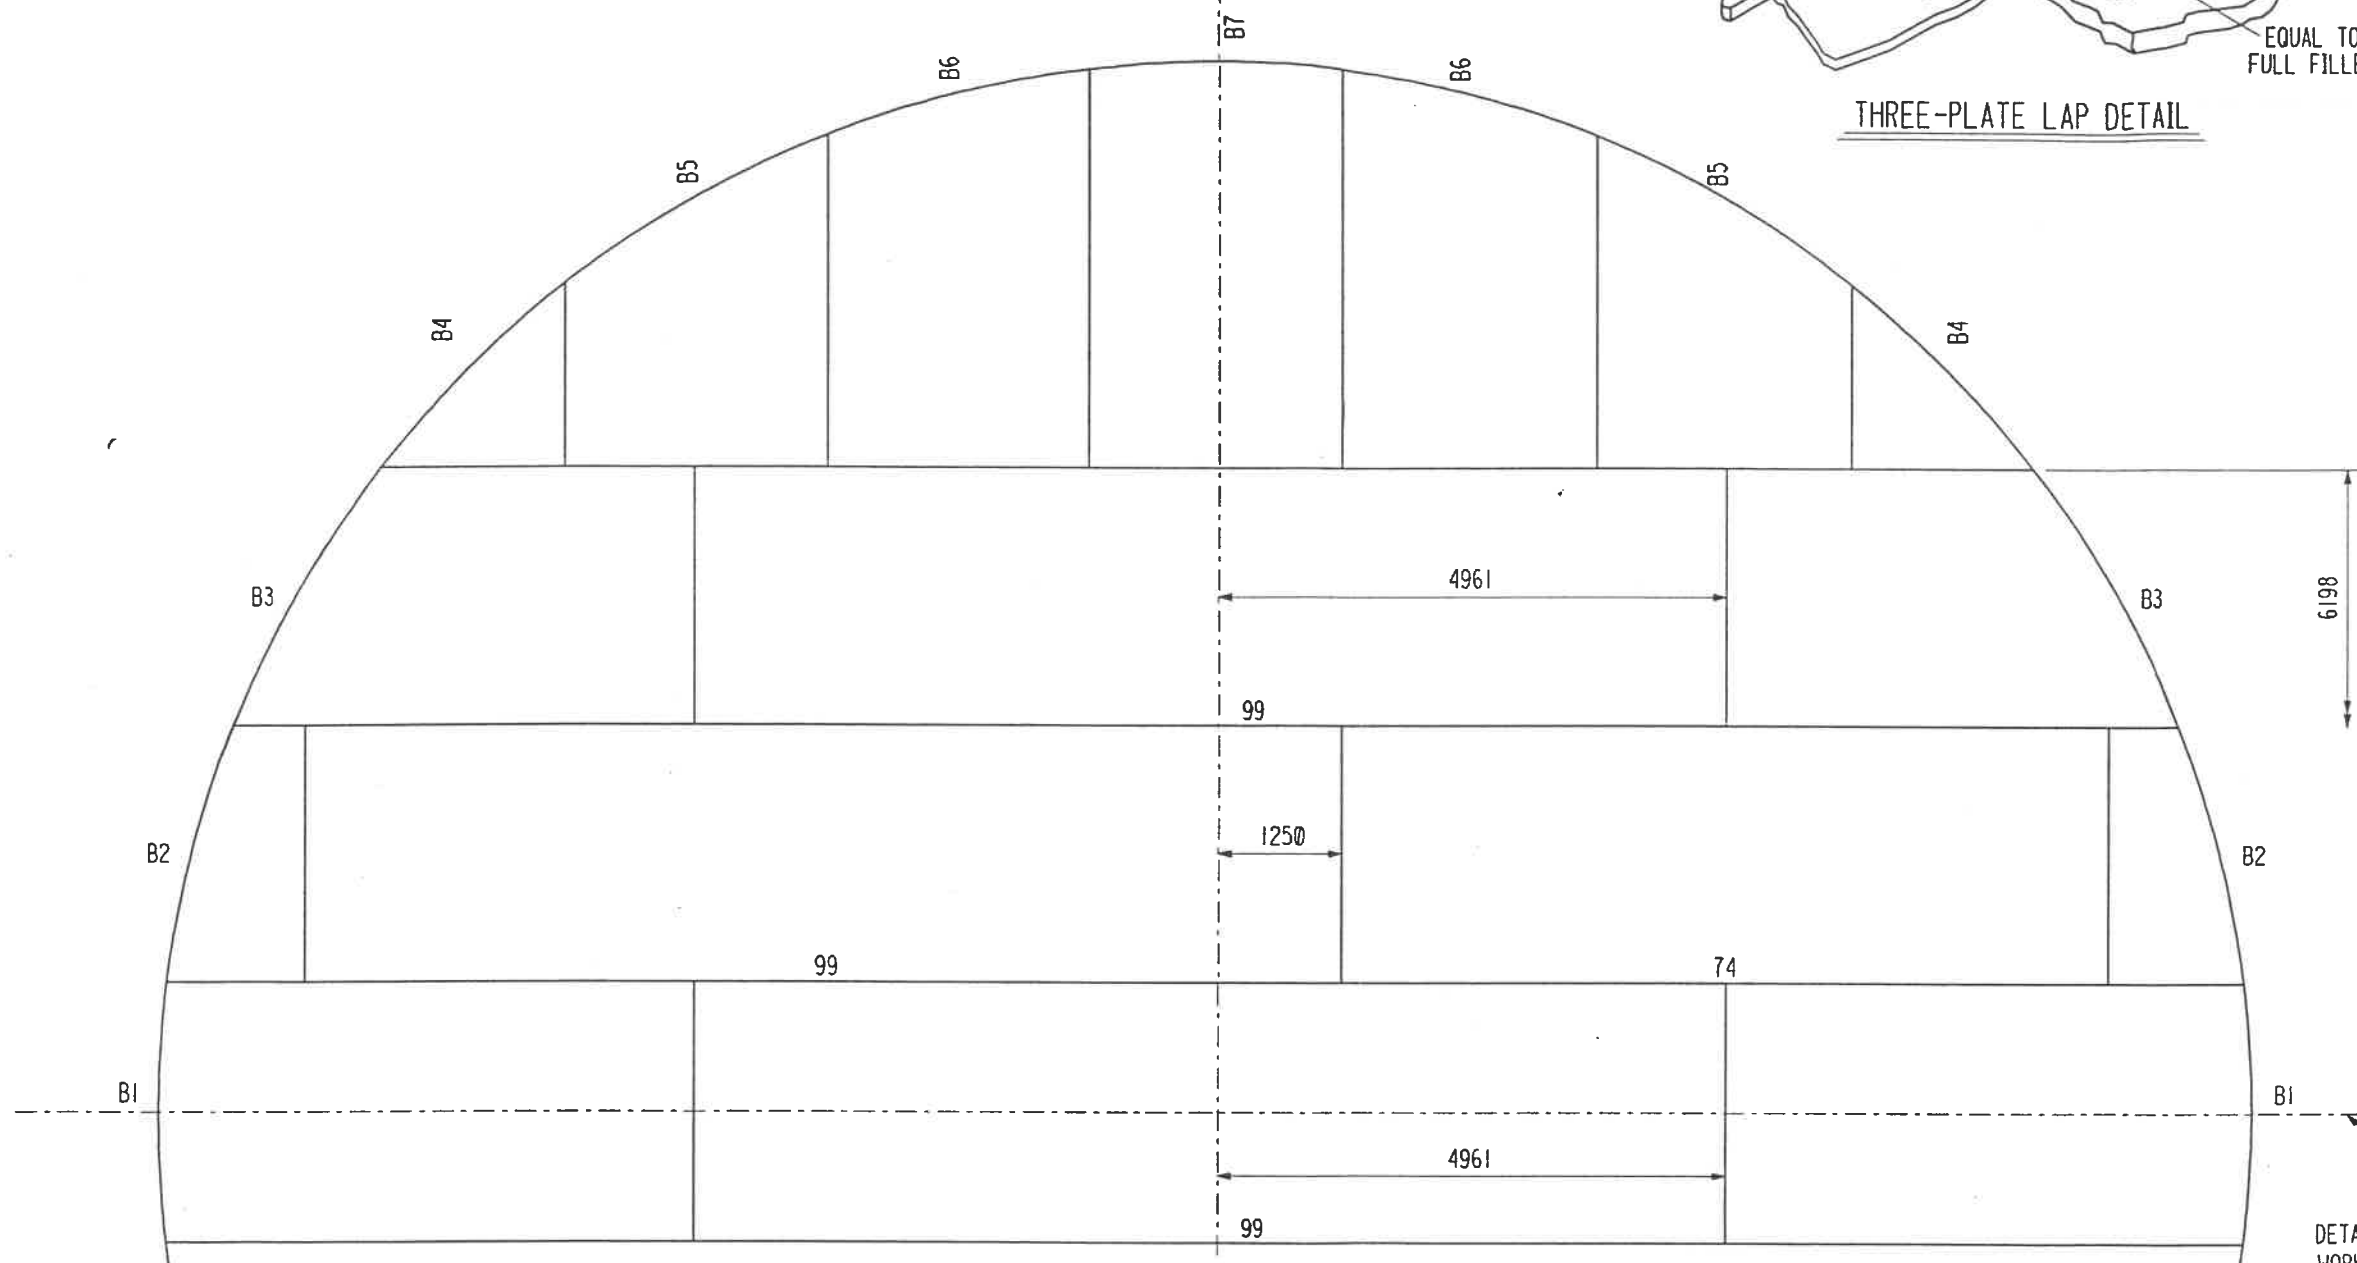

STEVE COYLE
SABCO QA/QC
16 MAY 1999

AS-BUILT

KG ACBI

SYMMETRICAL ABOUT CL

DETAILED FOR (1) TANK -- (2) TANKS REQUIRED
WORK THIS DRAWING WITH DRAWING #6

ORTHOXYLENE STORAGE TANK

BECHTEL LTD CONTRACT No. 22854-LCC-005
(22854-000-F-001)



ARABIAN CBI LTD.

BOTTOM ASSEMBLY

20.0m DIA. x 19.0m HIGH SS DRT
IBN RUSHD PTA AND AROMATICS PLANT PROJECT
ARABIAN INDUSTRIAL FIBERS CO. LTD
YANBU, SAUDI ARABIA

ITEM NO 103-F-005/006

CONTRACT NO

BY MSTG CHKD KWB DATE 4-22-96

ED 965208

R L HERBERT

DWG 5

REV

ENGINEERING SUPERVISOR

SHT

0

This drawing is the property of ACBI and is to be used
only in conjunction with the performance of work by ACBI.
Reproduction in whole or in part is expressly forbidden.


INDICATES CHANGE FROM PREVIOUS ISSUE

BY	CHKD	DATE	BY	CHKD	DATE	REVISIONS


HALF PLAN OF BOTTOM

ALL LAPS 26 MM
174 METERS OF 7.35 LAP WELD
DIMENSIONS ARE TO EDGE OF PLATE
ON WHICH THEY APPEAR


BURN & TAN RAD = 10075

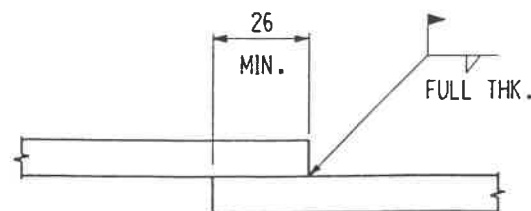


TYP SECTION THRU LAP

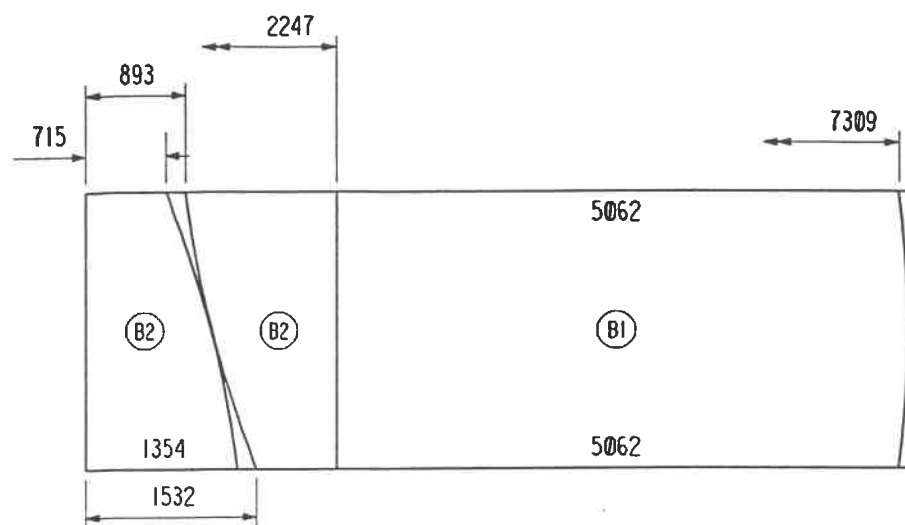


(74) (2) REQUIRED

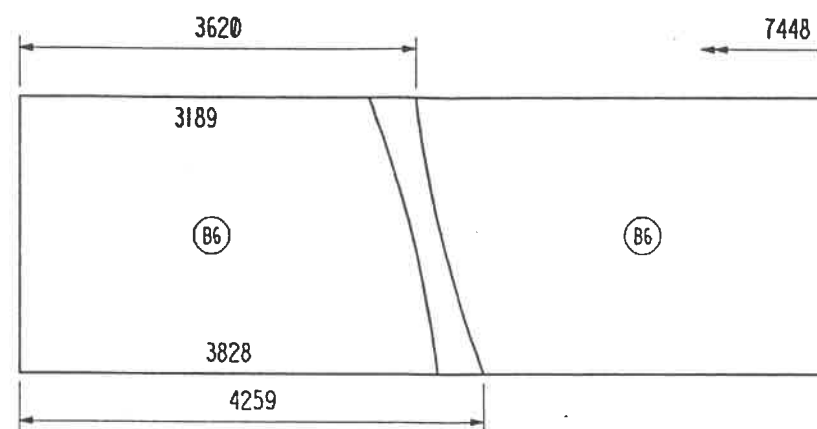

(74) (2) REQUIRED

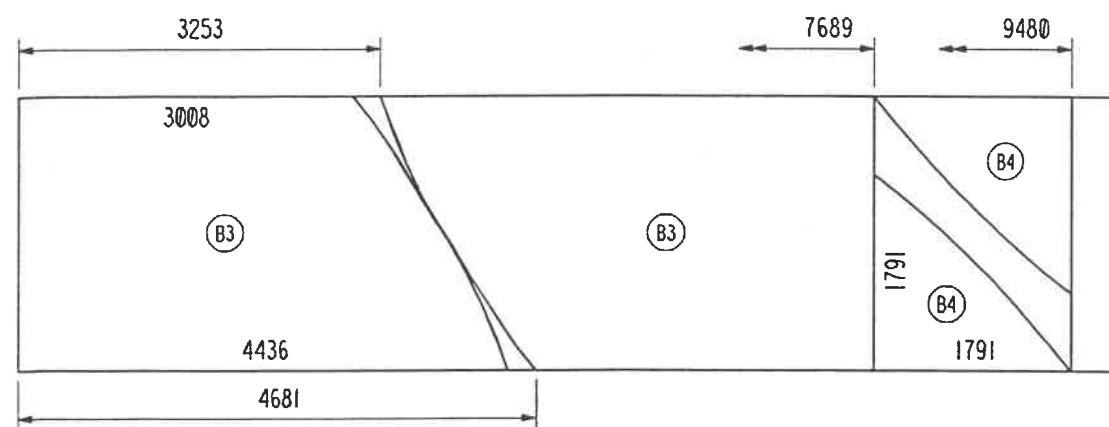

(99) (2) REQUIRED

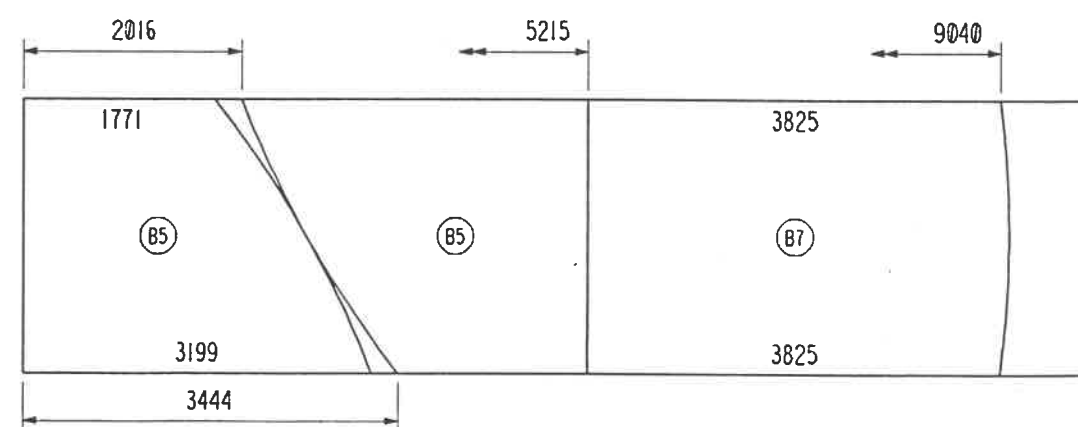

(99) (2) REQUIRED

SHIP PC	MARK	ASSM PC	DESCRIPTION	LENGTH MM	SPEC	ID
			--RECTANGULAR--			
5	99		PL-2500 X 7.35	9922	A36	A
2	74		PL-2500 X 7.35	7448	A36	A
			--SKETCHES--			
2	B1		PL-SK X 7.35		A36	A
4	B2		PL-SK X 7.35		A36	A
4	B3		PL-SK X 7.35		A36	A
4	B4		PL-SK X 7.35		A36	A
4	B5		PL-SK X 7.35		A36	A
4	B6		PL-SK X 7.35		A36	A
2	B7		PL-SK X 7.35		A36	A

THEORETICAL WT OF APPLIED MATERIAL
FOR CUTTING SKETCHES = 10022

TOTAL MATERIAL REQUIRED FOR SKETCHES

(4) - PL-2500 X 7.35 X 9922

(4) - PL-2500 X 7.35 X 7448

IR
1 Jun 99STEVE COYLE
SABCO QA/QC
16 MAY 1999**AS-BUILT**
RGT ACBI

ORTHOXYLENE STORAGE TANK

BECHTEL LTD CONTRACT No. 22854-LCC-005
(22854-000-F-001)DETAILED AND BILLED FOR (1) TANK -- (2) TANKS REQUIRED
WORK THIS DRAWING WITH DRAWING #5
BURN RAD = 10075STEVE COYLE
SABCO QA/QC
16 MAY 1999


INDICATES CHANGE FROM PREVIOUS ISSUE

MODIFICATION/REMARKS					
BY	CHKD	DATE	BY	CHKD	DATE

ARABIAN CBI LTD.

BOTTOM SKETCHES

20.0m DIA. x 19.0m HIGH SS DRT
IBN RUSHD PTA AND AROMATICS PLANT PROJECT
ARABIAN INDUSTRIAL FIBERS CO. LTD
YANBU, SAUDI ARABIAITEM NO 103-F-005/006 CONTRACT NO
BY MSTC CHKD KWB DATE 4-22-96 ED 965208R L HERBERT DWG 6 REV
ENGINEERING SUPERVISOR SHT 0This drawing is the property of ACBI and is to be used
only in conjunction with the performance of work by ACBI.
Reproduction in whole or in part is expressly forbidden.

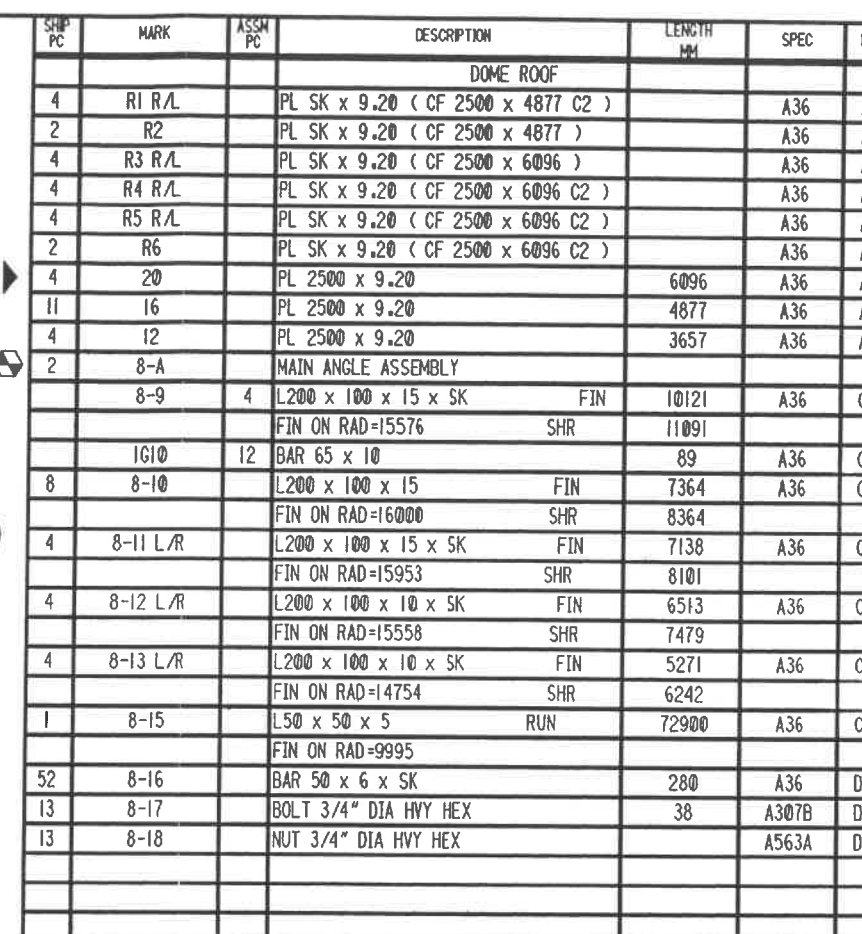

 MAYBE SHIPPED IN TWO PIECES

STEVE COYLE
SABCO QA/QC
16 MAY 1999

AS - BUILT

LENGTH OF 9.2 WELDS FOR ROOF PLATES (m)
 ROOF TO TOP ANGLE = 62.8
 LAP DOWN = 53.5
 LAP SLOPING = 165.1
 LAP OVERHEAD (IF REQ'D.) = 222.4

NOTE:
1. WORK THIS DWG WITH DWG # 9 & 10.

DETAILED & BILLED FOR (1) TANK - (2) TANKS REQUIRED
ORTHODXYLENE STORAGE TANK


BECHTEL LTDCONTRACT No. 22854-LCC-005

FIELD NOTES:


1. ROOF SKETCH PLATES NUMBERED IN ORDER OF ERECTION. USE THE CHORDS SHOWN FOR LOCATING CORNER OF SKETCH PLATE.
2. NOTE THAT PLATE COURSES ARE 90° TO THE LONG CONTINUOUS ANGLE.
3. MINIMUM LAP IS 26mm. LAP BETWEEN ADJACENT COURSES WILL INCREASE TO A MAXIMUM AT THE TOP ANGLE. SKETCH PLATE LOCATING CHORDS AND SKETCH PLATE SIZES ARE BASED ON 38mm LAP.
4. BEFORE COMPLETING ERECTION OF FRAMING, 181 kg TOTAL IS THE MAXIMUM PERMISSIBLE CONCENTRATED LOAD ON THE FRAMING.

► INDICATES CHANGE FROM PREVIOUS ISSUE


[illegible]

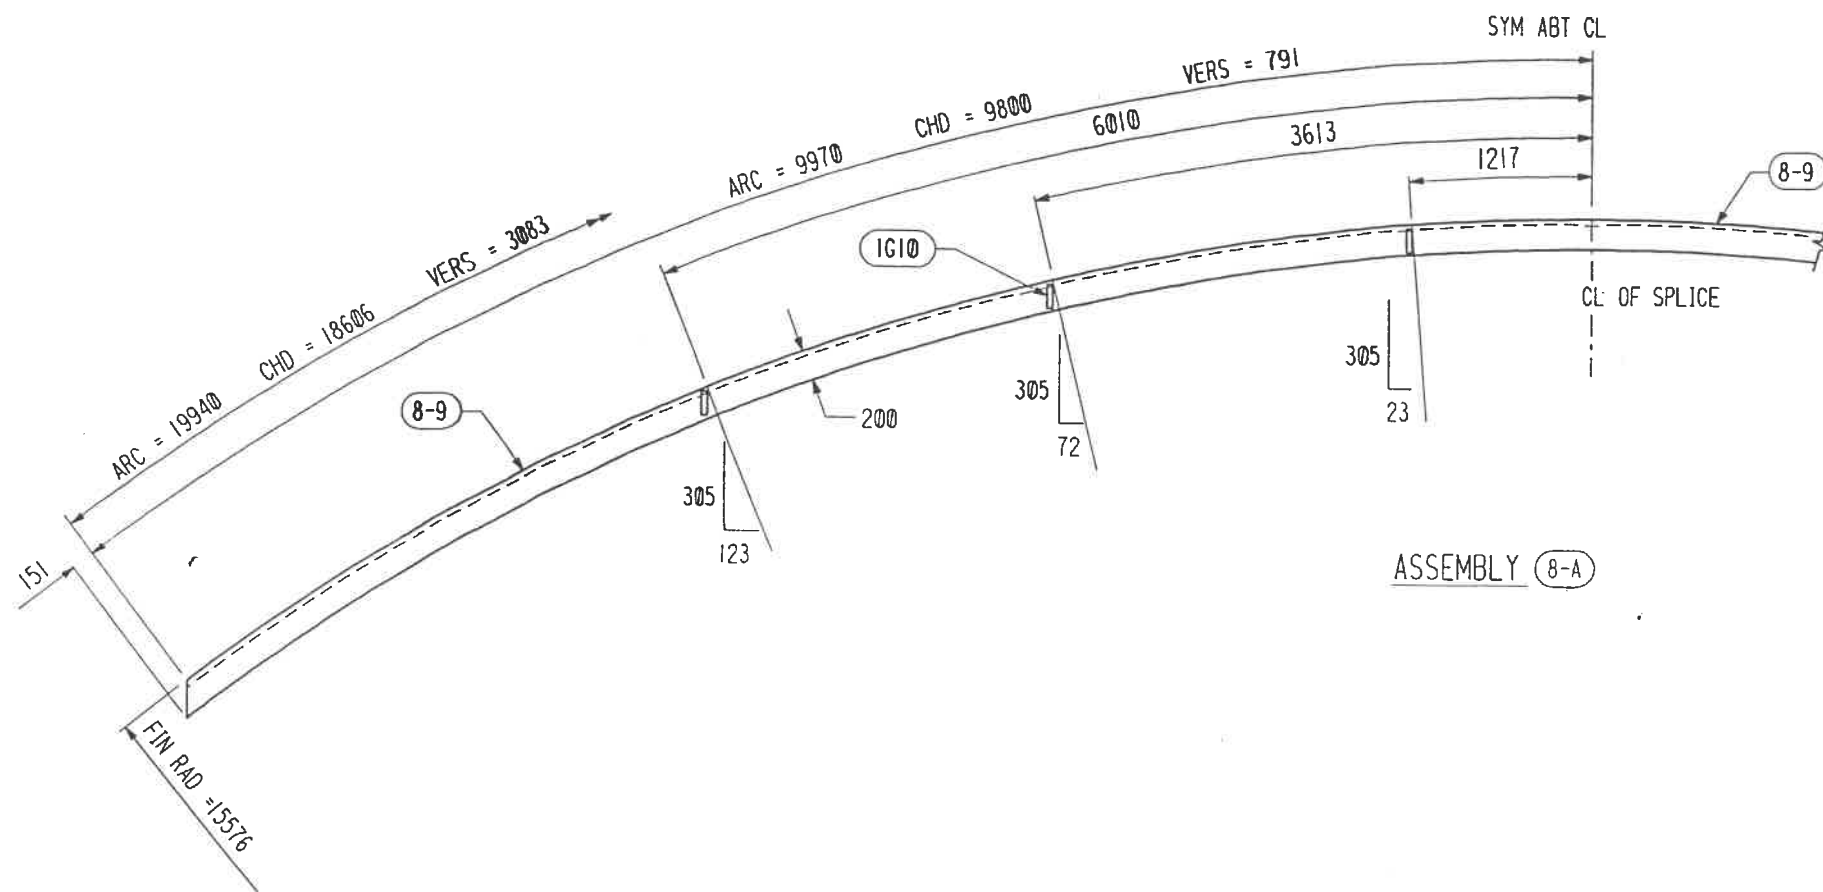



ASSEMBLY 8-A

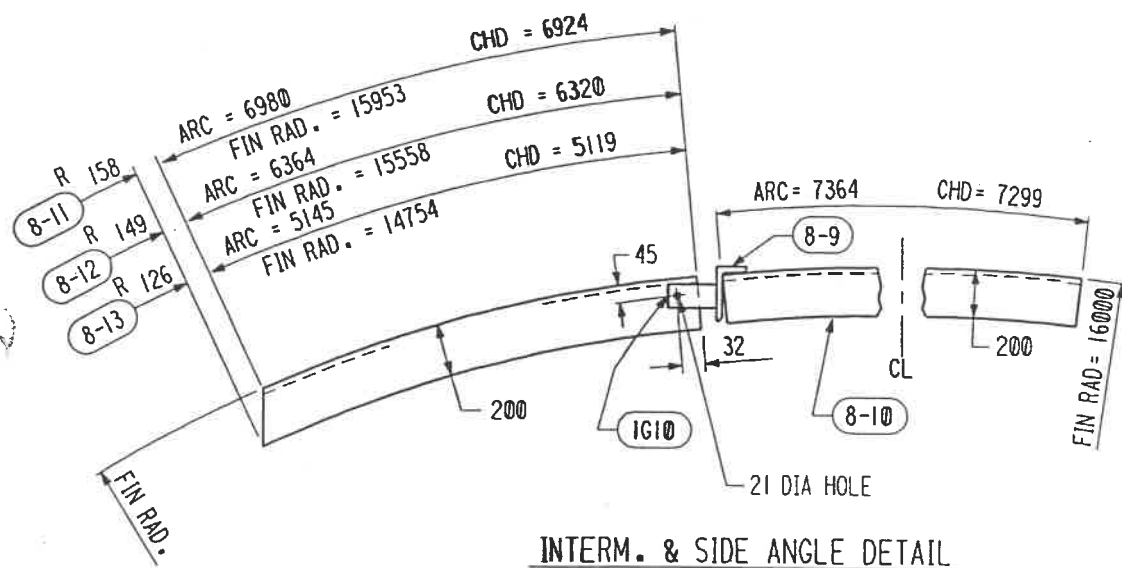

INTERM. & SIDE ANGLE DETAIL

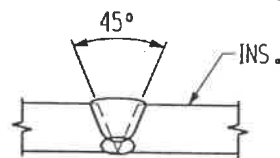

TYP ANGLE SPLICE
(IF NECESSARY)

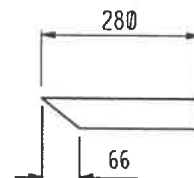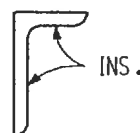

DETAIL Pc 8-16

STEVE COYLE
SABCO QA/QC
16 MAY 1999

IR
1 Jun 99

AS-BUILT

DETAILED FOR (1) - (2) REQUIRED
WORK THIS DRAWING WITH DRAWING #8

ORTHOXYLENE STORAGE TANK

BECHTEL LTD CONTRACT No. 22854-LCC-005
(22854-000-F-001)

ARABIAN CBI LTD.					
DOME ROOF 20.0m DIA. x 19.0m HIGH SS DRT IBN RUSHD PTA AND AROMATICS PLANT PROJECT ARABIAN INDUSTRIAL FIBERS CO. LTD YANBU, SAUDI ARABIA					
ITEM NO 103-F-005/006			CONTRACT NO ED 965208		
BY Key CHKD DATE 4/25/96			R L HERBERT		
ENGINEERING SUPERVISOR			DWG 9	REV	0
SH1			This drawing is the property of ACBI and is to be used only in conjunction with the performance of work by ACBI. Reproduction in whole or in part is expressly forbidden.		

INDICATES CHANGE FROM PREVIOUS ISSUE