



ARABIAN INDUSTRIAL FIBERS COMPANY

IR-II AROMATICS PROJECT

PROJECT NO. 10E0541A01

DOCUMENT TITLE:

CHARGE HEATER DATA SHEET

DOCUMENT NO:

DS-54-BA-501

						ابن رشد ibn rushd	ARABIAN INDUSTRIAL FIBERS COMPANY YANBU, KINGDOM OF SAUDI ARABIA	CTCI CORPORATION
						CERTIFIED		
2	Revised as Marked	KWY.	CBC	YSL	11 Aug. 11	PROJ.		
1	Issued for Design	KWY	CBC	YSL	27-May-11	MGR	DATE	
0	Issue For Approval	KWY	CBC	YSL	23-Mar.-11	CLIENT	DATE	
REV	DESCRIPTION	BY	CHK.	APPR.	DATE	PAGE 1 OF 2	XC33D-54-501	

CONTENTS

<u>ITEM</u>	<u>EQUIPMENT NO.</u>	<u>SHEET NO.</u>	<u>REV. NO.</u>	<u>REV. DATE</u>
1.	54-B-01	1 THRU 5 OF 5	2	11-Aug.-2011
Attachment total 9 pages				

CHARGE HEATER DATA SHEET

XC33D-54-501

2 OF 2

DATE
11-Aug.-2011
REV.
2

ابن رشيد ibn rushd FLUOR	FIRED HEATER DATA SHEET	Contract: 10E0541A01 Equipment No.: 54-B-01 Revision: 2 Date: 11-Aug-2011 Unit: 54 - Isomar P.O. No.: Document No.: DS-54-BA-01 Sheet: 2 of 5	 سابك sabik CTCI CORPORATION
---	--	--	--

1	COMBUSTION DESIGN CONDITIONS					REV
2	* OPERATING CASE	REVAMP EOR				
3	* TYPE OF FUEL	Sales Gas				
4	* EXCESS AIR %	15.0				
5	CALCULATED HEAT RELEASE (LHV) MW	23.62				
6	CALCULATED THERMAL EFFICIENCY % (LHV)					
7	CALCULATED FUEL EFFICIENCY % (LHV)	86.0				
8	* GUARANTEED FUEL EFFICIENCY % (LHV)					
9	RADIATION LOSS % OF HEAT RELEASE (LHV)	2.0				
10	FLUE GAS TEMPERATURE LEAVING: RADIANT SECT. °C	742				
11	CONVECTION SECTION °C	276				
12	AIR PREHEATER °C	n/a				
13	FLUE GAS ACID DEW POINT TEMPERATURE, °C	93				
14	FLUE GAS QUANTITY kg/hr	35,917				
15	FLUE GAS MASS VELOCITY THRU CONVECTION SECTION kg/s-m²					
16	VOLUMETRIC HEAT RELEASE (LHV) kW/m³					
17	DRAFT: Immediately Above Top Convection Row, mm H2O					
18	Immediately Below Bottom Convection Row, mm H2O	2.5				
19	At Burners, mm H2O	50.0				
20	COMBUSTION AIR TEMP.: Leaving Steam/Air Preheater, °C	-				
21	At Burners, °C	15.6				
22	COMBUSTION AIR QUANTITY kg/hr	33,819				
23	AMBIENT AIR TEMPERATURE - EFFICIENCY CALCULATION °C	15.6				
24	* AMBIENT AIR TEMPERATURE - STACK DESIGN °C	50.0				
25	* ALTITUDE ABOVE SEA LEVEL m	7.25				
26	FUEL CHARACTERISTICS					
27	* GAS TYPE Sales Gas	* GAS TYPE	* LIQUID TYPE			
28	* LHV 40,512 kJ/kg ☒ kJ/Sm³	* LHV ☐ kJ/kg ☐ kJ/Sm³	* LHV ☐ kJ/kg			
29	* HHV ☐ kJ/kg ☐ kJ/Sm³	* HHV ☐ kJ/kg ☐ kJ/Sm³	* HHV ☐ kJ/kg			
30	* PRESS. @ BURNER 1.75 bar (g)	* PRESS. @ BURNER ☐ bar (g)	* PRESS. @ BURNER ☐ bar (g)			
31	* TEMP. @ BURNER 15.6 °C	* TEMP. @ BURNER ☐ °C	* TEMP. @ BURNER ☐ °C			
32	* MOLECULAR WEIGHT	* MOLECULAR WEIGHT	* VISCOSITY @ ☐ °C SSU			
33			* ATOMIZING STEAM TEMP. ☐ °C			
34	COMPOSITION	MOLE %	COMPOSITION	MOLE %	COMPOSITION	WT %
35	N2	12.0				
36	C1	82.7				
37	C2	5.0				
38	C3	0.3				
39	H2S	<2.0 wt ppm				
40	TOTAL	100.0				
41						
42						
43						
44					* VANADIUM (ppm)	
45					* SODIUM (ppm)	
46					* SULFUR	
47					* ASH	
48	DATA FOR EXISTING BURNERS					
49	MANUFACTURER:	SIZE / MODEL:	NUMBER:	13		
50	TYPE:	LOCATION:	ORIENTATION:			
51	HEAT RELEASE PER BURNER: MW	DESIGN: 2.38	NORMAL: 1.82	MINIMUM:		
52	PRESSURE DROP ACROSS BURNER @ DESIGN HEAT RELEASE:	By Vendor mm H2O				
53	DISTANCE BURNER CENTER LINE TO TUBE CENTER LINE:	HORIZONTAL: mm	VERTICAL: mm			
54	DISTANCE BURNER CENTER LINE TO UNSHIELDED REFRACTORY:	HORIZONTAL: mm	VERTICAL: mm			
55	BURNER PILOT: CAPACITY kW	FUEL Sales Gas	FUEL PRESSURE	bar (g)		
56	IGNITION METHOD: Automatic					
57	SPECIAL REQUIREMENTS (FLAME DETECTION DEVICES, SAFETY INTERLOCKS, ETC.):					
58	REQUIRED EMISSIONS: ☐ ppmv(d) (CORRECTED TO 3% O2)	NOx: Remark 1	CO: Remark 1	SOx: Remark 1		
59	See REMARK 1 ☐ kg/kJ ☐ (LHV) ☐ (HHV)	UHC: Remark 1	PARTICULATES: Remark 1			
60	REMARKS:					
61	1. The Royal Commission for Jubail and Yanbu has issued the "Royal Commission Environmental Regulations (RCER)" to be adopted by					
62	industries both in Jubail and Yanbu. Any facility operating or planning to operate on the Royal Commission property shall comply with					
63	those regulations.					
64						

**FIRED HEATER
DATA SHEET**

Contract: 10E0541A01
Equipment No.: 54-B-01
Revision: 2 Date: 11-Aug-2011
Unit: 54 - Isomar
P.O. No.:
Document No.: DS-54-BA-01
Sheet: 3 of 5

FLUID PROPERTIES:													REV
Deheptanizer Reboiler													
Thermodynamic condition			Vapor					Liquid					
Pressure bar(a)	Temp °C	Weight fraction vapor	Enthalpy kJ/kg	Density kg/m³	Specific heat kJ/kg·°C	Viscosity mPa·s	Thermal cond. W/m·°C	Enthalpy kJ/kg	Density kg/m³	Specific heat kJ/kg·°C	Viscosity mPa·s	Thermal cond. W/m·°C	Surface tension dyne/cm
7.770	233.33	0.0000	0.00	0.00	0.0000	0.0000	0.0000	457.59	653.55	2.5690	0.1725	0.0981	7.99
7.770	234.47	0.0000	0.00	0.00	0.0000	0.0000	0.0000	460.51	651.95	2.5745	0.1717	0.0980	7.90
7.770	235.60	0.0000	0.00	0.00	0.0000	0.0000	0.0000	463.43	650.35	2.5803	0.1708	0.0978	7.80
7.770	236.72	0.0000	735.90	23.06	2.0645	0.0106	0.0272	466.33	648.75	2.5858	0.1701	0.0976	7.70
7.770	236.74	0.0420	735.93	23.06	2.0649	0.0106	0.0272	466.37	648.75	2.5858	0.1701	0.0976	7.70
7.770	236.75	0.0839	735.97	23.06	2.0649	0.0106	0.0272	466.41	648.91	2.5858	0.1701	0.0976	7.70
7.770	236.76	0.1259	736.01	23.06	2.0649	0.0106	0.0272	466.44	648.91	2.5858	0.1701	0.0976	7.70
7.770	236.78	0.1679	736.04	23.06	2.0649	0.0106	0.0272	466.48	648.91	2.5862	0.1701	0.0976	7.70
7.770	236.79	0.2098	736.08	23.06	2.0649	0.0106	0.0272	466.52	648.91	2.5862	0.1701	0.0976	7.70
7.770	236.81	0.2518	736.12	23.06	2.0649	0.0106	0.0272	466.56	648.91	2.5862	0.1701	0.0976	7.70
7.770	236.82	0.2938	736.15	23.06	2.0649	0.0106	0.0272	466.60	648.91	2.5862	0.1701	0.0976	7.70
7.770	236.83	0.3358	736.19	23.06	2.0653	0.0106	0.0272	466.63	648.91	2.5862	0.1701	0.0976	7.70
7.770	236.84	0.3778	736.23	23.06	2.0653	0.0106	0.0272	466.67	648.91	2.5862	0.1701	0.0976	7.70
7.770	236.86	0.4197	736.27	23.06	2.0653	0.0106	0.0272	466.71	648.91	2.5862	0.1701	0.0976	7.70
7.924	234.44	0.0000	0.00	0.00	0.0000	0.0000	0.0000	460.45	652.11	2.5745	0.1717	0.0980	7.90
7.924	235.60	0.0000	0.00	0.00	0.0000	0.0000	0.0000	463.43	650.51	2.5803	0.1709	0.0978	7.80
7.924	236.76	0.0000	0.00	0.00	0.0000	0.0000	0.0000	466.42	648.91	2.5858	0.1701	0.0976	7.70
7.924	237.90	0.0000	737.86	23.52	2.0704	0.0106	0.0273	469.38	647.31	2.5916	0.1692	0.0974	7.60
7.924	237.91	0.0420	737.90	23.52	2.0704	0.0106	0.0273	469.41	647.31	2.5916	0.1693	0.0974	7.60
7.924	237.92	0.0839	737.94	23.52	2.0704	0.0106	0.0273	469.45	647.31	2.5916	0.1693	0.0974	7.60
7.924	237.94	0.1259	737.97	23.52	2.0704	0.0106	0.0273	469.49	647.31	2.5916	0.1693	0.0974	7.60
7.924	237.95	0.1679	738.01	23.52	2.0704	0.0106	0.0273	469.52	647.31	2.5920	0.1693	0.0974	7.60
7.924	237.97	0.2098	738.04	23.52	2.0704	0.0106	0.0273	469.56	647.31	2.5920	0.1693	0.0974	7.60
7.924	237.98	0.2518	738.08	23.52	2.0704	0.0106	0.0273	469.60	647.31	2.5920	0.1693	0.0974	7.60
7.924	237.99	0.2938	738.12	23.53	2.0708	0.0106	0.0273	469.64	647.31	2.5920	0.1693	0.0974	7.60
7.924	238.01	0.3358	738.15	23.53	2.0708	0.0106	0.0273	469.67	647.31	2.5920	0.1693	0.0974	7.60
7.924	238.02	0.3778	738.19	23.53	2.0708	0.0106	0.0273	469.71	647.31	2.5920	0.1693	0.0974	7.60
7.924	238.03	0.4197	738.23	23.53	2.0708	0.0106	0.0273	469.75	647.31	2.5920	0.1693	0.0974	7.60
8.078	235.56	0.0000	0.00	0.00	0.0000	0.0000	0.0000	463.32	650.67	2.5799	0.1709	0.0978	7.80
8.078	236.73	0.0000	0.00	0.00	0.0000	0.0000	0.0000	466.34	649.07	2.5858	0.1701	0.0976	7.70
8.078	237.90	0.0000	0.00	0.00	0.0000	0.0000	0.0000	469.38	647.31	2.5916	0.1693	0.0974	7.60
8.078	239.06	0.0000	739.80	23.99	2.0758	0.0106	0.0273	472.38	645.70	2.5975	0.1685	0.0973	7.50
8.078	239.07	0.0420	739.84	23.99	2.0758	0.0106	0.0273	472.42	645.70	2.5975	0.1685	0.0973	7.50
8.078	239.08	0.0839	739.87	23.99	2.0758	0.0106	0.0273	472.45	645.70	2.5975	0.1685	0.0973	7.50
8.078	239.09	0.1259	739.91	23.99	2.0758	0.0106	0.0273	472.49	645.70	2.5975	0.1685	0.0973	7.50
8.078	239.11	0.1679	739.94	23.99	2.0758	0.0106	0.0273	472.53	645.70	2.5979	0.1685	0.0973	7.50
8.078	239.12	0.2098	739.98	23.99	2.0758	0.0106	0.0273	472.56	645.70	2.5979	0.1685	0.0973	7.50
8.078	239.13	0.2518	740.01	23.99	2.0758	0.0106	0.0273	472.60	645.70	2.5979	0.1685	0.0973	7.50
8.078	239.15	0.2938	740.05	23.99	2.0762	0.0106	0.0273	472.64	645.70	2.5979	0.1685	0.0973	7.50
8.078	239.16	0.3358	740.09	23.99	2.0762	0.0106	0.0273	472.68	645.70	2.5979	0.1685	0.0973	7.50
8.078	239.18	0.3778	740.13	23.99	2.0762	0.0106	0.0273	472.72	645.70	2.5979	0.1685	0.0973	7.50
8.078	239.19	0.4197	740.17	23.99	2.0762	0.0106	0.0273	472.76	645.70	2.5979	0.1685	0.0973	7.50
8.232	236.39	0.0000	0.00	0.00	0.0000	0.0000	0.0000	465.47	649.55	2.5841	0.1704	0.0976	7.73
8.232	237.66	0.0000	0.00	0.00	0.0000	0.0000	0.0000	468.76	647.79	2.5904	0.1695	0.0974	7.62
8.232	238.93	0.0000	0.00	0.00	0.0000	0.0000	0.0000	472.06	646.02	2.5971	0.1686	0.0973	7.51
8.232	240.19	0.0000	741.71	24.46	2.0813	0.0107	0.0275	475.35	644.26	2.6034	0.1677	0.0971	7.40
8.232	240.21	0.0420	741.74	24.46	2.0813	0.0107	0.0275	475.39	644.26	2.6034	0.1677	0.0971	7.40
8.232	240.22	0.0839	741.78	24.46	2.0813	0.0107	0.0275	475.42	644.26	2.6034	0.1677	0.0971	7.40
8.232	240.24	0.1259	741.82	24.46	2.0813	0.0107	0.0275	475.46	644.26	2.6034	0.1677	0.0971	7.40
8.232	240.25	0.1679	741.85	24.46	2.0813	0.0107	0.0275	475.49	644.26	2.6034	0.1677	0.0971	7.40
8.232	240.26	0.2098	741.89	24.46	2.0813	0.0107	0.0275	475.53	644.26	2.6038	0.1677	0.0971	7.40
8.232	240.28	0.2518	741.92	24.46	2.0813	0.0107	0.0275	475.57	644.26	2.6038	0.1677	0.0971	7.40
8.232	240.29	0.2938	741.96	24.46	2.0813	0.0107	0.0275	475.61	644.26	2.6038	0.1677	0.0971	7.40
8.232	240.30	0.3358	742.00	24.46	2.0817	0.0107	0.0275	475.64	644.26	2.6038	0.1677	0.0971	7.40
8.232	240.32	0.3778	742.03	24.46	2.0817	0.0107	0.0275	475.68	644.26	2.6038	0.1677	0.0971	7.40
8.232	240.33	0.4198	742.07	24.46	2.0817	0.0107	0.0275	475.72	644.26	2.6038	0.1677	0.0971	7.40
8.385	236.39	0.0000	0.00	0.00	0.0000	0.0000	0.0000	465.47	649.71	2.5841	0.1704	0.0976	7.73
8.385	238.04	0.0000	0.00	0.00	0.0000	0.0000	0.0000	469.74	647.31	2.5925	0.1692	0.0974	7.59
8.385	239.69	0.0000	0.00	0.00	0.0000	0.0000	0.0000	474.02	645.06	2.6008	0.1681	0.0973	7.45
8.385	241.32	0.0000	743.59	24.93	2.0863	0.0107	0.0275	478.28	642.66	2.6092	0.1669	0.0969	7.31
8.385	241.33	0.0420	743.62	24.93	2.0863	0.0107	0.0275	478.32	642.66	2.6092	0.1669	0.0969	7.31
8.385	241.35	0.0839	743.66	24.93	2.0867	0.0107	0.0275	478.35	642.66	2.6092	0.1669	0.0969	7.31
8.385	241.36	0.1259	743.69	24.93	2.0867	0.0107	0.0275	478.39	642.66	2.6092	0.1669	0.0969	7.31
8.385	241.37	0.1679	743.73	24.93	2.0867	0.0107	0.0275	478.43	642.66	2.6092	0.1669	0.0969	7.31
8.385	241.39	0.2098	743.77	24.93	2.0867	0.0107	0.0275	478.47	642.66	2.6092	0.1669	0.0969	7.31
8.385	241.40	0.2518	743.80	24.93	2.0867	0.0107	0.0275	478.50	642.66	2.6096	0.1669	0.0969	7.31
8.385	241.41	0.2938	743.84	24.93	2.0867	0.0107	0.0275	478.54	642.66	2.6096	0.1669	0.0969	7.31
8.385	241.43	0.3358	743.88	24.93	2.0867	0.0107	0.0275	478.58	642.66	2.6096	0.1670	0.0969	7.31
8.385	241.44	0.3778	743.91	24.93	2.0867	0.0107	0.0275	478.61	642.66	2.6096	0.1670	0.0969	7.31
8.385	241.46	0.4198	743.95	24.93	2.0871	0.0107	0.0275	478.65	642.66	2.6096	0.1670	0.0969	7.31

**FIRED HEATER
DATA SHEET**

Contract: 10E0541A01
Equipment No.: 54-B-01
Revision: 2 Date: 11-Aug-2011
Unit: 54 - Isomar
P.O. No.:
Document No.: DS-54-BA-01
Sheet: 4 of 5

FLUID PROPERTIES:													REV
Deheptanizer Reboiler													
Thermodynamic condition			Vapor					Liquid					
Pressure bar(a)	Temp °C	Weight fraction vapor	Enthalpy kJ/kg	Density kg/m³	Specific heat kJ/kg-°C	Viscosity mPa-s	Thermal cond. W/m-°C	Enthalpy kJ/kg	Density kg/m³	Specific heat kJ/kg-°C	Viscosity mPa-s	Thermal cond. W/m-°C	Surface tension dyne/cm
8.539	236.39	0.0000	0.00	0.00	0.0000	0.0000	0.0000	465.47	649.71	2.5841	0.1704	0.0976	7.73
8.539	238.41	0.0000	0.00	0.00	0.0000	0.0000	0.0000	470.69	646.99	2.5941	0.1690	0.0974	7.56
8.539	240.42	0.0000	0.00	0.00	0.0000	0.0000	0.0000	475.93	644.10	2.6046	0.1676	0.0971	7.38
8.539	242.43	0.0000	745.44	25.40	2.0917	0.0107	0.0277	481.18	641.22	2.6151	0.1662	0.0967	7.21
8.539	242.44	0.0420	745.48	25.40	2.0917	0.0107	0.0277	481.22	641.22	2.6151	0.1662	0.0967	7.21
8.539	242.46	0.0839	745.51	25.40	2.0917	0.0107	0.0277	481.25	641.22	2.6151	0.1662	0.0967	7.21
8.539	242.47	0.1259	745.55	25.40	2.0917	0.0107	0.0277	481.29	641.22	2.6151	0.1662	0.0967	7.21
8.539	242.48	0.1679	745.59	25.40	2.0917	0.0107	0.0277	481.33	641.22	2.6151	0.1662	0.0967	7.21
8.539	242.49	0.2098	745.62	25.40	2.0921	0.0107	0.0277	481.36	641.22	2.6151	0.1662	0.0967	7.21
8.539	242.51	0.2518	745.66	25.40	2.0921	0.0107	0.0277	481.40	641.22	2.6151	0.1662	0.0967	7.21
8.539	242.52	0.2938	745.69	25.40	2.0921	0.0107	0.0277	481.44	641.22	2.6151	0.1662	0.0967	7.21
8.539	242.54	0.3358	745.73	25.40	2.0921	0.0107	0.0277	481.48	641.22	2.6155	0.1662	0.0967	7.21
8.539	242.55	0.3778	745.77	25.40	2.0921	0.0107	0.0277	481.51	641.22	2.6155	0.1662	0.0967	7.21
8.539	242.56	0.4198	745.80	25.40	2.0921	0.0107	0.0277	481.55	641.22	2.6155	0.1662	0.0967	7.21
8.693	236.39	0.0000	0.00	0.00	0.0000	0.0000	0.0000	465.47	649.87	2.5841	0.1704	0.0976	7.73
8.693	238.77	0.0000	0.00	0.00	0.0000	0.0000	0.0000	471.64	646.51	2.5962	0.1688	0.0973	7.52
8.693	241.16	0.0000	0.00	0.00	0.0000	0.0000	0.0000	477.85	643.14	2.6084	0.1671	0.0969	7.32
8.693	243.53	0.0000	747.27	25.87	2.0972	0.0107	0.0277	484.05	639.78	2.6205	0.1655	0.0967	7.12
8.693	243.54	0.0420	747.31	25.87	2.0972	0.0107	0.0277	484.08	639.78	2.6205	0.1655	0.0967	7.12
8.693	243.55	0.0839	747.34	25.87	2.0972	0.0107	0.0277	484.12	639.78	2.6205	0.1655	0.0967	7.12
8.693	243.57	0.1259	747.38	25.87	2.0972	0.0107	0.0277	484.15	639.78	2.6205	0.1655	0.0966	7.12
8.693	243.58	0.1679	747.41	25.87	2.0972	0.0107	0.0277	484.19	639.78	2.6209	0.1655	0.0966	7.12
8.693	243.59	0.2098	747.45	25.87	2.0972	0.0107	0.0277	484.23	639.78	2.6209	0.1655	0.0966	7.12
8.693	243.61	0.2518	747.49	25.87	2.0972	0.0107	0.0277	484.27	639.78	2.6209	0.1655	0.0966	7.12
8.693	243.62	0.2938	747.52	25.87	2.0972	0.0107	0.0277	484.30	639.78	2.6209	0.1655	0.0966	7.12
8.693	243.63	0.3358	747.56	25.87	2.0976	0.0107	0.0277	484.34	639.78	2.6209	0.1655	0.0966	7.12
8.693	243.64	0.3778	747.60	25.87	2.0976	0.0107	0.0277	484.38	639.78	2.6209	0.1655	0.0966	7.12
8.693	243.66	0.4198	747.63	25.87	2.0976	0.0107	0.0277	484.42	639.78	2.6209	0.1655	0.0966	7.12
8.847	236.39	0.0000	0.00	0.00	0.0000	0.0000	0.0000	465.47	649.87	2.5841	0.1704	0.0976	7.73
8.847	239.13	0.0000	0.00	0.00	0.0000	0.0000	0.0000	472.58	646.02	2.5979	0.1685	0.0973	7.49
8.847	241.88	0.0000	0.00	0.00	0.0000	0.0000	0.0000	479.73	642.18	2.6121	0.1666	0.0969	7.26
8.847	244.61	0.0000	749.07	26.34	2.1022	0.0107	0.0279	486.88	638.18	2.6264	0.1647	0.0966	7.03
8.847	244.62	0.0420	749.11	26.34	2.1022	0.0107	0.0279	486.92	638.18	2.6264	0.1647	0.0966	7.03
8.847	244.63	0.0839	749.14	26.34	2.1022	0.0107	0.0279	486.95	638.18	2.6264	0.1647	0.0966	7.03
8.847	244.64	0.1259	749.18	26.34	2.1022	0.0107	0.0279	486.99	638.18	2.6264	0.1647	0.0966	7.03
8.847	244.66	0.1679	749.22	26.34	2.1026	0.0107	0.0279	487.02	638.18	2.6264	0.1647	0.0966	7.03
8.847	244.67	0.2098	749.25	26.34	2.1026	0.0107	0.0279	487.06	638.18	2.6264	0.1647	0.0966	7.03
8.847	244.68	0.2518	749.29	26.34	2.1026	0.0107	0.0279	487.10	638.18	2.6268	0.1648	0.0966	7.03
8.847	244.69	0.2938	749.32	26.34	2.1026	0.0107	0.0279	487.13	638.34	2.6268	0.1648	0.0966	7.03
8.847	244.71	0.3358	749.36	26.34	2.1026	0.0107	0.0279	487.17	638.34	2.6268	0.1648	0.0966	7.03
8.847	244.72	0.3778	749.40	26.34	2.1026	0.0107	0.0279	487.21	638.34	2.6268	0.1648	0.0966	7.03
8.847	244.74	0.4198	749.44	26.34	2.1026	0.0107	0.0279	487.25	638.34	2.6268	0.1648	0.0966	7.03
9.000	236.39	0.0000	0.00	0.00	0.0000	0.0000	0.0000	465.47	650.03	2.5841	0.1705	0.0978	7.73
9.000	239.48	0.0000	0.00	0.00	0.0000	0.0000	0.0000	473.49	645.70	2.5996	0.1683	0.0973	7.46
9.000	242.58	0.0000	0.00	0.00	0.0000	0.0000	0.0000	481.56	641.22	2.6155	0.1662	0.0967	7.20
9.000	245.67	0.0000	750.85	26.81	2.1076	0.0108	0.0279	489.68	636.73	2.6318	0.1640	0.0964	6.94
9.000	245.68	0.0420	750.89	26.81	2.1076	0.0108	0.0279	489.72	636.73	2.6318	0.1640	0.0964	6.94
9.000	245.70	0.0839	750.92	26.81	2.1076	0.0108	0.0280	489.76	636.73	2.6322	0.1640	0.0964	6.94
9.000	245.71	0.1259	750.96	26.81	2.1076	0.0108	0.0280	489.79	636.73	2.6322	0.1640	0.0964	6.94
9.000	245.72	0.1679	751.00	26.81	2.1076	0.0108	0.0280	489.83	636.73	2.6322	0.1640	0.0964	6.94
9.000	245.73	0.2098	751.03	26.81	2.1076	0.0108	0.0280	489.86	636.73	2.6322	0.1640	0.0964	6.94
9.000	245.75	0.2518	751.07	26.81	2.1076	0.0108	0.0280	489.90	636.73	2.6322	0.1640	0.0964	6.94
9.000	245.76	0.2938	751.10	26.81	2.1076	0.0108	0.0280	489.94	636.73	2.6322	0.1641	0.0964	6.94
9.000	245.78	0.3358	751.14	26.81	2.1081	0.0108	0.0280	489.97	636.73	2.6322	0.1641	0.0964	6.94
9.000	245.79	0.3778	751.17	26.81	2.1081	0.0108	0.0280	490.01	636.73	2.6322	0.1641	0.0964	6.94
9.000	245.80	0.4198	751.21	26.81	2.1081	0.0108	0.0280	490.05	636.73	2.6322	0.1641	0.0964	6.94
9.154	236.39	0.0000	0.00	0.00	0.0000	0.0000	0.0000	465.47	650.03	2.5841	0.1705	0.0976	7.73
9.154	239.84	0.0000	0.00	0.00	0.0000	0.0000	0.0000	474.42	645.22	2.6017	0.1681	0.0973	7.43
9.154	243.29	0.0000	0.00	0.00	0.0000	0.0000	0.0000	483.42	640.26	2.6193	0.1657	0.0967	7.14
9.154	246.72	0.0000	752.61	27.29	2.1127	0.0108	0.0280	492.46	635.29	2.6377	0.1633	0.0962	6.85
9.154	246.74	0.0420	752.65	27.29	2.1127	0.0108	0.0280	492.49	635.29	2.6377	0.1633	0.0962	6.85
9.154	246.75	0.0839	752.68	27.29	2.1127	0.0108	0.0280	492.53	635.29	2.6377	0.1633	0.0962	6.85
9.154	246.76	0.1259	752.71	27.29	2.1127	0.0108	0.0280	492.56	635.29	2.6377	0.1633	0.0962	6.85
9.154	246.78	0.1679	752.75	27.29	2.1127	0.0108	0.0280	492.60	635.29	2.6377	0.1633	0.0962	6.85
9.154	246.79	0.2098	752.79	27.29	2.1131	0.0108	0.0280	492.64	635.29	2.6377	0.1634	0.0962	6.85
9.154	246.80	0.2518	752.82	27.29	2.1131	0.0108	0.0280	492.67	635.29	2.6377	0.1634	0.0962	6.85
9.154	246.82	0.2938	752.86	27.29	2.1131	0.0108	0.0280	492.71	635.29	2.6381	0.1634	0.0962	6.85
9.154	246.83	0.3358	752.89	27.29	2.1131	0.0108	0.0280	492.75	635.29	2.6381	0.1634	0.0962	6.85
9.154	246.84	0.3778	752.93	27.29	2.1131	0.0108	0.0280	492.78	635.29	2.6381	0.1634	0.0962	6.85
9.154	246.86	0.4198	752.97	27.29	2.1131	0.0108	0.0280	492.82	635.29	2.6381	0.1634	0.0962	6.85




REVIEW

1. The UOP revamp conclusions are based on the assumption that all existing heater components that are to be re-used for the revamp are identical to the vendor's data sheets referenced above, and:
 - a. The tubes/fittings have normal original wall thickness.
 - b. No significant corrosion or metallurgical damage has occurred.
 - c. The tubes/fittings are not severely warped, bulged, nor oxidized.
 - d. The tubes/fittings are free of internal and external deposits.Changes to this information will require further review of this specification by UOP.
2. CTCI/heater vendor is responsible for the following:
 - a. Providing confirmation and guarantee that the existing heater will meet UOP's predicted thermal and hydraulic performance while complying with specified noise and emissions limits.
 - b. Conducting a detailed field inspection based upon consultation with the vendors.
 - c. Ensuring that the heaters and ancillary equipment are refurbished, as required, to provide for safe operation at the revamp conditions.
 - d. Verifying that the structural and mechanical integrity of the heater and ancillary equipment is satisfactory for the revamp conditions.
 - e. Ensuring compliance with existing codes and practices, including environmental regulations.
 - f. Ensuring that any replacement parts or modifications shall comply with the latest appropriate API/ISO standards. As a minimum, the replacement parts or modifications shall comply with the same standards as the original equipment.

8-1

CLIENT : CHIYODA / ARABIAN INDUSTRIAL FIBERS CO LTD
 CHIYODA PO : SAY POE 0002
 LOCATION : IBN RUSHD PTA & AROMATICS PLANT PROJECT
 EQUIPMENT : 54-B-01 CHARGE HEATER
 REQUISITION NO : 22854-MR-000-B-501

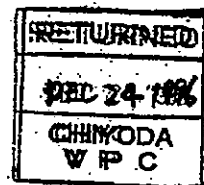

CHIYODA CORPORATION	
JOB NO. 51046	IBN RUSHD AROMATICS PROJECT
PONO. SAYPOE0002	
REQ NO. 22854000B501	
IDENT NO. 22854000B501	22854000B501
A-NO COMMENTS. PROCEED WITH FABRICATION	SAY TEAM
B-PROCEED WITH FABRICATION COMMENTS TO BE CONSIDERED	PYD MB
C-DO NOT PROCEED WITH FABRICATION	DATE 19 DEC 1986
PURCHASER'S PERMISSION TO PROCEED OR REVIEW TAKEN ON VENDOR PRINTS SHALL NOT RELIEVE VENDOR FROM ITS RESPONSIBILITIES OR LIABILITIES UNDER PURCHASE ORDER	

<table border="1"> <tr> <td>7</td> <td>JKS</td> <td>24/1/86</td> <td>AS NOTED</td> <td>MAR</td> <td>24/1/86</td> <td>Q1</td> <td>30/1/86</td> </tr> <tr> <td>6</td> <td>JAS</td> <td>8/8/86</td> <td>AS NOTED</td> <td>MAR</td> <td>12/8/86</td> <td>Q1</td> <td>18/8/86</td> </tr> <tr> <td>5</td> <td>BP</td> <td>2/1/86</td> <td>AS PER CLIENT COMMENTS</td> <td>ETW</td> <td>22/4/86</td> <td>Q1</td> <td>11/5/86</td> </tr> <tr> <td>4</td> <td>BP</td> <td>7/3/86</td> <td>AS NOTED</td> <td>RW</td> <td>7/3/86</td> <td>Q1</td> <td>11/3/86</td> </tr> <tr> <td>REV</td> <td>INITL</td> <td>DATE</td> <td>REVISIONS</td> <td>CHKD</td> <td>DATE</td> <td>APP</td> <td>DATE</td> </tr> </table>								7	JKS	24/1/86	AS NOTED	MAR	24/1/86	Q1	30/1/86	6	JAS	8/8/86	AS NOTED	MAR	12/8/86	Q1	18/8/86	5	BP	2/1/86	AS PER CLIENT COMMENTS	ETW	22/4/86	Q1	11/5/86	4	BP	7/3/86	AS NOTED	RW	7/3/86	Q1	11/3/86	REV	INITL	DATE	REVISIONS	CHKD	DATE	APP	DATE	CAT CODE: DI UNIT: 54-B-01	
7	JKS	24/1/86	AS NOTED	MAR	24/1/86	Q1	30/1/86																																										
6	JAS	8/8/86	AS NOTED	MAR	12/8/86	Q1	18/8/86																																										
5	BP	2/1/86	AS PER CLIENT COMMENTS	ETW	22/4/86	Q1	11/5/86																																										
4	BP	7/3/86	AS NOTED	RW	7/3/86	Q1	11/3/86																																										
REV	INITL	DATE	REVISIONS	CHKD	DATE	APP	DATE																																										
								TITLE: FIRE HEATER DATA SHEET																																									
								SPEC NO: 2881-54B01-ETD 002/A																																									
								SHEET 1 OF 9	REV 7																																								

MANUFACTURE AND CONSTRUCTION TO BE CARRIED OUT STRICTLY IN ACCORDANCE WITH THE REQUIREMENTS OF THIS DRAWING SPECIFICATION. NO CHANGES ARE TO BE MADE WITHOUT THE PRIOR AGREEMENT OF THE CHIEF ENGINEER OR THE ORGANISING SECTION WITHIN ENGINEERING DEPARTMENT.

066406

10-4-1

4/7

BORN

WORLD-WIDE MANUFACTURERS OF
DIRECT FIRED HEATERS
SI UNITS

PROCESS DESIGN CONDITIONS

1. Total duty heater, MW
2. Heater section
3. Service of heater
4. Heat Absorption heater, MW
5. Fluid Name
6. Flow rate, kg/hr
7. Flow rate, dm³/s
8. Press drop (allow, clean/fouled), bar
9. Press drop (calc, clean/fouled), bar
10. Fouling allowance, m(sq)-C(deg)/W
11. Therm conductivity of coke/scale, W/mC(deg)
12. Avg. radiant flux density (allowable), W/m(sq)
13. Avg. radiant flux density (calculated), W/m(sq)
14. Avg. convection flux density (allowable), W/m(sq)
15. Avg. convection flux density (calculated), W/m(sq)
16. Max radiant flux density, W/m(sq)
17. Max convection flux density, W/m(sq)
18. Velocity limitation, m/sec
19. Max. Allowable Inside film temperature, C(deg)

INLET CONDITIONS:

20. Temperature, C(deg)
21. Pressure, barg
22. Liquid flow, kg/hr
23. Vapor flow, kg/hr
24. Density of Liquid @ T. P., S.G
25. Vapor, molecular weight
26. Viscosity, liquid, mPa.s
27. Viscosity, vapor, mPa.s
28. Specific heat, liquid, KJ/kgC(deg)
29. Specific heat, vapor, KJ/kgC(deg)
30. Thermal conductivity, liquid, W/mC(deg)
31. Thermal conductivity, vapor, W/mC(deg)

OUTLET CONDITIONS:

32. Temperature, Degree C
33. Pressure, barg
34. Liquid flow, kg/hr
35. Vapor flow, kg/hr
36. Density of Liquid @ T. P., Kg/cuM
37. Vapor, molecular weight
38. Viscosity, liquid, mPa.s
39. Viscosity, vapor, mPa.s
40. Specific heat, liquid, KJ/kgC(deg)
41. Specific heat, vapor, KJ/kgC(deg)
42. Thermal conductivity, liquid, W/mC(deg)
43. Thermal conductivity, vapor, W/mC(deg)

REMARKS

44. Distillation data should be attached for vaporization service
45. Other

Service /Item Charge Heater 54B01
Type rad arbor Plant Location
w/ con sectn. Quantity 1
Owner Ref. No
Purchaser Chiyoda Ref. No.
Date 24/09/96 Born Ref No. BJ 2881
By: JAS Page 1 of 8



Deheptaniser reboiler		
16.89	7.55	
Radiant	Conv.	
Charge Heater 54B01		
16.89	7.55	
HC	HC	
283340	185472	
0.345	3.45	
0.316	2.11	
31546		
31423		
	2538	
56562		
	57085	
362	224	
12.845	8.85	
0	185472	
283340	0	
	0.668	
21		
	0.18	
0.018		
	2.515	
3.255		
	0.099	
0.13		
426	227	
12.50	5.40	
0	92736	
283340	92736	
	0.663	
21	106.2	
	0.177	
0.02	0.01	
	2.529	
3.410	2.009	
	0.099	
0.143	0.026	

CKJMAS 24/9/96
Rev. 7

DATASHT.XLS

066407

10-4-2

**WORLD-WIDE MANUFACTURERS OF
DIRECT FIRED HEATERS
SI UNITS**

Service /Item	Charge Heater 54B01		
Unit	rad arbor	Plant Location	
Type	w/ con sectn.	Quantity	1
Owner		Ref. No.	
Purchaser	Chiyoda	Ref. No.	
Date:	24/09/96	Born Ref No.	BJ 2881
By:	JAS	Page 2 of	8



CTCI CORPORATION

Combustion Design Conditions

1. Type of fuel
2. Excess air, percent
3. Calc heat release, MW (LHV)
4. Calc fuel efficiency, percent (LHV)
5. Calc thermal efficiency, percent (LHV)
6. Guaranteed thermal efficiency, percent (LHV)
7. Radiation loss, percent of heat rel (LHV)
8. Flue gas temp. leaving radiant section, C(deg)
9. Flue gas temp. leaving conv section, C(deg)
10. Flue gas temp. leaving air heater (uncorrected), C
11. Flue gas temp. leaving air heater (corrected), C(deg)
12. Max flue gas mass vel thru conv sect, kg/s² m(sq)
13. Volumetric heat release, W/m(cube) (LHV)
14. Ambient air temperature, C(deg)
15. Air temperature, stack design, C(deg)
16. Air temperature leaving air heater, C(deg)
17. Altitude above sea level; m
18. Draft @ Bridgwall, mm wg
19. Draft @ Burner, mm wg

Fuel Characteristics

20. Type of Fuel
21. Heating value (LHV), KJ/kg
22. Heating value (LHV), KJ/Nm(cube)
23. sp Gr. @ P, T.
24. H/C ratio (by weight)
25. Viscosity, @ _____ C(deg), mPa*s
26. Viscosity, @ _____ C(deg), mPa*s
27. Total salts, ppm
28. Vanadium, ppm
29. Sodium, ppm
30. Fixed nitrogen, ppm
31. Sulfur, percent by weight
32. Hydrogen sulfide, percent by volume
33. Ash, percent by weight
34. Liquids: ASTM initial boiling point, C(deg)
35. ASTM end point, C(deg)
36. Gases: Molecular weight
37. Composition, mol percent
38. Temperature at burner, C(deg)
39. Fuel pressure (available @ burner), kPa
40. Atomizing air stream pressure, kPa

Mechanical Design Conditions (General:)

41. Plot limitations _____
42. Tube limitations _____
Structural Design Data:
1. Wind Velocity, m/s _____
2. Wind exposure _____
3. Minimum ambient air temperature C(deg) _____

Structural Design Data:

1. Wind Velocity, m/s
2. Wind exposure
3. Minimum ambient air temperature C(deg)

GAS			
15			
28.00			
87.3			
86.3			
2.00			
780			
252			
1.38			
15	combustion design		
50			
3.00			
10.56			

[illegible]

Min Stack Ht. _____
Noise Limitations _____
_____ Wind occurrence _____
_____ Seismic Zone _____
0

Ckd MAB 24/1/76
Rev. 7

066408

DATASHT.XLS

10-4-3

**WORLD-WIDE MANUFACTURERS OF
DIRECT FIRED HEATERS
SI UNITS**

Service/Item	Charge Heater 54B01		
Unit	rad arbor	Plant Location	
Type	w/ con sectn.	Quantity	1
Owner		Ref. No.	
Purchaser	Chiyoda	Ref. No.	
Date:	24/09/96	Born Ref No.	BJ 2881
By:	JAS	Page 3 of	8



Coll Design: (RADIANT)

4. Design basis of tube wall thk. (code or specs)
5. Design basis for rupture strength, (min or avg)
6. Design life, hr
7. Elastic design pressure, bar
8. Rupture design pressure, bar
9. Temperature allowance, C(deg)
10. Corrosion allowance, mm
11. Stress relieve (YES or NO)
12. Weld inspection requirements radiography, %
13. Hydrostatic test pressure, BARG
14. Max tube metal temperature (clean) C(deg)
15. Design tube metal temperature C(deg)
16. Inside film coefficient, W/m C(deg)

Coil Configuration: (RADIANT)

17. Tubes (vertical or horizontal)
18. No. of flow passes
19. Effective tube length, m
20. Bare tubes, number
21. Bare tubes, exposed surface, m(sq)
22. Bare tubes, total exposed surface, m(sq)
23. Tubes, inline or staggered
24. Tube spacing, C to C, mm
- Tubes: (RADIANT)**
25. Material (ASTM spec. or grade).
26. Outside diameter, mm
27. wall thickness, mm or Sch
28. Overall tube length, m
29. No. of intermediate welds/pass
30. Distance from Center Line of tube to wall, mm

Heater Section

Plug-Type Headers:

31. Location (one end or both ends)
32. Manufacture and type
33. Nominal rating
34. Welded or rolled joint

Return Bends:

35. Location (header box or firebox)
36. Material (ASTM spec and grade)

[illegible]

128 NAB 24/9/96
Rev. 7

066409

DATASHT.XLS

10-11-11

BORN

WORLD-WIDE MANUFACTURERS OF
DIRECT FIRED HEATERS
SI UNITS

Service/Item Charge Heater 54801
Unit rad arbor Plant Location
Type w/ con sectn. Quantity
Owner Ref. No.
Purchaser Chiyoda Ref. No.
Date: 24/09/96 Born Ref No. BJ 2881
By: JAS Page 4 of 8



Coil Design: (CONVECTION)

4. Design basis of tube wall thk. (code)
5. Design basis for rupture strength
6. Design life, hr.
7. Elastic design pressure, BAR
8. Rupture design pressure, BAR
9. Temperature allowance, C(deg)
10. Corrosion allowance, mm
11. Stress relieve (yes or no)
12. Weld inspection requirements radiography, %
13. Hydrostatic test pressure, Barg
14. Max tube metal temperature (clean), C(deg)
15. Design tube metal temperature, C(deg)
16. Inside film coefficient, W/m(sq) C(deg)

Coil Configuration: (CONV.)

17. Tubes (vertical or horizontal)
18. No. of flow passes/tubes per row
19. Effective tube length, m
20. Bare tubes, number
21. Bare tubes, exposed surface, m(sq)
22. Ext tubes, number
23. Ext surface tubes, exp. surface, m(sq)
24. Ext surface tubes, total exp. surface, m(sq)
25. Tubes, staggered/inline
26. Tube spacing, C to C, mm

Tubes: (CONVECTION)

27. Material (ASTM spec. or grade)
28. Outside diameter, mm
29. wall thickness, mm or Sch
30. Overall tube length, m
31. No. of intermediate welds
32. Distance from tube center line to wall, mm

Description of Extended Surface:

33. Type (studs, serrated fins or solid fins)
34. Material
35. Fin Height, mm
36. Fin Thickness, mm
37. Fins Per m
38. Max tip temperature, C(deg)
39. Extension ratio

Heater Section

Plug-Type Headers:

40. Location (one end or both ends)
41. Manufacture and type
42. Nominal rating
43. Welded or rolled joint

Return Bends:

44. Location (header box or firebox)
45. Material (ASTM spec and grade)

BARE	EXT.	EXT.	EXT.
API 530	API 530	API 530	API 530
100,000	100,000	100,000	100,000
11.2	11.2	11.2	11.2
28	28	28	28
3.0	3.0	3.0	3.0
NO	NO	NO	NO
100	100	100	100
19.6	19.6	19.6	19.6
294	309	306	291
322	337	334	319
1709	1675	1630	1561
HORI.	HORI.	HORI.	HORI.
4 6	4 6	4 6	4 6
14.021	14.021	14.021	14.021
18	0	0	0
112.04			
0	6	6	30
	160.54	293.85	2408.00
	2862.39		
STAGGERED	STAGGERED	STAGGERED	STAGGERED
254	254	254	254
A106 GRB	A106 GRB	A106 GRB	A106 GRB
141.3	141.3	141.3	141.3
sch 40aw	sch 40 aw	sch 40 aw	sch 40 aw
18	6	6	30
127	127	127	127
	SOLID FIN	SOLID FIN	SOLID FIN
	Car/Stl	Car/Stl	Car/Stl
	12.70	19.10	
	1.30	1.30	1.30
	118	157	197
	353	370	354
	4.299	7.868	12.897
	Convection		
	NONE		
Header box	Header box	Header box	Header box
A-234-WPB	A-234-WPB	A-234-WPB	A-234-WPB

CKD MAB 24/9/96
Rev. 7

066410

DATASHT.XLS

10-4-5

BORN

WORLD-WIDE MANUFACTURERS OF
DIRECT FIRED HEATERS
SI UNITS

Service/Item Charge Heater 54B01
Unit rad arbor Plant Location
Type w/ con sectn. Quantity 1
Owner Ref. No.
Purchaser Chiyoda Ref. No.
Date: 24/09/96 Born Ref No. BJ 2881
By: JAS Page 5 of 8



Heater Section Continued:

Terminals:

1. Type (welded or flanged)

Inlet:

2. Material (ASTM spec and grade)
3. Size/rating, schedule or thickness
4. Number of terminals

Outlet:

5. Material (ASTM spec and grade)
6. Size/rating, schedule or thickness
7. Number of terminals

Manifolds:

8. Connection to tubes (weld or flanged)
9. Location (internal or external)

Inlet: Dead End

10. Material (ASTM spec and grade)
11. Size/schedule or thickness
12. Flange/material (ASTM spec and grade)
13. Flange size and rating

Outlet: Dead End

14. Material (ASTM spec and grade)
15. Size schedule or thickness
16. Flange/material (ASTM spec and grade)
17. Flange size and rating

Crossovers:

18. Location (internal or external)
19. Pipe mat'l (ASTM spec and grade)
20. Pipe size/schedule or thickness
21. Flange mat'l (ASTM spec and grade)
22. Flange size and rating

Tube Supports:

23. Location (top, bottom, intermediate)
24. Material (ASTM spec and grade)
25. Spacing
26. Coating (type and thickness)

Tube Guides:

27. Location and spacing (Top/Bottom)
28. Material (ASTM spec and grade)

Settings:

Floor:

29. Lining: Thickness - Hot face temp. - calc - design 200 780 C

30. Mat/thk/service temperature 200 MM LW CASTABLE

31. Anchor (type & mat'l)

32. Casing: Thickness - Material - Temperature 6 C.S. plate

Exposed Vertical Walls:

33. Lining: Thickness - Hot face temp. - calc - design 150 780 C

34. Mat/thk/service temperature 50- 128 kg/cum CFNB +100- 96 kg/cum CFNB+3mmstalestic

35. Anchor (type & mat'l) TP 310 SS Studs and Washers

36. Casing: Thickness - Material - Temperature 6 C.S. PLATE

Radiant

Convection

welded

Flanged

A335 P11

A106 GRB

28" x 9.525 mm AW

6" SCH 40 AW 300#

1

4

A335 P11

A106 GRB

30" x 9.525 mm AW

12" SCH 40AW 300# REWN

1

1

welded

welded

external

external

A335 P11

28"

A182 Gr F11

28" 9.525mmAW 300#

A335 P11

A234-WPB

30"

12"

A182 Gr F11

Pipe Cap

30" 9.525mm AW 300#

SCH 40 AW

INTER

ENDS

25/20CR NI

C.S. PLATE

approx 3500 mm

100 mm LW cast

INTER

25/20 Cr Ni

CKD MAB 24/1/96
Rev. 7

DATASHT.XLS

066411

10-4-6

BORN

WORLD-WIDE MANUFACTURERS OF
DIRECT FIRED HEATERS
SI UNITS

Service/Item Charge Heater 54B01
Unit rad arbor Plant Location
Type w/ con sectn. Quantity 1
Owner Ref. No.
Purchaser Chiyoda Ref. No.
Date: 24/09/96 Born Ref No. BJ 2881
By: JAS Page 6 of 8



Mechanical Design Conditions (continued)

Heater Section (continued):

Shielded Vertical Walls:

1. Lining: Thickness - Hot face temp. - calc - design 125 629 C 1260 C
2. Thk/Mat'l/service temperature 50 -128 kg/ cu m CFNB + 75 -96 kg/ cu m CFNB+3mm stalastic
3. Anchor (type & matl) TP 310 SS Studs and Washers
4. Casing: Thickness - Material - Temperature 6 C.S. plate

Arch:

5. Lining: Thickness - Hot face temp. - calc - design 150 780 C 1260 C
6. Thk/Mat'l/service temperature 50 mm 128kg/cu m CFNB + 100 mm 96 kg/ cu m CFNB+3mm stalastic
7. Anchor (type & matl) TP 310 SS Studs and Washers
8. Casing: Thickness - Material - Temperature 6 C.S. plate

Convection Walls:

9. Lining: Thickness - Hot face temp. - calc - design 125 516 C 1100 C
10. Thk/Mat'l/service temperature 125 mm LW castable
11. Anchor (type & matl) v type 304 SS
12. Casing: Thickness - Material - Temperature 6 C.S. plate

Breeching:

13. Lining: Thickness - Hot face temp. - calc - design 75 252 C 1093 C
14. Thk/Mat'l/service temperature LW CASTABLE
15. Anchor (type & matl) v type CS
16. Casing: Thickness - Material - Temperature 5

Flue Gas Ducts:

17. Location top of convection section
18. Lining (internal or external) internal
19. Thickness & Material 50 mm LW castable
20. Anchor, type and material CS 'v' anchors
21. Hot face design temperature
22. Cold face design temperature

Combustion Air Ducts:

23. Location FD fan to burner
24. Lining (internal or external)
25. Thickness and Material
26. Anchor, type and material
27. Hot face / cold face design temperature, C(deg)

Header Boxes:

28. Location
29. lining (Thickness & Material) Conv. ends Hinged doors/bolted Bolted
30. Anchor (type and material) 50 mm LW castable
31. Door/panel (matl and thickness) v type CS
C.S. plate

Burner Windboxes

32. Lining (internal or external) internal Matl & thk. mineral wool
33. Anchor (type and matl) CS 'v'
34. Casing: Materials and thk. CS 5
35. Hot face design temp., C(deg) Cold face design temp., C

CKD MAB 24/9/96
Rev. 7

066412

DATASHT.XLS

10-4-7

BORN

WORLD-WIDE MANUFACTURERS OF
DIRECT FIRED HEATERS
SI UNITS

Mechanical Design Conditions (continued)

Heater Section (continued):

Stack:

1. Location
Inside met. dia. at exit, mm
2. Min stack height above grade
3. Plate, min. thickness, mm
4. Lining : (Internal or External)
5. Thickness and Material, mm
6. Anchor, type and material:

Bridgewall:

7. Height, mm
- Matl and thickness:

Dampers:

8. Location
9. Material of blade
10. Material of shaft
11. Bearing type
12. Multiple or single blade
13. Desc of provision for operation
14. Location and type of operator

Miscellaneous:

Platforms:

- | | Location/No. |
|------------------------------|--------------|
| 15. Hearth / One | |
| 16. Convection Side(s) / One | |
| 17. Convection End(s) / Two | |
| 18. Rad Intermediate / One | |
| 19. Stack Damper / One | |
| 20. Stack Sample Port | |
| 21. Type of flooring | |
| Doors: | |
| 22. Access Doors | |
| 23 | |
| 24. Observation Doors | |
| 25 | |
| 26 | |
| 27. Steam Lance Doors | |
| 28 | |
| 29. Explosion Door | |
| 30 | |
| 31 | |

Instruments and Aux. connections

32. Process fluid temperature
33. Flue gas / combustion air temp.
34. Flue gas / combustion air pressure
35. Flue gas composition (sample)
36. Snuffing steam
37. Purge
38. Vents and drains
39. Tubekin thermocouples

CRD MAB 24/4/96
Rev. 7

Service /Item	Charge Heater 54B01	
Unit	rad airbor	Plant Location
Type	w/ con sectn.	Quantity 1
Owner		Ref. No.
Purchaser	Chiyoda	Ref. No.
Date:	24/09/96	Born Ref No. BJ 2881
By:	JAS	Page 7 of 8



top of heater	Corr Allow
2012	inside metal dia. at base, mm 3078
40 metres	total Stack length, mm 20016
6	Material: Carbon steel
Internal	Extent of lining To top
50	LW Castable
V type	CS

none	Location
------	----------

Stack
TP304SS
TP304SS
PILLOW BLOCK
Multiple blade
actuated

Width	Length/Arc	Access	
		Stairs/Ladder	Gr./Pl./Loc.
1100 mm	1 side + 2 ends	1stair/1ladder	GRADE
1100 mm		1 LADDER	
1100 mm		2 WALKWAYS	
1100 mm		1 Ladder	
1100 mm	270 DEGREE	1 LADDER	

Number	Location	Size	Hinged/Bolted
2	FLOOR	450 x 600	Hinged

13	RAD SIDE	127 x 406	HINGED(20-std-03)
----	----------	-----------	-------------------

4	CONV SIDE	600 x 150 bolted (BLS-D-106)	
---	-----------	------------------------------	--

Number	Size	Type
SEE DRAWING No. 2881/403/162DA		
2281-51B01-02A & 02B		
4	2" NPS	3000# CRG with Plug

066413


DATASHT.XLS

10-4-8

BORN

WORLD-WIDE MANUFACTURERS OF
DIRECT FIRED HEATERS
SI UNITS

Service /Item Charge Heater 54B01
Unit rad arbor Plant Location
Type w/ con sectn. Quantity 1
Owner Ref. No.
Purchaser Chiyoda Ref. No.
Date 24/09/96 Born Ref No. BJ 2881
By: JAS Page 8 of 8

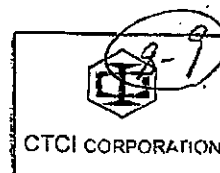

Mechanical Design Conditions (continued) Heater Section (continued):

1. Painting requirements:	22854-SP-000-X-002 System 2 and Prime Coat Only
2. Galvanizing requirements:	Ladders and Platforms
3. Internal coatings (casing, ducts, stack)	Stalastic behind ceramic fibre blanket
4. Fireproofing requirements:	None

Burner and Auxiliary Equipment:

Burners:

5. Manufacture/type	J.Z. PSFG	FD gas only	Location	rad floor
6. Designation/size	12	Number:	13	Fuel: gas
7. Heat rel. (MW per burner) at design excess air (Max/Norm/Min)	2.98		2.16	
8. Design press drop across burner	50mm		@ max heat release	
9. Distance burner centerline to tube centerline or	mm			
Distance burner centerline to unshielded refractory:	1100 mm		HORIZONTAL	
10. Burner pilot:				
Capacity (KW)	20	Fuel: Gas	Fuel press	
Fuel Pressure/ Fuel:		Type of ignition:	AUTO	
11. Special requirements: (flame detection devices, safety interlocks etc.)			UV SCANNERS	

Sootblowers:

12. Location	SPACE FOR FUTURE INSTALLATION
13. Manufacture and type	
14. Number	
15. Maximum cleaning radius, mm	
16. Lane dimensions (min. clearance)	
17. Orientation (horizontal or vertical)	
18. Cleaning medium	
19. Supply pressure/temperature	
20. Flow rate per blower, kg/s	
21. Materials of construction	
22. Driver type (manual, air, or elec.)	
23. Control systems type (auto or manual, sequential, local, or remote panel)	

CRS MAB 24/9/96
Rev. 7

056414

DATASHT.XLS

10-4-9



ARABIAN INDUSTRIAL FIBERS COMPANY

IR-II AROMATICS PROJECT

PROJECT NO. 10E0541A01

DOCUMENT TITLE:

XYLENE COLUMN REBOILER DATA SHEET

DOCUMENT NO:

DS-55-BA-501

						ابن رشد ibn rushd	ARABIAN INDUSTRIAL FIBERS COMPANY YANBU, KINGDOM OF SAUDI ARABIA	CTCI CORPORATION
						CERTIFIED		
2	Revised As Marked	KCK	CBC	YSL	11 Aug. 11	PROJ. _____		
1	Issued For Design	KCK	CBC	YSL	27-May.-11	MGR _____ DATE _____		
0	Issue For Approval	KCK	CBC	YSL	23-Mar.-11	CLIENT _____ DATE _____		
REV	DESCRIPTION	BY	CHK.	APPR.	DATE	PAGE 1 OF 2		XC33D-55-501

CONTENTS

<u>ITEM</u>	<u>EQUIPMENT NO.</u>	<u>SHEET NO.</u>	<u>REV. NO.</u>	<u>REV. DATE</u>
1.	55-B-01 A/B	1 THRU 5 OF 5	2	11-Aug.-2011

Attachment total 9 page.

XYLENE COLUMN REBOILER DATA SHEET

XC33D-55-501

2 OF 2

DATE
11-Aug.-2011
REV.
2

ابن رشد ibn rushd FLUOR	FIRED HEATER DATA SHEET	<table border="1" style="width: 100%; border-collapse: collapse;"> <tr><td>Contract:</td><td>10E0541A01</td></tr> <tr><td>Equipment No.:</td><td>55-B-01 A/B</td></tr> <tr><td>Revision:</td><td>2 Date: 11-Aug-2011</td></tr> <tr><td>Unit:</td><td>55 - Xylenes Fractionation</td></tr> <tr><td>P.O. No.:</td><td></td></tr> <tr><td>Document No.:</td><td>DS-55-BA-01</td></tr> <tr><td>Sheet:</td><td>1 of 5</td></tr> </table>	Contract:	10E0541A01	Equipment No.:	55-B-01 A/B	Revision:	2 Date: 11-Aug-2011	Unit:	55 - Xylenes Fractionation	P.O. No.:		Document No.:	DS-55-BA-01	Sheet:	1 of 5	 سابك sabik CTCI CORPORATION
Contract:	10E0541A01																
Equipment No.:	55-B-01 A/B																
Revision:	2 Date: 11-Aug-2011																
Unit:	55 - Xylenes Fractionation																
P.O. No.:																	
Document No.:	DS-55-BA-01																
Sheet:	1 of 5																
Client: Arabian Industrial Fibers Company (Ibn Rushd)		Vendor: Existing Born Heater - Revamped for New Service															
Service: Xylene Column Reboiler		Plant: Xylene Fractionation Site: Yanbu, Saudi Arabia															
Type of Heater: Vertical Cylindrical		Vendor: Existing Born Heater															
Total Heater Absorbed Duty: 114.44 MW		Assembly: Twin Vertical Cylindrical with Individual Convection Sections															
PROCESS DESIGN CONDITIONS																	
* OPERATION CASE		REVAMP															
HEATER SECTION		Radiant/Convec															
SERVICE		Process															
HEAT ABSORPTION MW		114.44															
FLUID NAME		Hydrocarbon															
FLOW RATE kg/hr		1,675,457															
FLOW RATE B.P.D.																	
PRESSURE DROP - ALLOWABLE (CLEAN / FOULED) bar																	
PRESSURE DROP - CALCULATED (CLEAN / FOULED) bar		2.1															
FOULING ALLOWANCE m ² ·°C/W																	
THERMAL CONDUCTIVITY OF COKE/SCALE W/m·°C																	
COKING ALLOWANCE mm																	
AVG. RADIANT SECTION FLUX DENSITY - ALLOWABLE W/m ²																	
AVG. RADIANT SECTION FLUX DENSITY - CALCULATED W/m ²																	
MAX. RADIANT SECTION FLUX DENSITY W/m ²																	
CONVECTION SECTION FLUX DENSITY, (BARE TUBE) W/m ²																	
VELOCITY LIMITATION m/s																	
PROCESS FLUID MASS VELOCITY kg/s·m ²																	
MAX. ALLOWABLE / CALCULATED INSIDE FILM TEMPERATURE °C																	
INLET CONDITIONS:																	
TEMPERATURE °C		267															
PRESSURE ☒ bar (g) ☐ bar (g)		12.27															
LIQUID FLOW kg/hr		1,675,457															
VAPOR FLOW kg/hr		0															
DENSITY - LIQUID kg/m ³		634.9															
VAPOR MOLECULAR WEIGHT																	
VISCOSITY - (LIQUID / VAPOR) mPa·s		0.177															
SPECIFIC HEAT - (LIQUID / VAPOR) kJ/kg·°C		2.733															
THERMAL CONDUCTIVITY - (LIQUID / VAPOR) W/m·°C		0.093															
OUTLET CONDITIONS:																	
TEMPERATURE °C		299															
PRESSURE ☒ bar (g) ☐ bar (g)		10.17															
LIQUID FLOW kg/hr		479,348															
VAPOR FLOW kg/hr		1,196,109															
DENSITY - LIQUID kg/m ³		588.2															
VAPOR MOLECULAR WEIGHT		124.7															
VISCOSITY - (LIQUID / VAPOR) mPa·s		0.155 0.011															
SPECIFIC HEAT - (LIQUID / VAPOR) kJ/kg·°C		2.927 2.356															
THERMAL CONDUCTIVITY - (LIQUID / VAPOR) W/m·°C		0.089 0.031															
REMARKS AND SPECIAL REQUIREMENTS:																	
DISTILLATION DATA OR FEED COMPOSITION: See Fluid Properties on Sheets 3 and 4																	
SHORT TERM OPERATING CONDITIONS:																	
OTHER:																	
NOTES:																	
See Notes on Sheet 5																	

**FIRED HEATER
DATA SHEET**

Contract: 10E0541A01
Equipment No.: 55-B-01 A/B
Revision: 2 Date: 11-Aug.-2011
Unit: 55 - Xylenes Fractionation
P.O. No.:
Document No.: DS-55-BA-01
Sheet: 3 of 5

FLUID PROPERTIES:														REV
PROCESS														
Thermodynamic condition			Vapor					Liquid						
Pressure bar(a)	Temp °C	Weight fraction vapor	Enthalpy kJ/kg	Density kg/m³	Specific heat kJ/kg-°C	Viscosity mPa-s	Thermal cond. W/m-°C	Enthalpy kJ/kg	Density kg/m³	Specific heat kJ/kg-°C	Viscosity mPa-s	Thermal cond. W/m-°C	Surface tension dyne/cm	
11.218	266.67	0.0000	0.00	0.00	0.0000	0.0000	0.0000	546.33	633.53	2.7323	0.1767	0.0935	6.93	
11.218	276.64	0.0000	0.00	0.00	0.0000	0.0000	0.0000	573.87	619.75	2.7880	0.1694	0.0919	6.14	
11.218	286.62	0.0000	0.00	0.00	0.0000	0.0000	0.0000	602.00	604.88	2.8491	0.1623	0.0905	5.38	
11.218	296.59	0.0000	851.48	37.84	2.3484	0.0108	0.0310	630.74	588.52	2.9174	0.1552	0.0891	4.64	
11.218	296.78	0.0710	851.85	37.85	2.3488	0.0108	0.0310	631.21	588.36	2.9182	0.1552	0.0891	4.63	
11.218	296.97	0.1420	852.23	37.86	2.3496	0.0108	0.0310	631.70	588.36	2.9195	0.1552	0.0891	4.63	
11.218	297.17	0.2132	852.63	37.87	2.3505	0.0108	0.0310	632.19	588.36	2.9203	0.1552	0.0890	4.63	
11.218	297.38	0.2844	853.04	37.89	2.3513	0.0108	0.0310	632.70	588.20	2.9216	0.1552	0.0890	4.63	
11.218	297.59	0.3558	853.46	37.90	2.3521	0.0108	0.0310	633.23	588.20	2.9224	0.1552	0.0890	4.62	
11.218	297.81	0.4273	853.89	37.91	2.3534	0.0108	0.0310	633.78	588.20	2.9236	0.1553	0.0890	4.62	
11.218	298.04	0.4989	854.34	37.93	2.3542	0.0108	0.0310	634.34	588.04	2.9249	0.1553	0.0890	4.62	
11.218	298.27	0.5706	854.80	37.94	2.3551	0.0108	0.0310	634.92	588.04	2.9262	0.1553	0.0890	4.61	
11.218	298.52	0.6424	855.28	37.96	2.3559	0.0108	0.0310	635.52	588.04	2.9274	0.1553	0.0888	4.61	
11.218	298.77	0.7144	855.78	37.97	2.3572	0.0108	0.0312	636.14	587.88	2.9287	0.1553	0.0888	4.61	
11.601	266.67	0.0000	0.00	0.00	0.0000	0.0000	0.0000	546.33	633.85	2.7323	0.1768	0.0935	6.93	
11.601	277.42	0.0000	0.00	0.00	0.0000	0.0000	0.0000	576.03	618.95	2.7926	0.1690	0.0919	6.08	
11.601	288.17	0.0000	0.00	0.00	0.0000	0.0000	0.0000	606.41	602.77	2.8592	0.1613	0.0903	5.26	
11.601	298.92	0.0000	855.71	39.28	2.3614	0.0108	0.0312	637.55	584.83	2.9345	0.1536	0.0888	4.46	
11.601	299.10	0.0710	856.08	39.29	2.3622	0.0108	0.0312	638.02	584.83	2.9358	0.1536	0.0888	4.46	
11.601	299.29	0.1421	856.46	39.30	2.3626	0.0108	0.0312	638.50	584.67	2.9366	0.1536	0.0888	4.46	
11.601	299.49	0.2132	856.85	39.32	2.3634	0.0108	0.0312	639.00	584.67	2.9379	0.1537	0.0888	4.46	
11.601	299.70	0.2845	857.26	39.33	2.3643	0.0108	0.0312	639.51	584.67	2.9387	0.1537	0.0886	4.46	
11.601	299.91	0.3558	857.68	39.35	2.3651	0.0108	0.0312	640.03	584.51	2.9400	0.1537	0.0886	4.45	
11.601	300.13	0.4273	858.11	39.36	2.3664	0.0108	0.0312	640.57	584.51	2.9412	0.1537	0.0886	4.45	
11.601	300.35	0.4989	858.56	39.37	2.3672	0.0108	0.0312	641.13	584.51	2.9425	0.1537	0.0886	4.45	
11.601	300.58	0.5706	859.02	39.39	2.3681	0.0108	0.0313	641.71	584.35	2.9433	0.1537	0.0886	4.44	
11.601	300.82	0.6425	859.49	39.41	2.3689	0.0108	0.0313	642.30	584.35	2.9446	0.1538	0.0884	4.44	
11.601	301.07	0.7144	859.99	39.42	2.3701	0.0108	0.0313	642.92	584.19	2.9463	0.1538	0.0884	4.44	
11.984	266.67	0.0000	0.00	0.00	0.0000	0.0000	0.0000	546.33	634.01	2.7323	0.1769	0.0935	6.93	
11.984	278.17	0.0000	0.00	0.00	0.0000	0.0000	0.0000	578.14	618.15	2.7972	0.1685	0.0917	6.02	
11.984	289.68	0.0000	0.00	0.00	0.0000	0.0000	0.0000	610.74	600.69	2.8692	0.1603	0.0902	5.15	
11.984	301.18	0.0000	859.82	40.74	2.3743	0.0108	0.0313	644.23	581.15	2.9521	0.1521	0.0884	4.30	
11.984	301.37	0.0710	860.19	40.75	2.3752	0.0108	0.0313	644.69	581.15	2.9530	0.1521	0.0884	4.30	
11.984	301.56	0.1421	860.57	40.77	2.3760	0.0108	0.0313	645.17	581.15	2.9542	0.1521	0.0884	4.30	
11.984	301.76	0.2132	860.96	40.78	2.3764	0.0108	0.0313	645.67	580.99	2.9555	0.1521	0.0884	4.29	
11.984	301.96	0.2845	861.37	40.79	2.3773	0.0108	0.0313	646.18	580.99	2.9563	0.1522	0.0884	4.29	
11.984	302.17	0.3559	861.79	40.81	2.3781	0.0108	0.0313	646.70	580.99	2.9576	0.1522	0.0883	4.29	
11.984	302.38	0.4274	862.21	40.82	2.3794	0.0108	0.0313	647.24	580.83	2.9588	0.1522	0.0883	4.29	
11.984	302.61	0.4989	862.66	40.84	2.3802	0.0108	0.0315	647.80	580.83	2.9597	0.1522	0.0883	4.28	
11.984	302.83	0.5707	863.12	40.85	2.3810	0.0108	0.0315	648.37	580.83	2.9609	0.1522	0.0883	4.28	
11.984	303.07	0.6425	863.59	40.87	2.3819	0.0108	0.0315	648.96	580.67	2.9622	0.1522	0.0883	4.28	
11.984	303.32	0.7145	864.08	40.89	2.3827	0.0108	0.0315	649.57	580.67	2.9638	0.1522	0.0881	4.27	
12.368	266.67	0.0000	0.00	0.00	0.0000	0.0000	0.0000	546.33	634.33	2.7323	0.1769	0.0935	6.93	
12.368	278.91	0.0000	0.00	0.00	0.0000	0.0000	0.0000	580.21	617.35	2.8014	0.1681	0.0916	5.97	
12.368	291.16	0.0000	0.00	0.00	0.0000	0.0000	0.0000	614.99	598.77	2.8793	0.1594	0.0898	5.04	
12.368	303.39	0.0000	863.83	42.22	2.3873	0.0109	0.0315	650.78	577.63	2.9697	0.1506	0.0881	4.14	
12.368	303.58	0.0710	864.19	42.23	2.3882	0.0109	0.0315	651.25	577.63	2.9710	0.1506	0.0881	4.14	
12.368	303.77	0.1421	864.57	42.25	2.3890	0.0109	0.0315	651.73	577.47	2.9718	0.1506	0.0881	4.14	
12.368	303.96	0.2133	864.96	42.26	2.3898	0.0109	0.0315	652.22	577.47	2.9730	0.1507	0.0881	4.13	
12.368	304.16	0.2845	865.37	42.28	2.3907	0.0109	0.0315	652.72	577.47	2.9739	0.1507	0.0881	4.13	
12.368	304.37	0.3559	865.78	42.29	2.3915	0.0109	0.0317	653.25	577.31	2.9751	0.1507	0.0881	4.13	
12.368	304.58	0.4274	866.21	42.30	2.3923	0.0109	0.0317	653.78	577.31	2.9764	0.1507	0.0879	4.13	
12.368	304.80	0.4990	866.65	42.32	2.3932	0.0109	0.0317	654.34	577.31	2.9777	0.1507	0.0879	4.12	
12.368	305.03	0.5707	867.10	42.34	2.3940	0.0109	0.0317	654.91	577.15	2.9789	0.1507	0.0879	4.12	
12.368	305.26	0.6425	867.57	42.35	2.3949	0.0109	0.0317	655.49	577.15	2.9802	0.1507	0.0879	4.12	
12.368	305.51	0.7145	868.06	42.37	2.3957	0.0109	0.0317	656.10	577.15	2.9814	0.1508	0.0879	4.12	
12.751	266.67	0.0000	0.00	0.00	0.0000	0.0000	0.0000	546.33	634.65	2.7323	0.1770	0.0935	6.93	
12.751	279.63	0.0000	0.00	0.00	0.0000	0.0000	0.0000	582.23	616.71	2.8060	0.1676	0.0916	5.91	
12.751	292.60	0.0000	0.00	0.00	0.0000	0.0000	0.0000	619.15	596.85	2.8889	0.1585	0.0897	4.93	
12.751	305.56	0.0000	867.72	43.72	2.4003	0.0109	0.0317	657.22	574.10	2.9877	0.1492	0.0877	3.99	
12.751	305.74	0.0710	868.09	43.73	2.4011	0.0109	0.0317	657.68	573.94	2.9885	0.1492	0.0877	3.98	
12.751	305.93	0.1421	868.47	43.74	2.4020	0.0109	0.0317	658.16	573.94	2.9898	0.1492	0.0877	3.98	
12.751	306.12	0.2133	868.86	43.76	2.4028	0.0109	0.0317	658.65	573.94	2.9906	0.1492	0.0877	3.98	
12.751	306.32	0.2846	869.26	43.78	2.4036	0.0109	0.0318	659.16	573.78	2.9919	0.1492	0.0877	3.98	
12.751	306.52	0.3559	869.67	43.79	2.4045	0.0109	0.0318	659.68	573.78	2.9931	0.1492	0.0877	3.97	
12.751	306.73	0.4274	870.09	43.81	2.4053	0.0109	0.0318	660.21	573.78	2.9944	0.1493	0.0877	3.97	
12.751	306.95	0.4990	870.53	43.82	2.4062	0.0109	0.0318	660.76	573.62	2.9957	0.1493	0.0876	3.97	
12.751	307.17	0.5707	870.98	43.84	2.4070	0.0109	0.0318	661.33	573.62	2.9969	0.1493	0.0876	3.97	
12.751	307.41	0.6426	871.45	43.86	2.4078	0.0109	0.0318	661.91	573.62	2.9982	0.1493			

**FIRED HEATER
DATA SHEET**



Contract: 10E0541A01
Equipment No.: 55-B-01 A/B
Revision: 2 Date: 11-Aug.-2011
Unit: 55 - Xylenes Fractionation
P.O. No.:
Document No.: DS-55-BA-01
Sheet: 4 of 5

FLUID PROPERTIES:														REV
PROCESS														
Thermodynamic condition			Vapor					Liquid						
Pressure bar(a)	Temp °C	Weight fraction vapor	Enthalpy kJ/kg	Density kg/m³	Specific heat kJ/kg·°C	Viscosity mPa·s	Thermal cond. W/m·°C	Enthalpy kJ/kg	Density kg/m³	Specific heat kJ/kg·°C	Viscosity mPa·s	Thermal cond. W/m·°C	Surface tension dyne/cm	
13.134	266.67	0.0000	0.00	0.00	0.0000	0.0000	0.0000	546.33	634.81	2.7323	0.1771	0.0935	6.93	
13.134	280.33	0.0000	0.00	0.00	0.0000	0.0000	0.0000	584.20	616.07	2.8102	0.1672	0.0914	5.86	
13.134	294.00	0.0000	0.00	0.00	0.0000	0.0000	0.0000	623.21	594.93	2.8989	0.1576	0.0895	4.83	
13.134	307.67	0.0000	871.52	45.23	2.4137	0.0109	0.0318	663.55	570.58	3.0057	0.1478	0.0876	3.83	
13.134	307.85	0.0710	871.89	45.25	2.4145	0.0109	0.0318	664.01	570.42	3.0065	0.1478	0.0876	3.83	
13.134	308.03	0.1421	872.26	45.26	2.4154	0.0109	0.0318	664.49	570.42	3.0078	0.1478	0.0876	3.83	
13.134	308.22	0.2133	872.65	45.28	2.4162	0.0109	0.0320	664.98	570.42	3.0091	0.1478	0.0874	3.83	
13.134	308.42	0.2846	873.05	45.29	2.4166	0.0109	0.0320	665.48	570.26	3.0099	0.1478	0.0874	3.83	
13.134	308.62	0.3560	873.46	45.31	2.4175	0.0109	0.0320	666.00	570.26	3.0111	0.1478	0.0874	3.82	
13.134	308.83	0.4275	873.88	45.33	2.4183	0.0109	0.0320	666.53	570.26	3.0124	0.1478	0.0874	3.82	
13.134	309.04	0.4991	874.32	45.34	2.4191	0.0109	0.0320	667.08	570.10	3.0137	0.1479	0.0874	3.82	
13.134	309.27	0.5708	874.76	45.36	2.4204	0.0109	0.0320	667.64	570.10	3.0149	0.1479	0.0874	3.82	
13.134	309.49	0.6426	875.23	45.38	2.4212	0.0109	0.0320	668.22	570.10	3.0166	0.1479	0.0872	3.81	
13.134	309.73	0.7146	875.71	45.39	2.4221	0.0109	0.0320	668.82	569.94	3.0178	0.1479	0.0872	3.81	
13.518	266.67	0.0000	0.00	0.00	0.0000	0.0000	0.0000	546.33	635.13	2.7323	0.1772	0.0935	6.93	
13.518	281.02	0.0000	0.00	0.00	0.0000	0.0000	0.0000	586.14	615.27	2.8144	0.1668	0.0914	5.81	
13.518	295.38	0.0000	0.00	0.00	0.0000	0.0000	0.0000	627.21	593.00	2.9086	0.1567	0.0893	4.72	
13.518	309.73	0.0000	875.22	46.77	2.4271	0.0110	0.0320	669.77	567.05	3.0241	0.1464	0.0872	3.69	
13.518	309.91	0.0710	875.58	46.79	2.4279	0.0110	0.0322	670.24	566.89	3.0254	0.1464	0.0872	3.69	
13.518	310.09	0.1421	875.96	46.80	2.4288	0.0110	0.0322	670.71	566.89	3.0262	0.1464	0.0872	3.68	
13.518	310.28	0.2133	876.34	46.82	2.4292	0.0110	0.0322	671.20	566.89	3.0275	0.1464	0.0872	3.68	
13.518	310.48	0.2846	876.74	46.83	2.4300	0.0110	0.0322	671.70	566.73	3.0287	0.1464	0.0872	3.68	
13.518	310.68	0.3560	877.15	46.85	2.4309	0.0110	0.0322	672.22	566.73	3.0300	0.1464	0.0871	3.68	
13.518	310.88	0.4275	877.57	46.87	2.4317	0.0110	0.0322	672.75	566.73	3.0308	0.1465	0.0871	3.68	
13.518	311.10	0.4991	878.00	46.88	2.4325	0.0110	0.0322	673.29	566.57	3.0325	0.1465	0.0871	3.67	
13.518	311.32	0.5708	878.45	46.90	2.4334	0.0110	0.0322	673.85	566.57	3.0338	0.1465	0.0871	3.67	
13.518	311.54	0.6427	878.91	46.92	2.4342	0.0110	0.0322	674.43	566.57	3.0350	0.1465	0.0871	3.67	
13.518	311.78	0.7146	879.38	46.94	2.4355	0.0110	0.0322	675.03	566.41	3.0363	0.1465	0.0871	3.67	
13.901	266.67	0.0000	0.00	0.00	0.0000	0.0000	0.0000	546.33	635.29	2.7323	0.1772	0.0935	6.93	
13.901	281.70	0.0000	0.00	0.00	0.0000	0.0000	0.0000	588.05	614.63	2.8181	0.1664	0.0912	5.75	
13.901	296.73	0.0000	0.00	0.00	0.0000	0.0000	0.0000	631.16	591.24	2.9186	0.1559	0.0891	4.62	
13.901	311.75	0.0000	878.83	48.33	2.4405	0.0110	0.0324	675.91	563.53	3.0425	0.1450	0.0871	3.55	
13.901	311.93	0.0710	879.19	48.34	2.4413	0.0110	0.0324	676.37	563.53	3.0438	0.1451	0.0869	3.55	
13.901	312.11	0.1421	879.56	48.36	2.4422	0.0110	0.0324	676.84	563.37	3.0451	0.1451	0.0869	3.54	
13.901	312.30	0.2133	879.95	48.38	2.4430	0.0110	0.0324	677.33	563.37	3.0463	0.1451	0.0869	3.54	
13.901	312.49	0.2846	880.34	48.39	2.4438	0.0110	0.0324	677.83	563.21	3.0476	0.1451	0.0869	3.54	
13.901	312.69	0.3560	880.75	48.41	2.4443	0.0110	0.0324	678.34	563.21	3.0488	0.1451	0.0869	3.54	
13.901	312.89	0.4275	881.17	48.43	2.4451	0.0110	0.0324	678.87	563.21	3.0501	0.1451	0.0869	3.53	
13.901	313.11	0.4991	881.60	48.44	2.4459	0.0110	0.0324	679.41	563.05	3.0513	0.1451	0.0867	3.53	
13.901	313.32	0.5709	882.04	48.46	2.4468	0.0110	0.0324	679.97	563.05	3.0526	0.1451	0.0867	3.53	
13.901	313.54	0.6427	882.50	48.48	2.4480	0.0110	0.0324	680.55	563.05	3.0539	0.1451	0.0867	3.53	
13.901	313.78	0.7146	882.97	48.50	2.4489	0.0110	0.0324	681.14	562.89	3.0555	0.1452	0.0867	3.52	
14.285	266.67	0.0000	0.00	0.00	0.0000	0.0000	0.0000	546.33	635.61	2.7323	0.1773	0.0935	6.93	
14.285	282.36	0.0000	0.00	0.00	0.0000	0.0000	0.0000	589.89	613.99	2.8223	0.1661	0.0912	5.70	
14.285	298.04	0.0000	0.00	0.00	0.0000	0.0000	0.0000	635.00	589.48	2.9282	0.1551	0.0890	4.53	
14.285	313.73	0.0000	882.34	49.91	2.4543	0.0110	0.0325	681.95	560.01	3.0618	0.1437	0.0867	3.41	
14.285	313.91	0.0710	882.71	49.92	2.4551	0.0110	0.0325	682.41	560.01	3.0631	0.1437	0.0867	3.41	
14.285	314.09	0.1422	883.08	49.94	2.4560	0.0110	0.0325	682.88	559.85	3.0643	0.1437	0.0867	3.41	
14.285	314.27	0.2134	883.46	49.96	2.4564	0.0110	0.0325	683.37	559.85	3.0656	0.1437	0.0865	3.40	
14.285	314.47	0.2847	883.85	49.97	2.4572	0.0110	0.0325	683.87	559.85	3.0668	0.1438	0.0865	3.40	
14.285	314.66	0.3561	884.26	49.99	2.4581	0.0110	0.0325	684.38	559.68	3.0681	0.1438	0.0865	3.40	
14.285	314.86	0.4276	884.67	50.01	2.4589	0.0110	0.0325	684.90	559.68	3.0693	0.1438	0.0865	3.40	
14.285	315.07	0.4992	885.10	50.03	2.4597	0.0110	0.0325	685.44	559.68	3.0706	0.1438	0.0865	3.39	
14.285	315.28	0.5709	885.54	50.05	2.4606	0.0110	0.0325	686.00	559.52	3.0719	0.1438	0.0865	3.39	
14.285	315.51	0.6427	886.00	50.07	2.4614	0.0110	0.0325	686.57	559.52	3.0735	0.1438	0.0864	3.39	
14.285	315.73	0.7147	886.46	50.09	2.4623	0.0110	0.0325	687.16	559.36	3.0748	0.1438	0.0864	3.39	
14.668	266.67	0.0000	0.00	0.00	0.0000	0.0000	0.0000	546.33	635.93	2.7323	0.1774	0.0935	6.93	
14.668	283.01	0.0000	0.00	0.00	0.0000	0.0000	0.0000	591.73	613.35	2.8265	0.1657	0.0910	5.65	
14.668	299.34	0.0000	0.00	0.00	0.0000	0.0000	0.0000	638.81	587.72	2.9379	0.1543	0.0888	4.43	
14.668	315.67	0.0000	885.78	51.51	2.4681	0.0110	0.0327	687.90	556.48	3.0815	0.1424	0.0864	3.28	
14.668	315.84	0.0710	886.14	51.53	2.4690	0.0110	0.0327	688.36	556.48	3.0827	0.1424	0.0864	3.27	
14.668	316.02	0.1422	886.51	51.54	2.4698	0.0110	0.0327	688.84	556.32	3.0840	0.1424	0.0864	3.27	
14.668	316.21	0.2134	886.89	51.56	2.4706	0.0110	0.0327	689.32	556.32	3.0853	0.1424	0.0864	3.27	
14.668	316.39	0.2847	887.28	51.58	2.4711	0.0110	0.0327	689.82	556.32	3.0865	0.1424	0.0864	3.27	
14.668	316.59	0.3561	887.68	51.60	2.4719	0.0110	0.0327	690.33	556.16	3.0878	0.1425	0.0864	3.26	
14.668	316.79	0.4276	888.10	51.62	2.4727	0.0110	0.0327	690.85	556.16	3.0890	0.1425	0.0862	3.26	
14.668	316.99	0.4992	888.52	51.64	2.4736	0.0110	0.0327	691.39	556.16	3.0907	0.1425	0.0862	3.26	
14.668	317.21	0.5709	888.96	51.65	2.4744	0.0110	0.0327	691.94	556.00	3.0920	0.1425	0.0862	3.26	
14.668	317.43	0.6428	889.41	51.67	2.4752	0.0111	0.0327	692.51						

		FIRED HEATER DATA SHEET		Contract: 10E0541A01 Equipment No.: 55-B-01 A/B Revision: 2 Date: 11-Aug.-2011 Unit: 55 - Xylenes Fractionation P.O. No.: Document No.: DS-55-BA-01 Sheet: 5 of 5			
NOTES							
MODIFICATIONS							
1. The existing Xylene Column Reboiler, Equipment No. 55-B-01 A/B, is suitable for the revamp conditions.							
2. No other modifications, except those given below are required for the existing heater as long as it is "fit for service", which shall be determined by CTCI : (Also, see "Revamp Notes" below).							
a. UOP combustion conditions shown on Sheet 2 of this data sheet are based on 'Sales Gas' composition given in UOP document number 951606 - A.4 "Basic Engineering Design Questionnaire, Rev. 3. CTCI/Heater Vendor shall confirm the adequacy of the existing burners and fuel gas supply system for the full range of fuel gas compositions anticipated for the revamp operation as shown in latest revision of Fluor document SP-000-AA-5002 "Basic Engineering Design Data".							
b. Due to inadequate data regarding the flue gas/combustion air heater, UOP has estimated the combustion air temperature at the burners based on heat balance. Heater vendor shall evaluate the adequacy of the entire air preheat system for the revamp operation.							
REFERENCE DATA							
1. Born Overall Layout & Plot Drawing No. 2881-55B01-01A Rev. 2 dated 7-Mar-96.							
4. Born General Arrangement Drawing No. 2881-55B01-02A Rev. 2 dated 7-Mar-96.							
5. Born API Fired Heater Data Sheet Rev. 5 dated 7-Mar-96 (8 pages).							
REVAMP NOTES							
1. The revamp conclusions are based on the assumption that all existing coil components that are to be re-used for the revamp are identical to the vendor's data sheets referenced above, and:							
a. The tubes/fittings have normal original wall thickness.							
b. No significant corrosion or metallurgical damage has occurred.							
c. The tubes/fittings are not severely warped, bulged, nor oxidized.							
d. The tubes/fittings are free of internal and external deposits.							
Changes to this information will require further review of this specification by UOP.							
2. CTCI/heater vendor is responsible for the following:							
a. Providing confirmation and guarantee that the existing heater will meet UOP's predicted thermal and hydraulic performance while complying with specified noise and emissions limits.							
b. Conducting a detailed field inspection based upon consultation with the component vendors.							
c. Ensuring that the heaters and ancillary equipment are refurbished, as required, to provide for safe operation at the revamp conditions.							
d. Verifying that the structural and mechanical integrity of the heater and ancillary equipment is satisfactory for the revamp conditions.							
e. Ensuring compliance with existing codes and practices, including environmental regulations.							
f. Ensuring that any replacement parts or modifications shall comply with the latest appropriate API/ISO standards. As a minimum, the replacement parts or modifications shall comply with the same standards as the original equipment.							

9-1

CLIENT : CHIYODA / ARABIAN INDUSTRIAL FIBERS CO LTD
 CHIYODA PO : SAY POE 0002
 LOCATION : IBN RUSHD PTA & AROMATICS PLANT PROJECT
 EQUIPMENT : 55-B-01 XYLENE COLUMN REBOILER
 REQUISITION NO : 22854-MR-000-B-501

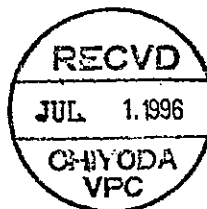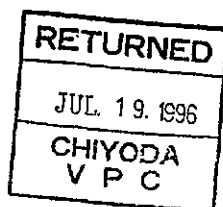

CHIYODA CORPORATION	
JOB NO. 51046	IBN RUSHD AROMATICS PROJECT
PO NO. SAY POE 0002	
REQ NO. 22854000B501	130
IDENT NO. 22854000B501 01 01-27 15	
A-NO COMMENTS PROCEED WITH FABRICATION	SAY TEAM
B-PROCEED WITH FABRICATION COMMENTS TO BE CONSIDERED	PYD P/11
C-DO NOT PROCEED WITH FABRICATION	DATE July 16 1996
PURCHASER'S PERMISSION TO PROCEED OR REVIEW TAKEN ON VENDOR PRINTS SHALL NOT RELIEVE VENDOR FROM ITS RESPONSIBILITIES OR LIABILITIES UNDER PURCHASE ORDER	

								CAT CODE: D1
								UNIT: 55-B-01
								069235
5	BP	10/5/96	AS CLIENT COMMENTS	ERW	2/5/96	DA	7/1/96	TITLE: FIRE HEATER DATA SHEET. SPEC NO: 2881- 55B01-ETD 002/A
4	BP	7/3/96	AS NOTES	RW	7/3/96	Q	11/1/96	
REV	INITL	DATE	REVISIONS	CHKD	DATE	APP	DATE	
NOTE: THIS DRAWING IS THE PROPERTY OF BORN INTERNATIONAL, INC. AND SHALL NOT BE REPRODUCED OR TRANSMITTED IN ANY FORM OR BY ANY MEANS, ELECTRONIC OR MECHANICAL, INCLUDING PHOTOCOPYING, RECORDING, OR BY ANY INFORMATION STORAGE AND RETRIEVAL SYSTEM. PERMISSION TO REPRODUCE THIS DRAWING IN ANY FORM OR BY ANY MEANS, ELECTRONIC OR MECHANICAL, INCLUDING PHOTOCOPYING, RECORDING, OR BY ANY INFORMATION STORAGE AND RETRIEVAL SYSTEM, SHALL BE OBTAINED FROM BORN INTERNATIONAL, INC.								SHEET 1 OF 9 REV 5
MANUFACTURE AND CONSTRUCTION TO BE CARRIED OUT STRICTLY IN ACCORDANCE WITH THE REQUIREMENTS OF THIS DRAWING SPECIFICATION. NO CHANGES ARE TO BE MADE WITHOUT THE PRIOR AGREEMENT OF THE CHIEF ENGINEER OR THE ORGANISING SECTION WITHIN ENGINEERING DEPARTMENT.								

11-5-1

ALTERNATE DESIGN

BORNWORLD-WIDE MANUFACTURERS OF
DIRECT FIRED HEATERS
SI UNITS

PROCESS DESIGN CONDITIONS

1. Total duty heater, MW
2. Heater section
3. Service of heater
4. Heat Absorption per heater, MW
5. Fluid Name
6. Flow rate, kg/hr
7. Flow rate, dm(cube)/s
8. Press drop (allow, clean/fouled), bar
9. Press drop (calc, clean/fouled), bar
10. Fouling allowance, m(sq)-C(deg)/W
11. Therm conductivity of coke/scale, WmC(deg)
12. Avg. radiant flux density (allowable), W/m(sq)
13. Avg. radiant flux density (calculated), W/m(sq)
14. Avg. convection flux density (allowable), W/m(sq)
15. Avg. convection flux density (calculated), W/m(sq)
16. Max radiant flux density, W/m(sq)
17. Max convection flux density, W/m(sq)
18. Velocity limitation, m/sec
19. Max. Allowable Inside film temperature, C(deg)

INLET CONDITIONS:

20. Temperature, C(deg)
21. Pressure, barg
22. Liquid flow, kg/hr
23. Vapor flow, kg/hr
24. Density of Liquid @ T. P. , S.G
25. Vapor, molecular weight
26. Viscosity, liquid, mPa.s
27. Viscosity, vapor, mPa.s
28. Specific heat, liquid, KJ/kgC(deg)
29. Specific heat, vapor, KJ/kgC(deg)
30. Thermal conductivity, liquid, W/mC(deg)
31. Thermal conductivity, vapor, W/mC(deg)

OUTLET CONDITIONS:

32. Temperature, Degree C
33. Pressure, barg
34. Liquid flow, kg/hr
35. Vapor flow, kg/hr
36. Density of Liquid @ T. P. , Kg/cuM
37. Vapor, molecular weight
38. Viscosity, liquid, mPa*s
39. Viscosity, vapor, mPa*s
40. Specific heat, liquid, KJ/kgC(deg)
41. Specific heat, vapor, KJ/kgC(deg)
42. Thermal conductivity, liquid, W/mC(deg)
43. Thermal conductivity, vapor, W/mC(deg)

REMARKS

44. Distillation data should be attached
for vaporization service
45. Other

Service /Item	Xylene column Reboiler 55B01		
Type	RAD CON VC	Plant Location	
		Quantity	2
Owner		Ref. No	
Purchaser	Chiyoda	Ref. No.	
Date	07/03/96	Bom Ref No.	BJ 2881
By:	BDP	Page 1 of	8

107.82		
Radiant	Conv.	
Xylene column Reboiler 55B01		
40.06	13.85	
HC	HC	
837728		
3.80		
2.000		
31546		
31528		
	3748	
56751		
	56833	
	281	
	14.60	
	837728	
	0	
	0.665	
	0.174	
	2.729	
	0.091	
	310	
	10.80	
	291780.5	
	545947.5	
	0.639	
	118.7	
	0.16	
	0.011	
	2.862	
	2.335	
	0.087	
	0.033	

BORN

WORLD-WIDE MANUFACTURERS OF
DIRECT FIRED HEATERS
SI UNITS

Combustion Design Conditions

1. Type of fuel
2. Excess air, percent
3. Calc heat release, MW (LHV)
4. Calc fuel efficiency, percent (LHV)
5. Calc thermal efficiency, percent (LHV)
6. Guaranteed thermal efficiency, percent (LHV)
7. Radiation loss, percent of heat rel (LHV)
8. Flue gas temp. leaving radiant section, C(deg)
9. Flue gas temp. leaving conv section, C(deg)
10. Flue gas temp. leaving air heater (uncorrected), C
11. Flue gas temp. leaving air heater (corrected), C(de
12. Max flue gas mass vel thru conv sect, kg/s* m(sq)
13. Volumetric heat release, W/m(cube) (LHV)
14. Ambient air temperature, C(deg)
15. Air temperature, stack design, C(deg)
16. Air temperature leaving air heater, C(deg)
17. Altitude above sea level, m
18. Draft @ Bridgwall, mm wg
19. Draft @ Burner, mm wg

Fuel Characteristics

20. Type of Fuel
21. Heating value (LHV), KJ/kg
22. Heating value (LHV), KJ/Nm(cube)
23. sp Gr. @ P, T.
24. H/C ratio (by weight)
25. Viscosity, @ _____ C(deg), mPa*s
26. Viscosity, @ _____ C(deg), mPa*s
27. Total salts, ppm
28. Vanadium, ppm
29. Sodium, ppm
30. Fixed nitrogen, ppm
31. Sulfur, percent by weight
32. Hydrogen sulfide, percent by volume
33. Ash, percent by weight
34. Liquids: ASTM initial boiling point, C(deg)
35. ASTM end point, C(deg)
36. Gases: Molecular weight
37. Composition, mol percent
38. Temperature at burner, C(deg)
39. Fuel pressure (available @ burner), kPa
40. Atomizing air stream pressure, kPa

Mechanical Design Conditions (General:)

41. Plot limitations
42. Tube limitations

Structural Design Data:

1. Wind Velocity, m/s
2. Wind exposure
3. Minimum ambient air temperature C(deg)

Service /Item Xylene column Reboiler 55B01
Unit RAD CON VC Plant Location
Type Quantity 2
Owner Ref. No.
Purchaser Chiyoda Ref. No.
Date: 07/03/96 Born Ref No. BJ 2881
By: BDP Page 2 of 8

with preheat	no preheat
GAS	gas
15	15
59.157	65.50
91.1	82.3
90.1	81.3
2.50	2.50
848	841
332	347
145	
1.36	1.50
15 combustion design	
50	
224	
0	
3.00	
15.11	
gas	
23376	
0.306 @ 15C	
15.6	
138	

Min Stack Ht. m
Noise Limitations

Wind occurrence
Seismic Zone

0

069237

ALTERNATE DESIGN

BORN

WORLD-WIDE MANUFACTURERS OF
DIRECT FIRED HEATERS
SI UNITS

Service/Item Xylene column Reboiler 55B01
Unit RAD CON VC Plant Location
Type Quantity 2
Owner Ref. No.
Purchaser Chiyoda Ref. No.
Date: 07/03/96 Born Ref No. BJ 2881
By: BDP Page 3 of 8

Coil Design: (RADIANT)

4. Design basis of tube wall thk. (code or specs)
5. Design basis for rupture strength, (min or avg)
6. Design life, hr
7. Elastic design pressure, barg
8. Rupture design pressure, barg
9. Temperature allowance, C(deg)
10. Corrosion allowance, mm
11. Stress relieve (YES or NO)
12. Weld inspection requirements radiography, %
13. Hydrostatic test pressure, BARG
14. Max tube metal temperature (clean) C(deg)
15. Design tube metal temperature C(deg)
16. Inside film coefficient, W/m2 C(deg)

Coil Configuration: (RADIANT)

17. Tubes (vertical or horizontal)
18. No. of flow passes
19. Effective tube length, m
20. Bare tubes, number
21. Bare tubes, exposed surface, m(sq)
22. Bare tubes, total exposed surface, m(sq)
23. Tubes, inline or staggered
24. Tube spacing, C to C, mm

Tubes: (RADIANT)

25. Material (ASTM spec. or grade)
26. Outside diameter, mm
27. wall thickness, mm or Sch
28. Overall tube length, m
29. No. of intermediate welds
30. Distance from Center Line of tube to wall, mm

Heater Section**Plug-Type Headers:**

31. Location (one end or both ends)
32. Manufacture and type
33. Nominal rating
34. Welded or rolled joint

Return Bends:

35. Location (header box or firebox)
36. Material (ASTM spec and grade)

RADIANT SHOCK

API 530	API 530
100000	100000
20.65	20.65
28	28
3	3
no	no
100	100
51.0	51.0
408	
436	436
710	1221
VERT	HORI
8	8
18.059	9.144
96	16
1193.24	77.39
1270.63	
IN LINE	STAGGERED
406.40	304.80
A106 GRB	A106 GRB
219.1	168.3
sch 40aw	sch 40aw
96	None
305	152
Radiant	
None	
firebox	header box
A234 WPB	A234 WPB

Rev. 5 BORN 3/7/96

DSHTB.XLS

069238

11-5-

ALTERNATE DESIGN

BORNWORLD-WIDE MANUFACTURERS OF
DIRECT FIRED HEATERS
SI UNITS

Service/Item	Xylene column Reboiler 55B01		
Unit	RAD CON VC	Plant Location	
Type		Quantity	2
Owner		Ref. No.	
Purchaser	Chiyoda	Ref. No.	
Date:	07/03/96	Born Ref No.	BJ 2881
By:	BDP	Page 5 of	8

Heater Section Continued:**Terminals:**

1. Type (welded or flanged)

Inlet:

2. Material (ASTM spec and grade)
3. Size/rating, schedule or thickness
4. Number of terminals

Outlet:

5. Material (ASTM spec and grade)
6. Size/rating, schedule or thickness
7. Number of terminals

Manifolds:

8. Connection to tubes (weld or flanged)
9. Location (internal or external)

Inlet:

10. Material (ASTM spec and grade)
11. Size/schedule or thickness
12. Flange/material (ASTM spec and grade)
13. Flange size and rating

Outlet:

14. Material (ASTM spec and grade)
15. Size schedule or thickness
16. Flange/material (ASTM spec and grade)
17. Flange size and rating

**Crossovers:**

18. Location (internal or external)
19. Pipe mat'l (ASTM spec and grade)
20. Pipe size/schedule or thickness
21. Flange mat'l (ASTM spec and grade)
22. Flange size and rating

Tube Supports:

23. Location (top, bottom, intermediate)
24. Material (ASTM spec and grade)
25. Spacing
26. Coating (type and thickness)

Tube Guides:

27. Location and spacing (Top/Bottom)
28. Material (ASTM spec and grade)

Settings:**Floor:**

29. Lining: Thickness - Hot face temp. - calc - design 200 827 C

30. Mat'l/thk/service temperature 200 MM LW CASTABLE

31. Anchor (type & mat'l)

32. Casing: Thickness - Material - Temperature 6mm C.S. plate

Exposed Vertical Walls:

33. Lining: Thickness - Hot face temp. - calc - design

34. Mat'l/thk/service temperature

35. Anchor (type & mat'l)

36. Casing: Thickness - Material - Temperature

Radiant	Convection	
FLANGED	Flanged	
	A105	
	6" SCH 40 300#	
	8 PER HEATER	
A105		
8" SCH 40AW 300#		
8 PER HEATER		
Flanged		
External		
None		
A106 GrB		
26" x STD WT		
None (Connections to Heater terminals only)		
26" x STD WT Bevelled		
EXTERNAL		
A 106 GRB		
6" SCH 40AW		
TOP	INTER	ENDS
25/20 CR NI	25/20/ CR/NI	C.S. PLATE
	4700 mm	
		100 mm LW cast
BOTTOM		
310 SS		

Rev

DSHTB.XLS

069240

11-5-

ALTERNATE DESIGN

BORN

WORLD-WIDE MANUFACTURERS OF
DIRECT FIRED HEATERS
SI UNITS

Service/Item Xylene column Reboiler 55B01
Unit RAD CON VC Plant Location
Type Quantity 2
Owner Ref. No.
Purchaser Chiyoda Ref. No.
Date: 07/03/96 Born Ref No. BJ 2881
By: BDP Page 4 of 8

Coil Design: (CONVECTION)

4. Design basis of tube wall thk. (code)
5. Design basis for rupture strength
6. Design life, hr
7. Elastic design pressure, BARG
8. Rupture design pressure, BARG
9. Temperature allowance, C(deg)
10. Corrosion allowance, mm
11. Stress relieve (yes or no)
12. Weld inspection requirements radiography, %
13. Hydrostatic test pressure, Barg
14. Max tube metal temperature (clean), C(deg)
15. Design tube metal temperature, C(deg)
16. Inside film coefficient, W/m(sq) C(deg)

Coil Configuration: (CONV.)

17. Tubes (vertical or horizontal)
18. No. of flow passes/tubes per row
19. Effective tube length, m
20. Bare tubes, number
21. Bare tubes, exposed surface, m(sq)
22. Ext tubes, number
23. Ext surface tubes, exp. surface, m(sq)
24. Ext surface tubes, total exp. surface, m(sq)
25. Tubes, staggered/inline
26. Tube spacing, C to C, mm
27. Material (ASTM spec. or grade)
28. Outside diameter, mm
29. wall thickness, mm or Sch
30. Overall tube length, m
31. No. of intermediate welds
32. Distance from tube center line to wall, mm

Description of Extended Surface:

33. Type (studs, serrated fins or solid fins)
34. Material
35. Fin Height, mm
36. Fin Thickness, mm
37. Fins Per m
38. Max tip temperature, C(deg)
39. Extension ratio

Heater Section**Plug-Type Headers:**

40. Location (one end or both ends)
41. Manufacture and type
42. Nominal rating
43. Welded or rolled joint

Return Bends:

44. Location (header box or firebox)
45. Material (ASTM spec and grade)

BARE	EXT.	EXT.	EXT.
API 530	API 530	API 530	API 530
100,000	100,000	100,000	100,000
20.65	20.65	20.65	20.65
28	28	28	28
3	3	3	3
NO	NO	NO	NO
100	100	100	100
51.0	51	51	51
323	356	334	352
351	384	362	380
1130	1141	1130	1130
HORI.	HORI.	HORI.	HORI.
8 16	8 16	8 16	8 16
9.144	9.144	9.144	9.144
32	0	0	0
154.68			
0	16	16	48
	328.87	328.87	2922.15
	3579.89		
STAGGERED	STAGGERED	STAGGERED	STAGGERED
304.8	304.8	304.8	304.8
A106 GR B	A106 GR B	A106 GR B	A106 GR B
168.3	168.3	168.3	168.3
sch 40aw	sch 40aw	sch 40aw	sch 40 aw
None	None	None	None
152	152	152	152
	SOLID FIN	SOLID FIN	SOLID FIN
	CS	CS	Car/StL
	12.70	12.70	25.40
	1.30	1.30	1.30
	118	118	197
	386	355	411
	4.252	4.252	12.594
Convection			
NONE			
Header box	Header box	Header box	Header box
A-234-WPB	A-234-WPB	A-234-WPB	A-234-WPB

BORN

WORLD-WIDE MANUFACTURERS OF
DIRECT FIRED HEATERS
SI UNITS

Service/Item	Xylene column Reboiler 55B01		
Unit	RAD CON VC	Plant Location	
Type		Quantity	2
Owner		Ref. No.	
Purchaser	Chiyoda	Ref. No.	
Date:	07/03/96	Born Ref No.	BJ 2881
By:	BDP	Page 6 of	8

Mechanical Design Conditions (continued)**Heater Section (continued):****Shielded Vertical Walls:**

1. Lining: Thickness - Hot face temp. - calc - design	125	618 C	1260 C
2. Thk/Mat'l/service temperature	50 -128 kg/ cu m CFNB + 75 -96 kg/ cu m CFNB+3mm stalastic		
3. Anchor (type & matl)	TP 310 SS Studs and Washers		
4. Casing: Thickness - Material - Temperature	6	C.S. plate	

Arch:

5. Lining: Thickness - Hot face temp. - calc - design	150	827 C	1260 C
6. Thk/Mat'l/service temperature	50 mm 128kg/cu m CFNB + 100 mm 96 kg/ cu m CFNB+3mm stlasti		
7. Anchor (type & matl)	TP 310 SS Studs and Washers		
8. Casing: Thickness - Material - Temperature	6	C.S. plate	

Convection Walls:

9. Lining: Thickness - Hot face temp. - calc - design	125	584 C	1100 C
10. Thk/Mat'l/service temperature	125 mm LW castable		
11. Anchor (type & matl)	v' type	304 SS	r1
12. Casing: Thickness - Material - Temperature	6	C.S. plate	

Breeching:

13. Lining: Thickness - Hot face temp. - calc - design	75	340 C	1093 C
14. Thk/Mat'l/service temperature	LW CASTABLE		
15. Anchor (type & matl)	v' type	CS	
16. Casing: Thickness - Material - Temperature	5		

Flue Gas Ducts:

17. Location	TO PREHEATER	FROM PREHEATER
18. Lining (internal or external)	internal	internal
19. Thickness & Material	125 mm LW castable	75 mm LW castable
20. Anchor, type and material	CS 'v' anchors	CS 'v' anchors
21. Hot face design temperature		
22. Cold face design temperature		

Combustion Air Ducts:

23. Location	APH to burners
24. Lining (internal or external)	internal
25. Thickness and Material	50mm LW castable
26. Anchor, type and material	CS
27. Hot face / cold face design temperature, C(deg)	

Header Boxes:

28. Location	Conv. ends	Hinged doors/bolted	Bolted
29. Lining (Thickness & Material)	50 mm LW castable		
30. Anchor (type and material)	v' type	CS	
31. Door/panel (matl and thickness)		C.S. plate	

Burner Windboxes

32. Lining (internal or external)	internal	Matl & thk.	mineral wool
33. Anchor (type and matl)	CS 'v'		
34. Casing: Materials and thk.	CS 5		
35. Hot face design temp., C(deg)		Cold face design temp.,C	

BORN

WORLD-WIDE MANUFACTURERS OF
DIRECT FIRED HEATERS
SI UNITS

Mechanical Design Conditions (continued)**Heater Section (continued):****Stack:**

1. Location
2. Inside met. dia. at exit , mm
Inside met. dia. at base, mm
3. Plate, min. thickness, mm
4. Lining : (Internal or External)
5. Thickness and Material, mm
6. Anchor, type and material:

Bridgewall:

7. Height, mm
Matl and thickness:

Dampers:

8. Location
9. Material of blade
10. Material of shaft
11. Bearing type
12. Multiple or single blade
13. Desc of provision for operation
14. Location and type of operator

Miscellaneous:**Platforms:**

- | | Location/No. |
|-----------------------------|--------------|
| 15. Hearth / One | |
| 16. Convection Side(s) /One | |
| 17. Convection End(s) /Two | |
| 18. Rad Intermediate /One | |
| 19. Stack Damper / One | |
| 20. Stack Sample Port | |
| 21. Type of flooring | |
| Doors: | |
| 22. Access Doors | |
| 23 | |
| 24. Observation Doors | |
| 25 | |
| 26 | |
| 27. Steam Lance Doors | |
| 28 | |
| 29 Explosion Door | |
| 30 | |
| 31 | |

Instruments and Aux. connections

32. Process fluid temperature
33. Flue gas / combustion air temp.
34. Flue gas / combustion air pressure
35. Flue gas composition (sample)
36. Snuffing steam
37. Purge
38. Vents and drains
39. Tubeskin thermocouples

Service /Item	Xylene column Reboiler 55B01
Unit	RAD CON VC Plant Location
Type	Quantity 2
Owner	Ref. No.
Purchaser	Chiyoda Ref. No.
Date:	07/03/96 Born Ref No. BJ 2881
By:	BDP Page 7 of 8

grade mounted stack common to both heaters

3642	Ht. above grade: mm	80910
4176	refer born drwg for layout	
6	Material:	Carbon steel
Internal	Extent of lining	To top
50	LW Castable	
v' type	CS	

none

Location

Stack

TP304SS

TP304SS

PILLOW BLOCK

Multiple blade

actuated

Width	Length/Arc	Access	
		Stairs/Ladder	Gr./Pl/loc.
1100 mm	360 DEGREE	1stair/1ladder	GRADE
1100 mm		1 LADDER	
1100 mm		2 WALKWAYS	
1100 mm		1 Ladder	
1100 mm	270 DEGREE	1 LADDER	

Number	Location	Size	Hinged/Bolted
2	FLOOR	450 x 600	Hinged
24	RAD SIDE	127 x 406	HINGED(20-std-03)
4	CONV SIDE	600 x 150 bolted	(BLS-D-106)
1	RAD SIDE	473 x 432	HINGED

Number	Size	Type
	SEE DRAWING No. 2881/403/162EA	
	2881-55B01-02A & 02B	
4	2" NPS	3000# CRG With Plug

BORN

WORLD-WIDE MANUFACTURERS OF
DIRECT FIRED HEATERS
SI UNITS

Service /Item	Xylene column Reboiler 55B01		
Unit	RAD CON VC	Plant Location	
Type		Quantity	2
Owner		Ref. No.	
Purchaser	Chiyoda	Ref. No.	
Date	07/03/96	Born Ref No.	BJ 2881
By:	BDP	Page 8 of	8

Mechanical Design Conditions (continued)**Heater Section (continued):**

1. Painting requirements:	22854-SP-000-X-002
	System 2 to Prime Coat Only
2. Galvanizing requirements.	Ladders and Platforms to ASTM A123
3. Internal coatings (casing, ducts, stack)	Stalastic behind cermic fibre blanket
4. Fireproofing requirements.	None

Burner and Auxillary Equipment:**Burners:**

5. Manufacture/type	J.Z. PSFG	FD gas only	Location	rad floor
6. Designation/Size	18	Number:	12	Fuel: gas
7. Heat rel. (MW per burner) at design excess air (Max\Norm)			4.93	with preheated air
Heat rel. (MW per burner) at design excess air (Max\Norm)		6.006	5.46	ambient air
8. Design press drop across burner		50 mm Wg		
Distance burner centerline to unshielded refractory:		18059 mm		
10. Burner pilot:		BCD = 5900 MM		
Capacity (KW)	20	Fuel: Gas	Fuel press	
Fuel Pressure/ Fuel:		Type of ignition:	AUTO	
11. Special requirements: (flame detection devices, safety interlocks etc.)			UV SCANNERS	

Sootblowers:

12. Location	SPACE FOR FUTURE INSTALLATION
13. Manufacture and type	
14. Number	
15. Maximum cleaning radius, mm	
16. Lane dimensions (min. clearance)	
17. Orientation (horizontal or vertical)	
18. Cleaning medium	
19. Supply pressure/temperature	
20. Flow rate per blower, kg/s	
21. Materials of construction	
22. Driver type (manual, air, or elec.)	
23. Control systems type (auto or manual, sequential, local, or remote panel)	



ARABIAN INDUSTRIAL FIBERS COMPANY

IR-II AROMATICS PROJECT

PROJECT NO. 10E0541A01

DOCUMENT TITLE:

XYLENE COLUMN DATA SHEET

DOCUMENT NO:

DS-55-CA-501

						ابن رشد	ARABIAN INDUSTRIAL FIBERS COMPANY YANBU, KINGDOM OF SAUDI ARABIA	CTCI CORPORATION
3	Revised as Marked	KWT.	CBC	YSL	11-Aug-11	CERTIFIED		
2	Issued for Design	KWY	CBC	YSL	31-Mar-11	PROJ.		
1	Revised as Marked	KWY	CBC	YSL	11-Mar-11	MGR _____ DATE _____		
0	Issue For Approval	KWY	SYL	YSL	1-Feb-11	CLIENT _____ DATE _____		
REV	DESCRIPTION	BY	CHK.	APPR.	DATE	PAGE 1 OF 2		XC32A-55-501

CONTENTS

<u>ITEM</u>	<u>EQUIPMENT NO.</u>	<u>SHEET NO.</u>	<u>REV. NO.</u>	<u>REV. DATE</u>
1.	55-C-01	1 THRU 2 OF 2	3	11-Aug.-2011

Attachment total 1 page.

ابن رشيد
ibn rushd

FLUOR

VERTICAL VESSEL DATASHEET

Contract: 10E0541A010
Equip. No.: 55-C-01
Revision: 3 Date: 11-Aug.-2011
Unit: 55 - Xylene Fract
PO No.:
Document No DS-55-CA-501
Sheet: 1 of 2

سابك
sabik



CTCI CORPORATION

REV

Client: Arabian Industrial Fibers Company

Plant: Xylene Fract

Service: Xylene Column

Site: Yanbu, Kingdom of Saudi Arabia

DESIGN SKETCH

VESSEL DIMENSIONS: ID: 7500 mm T/T: 68100 mm

DESIGN CONDITIONS

Pressure: 16.0 bar(g) at 348 °C
Vacuum: FV bar(g) at 320 °C
Min. Metal Temp: 9(NOTE16) °C at MAWP bar(g)
Liquid Level: Note 11 mm
Specific Gravity of Liquid: 0.597 at (NOTE15) °C

OPERATING CONDITIONS

Pressure: NOTE15 bar(g) at Note 10 °C
Vacuum: bar(g) at °C
Low Temperature: °C at °C
Hydrogen Partial Press. bar (a) at °C

INTERNALS & INSULATION

DESCRIPTION	Bulk Density kg/m³	Liquid Holdup vol%	Pressure Drop bar(g)
Packing:			Note 14
Catalyst:			
Mist Eliminator:			
Insulation	90 mm Hot ☐ Cold ☐		
Fire Proofing	75 mm Yes ☐ No ☐		


CONSTRUCTION

	Materials	Corrosion Allowance
Shell:	SA-516-70 N	3 mm
Heads	SA-516-70 N	3 mm
Support	SA-516-70 N	1.6 mm

SPECIAL CONDITIONS

Stress Relieve (Process Reason Only): Yes ☐ No ☒
Vessel in Wet Sour Service: Yes ☐ No ☒
Steamout Required: Yes ☒ No ☐

DESIGN SKETCH (CONTINUED)

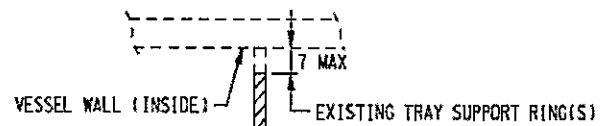

REMOVE EXISTING TRAY SUPPORT RING(S)
(IF NOT UTILIZED FOR THE NEW SERVICE)

WEIGHTS ARE BASED ON THE VENDOR CERTIFIED DRAWING No.

1-96-B9750-1 REV 4 (1997)

(kg)


EMPTY 901 500
OPERATING 1 367 200
FULL OF WATER 4 237 400

THICKNESS ARE BASED ON THE VENDOR CERTIFIED

DRAWING No. 1-96-B9750-01 REV 4 (1997)

(mm)

TOP HEAD 54
SHELL 55-58
BTM HEAD 58
SKIRT 25

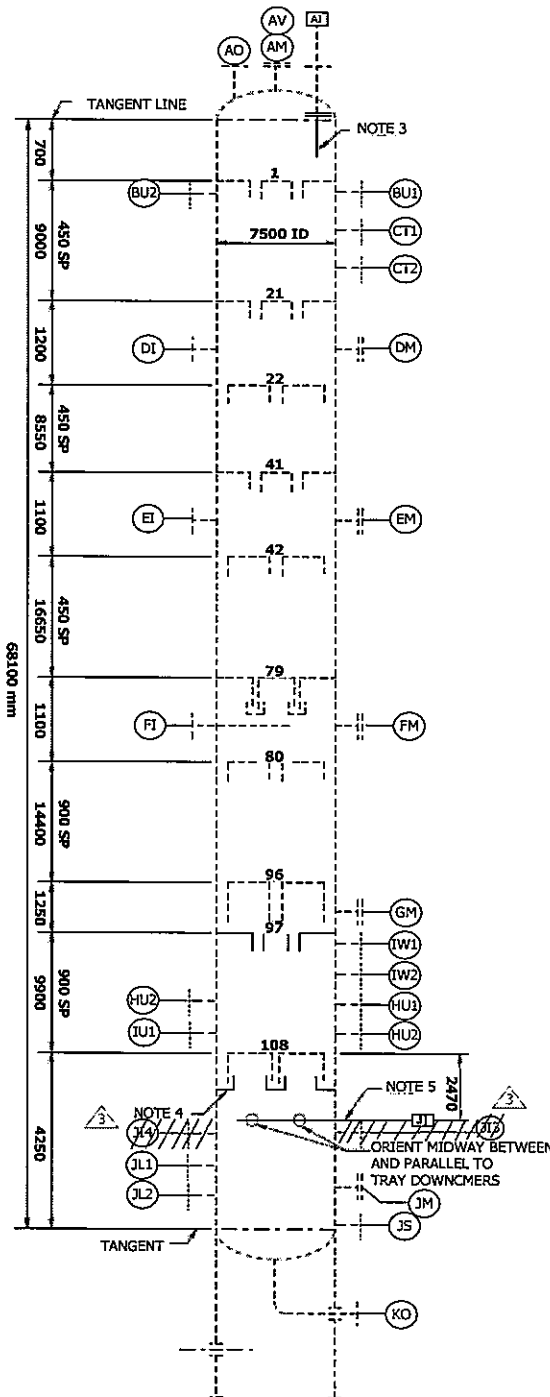

		VERTICAL VESSEL DATASHEET		Contract: 10E0541A01 Equip. No.: 55-C-01 Revision : 3 Date : 11-Aug-2011 Unit : 55 - Xylene Fract P.O. No. : Document No. : DS-55-CA-501 Sheet : 2 of 2			
NOZZLE SCHEDULE							
	TAG	QTY	SIZE in	PRESSURE RATING	DESCRIPTION		REV
1							
2	AI	1	14	300# RFWN	INLET (MODIFIED, SEE NOTE 3)		
3	AM	1	30	300# RFWN	MANWAY WITH COVER/LIFT LUG		
4	AO	1	34	300# RFWN	OUTLET		
5	AV	1	4	300# RFWN	VENT		
6	BU1/2	2	1	300# RFWN	TDIC-TI		
7	CT1/2	2	1 1/2	300# RFWN	ANALYZER		
8	DI	1	8	300# RFWN	INLET (NOT IN USE)		
9	DWEM/FM/GM/JM	5	24	300# RFWN	MANWAY WITH COVER/DAVIT		
10	EI	1	8	300# RFWN	INLET		
11	FI	1	6	300# RFWN	INLET		
12	HU1/2	2	1	300# RFWN	TDIC-TI		
13	IU1/2	2	1	300# RFWN	TI-TW		
14	IW1/2	2	1 1/2	300# RFWN	ANALYZER (NOT IN USE)		
15	JL1/2	2	2	300# RFWN	LEVEL		
16	JS	1	4	300# RFWN	STEAMOUT (NOTE17)		
17	KO	1	30	300# RFWN	OUTLET		
18	JI1/2	2	40	300# RFWN	INLET (NEW, SEE NOTE 5)		
19	JL3/4	2	24		INLET (NOT IN USE)		3
20							
21							
35	NOTES:						
36	1) This vessel tag number 55-C-01 is an existing vessel in the same service. Modifications required are as follows:						
37	2) From Tray #80-138 (existing tray numbering), every 4th tray (ie. 84, 88, 92, 96, 100, 104, 108, 112, 116, 120, 124, 128, 132, and 136) is						
38	to be retained. The other trays are to be removed / relocated as required for 900 mm tray spacing. Trays #137 and 138 are to be removed.						
39	3) Remove existing distributor at Nozzle "AI" and replace with new distributor with 12-inch outlet per U.O.P. DWG 3-170.						
40	4) Remove existing traps and install new traps below tray #108 per U.O.P. DWG 3-280.						
41	5) Remove existing Inlet Nozzles "JI" and replace with new 40-inch inlet Nozzles "JI", as shown.						
42	6) CTCL to verify the available thickness after evaluating maintenance records and performing UT testing and confirm. The CTCL to						
43	provide necessary ASME code documentation for the repair "R" stamp and new nameplate.						
44	7) Dimensions are in millimeter unless otherwise noted.						
45	8) Vessel heads are 2:1 Elliptical						
46	9) For nozzle elevation and orientation refer to vendor certified drawings nos. 1-96-B9750-1 REV 4 (1997) and 1-96-B9750-2 REV 4 (1997).						
47	10) Operating Temperature. Top: 248°C. Bottom: 299°C						
48	11) Normal liquid level (NLL) is 805 mm above bottom tangent line. HLL : 1049 mm. NLL : 561 mm.						2
49	12) Applicable specifications: SP-000-AA-5002, 22854-SP-000-A-003, 22854-SP-000-A-004, 22854-SP-000-D-001, 22854-SP-000-W-001,						
50	22854-SP-000-W-002, 22854-SP-000-W-003, P01-E07, T01-S01, 3-11.						
51	13) The following UOP standard drawings are applicable: 3-170, 3-280.						
52	14) Total pressure drop through column internals = 1.056 bar.						
53	15) Operating pressure Top: 8.27 bar(g) Bottom: 9.33 bar(g)						
54	16) The min. design ambient temperature should be 6 °C.						
55	17) Steamout at 150 (232 max) °C and 3.5 (4.1 max) bar (g).						
56							
57							
58							
59							

PROJECT	PTA & AROMATICS -	AFRD	<i>[Signature]</i>	<i>[Signature]</i>					
TITLE	AROMATICS	CHKD	<i>[Signature]</i>	<i>[Signature]</i>					
JOB NO.	5146	MADE	<i>[Signature]</i>	<i>[Signature]</i>					
DCC NO.	05-55-C-001 (1/1)	DATE	May 08 '91	Jan 30 '92					



25 East Alessandro Road • PO Box 3017 • Des Plaines, Illinois 60017-3017 • U.S.A.

VESSELS

PROJECT SPECIFICATION							
550693 - 301 - 2. SHEET 3							
REV	DATE	BY	APP'D	REV	DATE	BY	APP
0	5-11-95						
1	5-22-95	JWR	JWR				
2	1-03-95	MR	ASA				

SERVICE	(2)	XYLENE COLUMN	ITEM NO	55-C-01	C-500
---------	-----	---------------	---------	---------	------------------

Design Conditions at Top	INT 16.00 BAR (g)	+348 °C	(*) BY CONTRACTOR
	EXT FULL VACUUM	+320 °C	
	Metall Temperature (Min)	8 °C	
Operating Conditions	TOP	253 °C	
	BOTTOM	328 °C	

Radiograph	MR
Postaid Meat Trust	MR
Joint Efficiency	MR &
Material Specifications	
Heads	SAS16-70
Shells	SAS16-70

Shall	Thickness Required by Code in,	Corrosion Allowance in (Min)
-------	--------------------------------------	------------------------------------

[illegible]

1996			

Vessel Heads	
Top Head	2:1 ELLIPTICAL
Bottom Head	2:1 ELLIPTICAL

Accessories Applied by Fabricator	
Ladder & Platform Climb	AS REQUIRED (N)
Insulation Clips & Rings	YES

Virtual Support	YES
Nextgen and Manways	

Mark	No.	Size Inches	Service
------	-----	----------------	---------

AT	1	14	SMLE7
AP	1	30	MANNAY

AO	1	34	OUTLET (°)
AV	1	4	VENT

BU	2	1	TONE-TI, 10
CT	2	1 1/2	ANALYZER

DI	1	INLET
DI	1	MINI

OUT	1	2	3	100
INLET	1	2	3	100

24	1	24	RAYWAY
FI	1	8	INLET
			MASSACHUSETTS

FR	1	24	HAWAY
FR	1	24	HAWAY

10	2	1	FORC-T1, ID
----	---	---	-------------

14	2	1Y ₂	ANALYZER
JI	2	24	INLET

1	2	2	10:26
---	---	---	-------

JN	1	24	HANWAY
J3	1	4	STEAMBOAT


Class - ANSI C100 (1) SHEET 2-NOTE A

FACING - RAISED FACE

Normal Liquid Level = 805 MM ABOVE
BOTTOM TANGENT

Specific Gravity = 0.644
Delta-P Trays (Total) = 1.21 BAR
NOTES: MUST NOT BE LOCATED IN QUARTER

3. NOZZLES FIRST NOT BE EXPOSED TO DEHYDRATION.

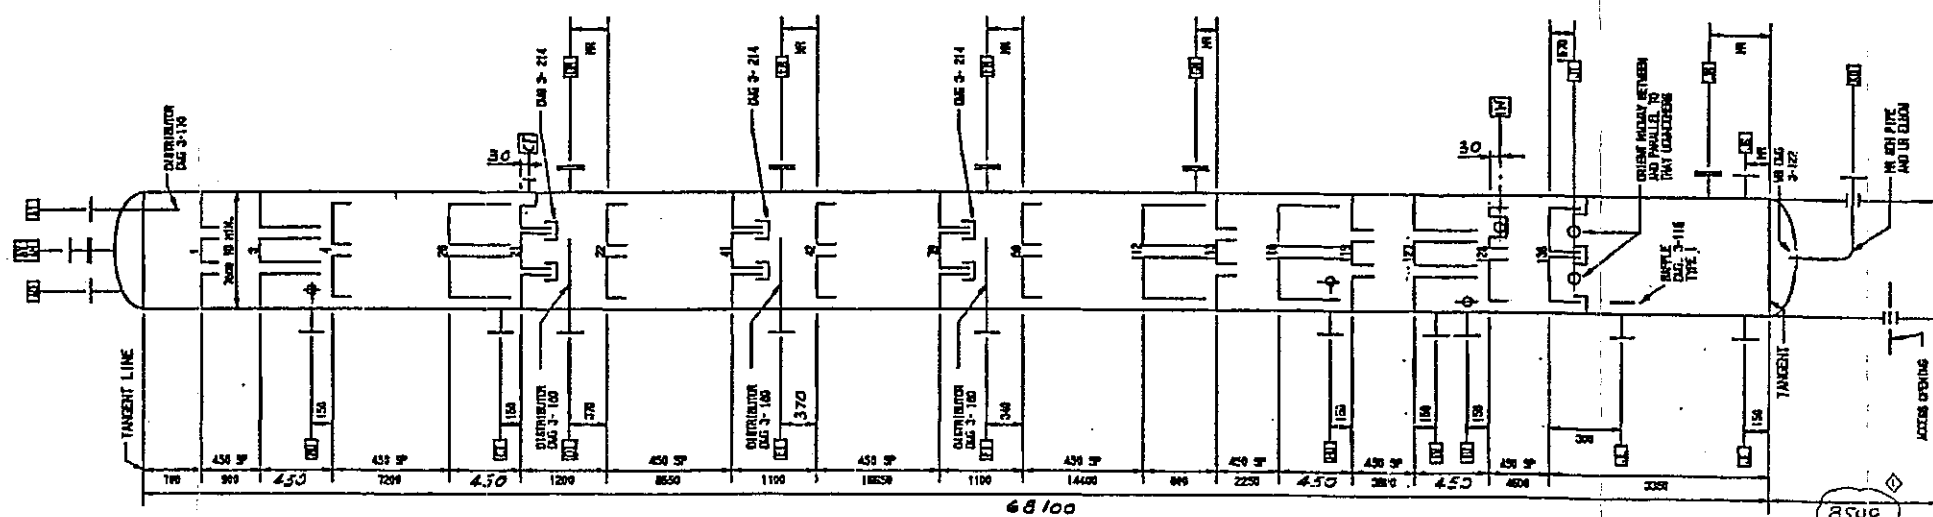[illegible]

Drawings Referred to in this Specification							
3-118-2	3-122-0	3-170-2	3-180-1	3-214-2			



ARABIAN INDUSTRIAL FIBERS COMPANY

IR-II AROMATICS PROJECT

PROJECT NO. 10E0541A01

DOCUMENT TITLE:

HEAVY AROMATICS COLUMN DATA SHEET

DOCUMENT NO:

DS-55-CA-502

						ابن رشيد SABIC	ARABIAN INDUSTRIAL FIBERS COMPANY YANBU, KINGDOM OF SAUDI ARABIA	CTCI CORPORATION
3	Revised as Marked	KWY.	CBC	YSL	11-Aug-11	CERTIFIED		
2	Issued for Design	KWY	CBC	YSL	31-Mar-11	PROJ.		
1	Revised as Marked	KWY	CBC	YSL	11-Mar-11	MGR _____ DATE _____		
0	Issue For Approval	KWY	SYL	YSL	1-Feb-11	CLIENT _____ DATE _____		
REV	DESCRIPTION	BY	CHK.	APPR.	DATE	PAGE 1 OF 2		XC32A-55-502

CONTENTS

<u>ITEM</u>	<u>EQUIPMENT NO.</u>	<u>SHEET NO.</u>	<u>REV. NO.</u>	<u>REV. DATE</u>
1.	55-C-02	1 THRU 3 OF 3	3	11-Aug.-2011
Attachment total 1 page				

ابن رشيد ابن رشيد FLUOR		VERTICAL VESSEL DATASHEET		Contract: 10E0541A01 Equip. No.: 55-C-02 Revision: 3 Unit: 55 - Xylene Fract PO No.: Document No.: DS-55-CA-502 Sheet: 1 of 3		سابك sabic CTCI CORPORATION																									
Client: Arabian Industrial Fibers Company Service: Heavy Aromatics Column		Plant: Xylene Fract Site: Yanbu, Kingdom of Saudi Arabia				REV																									
DESIGN SKETCH				DESIGN CONDITIONS																											
VESSEL DIMENSIONS: ID: 2600 mm T/T: 45700 mm				Pressure: 3.45 bar(g) at 290 °C Vacuum: FV bar(g) at 223 °C Min. Metal Temp: 9(NOTE20) °C at MAWP bar(g) Liquid Level: Note 13 mm Specific Gravity of Liquid: 0.684 at (NOTE12) °C																											
OPERATING CONDITIONS				Pressure: Note 19 bar(g) at Note 12 °C Vacuum: bar(g) at °C Low Temperature: °C at °C Hydrogen Partial Press. 0 bar(a) at °C																											
INTERNALS & INSULATION				<table border="1"> <thead> <tr> <th>DESCRIPTION</th> <th>Bulk Density kg/m³</th> <th>Liquid Holdup vol%</th> <th>Pressure Drop bar(g)</th> </tr> </thead> <tbody> <tr> <td>Packing:</td> <td></td> <td></td> <td></td> </tr> <tr> <td>Catalyst:</td> <td></td> <td></td> <td></td> </tr> <tr> <td>Mist Eliminator:</td> <td></td> <td></td> <td></td> </tr> <tr> <td>Insulation</td> <td>Note 14</td> <td>Hot ☒ Cold ☐</td> <td></td> </tr> <tr> <td>Fire Proofing</td> <td>75 mm</td> <td>Yes ☒ No ☐</td> <td></td> </tr> </tbody> </table>				DESCRIPTION	Bulk Density kg/m³	Liquid Holdup vol%	Pressure Drop bar(g)	Packing:				Catalyst:				Mist Eliminator:				Insulation	Note 14	Hot ☒ Cold ☐		Fire Proofing	75 mm	Yes ☒ No ☐	
DESCRIPTION	Bulk Density kg/m³	Liquid Holdup vol%	Pressure Drop bar(g)																												
Packing:																															
Catalyst:																															
Mist Eliminator:																															
Insulation	Note 14	Hot ☒ Cold ☐																													
Fire Proofing	75 mm	Yes ☒ No ☐																													
CONSTRUCTION				<table border="1"> <thead> <tr> <th></th> <th>Materials</th> <th>Corrosion Allowance</th> </tr> </thead> <tbody> <tr> <td>Shell:</td> <td>SA-516-70N</td> <td>3 mm</td> </tr> <tr> <td>Heads</td> <td>SA-516-70N</td> <td>3 mm</td> </tr> <tr> <td>Support</td> <td>SA-516-70N / A36</td> <td>1.6 mm</td> </tr> </tbody> </table>					Materials	Corrosion Allowance	Shell:	SA-516-70N	3 mm	Heads	SA-516-70N	3 mm	Support	SA-516-70N / A36	1.6 mm												
	Materials	Corrosion Allowance																													
Shell:	SA-516-70N	3 mm																													
Heads	SA-516-70N	3 mm																													
Support	SA-516-70N / A36	1.6 mm																													
SPECIAL CONDITIONS				Stress Relieve (Process Reason Only): Yes ☐ No ☒ Vessel in Wet Sour Service: Yes ☐ No ☒ Steamout Required: Yes ☒ No ☐																											
DESIGN SKETCH (CONTINUED)																															
WEIGHTS ARE BASED ON THE VENDOR CERTIFIED				DRAWING No. DA-7033-05-001 REV 3 (1997) (kg)																											
EMPTY				184 500																											
OPERATING				473 500																											
THICKNESS ARE BASED ON THE VENDOR CERTIFIED				DRAWING No. DA-7033-05-001 REV 3 (1997) (mm)																											
TOP HEAD				13																											
SHELL				13-20																											
BTM HEAD				20																											
SKIRT				20																											

[illegible]

ابن رشيد
ibn rushd
FLUOR


**VERTICAL VESSEL
DATASHEET**



Contract: 10E0541A01
Equip. No.: 55-C-02
Revision: 3 Date: 11-Aug.-2011
Unit: 55 - Xylene Fract
P.O. No.:
Document No.: DS-55-CA-502
Sheet: 3 of 3

سابك
sabc
CTCI CORPORATION

REV

PLATFORM SKETCH

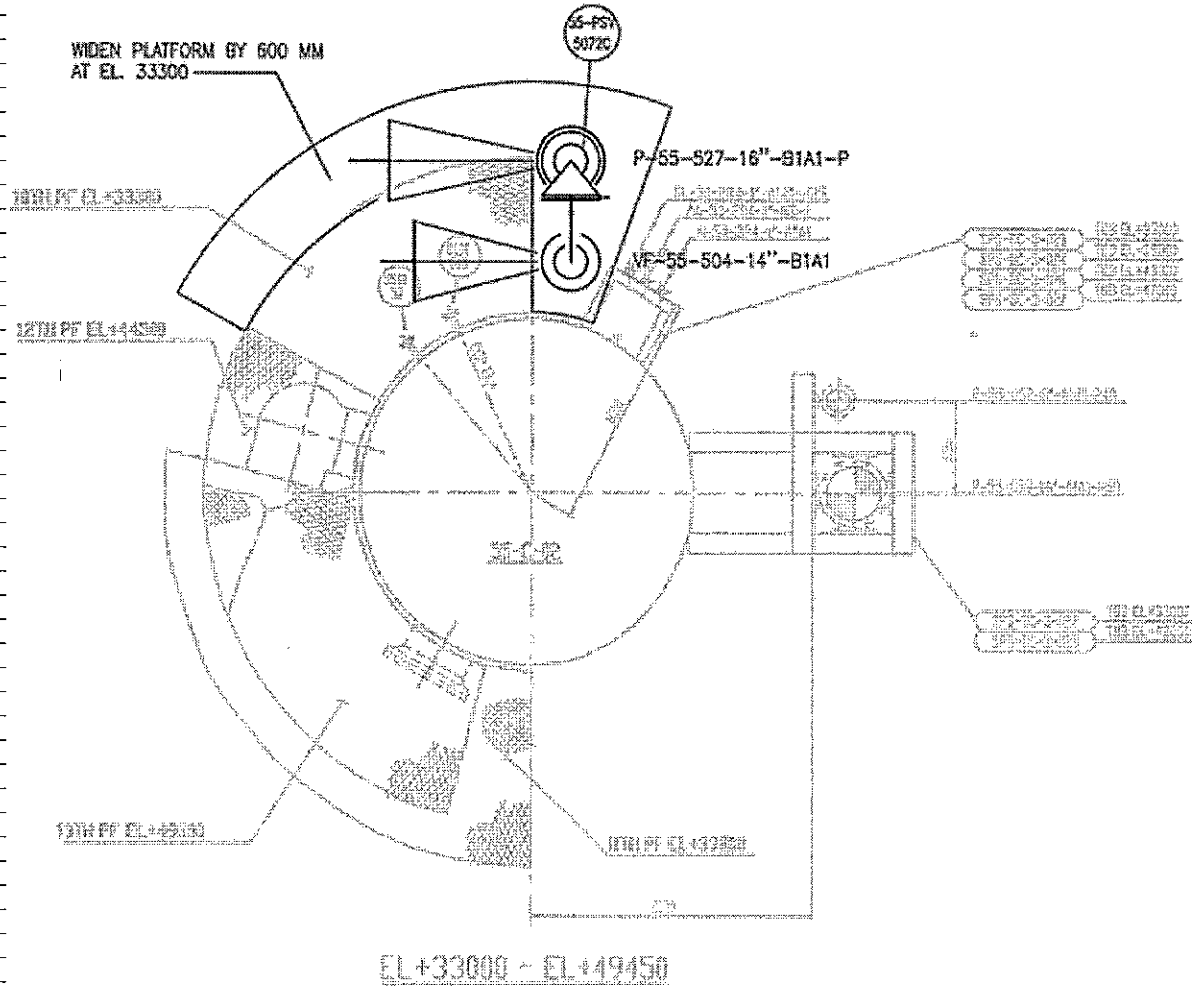

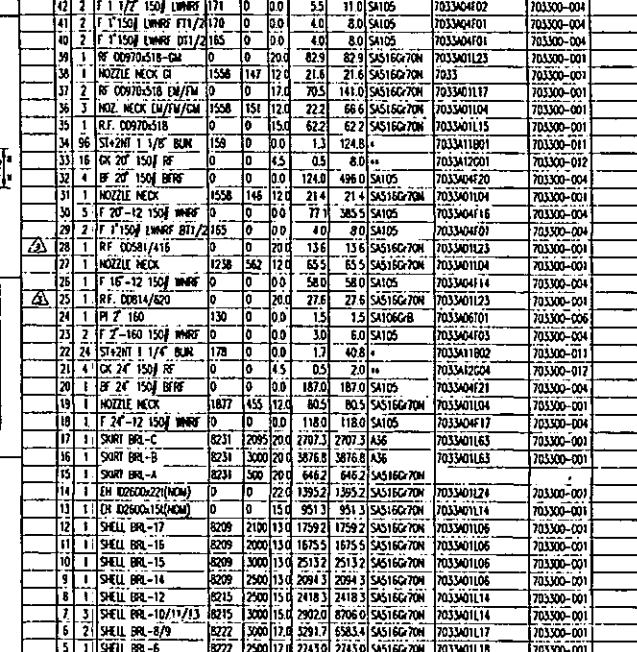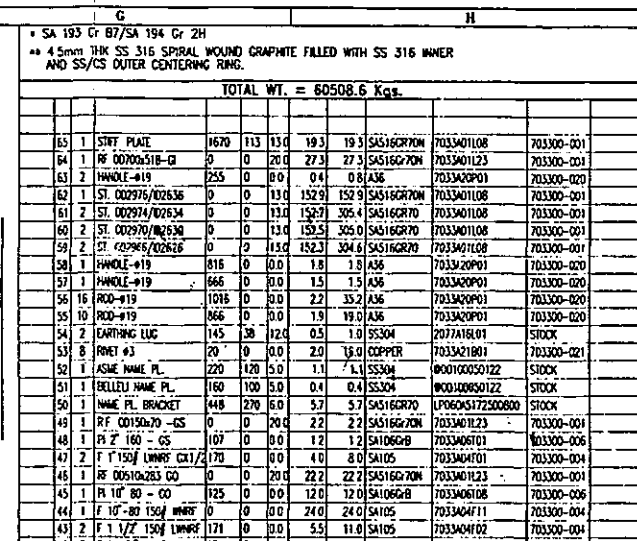

	4	2	ROLL	BR-5/2	8272	2000	170	71945	43890	SAS16G-70M	703300118	703300-01
	4	2	ROLL	BR-3/2	8272	3000	188	48666	69732	SAS16G-70M	703300120	703300-01
05-01	2	1	ROLL	BR-2	8250	2950	200	38122	38122	SAS16G-70M	703300123	703300-01
	1	1	ROLL	BR-1	8231	3050	300	39414	39414	SAS16G-70M	703300122	703300-01

FAM.	ITEM NO.	QTY	UNIT	DESCRIPTION	LENGTH	WIDTH	THICK	WT. IN KG.	MAT'L	MAT'L CODE	RDA. NO.

LIST OF MATERIAL

BELLELI SAUDI HEAVY INDUSTRIES LTD.

AS BUILT

CERTIFIED BY: *[Signature]*

CHYODA PETROSTAR LTD.

JOB NO. 54001 IBN RUSHD INDUSTRIES PROJECT

PO NO. SAY-POP0002

REC. NO. WP-50-C-003

IDENT. NO. 54002-OW-004

DATE: _____

TO: PROJECT MANAGER

FROM: PROJECT ENGINEER

FOR: PROJECT REVIEW

COPY TO: PROJECT MANAGER

PROJECT'S PERMISSION TO PROCEED OF REVIEW

UNDER NO VENDOR FINANCIAL SHALL NOT BE GIVEN

UNLESS FROM ITS RESPONSIBILITIES OR WARRANTIES

UNDER PURCHASE ORDER

3	21.05.97	REVISED AS MARKED  AND AS-BUILT	NB		
2	30.03.97	REVISED AS PER CLIENT'S COMMENTS AND MARKED 	RJP		YOGESH BANERJEE
1	17.10.96	DRAWING GENERALLY REVISED AND ISSUED FOR CONSTRUCTION	RJP		YOGESH BANERJEE
0	9.6.95	ISSUED FOR APPROVAL	R. YAJ		CHATTERJEE
REV.	DATE	DESCRIPTION	DRAWN	CHK'D	APP'D

No. REQUIRED : 1 UNIT

SCALE: 1 : 100

CLIENT	CHYODA/IBN RUSHD.	BELLELI SAUDI	بelleli Saudi
ORDER:	SAY-POP0002	HEAVY INDUSTRIES LTD.	المصانع الثقيلة المحدودة
		AL-JUBAIL, KINGDOM OF SAUDI ARABIA	الجبيل
		ARABIAN INDUSTRIAL FIBRES COMPANY (IBN RUSHD.	
		PTA & AROMATICS PROJECT-AROMATICS	
		ORTHOXYLENE COLUMN (55-C-02)	
		GENERAL ASSEMBLY	

DRAWING NO.	REV.
DA-7033-05-001	3

THIS DRAWING IS NOT TO BE REPRODUCED IN WHOLE OR PART NOR EMPLOYED FOR ANY PURPOSE OTHER THAN SPECIFICALLY PERMITTED IN WRITING BY BELLELI SAUDI HEAVY INDUSTRIES LTD.



ARABIAN INDUSTRIAL FIBERS COMPANY

IR-II AROMATICS PROJECT

PROJECT NO. 10E0541A01

DOCUMENT TITLE:

HEAVY AROMATICS COLUMN RECEIVER DATA SHEET

DOCUMENT NO:


DS-55-DA-503

						ابن رشد ibn rushd	ARABIAN INDUSTRIAL FIBERS COMPANY YANBU, KINGDOM OF SAUDI ARABIA	CTCI CORPORATION
						CERTIFIED		
2	Revised as Marked	KWY	CBC	YSL	11-Aug-11	PROJ.		
1	Issued for Design	KWY	CBC	YSL	26-Apr-11	MGR _____ DATE _____		
0	Issue For Approval	KWY	CBC	YSL	9-Mar-11	CLIENT _____ DATE _____		
REV	DESCRIPTION	BY	CHK.	APPR.	DATE	PAGE 1 OF 2		XC32B-55-503

CONTENTS

<u>ITEM</u>	<u>EQUIPMENT NO.</u>	<u>SHEET NO.</u>	<u>REV. NO.</u>	<u>REV. DATE</u>
1.	55-D-03	1 THRU 2 OF 2	2	11-Aug.-2011

Attachment total 2 pages

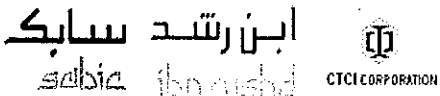	HEAVY AROMATICS COLUMN RECEIVER DATA SHEET		XC32B-55-503	
			2 OF 2	DATE 11-Aug.-2011
				REV. 2

ابن رشيد
ibn rushd

HORIZONTAL VESSEL DATA SHEET

Contract: 10E0541A01
Equip. No.: 55-D-03
Revision : 2 Date: 11-Aug.-2011
Unit : 55 - Xylene Fractionation
P.O. No.:
Document No. DS-55-DA-503
Sheet 1 of 2




CTCI CORPORATION

REV

Client: Arabian Industrial Fibers Company (Ibn Rushd) Plant: Xylene Fractionation
Service: Heavy Aromatic Column Receive Site: Yanbu, Kingdom of Saudi Arabia

DESIGN SKETCH

VESSEL DIMENSIONS: ID: 1800 F/T: 4200

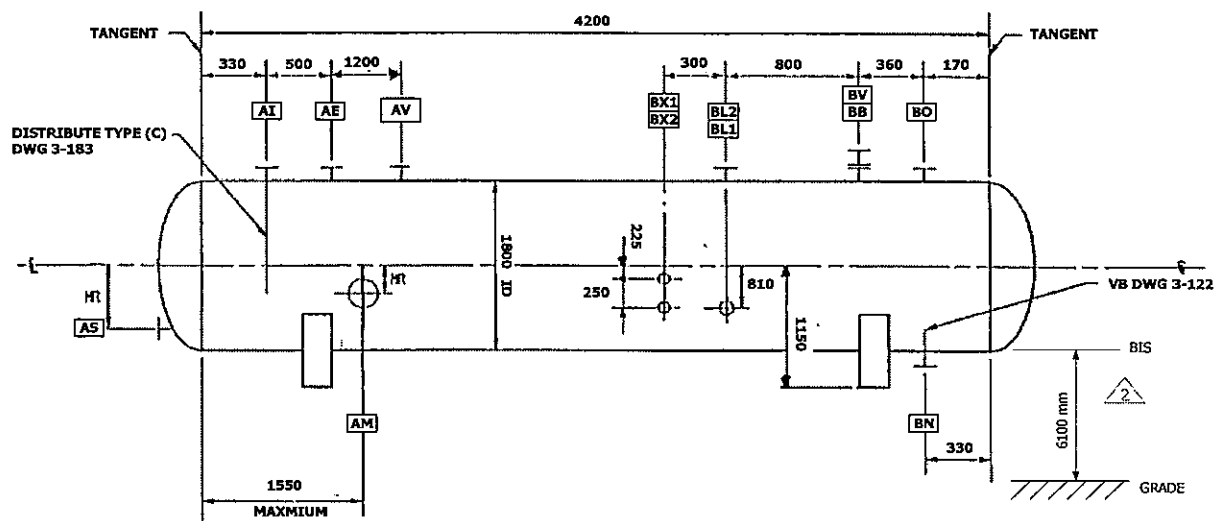

DESIGN CONDITIONS

Pressure:	3.79	bar(g)
At:	175	°C
Vacuum:	FV	bar(g)
At:	145.0	°C
Min. Design Metal Temp:	9(NOTE9)	°C
At:	MAWP	bar(g)
Liquid Level:	(Note4)	mm
Specific Gravity of Liquid:	0.739	

OPERATING CONDITIONS

Pressure +:	0.09	bar(g)
At:	165	°C
Vacuum -:		bar(g)
At:		°C
Low Temperature:		°C
At:		bar(g)
Hydrogen Partial Pressure:		bar(g)
At:		°C

INSULATION

Type:	HOT
Req'd Thickness:	40 mm
Fireproofing:	NO

CONSTRUCTION

MATERIALS	CORROSION ALLOWANCE
Shell: SA-516-70	3 mm
Head: SA-516-70	3 mm

INTERNALS

DESCRIPTION	BULK DENSITY kg/m³	LIQUID HOLDUP Vol. %	ΔP bar
Packing/Tray:	n/a	n/a	n/a
Catalyst:	n/a	n/a	n/a
Mist Eliminator:	n/a	n/a	n/a

NOTES & SPECIAL CONDITIONS

Stress Relieve (Process Reason):	
Vessel In Special Service:	
Steamout Required:	

THE ESTIMATED MECHANICAL WEIGHTS (kg)	
FABRICATED	
EMPTY	
OPERATING	
FULL OF WATER	
THE ESTIMATED WALL THICKNESS (mm)	
SHELL	
HEADS	

CHIYODA CORPORATION

CLIENT : IBN RUSHD

PROJECT : PTA & AROMATICS -

TITLE : AROMATICS

JOB NO. : 51046

DOC. NO.: DS-55-D-003 (V1)

REVISIONS			
MARK			
APRD	2/1/96	2/1/96	2/1/96
CHKD	2/1/96	2/1/96	2/1/96
MADE	2/1/96	2/1/96	2/1/96
DATE	Mar 28 '96	Apr 09 '96	May 24 '96

FOR RECORD

UOP

25 East Algonquin Road • PO Box 5017 • Des Plaines, Illinois 60017-5017 • U.S.A.

VESSELS

PROJECT SPECIFICATION

550693 - 301 - / SHEET 8

REV	DATE	BY	APP'D	REV	DATE	BY	APP'D
0	5-11-95						
1	1-04-95	MR	ASA				

SERVICE ORTHOXYLENE COLUMN RECEIVER

ITEM NO 550693-301-03

Design	INT 3.79 BAR (g)	175°C
Conditions	EXT FULL VACUUM	145°C
at Top	Metal Temperature (Min)	9°C
Operating		145°C
Conditions		°C

Radiograph	NR
Postweld Heat Treat	NR
Joint Efficiency	NR

Material Specifications	
Heads	SA 516-70
Shell	SA 516-70

Shell	Thickness / Corrosion Required by Allowance Code-mm. mm. (Min)
	3

Heads	
	3


Vessel Heads	
Vessel	2:1 ELLIPTICAL
Drop Leg	

Accessories Applied by Fabricator	
Ladder & Platform Clips	BY CONTRACTOR
Insulation Clips & Rings	YES
Vessel Support	YES

Nozzles and Manways	
Mark	No
Size	Inches
Service	

AE	1	2	EQUALIZING
AI	1	8	INLET
AM	1	20"	MANWAY
AS	1	2	STEAMOUT
BS	1	6	VENTILATION
BL	2	1 1/2	LC / LG
BN	1	8	OUTLET
BO	1	2	GAS IN/OUT
BV	1	2	VENT
BX	2	1	LLS
AU	1	4 ID	RELIEF

Class	ANSI CL 150
Facing	RAISED FACE
Normal Liquid Level	VESSEL CENTER LINE
Specific Gravity	0.767

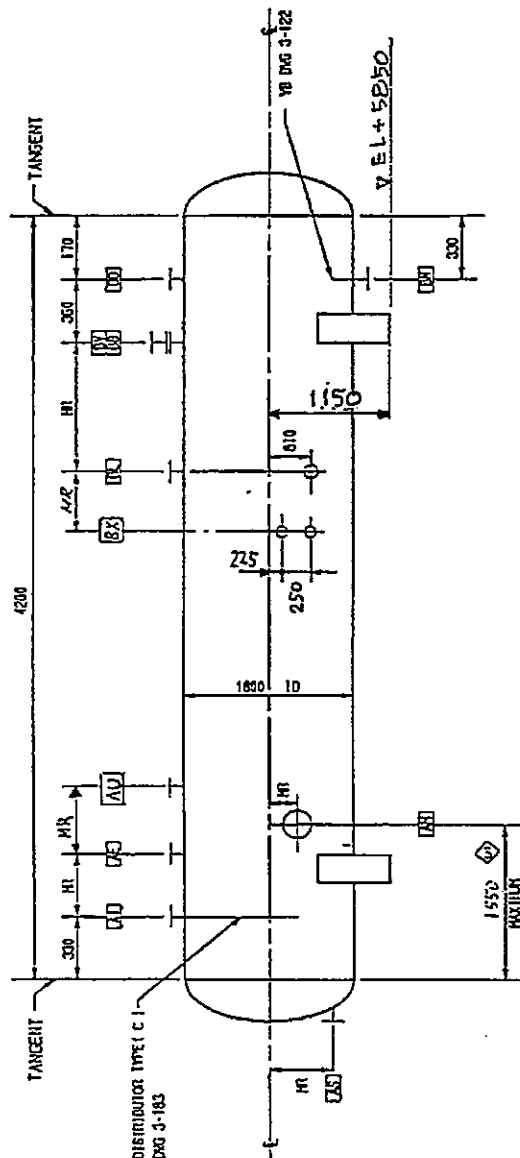

Drawings Referred to in this Specification

3-122-3 3-183-0 3-317-1

NOTE - These data are confidential and the property of UOP and shall not be disclosed to others or reproduced in any manner or used for any purpose whatsoever except by written permission or as provided in a signed agreement with UOP relating to such data.

509256



ARABIAN INDUSTRIAL FIBERS COMPANY

IR-II AROMATICS PROJECT

PROJECT NO. 10E0541A01

DOCUMENT TITLE:

TOLUENE/A9+ SURGE TANK DATA SHEET

DOCUMENT NO:

DS-55-DA-507

						ابن رشيد ibn rushid	ARABIAN INDUSTRIAL FIBERS COMPANY YANBU, KINGDOM OF SAUDI ARABIA	CTCI CORPORATION
3	Revised as Mareked	KWT	CMW	YSL	27 Oct.-11	CERTIFIED		
2	Revised as Mareked	KWY	CBC	YSL	09-Aug-11	PROJ.		
1	Issued for Design	KWY	CBC	YSL	22-Apr-11	MGR	DATE	
0	Issue For Approval	KWY	CBC	YSL	23-Mar-11	CLIENT	DATE	
REV	DESCRIPTION	BY	CHK.	APPR.	DATE	PAGE 1 OF 2	XC32B-55-507	

CONTENTS

<u>ITEM</u>	<u>EQUIPMENT NO.</u>	<u>SHEET NO.</u>	<u>REV. NO.</u>	<u>REV. DATE</u>
1.	55-D-07A/B	1 THRU 2 OF 2	3	27-Oct.-2011
Attachment total 4 page				

ابن رشد سابق
 Al-Bin Rushd



TOLUENE/A9+ SURGE TANK
DATA SHEET

XC32B-55-507

2 OF 2

DATE
27-Oct.-2011

REV.

3

ابن رشيد
ibn rushd

STORAGE TANK DATA SHEET

Contract: 10E0541A01
Equip. No.: 55-D-07 A/B
Revision : 3 Date: 27-Oct.-2011
Unit : 55 - Xylene Fractionation
P.O. No.:
Document No. DS-55-DA-507
Sheet 1 of 2




CTCI CORPORATION

REV

Client: Arabian Industrial Fibers Company (Ibn Rushd) Plant: Xylene Fractionation
Service: TOLUENE/A9+ SURGE TANK Site: Yanbu, Kingdom of Saudi Arabia

DESIGN SKETCH

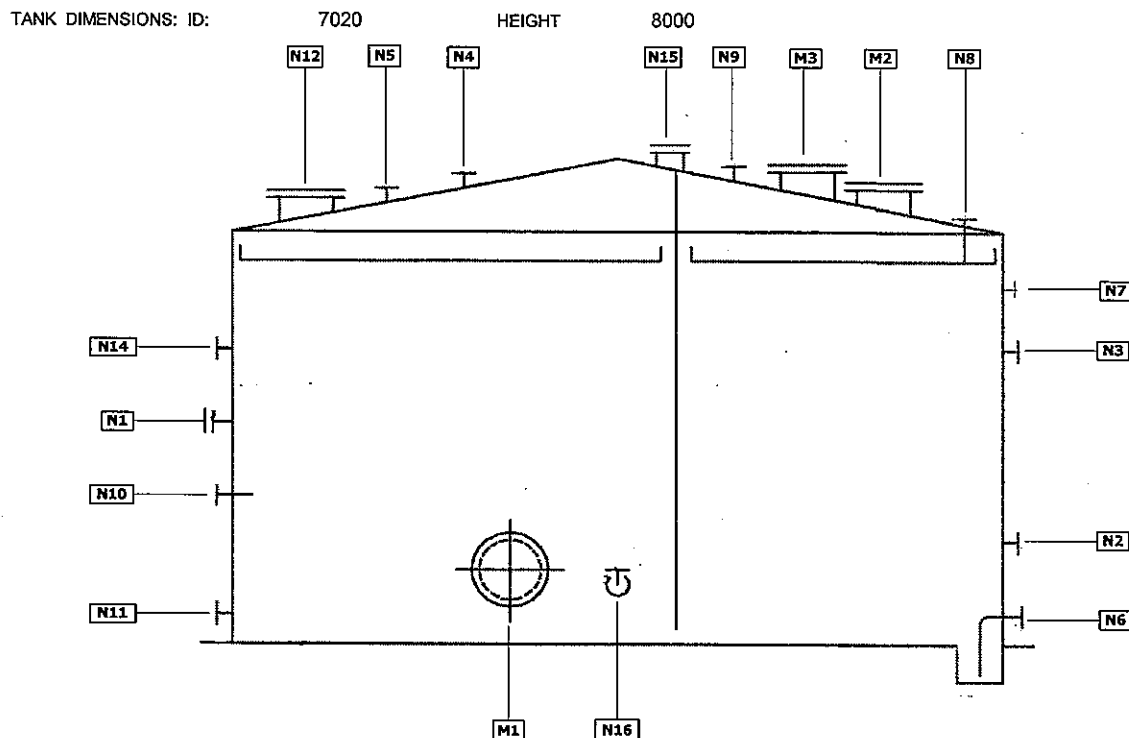

DESIGN CONDITIONS			CONSTRUCTION		
Pressure:	254	mmH2O(g)	MATERIALS		CORROSION ALLOWANCE
At:	85	°C	Shell:	A36	1.5 mm
Vacuum:	100	mmH2O(g)	Roof :	A36	NONE mm
At:		°C	Structure:	A307-B	NONE mm
Min. Design Metal Temp:	10.6(NOTE 11)	°C	Bottom:	A36	1.5 mm
At:		mmH2O(g)			
Liquid Level:	(NOTE9)	mm			
Specific Gravity of Liquid:	0.873				
At:	15.0	°C			
OPERATING CONDITIONS			NOTES & SPECIAL CONDITIONS		
Fluid:	Toluene/A9+		Roof Type:	Cone and Internal Floating Roof	
Pressure + :	12.7(NOTE6)	mmH2O(g)	Stress Relieve (Process Reason Only):	Yes	
At:	44	°C	Earthquake Design:		
Vacuum - :		mmH2O(g)	Seismic Zone:	API 650 APP. E ZONE 1	
At:		°C	Roof Tie Rods:		
Low Temperature:		°C	Essential Facilities Factor:		
At:		mmH2O(g)	Site Amplification Factor:		
Hydrogen Partial Pressure:		mmH2O(g)	Zone Coefficient:		
At:		°C			
INSULATION					
Type:	N/A				
Req'd Thickness:	N/A				
Fireproofing:					

ابن رشد
ibn rushd

STORAGE TANK DATA SHEET

Contract: 10E0541A01
Equip. No.: 55-D-07 A/B
Revision : 3 Date: 27-Oct.-2011
Unit : 55 -Xylene Fractionation
P.O. No. :
Document No. DS-55-DA-507
Sheet : 2 of 2



CTCI CORPORATION REV

NOZZLE SCHEDULE

TAG	QTY	SIZE in	PRESSURE RATING	DESCRIPTION	
M1	1	24	EXISTING	SHELL MANHOLE	
M2	1	24	EXISTING	ROOF MANHOLE	
M3	1	36	EXISTING	ROFF MANHOLE	
N1	1	2	EXISTING	SPARE NOZZLE (NOTE4)	
N2	1	6	EXISTING	SUCTION NOZZLE	
N3	1	1	EXISTING	TEMPERATURE INDICATOR	
N4	1	1	EXISTING	GAS BLANKETING NOZZLE	
N5	1	2	EXISTING	GAS BLANKETING NOZZLE	
N6	1	4	EXISTING	DRAIN NOZZLE W/SUMP	
N8	1	1 1/2	EXISTING	LEVEL INDICATOR	
N9	1	4	EXISTING	PRESSURE VACUUM VENT	
N10	1	4	EXISTING	JET MIXER	
N11	1	4	EXISTING	SPILLBACK NOZZLE	
N12	1	20	EXISTING	EMERGENCY VENT	
N14	1	4	EXISTING	FILLING NOZZLE (NOTE5)	
N15	1	8	EXISTING	GAUGE HATCH W/6" SLOT DIPPING DEVICE	
N16	1	1	EXISTING	LI & TI NOZZLE	
N7	2	2 1/2	EXISTING	FOAM CHAMBER	1

NOTES:

- Formerly Orthoxylene Tank, 55-D-07A/B.
- Dimensions are in millimeter unless otherwise noted.
- Following UOP data sheet 951610-306.
- Existing filling nozzle to be re-used as spare nozzle.
- Existing spare nozzle to be re-used as filling nozzle.
- Tank contents : true vapor pressure 0.04848 bar(a) at 38 °C , Flashing Point 4.4 °C.
- Pump In Rate = 35.4 (m3/h) & Pump Out Rate = 35.4 (m3/h).
- Deleted
- HLL : 7200 mm, HLL : 6400 mm, LLLL : 1000 mm, LLL : 1600 mm
- Deleted
- The min. design ambient temperature should be 6 degree C.
- Nominal capacity : 310 m3 Working capacity : 240 m3
- Existing design condition : 254 mmH2O(g) at 85 deg. C. New design condition : same as existing condition.



A Honeywell Company

UOP LLC • 25 East Algonquin Road • Des Plaines, Illinois 60017-5017 USA

ATMOSPHERIC STORAGE TANKS


PROJECT SPECIFICATION

951610 - 306 SHEET 2

REV	DATE	BY	APVD	REV	DATE	BY	APVD
0	10-Jul-09	PSK	MEH				

Note: The information in this document is confidential and the property of UOP LLC and must not be disclosed to others or reproduced in any manner or used for any purpose whatsoever without its written permission.

REV																																																																																																																																																																																																																																																																																																																																																																																																																																																																																																																																																																																																																																																																																																																																																																																																																																																																																																																																																																																																																																																																																																																																																																																																																																																																																																																																																																																																																												
-----	--	--	
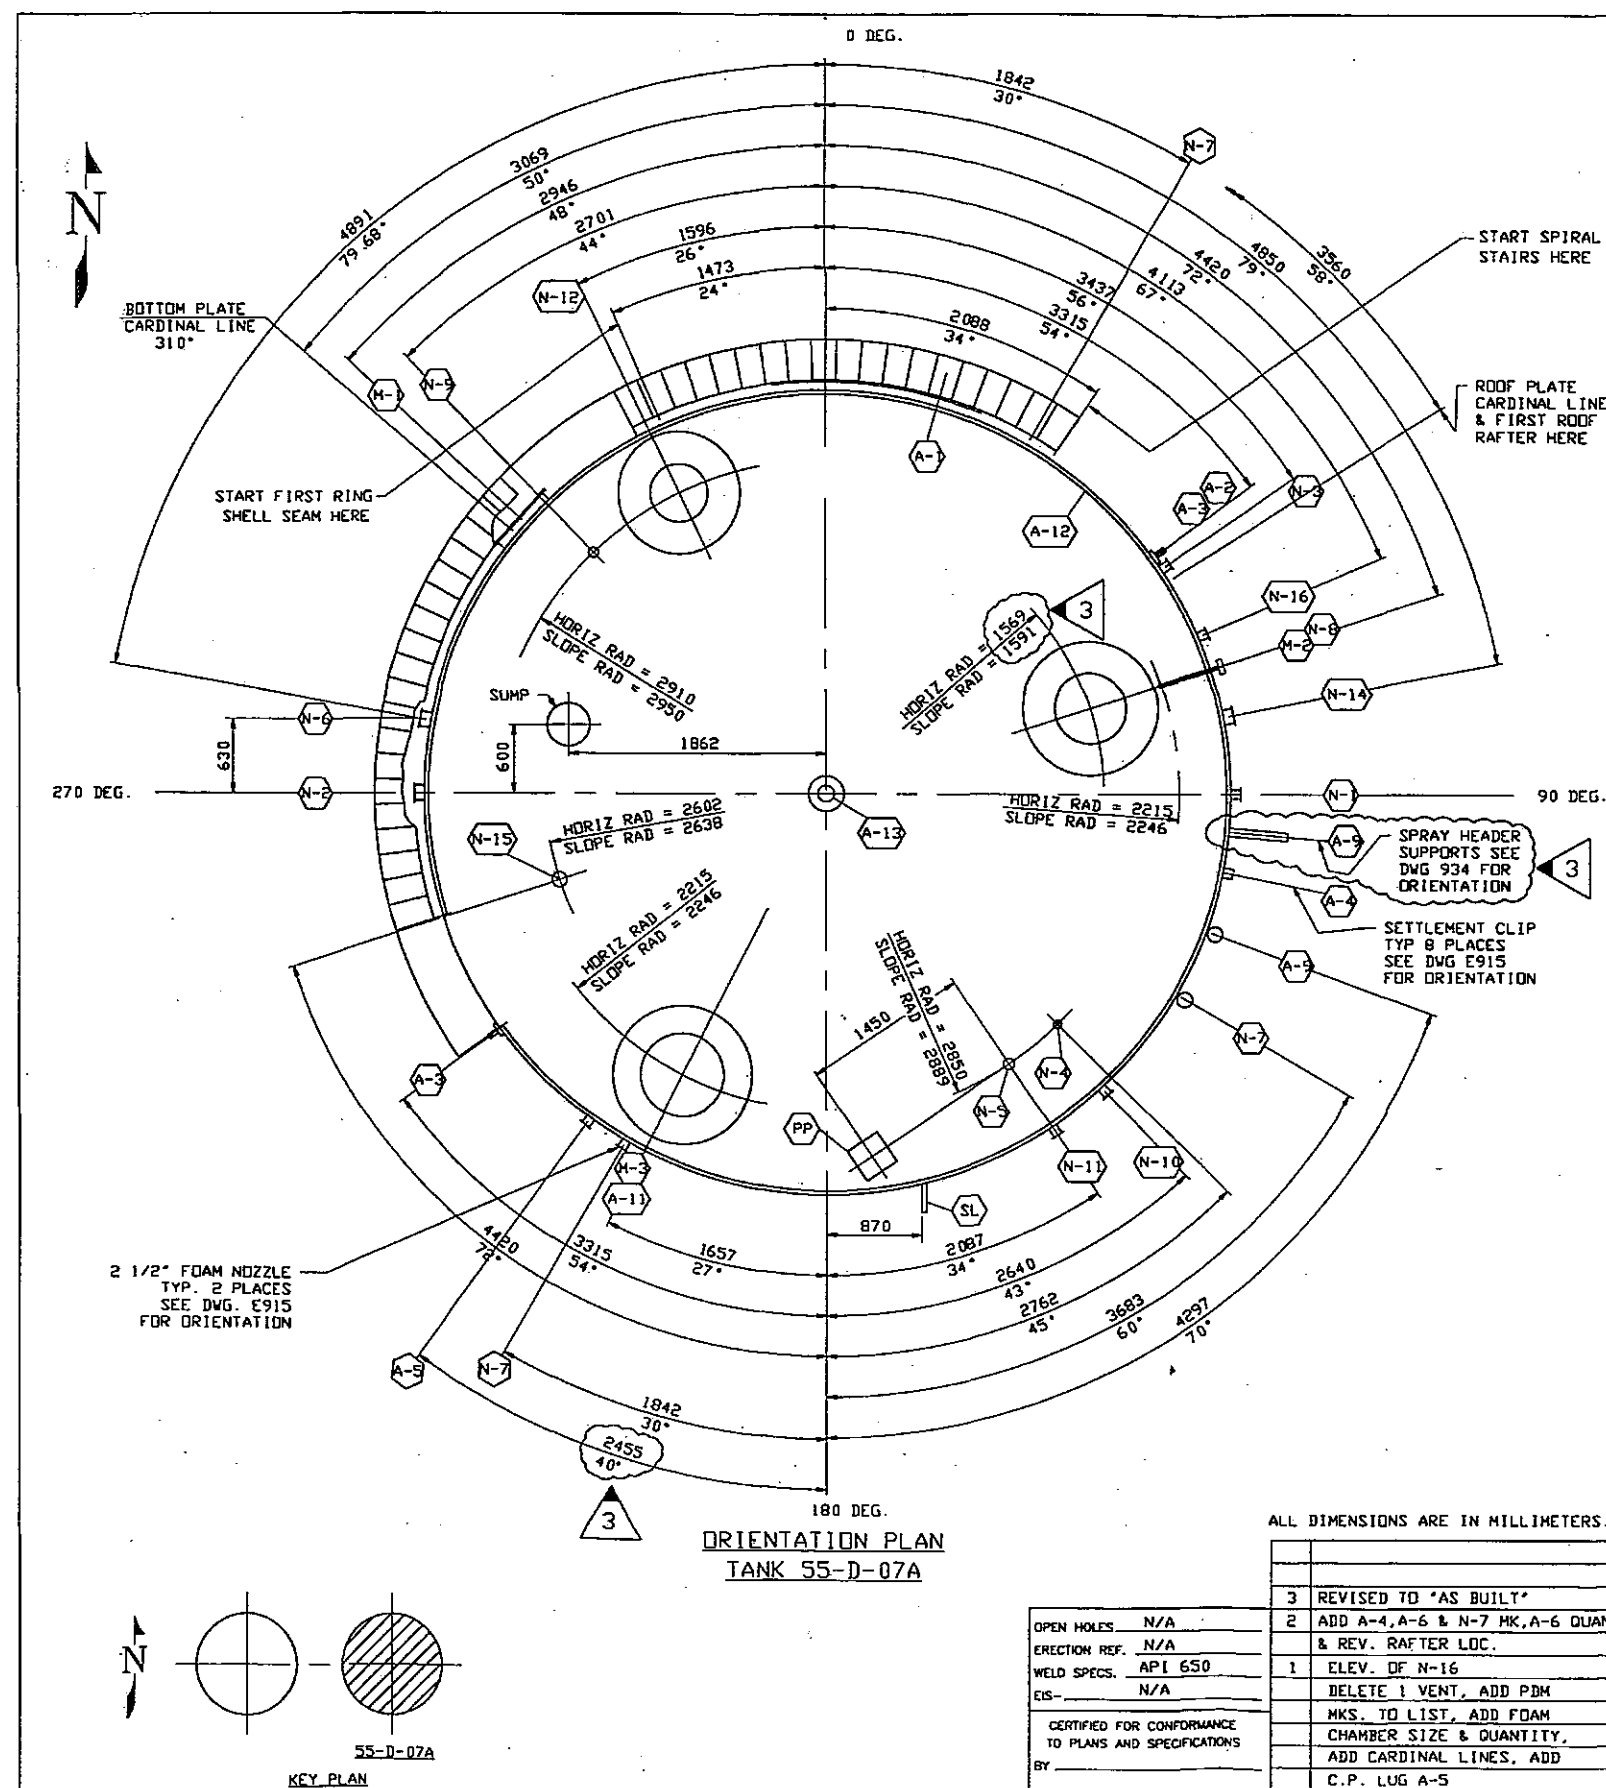

ACCESSORIES LIST					
CUST. MARK	PDM MARK	NO. REQD	DESCRIPTION	ELEVATION	PROJECTION
M-1	914-1	1	24" SHELL MANHOLE	762	127
M-2	928-1	1	24" ROOF MANHOLE	ROOF	209
M-3	926-1	1	36" ROOF MANHOLE	ROOF	208
N-1	917-2	1	2" FILLING NOZZLE	178	152
N-2	917-3	1	6" SUCTION NOZZLE	279	203
N-3	917-1	1	1" TEMPERATURE INDICATOR	600	152
N-4	912-2	1	1" GAS BLANKETING NOZZLE	ROOF	152
N-5	912-3	1	2" GAS BLANKETING NOZZLE	ROOF	152
N-6	916-2	1	4" DRAIN NOZZLE W/SUMP	229	178
N-7	933-1	2	2 1/2" FOAM CHAMBER	7840	152
N-8	917-4	1	1 1/2" LEVEL INDICATOR	ROOF	25
N-9	923-2	1	4" PRESSURE/VACUUM VENT	ROOF	152
N-10	917-5	1	4" JET MIXER	229	178
N-11	917-4	1	4" SPILLBACK NOZZLE	229	178
N-12	923-1	1	20" EMERGENCY VENT	ROOF	195
N-14	917-4	1	4" SPARE NOZZLE	229	178
N-15	913-9	1	8" GAUGE HATCH W/6" SLOT DIPPING DEVICE	ROOF	X
N-16	917-1	1	1" LI & TI NOZZLE	700	152
A-1	919-1	1	SPIRAL STAIRWAY	SHELL	----
A-2	915-1	1	NAMEPLATE	SHELL	----
A-3	918-2	2	EARTH LUG	SHELL	----
A-4	918-3	8	SETTLEMENT CLIP	SHELL	----
A-5	918-1	1	CATHODIC PROTECTION LUG	SHELL	----
A-6	920-1	10	ELECTRICAL CABLE SUPPORT	SHELL	----
A-7	DWG F901	15	ANCHOR BOLT	SHELL	----
A-8	X	1	INSTRUMENT CONDUIT SUPPORT	SHELL	----
A-9	SUB CONTR	1	WATER SPRAY SYSTEM	SHELL	----
A-11	925-1	1	INNER LADDER (ANTI-ROTATION DEVICE)	SHELL	----
A-12	935-1	1	PERIMETER HANDRAIL	ROOF	----
A-13	912-1	1	SCAFFOLD CABLE SUPPORT	ROOF	152
PP	932-2	1	PAD PLATE	ROOF	----
SL	932-1/R	1	SUPPORT LUG	SHELL	----

NOTES: ELEVATIONS GIVEN ARE FROM THE TOP OF THE BOTTOM PLATE AT THE SHELL TO CENTERLINE OF FITTING. PROJECTIONS GIVEN ARE FROM OUTSIDE FACE OF SHELL OR ROOF TO FACE OF FITTINGS.

ARC LENGTHS MEASURED ON OUTSIDE SURFACE OF SHELL. RING 1. RADIUS = 3517

DEGREES	ARC LENGTH
180	11047
90	5523
10	614
1	61

ALL DIMENSIONS ARE IN MILLIMETERS.

OPEN HOLES	N/A	3	REVISED TO "AS BUILT"	RK	20SEPT97	HJ	18OCT97
ERECTION REF.	N/A	2	ADD A-4, A-6 & N-7 MK, A-6 QUAN. & REV. RAFTER LOC.	RAS	01MAY97	AJM	01MAY97
WELD SPECS.	API 650	1	ELEV. OF N-16	ARF	01APR97	AJM	01APR97
EIS	N/A		DELETE 1 VENT, ADD PDM				
			MKS. TO LIST, ADD FOAM CHAMBER SIZE & QUANTITY, ADD CARDINAL LINES, ADD C.P. LUG A-5				
CERTIFIED FOR CONFORMANCE TO PLANS AND SPECIFICATIONS							
BY							
DATE							
NO	REVISION DESCRIPTION	BY	DATE	CHK	DATE		

CHYODA PETROSTAR LTD.

JOB NO. 54001 IBN RUSHD AROMATICS PROJECT

PO NO. 54001 T009

REQ NO. SC-50-0-003

IDENT NO. 55-D-07A-BW 0003

A-HS CONVENTS PROJECT WITH FABRICATION

B-PROJECT WITH FABRICATION COMMENTS TO BE CONSIDERED

C-DO NOT PROCEED WITH FABRICATION

SAY TEAM

DATE

PURCHASER'S PERMISSION TO PROCEED OR REVIEW TAKEN ON VENDOR PRINTS SHALL NOT RELIEVE VENDOR FROM ITS RESPONSIBILITIES OR LIABILITIES UNDER PURCHASE ORDER

IBN RUSHD PTA & AROMATICS PROJECT - AROMATICS ORTHOXYLENE TANKS 55-D-07A & B

PDM Saudi Arabia

ENGINEERS - FABRICATORS - CONTRACTORS

IBN RUSHD PTA

(2) 7.02 m DIA X 8 m FBSSCRIFR

YANBU, SAUDI ARABIA

ORIENTATION PLAN

DWG. PREPARED AT PIT FABRICATED AT YANBU

BY DATE

DRAWN: RRS 25NOV96

CHECKED: AJM 07FEB97

DRAWING E901AD

CONTRACT 76519-9

MATERIAL SPECIFICATIONS

PLATE	-	A36
BOTTOM	-	A36
ANNULAR RING	-	N/A
SHELL	-	A36
ROOF	-	A36
DECK	-	A36
MISC PLATE	-	TYPE 304 SS
SHAPES	-	A36 (OR EQUAL)
COL. PIPE	-	N/A
PIPE	-	A53-B, A106-B, API 5L-B (OR EQUAL)
FLANGES	-	A105
FITTINGS	-	A234-WPB
BOLTING	-	
PIPING	-	A307-B
STRUCTURAL	-	A307-B
GASKETS	-	NON-ASBESTOS COMPRESSED SHEET NITRILE BINDER
FLOATING ROOF SEAL	-	VITON (BY SEAL SUPPLIER)
AND SPECIAL GASKETS	-	

DESIGN SPECIFICATIONS

DESIGN SPECIFIC GRAVITY	-	0.883
DESIGN LIQUID LEVEL	-	6770 mm
DESIGN PRESSURE	-	254 mm WC
DESIGN VACUUM	-	100 mm WC (100 kg/sq.m)
DESIGN METAL TEMPERATURE	-	+10.6 DEG. C
MAXIMUM OPERATING TEMPERATURE	-	+85 DEG. C
WIND	-	ASCE 7-93 (34.7 m/s EXP. C)
SEISMIC	-	API 650 APP. E ZONE 1
CORROSION ALLOWANCE :	-	
ROOF	-	NONE
SHELL	-	1.5 mm
BOTTOM	-	1.5 mm
FRAMING	-	N/A

DECK

CONTENTS SPECIFIC GRAVITY	-	0.883
DESIGN SPECIFIC GRAVITY	-	0.70 - 1.00
DECK DISP. @ 0.70 SP. GR.	-	305 mm
DECK DISP. @ 1.00 SP. GR.	-	210 mm
RIM SPACE	-	200 mm NOMINAL
CORROSION ALLOWANCE :	-	
DECK PL	-	NONE
OUTER RIM	-	NONE
INNER RIM	-	N/A
COMPARTMENT PL	-	N/A
COVER PL	-	N/A

DRAWING LIST

CPL IDENT NO.	DRAWING	DESCRIPTION	CPL IDENT NO.	DRAWING	DESCRIPTION
55-D-07AB-DW 0002	F901AB	ANCHOR SETTING PLAN -TANK No. 55-D-07A	55-D-07AB-DW 0028	911	ROOF EMERGENCY DRAIN
55-D-07AB-DW 0046	F901B	ANCHOR SETTING PLAN -TANK No. 55-D-07B-	55-D-07AB-DW 0029	912	ROOF NOZZLES
55-D-07AB-DW 0052	F901AB	FOUNDATION ELEVATION	55-D-07AB-DW 0030	913	SIX INCH GAUGE HATCH
55-D-07AB-DW 0053	F901B	FOUNDATION ELEVATION	55-D-07AB-DW 0031	914	TWENTY FOUR INCH SHELL MANHOLE
55-D-07AB-DW 0050	G901	DRAWING LIST	55-D-07AB-DW 0032	915	API 650 NAMEPLATE
55-D-07AB-DW 0001	G902	GENERAL NOTES	55-D-07AB-DW 0033	916	SHELL NOZZLES
55-D-07AB-DW 0003	E901AD	ORIENTATION PLAN	55-D-07AB-DW 0034	917	SHELL NOZZLES
55-D-07AB-DW 0004	E901BD	DECK ORIENTATION PLAN	55-D-07AB-DW 0035	918	MISC. SHELL ATTACHMENTS
55-D-07AB-DW 0048	E901CB	ORIENTATION PLAN	55-D-07AB-DW 0036	919	SPIRAL STAIRCASE
55-D-07AB-DW 0049	E901D	DECK ORIENTATION PLAN	55-D-07AB-DW 0037	920	ELECTRICAL BRACKETS
55-D-07AB-DW 0005	E902	SHELL ELEVATION	55-D-07AB-DW 0038	921	TOP PLATFORM
55-D-07AB-DW 0006	E903	BOTTOM PLATE LAYOUT	55-D-07AB-DW 0039	922	HANDRAILS
55-D-07AB-DW 0007	E904	SPIRAL STAIRCASE	55-D-07AB-DW 0040	923	ROOF VENT / EMERGENCY VENT
55-D-07AB-DW 0008	E905	DECK PLATE LAYOUT	55-D-07AB-DW 0041	924	LADDER WELL
55-D-07AB-DW 0009	E906	PONTOON PLAN	55-D-07AB-DW 0042	925	INNER LADDER
55-D-07AB-DW 0010	E907AC	FOAM DAM	55-D-07AB-DW 0043	926	THIRTY SIX INCH ROOF MANHOLE
55-D-07AB-DW 0011	E907BC	SUPPORT LEG ELEVATION	55-D-07AB-DW 0044	927	LEVEL INDICATOR
55-D-07AB-DW 0057	E907C	FOAM DAM	55-D-07AB-DW 0045	928	TWENTY FOUR INCH ROOF MANHOLE
55-D-07AB-DW 0012	E908	INNER LADDER	55-D-07AB-DW 0051	929	DECK GROUND CABLE
55-D-07AB-DW 0013	E909	SPIRAL STAIRCASE	55-D-07AB-DW 0056	930	FLOAT WELL
55-D-07AB-DW 0014	E910	HANDRAIL	55-D-07AB-DW 0058	931	INTERMEDIATE PLATFORM
55-D-07AB-DW 0015	E911	SPIRAL STAIRCASE	55-D-07AB-DW 0059	932	PIPE SUPPORTS
55-D-07AB-DW 0016	E912	ROOF SEAL	55-D-07AB-DW 0061	933	FOAM NOZZLE DETAILS
55-D-07AB-DW 0017	E913	PIPE CONNECTIONS	55-D-07AB-DW 0062	934	WATER SPRAY SYSTEM SUPPORTS
55-D-07AB-DW 0047	E914	TWENTY FOUR INCH SHELL MANHOLE	55-D-07AB-DW 0063	935	ROOF HANDRAIL
55-D-07AB-DW 0060	E915	FOAM NOZZLE & SETTLEMENT CLIP ORIENTATION			
55-D-07AB-DW 0054	W0901AB	WELD QUALITY CONTROL - API 650			
55-D-07AB-DW 0055	W0901B	WELD QUALITY CONTROL - API 650			
55-D-07AB-DW 0018	901	BOTTOM DETAILS			
55-D-07AB-DW 0019	902	SHELL PLATE, RIM GIRDER & ANCHOR CHAIRS			
55-D-07AB-DW 0020	903	ROOF DETAILS			
55-D-07AB-DW 0021	904	DECK PLATES			
55-D-07AB-DW 0022	905	DECK RIM PLATES			
55-D-07AB-DW 0023	906	DECK			
55-D-07AB-DW 0024	907	DECK SUPPORT LEGS			
55-D-07AB-DW 0025	908	DECK BLEEDER VENT			
55-D-07AB-DW 0026	909	DECK MANHOLE			
55-D-07AB-DW 0027	910	TWENTY INCH INSPECTION HATCH			



OPEN HOLES	N/A						
ERECTION REF.	N/A						
WELD SPECS.	API 650						
EIS	N/A						
CERTIFIED FOR CONFORMANCE TO PLANS AND SPECIFICATIONS							
BY	2	ISSUED "AS BUILT"	RK	20SEPT97	MJ	20DCT97	
DATE	1	REVISE DRAWING LIST	ARF	31MAR97	AJM	31MAR97	
	NO	REVISION DESCRIPTION	BY	DATE	CHK	DATE	



JOB NO. 54001 IBN RUSHD AROMATICS PROJECT PD NO. 54001 T009 RED NO. SC-90-0-003 IDENT NO. 55-D-07AB-DW 0050	
A-NO COMMENTS PRECEDER WITH FABRICATION	SAY TEAM
B-PRECEDED WITH FABRICATION COMMENTS TO BE CONTINUED	
C-DO NOT PRECEED WITH FABRICATION	DATE
PURCHASER'S PERMISSION TO PROCEED OR REVIEW TAKEN ON VENDOR PRINTS SHALL NOT RELIEVE VENDOR FROM ITS RESPONSIBILITIES OR LIABILITIES UNDER PURCHASE ORDER	
IBN RUSHD PTA & AROMATICS PROJECT - AROMATICS ORTHOXYLENE TANKS 55-D-07A & B PDM Saudi Arabia ENGINEERS - FABRICATORS - CONTRACTORS IBN RUSHD PTA (2) 7.02 m DIA X 8 m FBSSCRIFR YANBU, SAUDI ARABIA DRAWING LIST DWG. PREPARED AT PIT FABRICATED AT YANBU BY DATE DRAWN: AMW 12FEB97 DRAWING G901 CHECKED: RHL 13FEB97 CONTRACT 76519-9	

THE STORAGE TANK, MATERIALS, DESIGN, FABRICATION AND ERECTION ARE IN COMPLIANCE WITH THE CUSTOMER'S SPECIFICATIONS AND API 650 9TH EDITION, INCLUDING APPENDIX A, E, F AND H.

A. FOUNDATION

A. FOUNDATION

1. DESIGNED BY : OTHERS
2. CONSTRUCTED BY : OTHERS

B. STORAGE TANK

1. DESIGNED BY : PITT-DES MOINES, INC.
2. FABRICATED AND ERECTED BY : PDM SAUDI ARABIA

C. COATINGS

1. PAINTING SHALL BE PER PAINTING INSTRUCTIONS (P-1).
2. GALVANIZE PER ASTM A123 REQUIREMENTS.

2. FOUNDATIONS

- A. WHERE RINGWALLS ARE PROVIDED UNDER THE TANK SHELL, THE TOP OF THE RINGWALL SHALL BE SMOOTH AND LEVEL WITHIN ± 3 mm OF ANY 9144 mm OF CIRCUMFERENTIAL LENGTH. NO POINT ON THE CIRCUMFERENCE OF THE RINGWALL SHALL VARY MORE THAN ± 6 mm FROM THE ESTABLISHED ELEVATION.
- B. RECESSES IN THE FOUNDATION SHALL BE PROVIDED FOR FLUSH TYPE CLEANOUTS, DRAW-OFF SUMPS, ETC.
- C. WHERE RINGWALLS ARE NOT PROVIDED, THE FOUNDATION UNDER THE TANK SHELL SHALL BE LEVEL WITHIN ± 3 mm IN ANY 9144 mm OF CIRCUMFERENTIAL LENGTH. NO POINT IN THE CIRCUMFERENCE SHALL VARY MORE THAN ± 13 mm FROM THE ESTABLISHED ELEVATION.
- D. THE ENTIRE FOUNDATION UNDER THE TANK SHALL BE WITHIN ± 13 mm OF TRUE ELEVATION.

3. STORAGE TANK

A. SHELL

1. SHELL PLATES SHALL HAVE A COMMON INSIDE DIAMETER.
2. ALL VERTICAL AND HORIZONTAL SHELL PLATE JOINTS SHALL BE DOUBLE-WELDED COMPLETE PENETRATION (CP) BUTT JOINTS.

B. WELDING

1. ALL TANK WELDS SHALL BE PER A QUALIFIED PROCEDURE AS SPECIFIED ON THE DRAWINGS.
2. ALL TEMPORARY ATTACHMENTS TO THE TANK SHELL SHALL BE WELDED USING WELD PROCEDURE SM-52.
3. ALL SHELL OPENING CONNECTIONS WHICH REQUIRE REINFORCING, SUCH AS NOZZLES, MANHOLES, ETC., SHALL BE ATTACHED BY WELDS FULLY PENETRATING THE SHELL UNLESS OTHERWISE SPECIFIED.

C. STRESS RELIEVING

1. STRESS RELIEVE IS NOT REQUIRED.

D. WELD INSPECTION

1. SHELL PLATE TO SHELL PLATE WELDS SHALL BE INSPECTED BY THE RADIOGRAPHIC METHOD AS SPECIFIED IN SECTION 6.1 AND PARAGRAPH A.5.3 OF API 650.
2. ALL WELDS (INCLUDING PERMANENT AND TEMPORARY ATTACHMENTS) SHALL BE INSPECTED BY VISUAL EXAMINATION.
3. ALL WELDS ATTACHING SHELL NOZZLES OR MANHOLES SHALL BE EXAMINED BY EITHER THE MAGNETIC PARTICLE METHOD OR THE DYE-PENETRANT METHOD. IF ANY PWHT IS PERFORMED, THE EXAMINATION SHALL BE PERFORMED BEFORE AND AFTER PWHT.
4. FLUSH CLEANDOUTS AND NOZZLES ARE NOT REQUIRED.

E. TESTING

1. THE TANK BOTTOM SHALL BE EXAMINED BY THE VACUUM BOX TEST METHOD.
2. THE TANK SHELL TO BOTTOM WELD SHALL BE TESTED BY THE PENETRATING OIL METHOD AND THE COMPLETED JOINT SHALL BE VISUALLY INSPECTED. THE INSIDE FILLET WELD SHALL BE COMPLETED FIRST AND INSPECTED FOR LEAK TIGHTNESS WITH PENETRATING OIL BEFORE THE OUTSIDE WELD IS STARTED. ALLOW 1 HOUR OF WAITING TIME FOR EACH 3 mm OF SHELL THICKNESS AFTER THE PENETRATING OIL IS APPLIED. THE MINIMUM WAITING TIME SHALL BE 4 HOURS.
3. REINFORCING PLATES SHALL BE TESTED PRIOR TO THE HYDROSTATIC TEST. APPLY $1.05 \pm .07$ kg/sq cm AIR PRESSURE USING THE TELLTALE HOLE WHILE UNDER PRESSURE, A SOAP SUDS SOLUTION SHALL BE APPLIED TO ALL ATTACHMENT WELDS FOR DETECTION OF LEAKS.
4. PDM SAUDI ARABIA SHALL HYDRO-PNEUMATICALLY TEST THE TANK PER API 650 AND PDM-SA PROCEDURE HT-4. PDM-SA SHALL SUPPLY POTABLE WATER FOR HYDROTEST. A LAB ANALYSIS WILL BE PERFORMED TO DETERMINE THE WATER QUALITY. PDM-SA WILL TREAT THE WATER IF NECESSARY BY ADDITION OF A CHEMICAL ADDITIVE. PDM-SA DOES NOT INCLUDE FOR SUPPLY OF SACRIFICIAL ANODES OR ANY OTHER CATHODIC PROTECTION SYSTEM. PDM-SA ASSUMES TEST WATER MAY BE DISPOSED OF IN THE VICINITY OF THE TANKS WITHOUT COST TO PDM-SA. PDM-SA INCLUDES ALL EQUIPMENT AND LABOR TO FILL THE TANKS, WATER TRANSFER, MONITORING THE HYDROTEST. SURVEY OF FOUNDATION SETTLEMENT IS REQUIRED DURING HYDROTEST. CPL WILL MONITOR THE FOUNDATION SETTLEMENT
5. PENETRATING OIL TEST SHALL BE PERFORMED ON BOTTOM DECK, PENETRATIONS AND OUTER RIM TO DECK JOINT PRIOR TO HYDROTEST.
6. THE FLOATING ROOF SHALL BE FLOTATION TESTED ON WATER DURING THE HYDROSTATIC TEST. DURING THE TEST THE UPPER SIDE OF THE DECK IN CONTACT WITH LIQUID SHALL BE EXAMINED FOR LEAKS. IN ADDITION ALL WELDS ON THE UPPER SIDE OF THE FLOATING ROOF SHALL BE INSPECTED BY VISUAL EXAMINATION.

F. FLANGE ORIENTATION

1. THE FLANGE BOLT HOLES FOR SHELL MANHOLES AND NOZZLES SHALL STRADDLE A VERTICAL CENTERLINE UNLESS OTHERWISE NOTED.
2. THE FLANGE BOLT HOLES FOR ROOF MANHOLES AND NOZZLES SHALL STRADDLE A ROOF TANK CENTERLINE UNLESS OTHERWISE NOTED.

G. MILL TEST REPORTS

1. MILL TEST REPORTS SHALL BE PROVIDED FOR SHELL, ROOF AND BOTTOM PLATES, REPADS AND NOZZLES/MANHOLES FABRICATED FROM PLATE.
2. CERTIFICATE OF COMPLIANCE SHALL BE PROVIDED FOR FLANGES, BOLTS, NUTS AND STRUCTURAL COMPONENTS.

H. AS BUILT DRAWINGS

- SHOP AND FIELD TO FURNISH MARKED-UP DRAWINGS OR A WRITTEN DESCRIPTION TO PDM SAUDI ARABIA REGARDING ANY CHANGES TO THE PROJECT FOR AS BUILT DRAWINGS.


- I. SPECIAL HANDLING REQUIREMENTS ARE NOT REQUIRED.

- J. TANK CALIBRATION IS REQUIRED.

- STRAPPING AND CALIBRATION, INCLUDING GAUGING TABLES.

- K. GRIND ALL SHARP EDGES/CORNERS SMOOTH REMOVE ALL BURRS.

OPEN HOLES	N/A							
ERECTION REF.	N/A							
WELD SPECS.	API 650							
EIS-	N/A							
CERTIFIED FOR CONFORMANCE TO PLANS AND SPECIFICATIONS								
BY		2	ISSUED "AS BUILT"	RK	20SEPT97	MJ	19OCT97	
		1	REVISE NOTE 3.E.4	ARF	31MAR97	AJM	31MAR97	
DATE		NO	REVISION DESCRIPTION	BY	DATE	CHK	DATE	

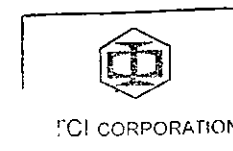

 CHITRO PETROSTAR LTD.			
JOB NO. 54001 IBN RUSHD AROMATICS PROJECT			
PO NO. 54001 7009			
REQ NO. SC-50-Q-003			
IDENT NO. 55-D-07A-BW 0001			
A-NO EXHIBITS PROCEED WITH FABRICATION		SAY TEAM	
B-PROCEED WITH FABRICATION EXHIBITS TO BE CONSIDERED			
C-DO NOT PROCEED WITH FABRICATION			
		DATE	
PURCHASER'S PERMISSION TO PROCEED OR REVIEW TAKEN ON VENDOR PRINTS SHALL NOT RELIEVE VENDOR FROM ITS RESPONSIBILITIES OR LIABILITIES UNDER PURCHASE ORDER			
IBN RUSHD PTA & AROMATICS PROJECT - AROMATICS ORTHOXYLENE TANKS 55-D-07A & B			
PDM Saudi Arabia ENGINEERS - FABRICATORS - CONTRACTORS			
IBN RUSHD PTA			
(2) 7.02 m DIA X 8 m FBSSCRIFR			
YANBU, SAUDI ARABIA			
GENERAL NOTES			
DWG. PREPARED AT		PIT	FABRICATED AT
BY		DATE	
DRAWN: AMW		13FE897	DRAWING G902
CHECKED: RHL		13FE897	CONTRACT 76519-9



ARABIAN INDUSTRIAL FIBERS COMPANY

IR-II AROMATICS PROJECT

PROJECT NO.10E0541A01

DOCUMENT TITLE:

WATER STRIPPER REBOILER DATA SHEET

DOCUMENT NO:

DS-56-EA-517

						ابن رشد ibn rushd	ARABIAN INDUSTRIAL FIBERS COMPANY YANBU, KINGDOM OF SAUDI ARABIA	CTCI CORPORATION
						CERTIFIED		
						PROJ.		
1	Issued for Design	WCC	SYL	YSL	15-Apr-2011	MGR	DATE	
0	Issue For Approval	WCC	SYL	YSL	25-Feb-11	CLIENT	DATE	
REV	DESCRIPTION	BY	CHK.	APPR.	DATE	PAGE 1 OF 2		XC33-56-517

CONTENTS

<u>ITEM</u>	<u>EQUIPMENT NO.</u>	<u>SHEET NO.</u>	<u>REV. NO.</u>	<u>REV. DATE</u>
1.	56-E-17	1 THRU 8 OF 8	1	15-Apr.-2011

1	Client: Arabian Industrial Fibers Company (Ibn Rushd)			Vendor:		
2	Service: Water Stripper Reboiler		Plant: Sulfolane		Site: Yanbu, Saudi Arabia	
3	Design Duty: 5,340,000 x 1.2 W		TEMA Type/Size: BKU / 1250/1750 x 4300		Orientation: Horizontal	
4	Transfer Rate Service: 638.58 W/m ² ·°C		Clean: 1150.23 W/m ² ·°C		Mtd (eff): 21.9 °C	
5	Total Surface (Eff.): 457.5 m ²		Shell/Unit: 1		Surface/Shell (Gross): 467.9 m ²	
6	Case:		Governing Case:			
7	PERFORMANCE OF ONE UNIT					
8			SHELL SIDE		TUBE SIDE:	
9	Fluid:		Water Stripper Bottoms		Lean Sulfolane	
10	Total Flow: kg/hr		9,377 x 1.2		359,891 x 1.2	
11			INLET OUTLET		INLET OUTLET	
12	Liquid Flow: kg/hr		9,377 x 1.2 743 x 1.2		359,891 x 1.2 359,891 x 1.2	
13	Molecular Weight:		18.14 18.14		114.8 114.8	
14	Density: kg/m ³		915 1,109		1,125 1,152	
15	Thermal Cond.: W/(m·°C)		0.482 0.195		0.174 0.179	
16	Specific Heat: kJ/(kg·°C)		4.04 2.09		1.88 1.81	
17	Viscosity: mPa·s		0.246 0.613		1.043 1.339	
18	Surface Tension: mN/m					
19						
20	Vapor Flow: kg/hr		8,634 x 1.2			
21	Molecular Weight:		18.2			
22	Density: kg/m ³		0.8874 0.8730			
23	Thermal Cond.: W/(m·°C)		0.0258 0.0265			
24	Specific Heat: kJ/(kg·°C)		1.92 1.91			
25	Viscosity: mPa·s		0.013 0.013			
26	Latent Heat: kJ/kg @ °C					
27						
28	Steam Flow: kg/hr					
29	Water Flow: kg/hr					
30	Noncondensable Flow: kg/hr					
31	Temperature: °C		113.2 134.81		173.9 144.9	
32	Pressure: bar (g)		0.6205		18.04	
33	Pressure Drop: bar		Allow: 0.0828 Calc: 0.014		Allow: 0.689 Calc: 0.604	
34	Velocity: m/s				1.46	
35	Fouling Resistance: m ² ·°C/W		0.00035		0.00026	
36						
37	Dew Point: °C					
38	Bubble Point: °C					
39	Boiling Range: °C					
40	Critical Pressure: bar (a)		218			
41	Critical Temperature: °C		377			
42	Remarks:					
43	1 Design for 120% heat duty and flow rates.					
44	2 Water Stripper Column, 56-C-07, will be installed on top of the 30" connection nozzle. Vendor shall design this nozzle to take the load .					
45	Wall thickness of shell course in that section may need to increase because nozzle reinforcement probably not sufficient. The operating					
46	weight for 56-C-07 is approximately 3,000 kg.					
47	3 The maximum bundle size is 1200 mm and the maximum bundle weight is 15,000 kg. A waiver will be required due to the 1250 mm bundle size.					
48						
49						
50						
51						
52						
53						
54						
55						
56						
57						
58						

	SHELL AND TUBE HEAT EXCHANGER DATA SHEET	Contract: 10E0541A01 Equipment No. 56-E-17 Revision: 1 Date: 15-Apr.-2011 Unit: 56 - Sulfolane P.O. No.: Document No.: DS-56-EA-517 Sheet 2 of 8	 
Case:		Governing Case:	
DESIGN CONDITIONS			
		SHELL SIDE:	TUBE SIDE:
Design Pressure:	min / max bar (g)	FV at 122 C / 4.0	FV at 174 C / 27.0
Test Pressure:	bar (g)	Code	Code
Design Temperature:	min / max °C	/ 150	/ 205
Corrosion Allowance:	mm	3	3
Number of Passes:		1	4
Minimum Design Metal Temperature:	°C	6	6
Flow Arrangement:	Parallel / Series	1 / 1	1 / 1
CONSTRUCTION			
Shell Dia, I.D.:	1750 / 1250 mm	Baffle Type:	Full Support
No. Tubes/Shell:	830 U's	Crosspasses:	Cut: % Dia.
O.D. x Length:	19.05 x 4,300 mm	Spacing Center:	599 mm
Tube Thickness:	2.11 MW (Note 4) mm	(In/Out)	/ mm
Tube Pitch:	25.4 mm Layout: 90 °	Peripheral Seals:	Yes ☐ No ☒
Tube/TS Joint	Expanded and Rolled	Number of Pairs:	
Impingement Protection:	None	Pass Lane Seals:	Yes ☐ No ☒
Expansion Joint:	None	Number:	
Removable Tube Bundle:	Yes	Diameter:	mm
Stacking:	No	Insulation: Shell: 40 Chan.: 50 mm	
Specification:		Prep & Paint - Shell: SES-PCS-10 (Note 5) Chan.: SES-PCS-10 (Note 5)	
Special Services:	Wet Sour: ☐ Side: Hydrogen: ☐ Side: Other: ☐ - Side:		
MATERIALS			
Tubes:	SA-179, Killed	Shell:	SA-516-70
Tubesheet:	SA-266-2 or 4	Shell Cover:	SA-516-70
Baffles/Tube Supports:	SA-36	Shell Flange:	SA-266-2 or 4
Tie Rods and Spacers:	CS	Channel/Bonnet:	SA-516-70
Long Baffle:	N/A	Channel Cover:	N/A
Gasket Shell Side:	DBL JKT Graphite Filled	Channel Flange:	SA-266-2 or 4
Gasket Tube Side:	DBL JKT Graphite Filled	Floating Head Cover:	N/A
Gasket Float. Head Cover:	N/A	Shell Bolting:	SA-193-B7/SA-194-2H
Expansion Joint:	N/A	Channel Bolting:	SA-193-B7/SA-194-2H
Exchanger Supports:	SA-516-70 Pad/SA-36 Saddle	Floating Head Bolting:	N/A
NOZZLES		TUBE SIDE:	
Description	No.	Size	Rating
Inlet		(Note 7)	
Vapor Outlet	1	10"	150#
Liquid Outlet	1	3"	150#
Column Connection	1	30"	150#
Drain	1	2"	150#
Level Control	2	2"	300#
Pump Return	1	1-1/2"	150#
Steam Out	1	2"	150#
Pressure Gauge*	1	3/4"	6000# CPLG
Level Alarm	2	1-1/2"	150#
* Each process nozzle.		* Each process nozzle.	
Remarks (cont'd):			
4. 2.11 mm (14 gage) minimum wall thickness.			
5. Uninsulated protrusions shall be painted per SES-PCS-4.			
6. Some of the applicable project specifications for shell and tube heat exchangers are: Z01-G07 (SABIC), 3-11-6 (UOP), 4-11-6 (UOP), 22854-SP-000-D-001 (Bechtel), 22854-SP-000-E-001 (Bechtel), 22854-SP-000-W-001 (Bechtel), 22854-SP-W-002 (Bechtel), 22854-SP-W-003 (Bechtel), T01-S01 (SABIC), SP000X5001 (SABIC), 22854-SP-000-N-001 (Bechtel).			
7. Liquid enters the reboiler through the water stripper column connection.			

SHELL AND TUBE
HEAT EXCHANGER
DATA SHEET

Contract: 10E0541A01
Equipment No. 56-E-17
Revision: 1 Date: 15-Apr.-2011
Unit: 56 - Sulfolane
P.O. No.:
Document No.: DS-56-EA-517
Sheet 4 of 8

COLD SIDE PROPERTIES


Properties at .7022 bar[g]			VAPOR				TOTAL LIQUID						
Temp.	Mass Vapor	Enthalpy Normalized	Density	Visc.	Thermal Cond.	Specific Heat	Density	Visc.	Thermal Cond.	Specific Heat	Surface Tension	Critical Press.	Critical Temp.
°C	Frac.	kJ/kg	kg/m³	mPas	W/(m.°C)	kJ/(kg.°C)	kg/m³	mPas	W/(m.°C)	kJ/(kg.°C)	mN/m	bar [a]	°C
87.7	0.0000						942.1	0.325	.484	4.00	60.4	218	377
101.9	0.0000	56.95					927.2	0.277	.483	4.02	57.7	218	377
116.0	0.0000	113.9	.9659	0.013	.0260	1.92	912.0	0.239	.481	4.04	54.9	218	377
116.0	0.1378	419.7	.9659	0.013	.0260	1.92	913.8	0.240	.463	4.01	54.9	218	377
116.1	0.2756	725.6	.9659	0.013	.0260	1.92	916.5	0.242	.441	3.97	54.8	217	378
116.2	0.4135	1,031	.9659	0.013	.0260	1.92	920.5	0.244	.414	3.91	54.7	217	379
116.5	0.5514	1,337	.9659	0.013	.0261	1.92	927.1	0.248	.380	3.81	54.6	215	380
116.9	0.6895	1,643	.9659	0.013	.0261	1.92	940.5	0.256	.334	3.62	54.2	212	384
118.0	0.8278	1,949	.9643	0.013	.0262	1.92	980.4	0.286	.265	3.15	53.2	203	395
152.8	0.9755	2,255	.9243	0.014	.0289	1.90	1,128	0.885	.180	1.91	38.7	86.6	536

Properties at .5792 bar[g]			VAPOR				TOTAL LIQUID						
Temp.	Mass Vapor	Enthalpy Normalized	Density	Visc.	Thermal Cond.	Specific Heat	Density	Visc.	Thermal Cond.	Specific Heat	Surface Tension	Critical Press.	Critical Temp.
°C	Frac.	kJ/kg	kg/m³	mPas	W/(m.°C)	kJ/(kg.°C)	kg/m³	mPas	W/(m.°C)	kJ/(kg.°C)	mN/m	bar [a]	°C
87.7	0.0000						942.1	0.325	.484	4.00	60.4	218	377
100.7	0.0000	52.32					928.4	0.281	.483	4.02	57.9	218	377
113.7	0.0000	104.6	.9018	0.013	.0258	1.92	914.4	0.215	.482	4.04	55.4	218	377
113.7	0.1381	411.8	.9018	0.013	.0259	1.92	916.3	0.246	.464	4.01	55.3	218	377
113.8	0.2761	719.0	.9018	0.013	.0259	1.92	919.0	0.247	.442	3.97	55.3	217	378
114.0	0.4142	1,026	.9018	0.013	.0259	1.92	923.0	0.250	.415	3.90	55.2	217	379
114.2	0.5524	1,333	.9018	0.013	.0259	1.92	929.7	0.253	.380	3.80	55.0	215	380
114.6	0.6907	1,640	.9018	0.013	.0259	1.92	943.2	0.262	.334	3.61	54.7	212	384
115.7	0.8292	1,948	.9002	0.013	.0260	1.92	983.8	0.294	.265	3.13	53.6	203	396
151.8	0.9781	2,255	.8618	0.014	.0288	1.90	1,130	0.915	.180	1.90	38.6	84.6	538

Properties at .4602 bar[g]			VAPOR				TOTAL LIQUID						
Temp.	Mass Vapor	Enthalpy Normalized	Density	Visc.	Thermal Cond.	Specific Heat	Density	Visc.	Thermal Cond.	Specific Heat	Surface Tension	Critical Press.	Critical Temp.
°C	Frac.	kJ/kg	kg/m³	mPas	W/(m.°C)	kJ/(kg.°C)	kg/m³	mPas	W/(m.°C)	kJ/(kg.°C)	mN/m	bar [a]	°C
87.7	0.0000						942.1	0.325	.484	4.00	60.4	218	377
99.5	0.0000	47.57					929.7	0.284	.483	4.02	58.1	218	377
111.3	0.0000	95.14	.8394	0.013	.0256	1.92	917.0	0.251	.482	4.04	55.8	218	377
111.4	0.1383	403.7	.8394	0.013	.0257	1.92	918.9	0.252	.464	4.01	55.8	218	377
111.5	0.2766	712.2	.8394	0.013	.0257	1.92	921.6	0.253	.442	3.96	55.7	217	378
111.6	0.4150	1,021	.8394	0.013	.0257	1.92	925.6	0.256	.415	3.90	55.6	217	379
111.8	0.5534	1,329	.8394	0.013	.0257	1.92	932.3	0.260	.380	3.80	55.5	215	380
112.2	0.6919	1,638	.8378	0.013	.0257	1.92	946.0	0.268	.334	3.61	55.1	212	384
113.4	0.8306	1,946	.8378	0.013	.0258	1.92	987.4	0.302	.264	3.12	54.0	202	396
150.7	0.9809	2,255	.8009	0.014	.0287	1.89	1,133	0.946	.180	1.89	38.6	82.7	541

WATER STRIPPER COLUMN REBOILER TYPICAL ARRANGEMENT

Item No.: 56-E-17

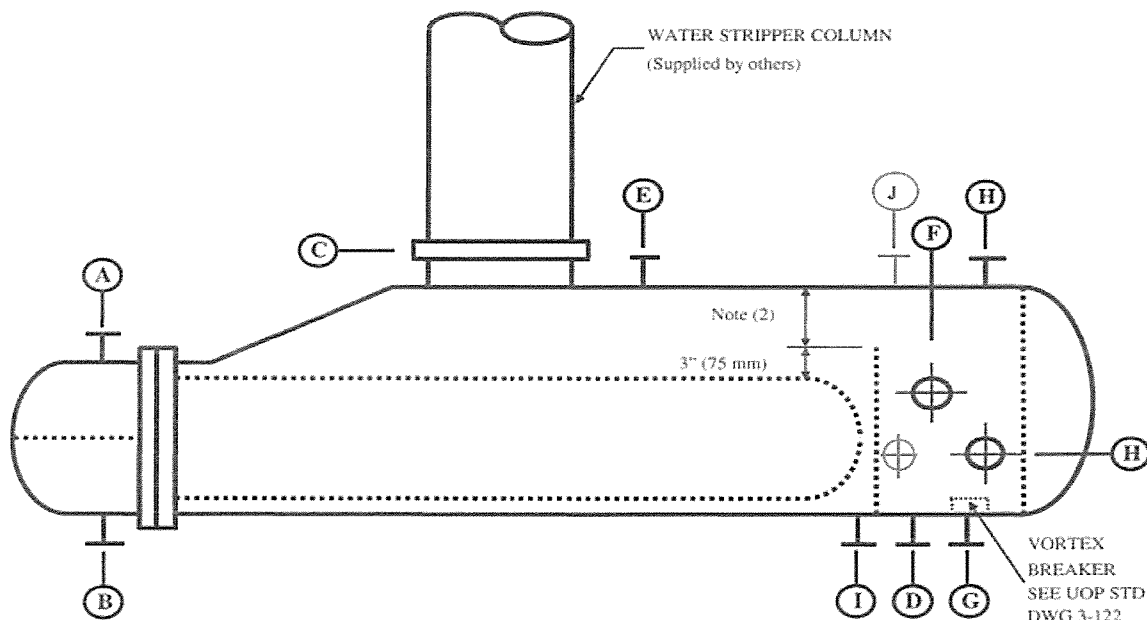

NOTES

(1) Nozzle Requirements

Nozzle	Service	Quantity	Size (NPS)	Rating	Facing
A	Tube Side Inlet	1	12	CL 300	RF
B	Tube Side Outlet	1	12	CL 300	RF
C	Water Stripper Column Welding Neck Flange	1	30	CL 150	RF
D	Steamout	1	2	CL 150	RF
E	Shell Side Vapor Outlet	1	10	CL 150	RF
F	Pump Return	1	1½	CL 150	RF
G	Shell Side Liquid Outlet	1	3	CL 150	RF
H	Level Control - Gauge Glass	2	2	CL 300	RF
I	Drain	1	2	CL 150	RF
J	Level Alarm	2	1-1/2	CL 150	RF

(2) Manufacturer's recommendation, but not less than 1'-6" (460 mm). Shell size shall be sufficient to assure the horizontal vapor velocity (in fpm OR m/s) in the vapor space above the maximum liquid level not to exceed 20 OR 0.1016 times the square root of the ratio of liquid density over vapor density.

(3) The reboiler shell must be capable of supporting the Water Stripper Column mounted on the top of the unit as shown above. Contractor shall advise the weight of this column and the moment due to wind load. Column details shall be as required by the 301 specification of this project.

PROPERTIES OF SULFOLANE
PROPERTIES OF PURE SULFOLANE LIQUID

CHEMICAL NAME: Tetramethylene Sulfone

MOLECULAR WEIGHT: 120

FREEZING POINT: 82°F (27.8°C)

LATENT HEAT AT 350°F (177°C): 207 BTU/lb (115.0 kcal/kg)

ATMOSPHERIC BOILING POINT: 545°F (285°C)

SPECIFIC GRAVITY:

100°F (38°C)	1.256
200°F (93°C)	1.208
350°F (177°C)	1.137
450°F (232°C)	1.091

SPECIFIC HEAT, BTU/lb·°F (or kcal/kg·°C):

100°F (38°C)	0.36
200°F (93°C)	0.40
350°F (177°C)	0.44
450°F (232°C)	0.47

VISCOSITY, CENTIPOISE:

100°F (38°C)	8.20
200°F (93°C)	2.75
350°F (177°C)	1.14
450°F (232°C)	0.87

THERMAL CONDUCTIVITY, BTU/hr·ft·°F (kcal/hr·m·°C)


100°F (38°C)	0.091 (0.135)
200°F (93°C)	0.088 (0.131)
350°F (177°C)	0.082 (0.122)
450°F (232°C)	0.079 (0.118)

NOTE: TO AVOID POSSIBLE DECOMPOSITION OF SULFOLANE, ITS FILM TEMPERATURE IN ANY HEAT EXCHANGE SERVICE SHALL BE LIMITED TO 450°F (232°C) MAXIMUM.

Suppliers shall make such calculations as are necessary to ensure that above maximum temperature requirement is met. Such calculations shall be based on the specified heating medium temperature and "clean" tube conditions.

PROPERTIES OF SULFOLANE (CONTINUED)


FREEZING POINT OF SULFOLANE - WATER MIXTURES

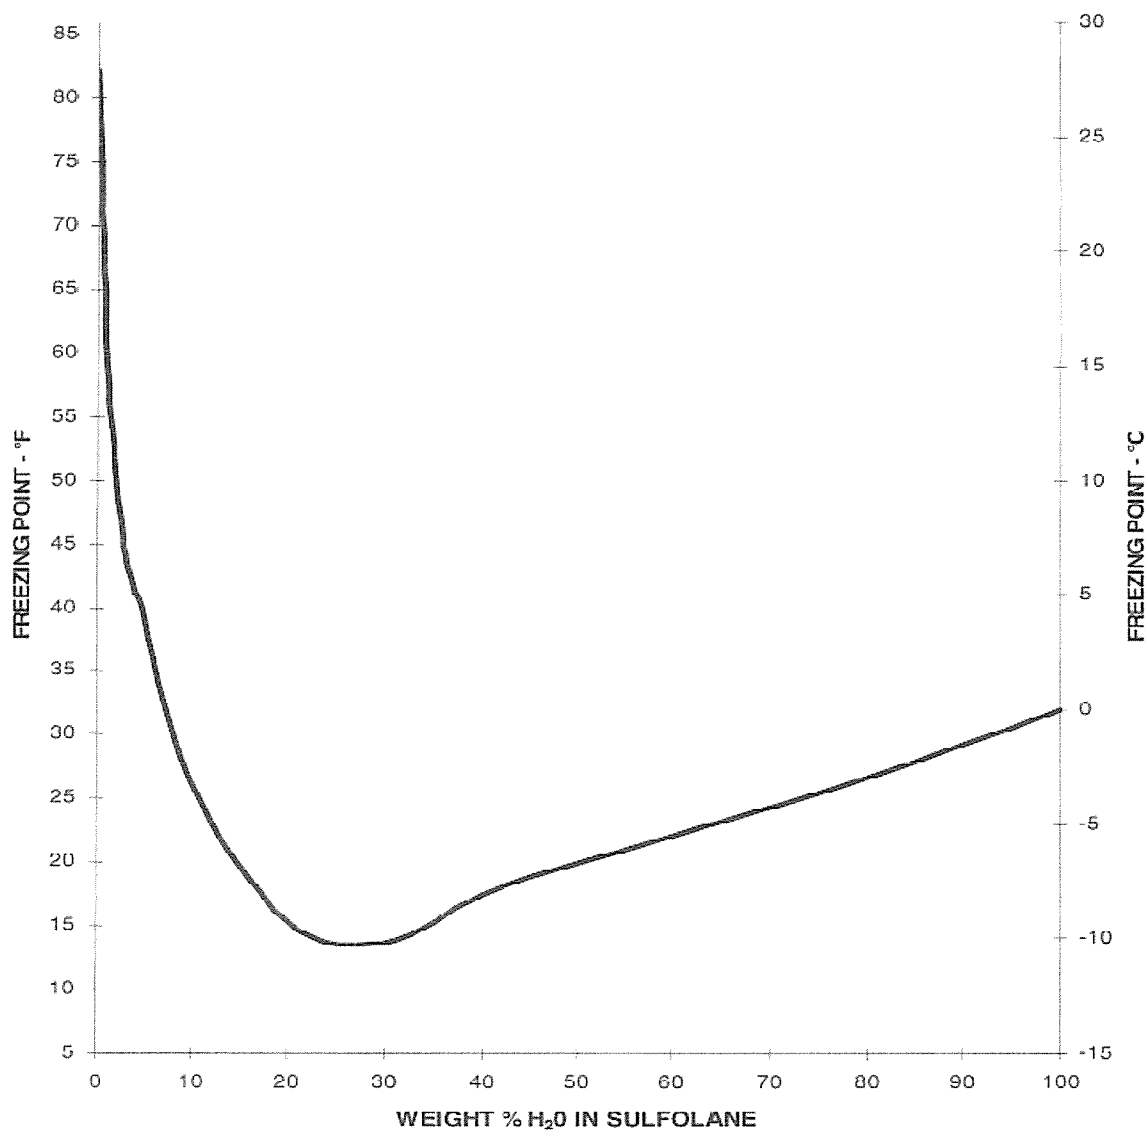

**SHELL AND TUBE
HEAT EXCHANGER
DATA SHEET**

Contract:	10E0541A01	
Equipment No:	56-E-17	
Revision:	1	Date: 15-Apr.-2011
Unit:	56 - Sulfolane	
P.O. No.:		
Document No.:	DS-56-EA-517	
Sheet	8 of 8	

HEAT EXCHANGER SKETCH

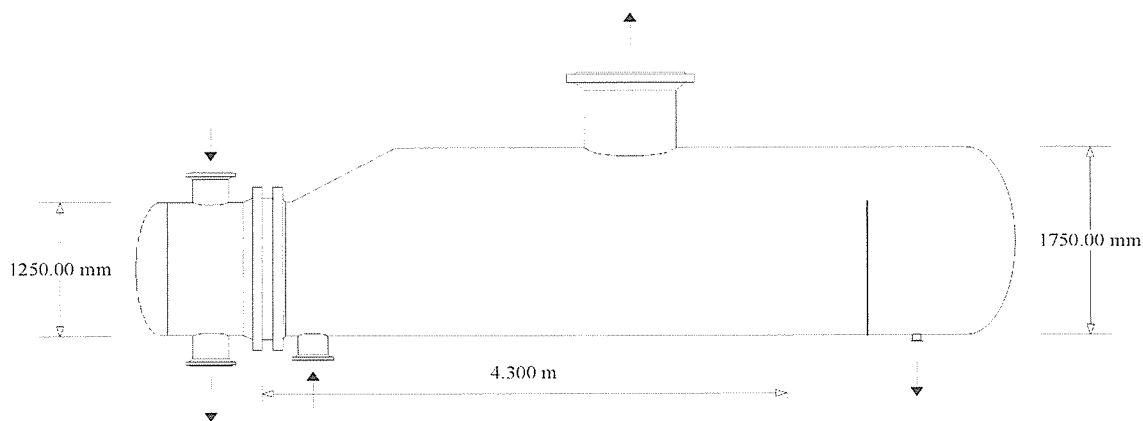



ARABIAN INDUSTRIAL FIBERS COMPANY

IR-II AROMATICS PROJECT

PROJECT NO. 10E0541A01

DOCUMENT TITLE:

PLANT INVENTORY STORAGE TANK DATA SHEET

DOCUMENT NO:

DS-56-FA-503

						ابن رشد aifc	ARABIAN INDUSTRIAL FIBERS COMPANY YANBU, KINGDOM OF SAUDI ARABIA	CTCI CORPORATION
						CERTIFIED		
2	Revised as Marked	LSH	SYL	YSL	22-Apr-11	PROJ.		
1	Issued for Design	LSH	SYL	YSL	22-Apr-11	MGR	DATE	
0	Issue For Approval	LSH	SYL	YSL	23-Mar-11	CLIENT	DATE	
REV	DESCRIPTION	BY	CHK.	APPR.	DATE	PAGE 1 OF 2		XC32C-56-503

CONTENTS

<u>ITEM</u>	<u>EQUIPMENT NO.</u>	<u>SHEET NO.</u>	<u>REV. NO.</u>	<u>REV. DATE</u>
1.	56-F-03	1 THRU 10 OF 10	2	09-Aug-2011

ابن رشد سابك
 salbia ibn rushd



PLANT INVENTORY STORAGE TANK
DATA SHEET

XC32C-56-503

2 OF 2

DATE
09-Aug-2011

REV.
2

ابن رشيد ibn rushd FLUOR.	API 650 TANK DATA SHEET Note: This data sheet has been modified from that in the annex of API Standard 650, Eleventh Edition.	Contract: 10E0541A01 Item No: 56-F-03 Revision: 2 Date: 09-Aug-2011 Unit: 56 - Sulfolane P.O. No.: Document No.: DS-56-FA-503 Sheet 1 of 10	سابك sabik  CTCI CORPORATION
Client: Arabian Industrial Fibers Company - Ibn Rushd Vendor: _____ Service: Plant Inventory Storage Tank Plant: IBN Rushd Site: Yanbu, Saudi Arabia Item Name: 56-F-03 P & ID No.: DR-56-AD-135 Vendor Shop Order No: _____ Number Req'd.: 1 Type: ☐ Shop Built ☒ Field Erected ☐ Open Top ☐ Dome Roo ☐ Umbrella Roof ☒ Cone Roof Floating Roof: ☐ No ☒ Yes - See sheet 8 of 8 for details of design and construction. Issued for: ☒ Proposal ☐ Purchase ☐ As Built Vendor Serial No: _____			
GENERAL:			
1 Size Limitation: 9.5 m dia and 9 m height Tank Diameter: 9.5 m Shell Height: 9 m Capacity: Max: 638 m³ Net Working: 465 m³ Criteria: _____ 2 Products Stored: Liquid: Sulfolane and Aromatic Hydrocarbon Min. S.G.: 1.261 (Note 23) @ 15 °C / Max. S.G.: @ °C Vapor: Vapor Pressure: 0.758 bar (a) At Maximum Operating Temperature 44 °C % Aromatic: Suppl. Spec.: H ₂ S Service: ☐ No ☐ Yes Suppl. Spec.: _____ Other Special Service Conditions: ☐ No ☐ Yes Suppl. Spec.: _____			
DESIGN CRITERIA			
3 Year Built: In accordance with API 650 11 th Edition and Addendum Appl. API 650 Appendices: ☐ A ☐ B ☐ C ☐ D ☒ E ☐ F ☐ G ☐ H ☐ I ☐ J ☐ M ☐ O ☐ P ☐ S ☐ U ☐ V Appendix W Sections Waived: ☐ All ☒ Other: Appendix R Suppl. Spec.: _____ 4 Max. Operating Temp.: 49 °C Design Metal Temp.: 85 °C Roof Max. Operating Temp.: 85 °C M.D.M.T.: 6 °C Design Pressure: 14.48 mbar(g) External Pressure: 7.58 mbar(g) Design Liquid Level: 9000 mm Maximum Fill Rate: 25.6 m³/h Maximum Emptying Rate: 25.6 m³/h 5 Seismic Design: ☐ No ☒ Yes Alternate Seismic Criteria: 22854-SP-M-001& SES B51-S01 Site Class: C Vertical Seismic Design: ☐ No ☒ Yes Vertical Ground Motion Accelerator A _v : _____ m/sec² Basis of Lateral Accel. (select one): ☒ Mapped Seismic Parameters S ₀ 0.183 S ₁ 0.048 S ₂ _____ ; ☐ Site-Specific Procedures MCE Design Required: ☐ No ☐ Yes ☐ Other (Non-ASCE) Methods: Freeboard: _____ Roof Tie Rods at Outer Ring: ☐ No ☐ Yes Sliding Friction Factor: _____ 6 Wind Velocity: 140 km/h Prevailing Wind Direction: From: _____ To: _____ Check Overturning Stability: ☐ No ☒ Yes Check Buckling in Corroded Condition: ☐ No ☒ Yes Top Wind Girder Style: _____ Dimensions: _____ mm Use Top Wind Girder as Walkway: ☒ No ☐ Yes Intermediate Wind Girders: ☐ No ☐ Yes Intermediate Wind Girder Style: _____ Dimensions: _____ mm			
CONSTRUCTION			
7 Shell Design: 1-Ft. Method: ☐ No ☒ Yes Variable-Design-Point Method: ☐ No ☐ Yes ☐ Alternate Elastic Analysis Method: ☐ No ☐ Yes ☐ Alternate: Plate Stacking Criteria: Center-line Stacked: ☐ No ☐ Yes Flush Stacked: ☐ No ☒ Yes ☐ Inside ☐ Outside Plate Widths (Shell Course Height) and Thickness (New). Numbers below indicate course number. Dimensions are in: millimeters. 1. _____ x _____ 2. _____ x _____ 3. _____ x _____ 4. _____ x _____ 5. _____ x _____ 6. _____ x _____ 7. _____ x _____ 8. _____ x _____ 9. _____ x _____ 10. _____ x _____ 11. _____ x _____ 12. _____ x _____ 13. _____ x _____ 14. _____ x _____ 15. _____ x _____ Joint Efficiency: _____ % Shell to Bottom Weld Type: _____ Corner Weld Insp. Mthd.: _____ 8 Open Top & Fixed Roofs: Open Top: ☒ No ☐ Yes - See sheet 8 for floating roof details of design and construction. Fixed Roof Type: ☐ Dome Roo ☐ Umbrella Roof ☒ Cone Roof Roof Structural Columns: ☐ Pipe ☐ Struc. Shape: _____ Dome / Umbrella Rad.: _____ m Cone Slope: _____ mm/m Weld Joint Type: _____ Seal Weld Underside of Lap Joints: ☐ No ☐ Yes Seal Weld Underside of Wind Girder Joints: ☐ No ☐ Yes Gas Tight: ☐ No ☒ Yes Joint Efficiency: _____ % Thickness: _____ (mm) Live Load: _____ kPa Applicable Supplementary Load Specification: _____ Column Lateral Load: _____ N Normal Venting Devices: Yes Note 11 Emergency Venting Devices: Yes Note 11, 24 Frangible Roof to Shell Joint: ☒ No ☐ Yes Seal Weld Roof Plates to Top Angle on the Inside: ☐ No ☒ Yes Radial Projection of Horizontal Component Top Angle: ☐ Inward ☒ Outward Roof to Shell Detail: _____ Point Load Required: ☐ No ☐ Yes			

REV

1

1

2

ابن رشيد ibn rushid FLUOR.	API 650 TANK DATA SHEET Note: This data sheet has been modified from that in the annex of API Standard 650, Eleventh Edition.	Contract: 10E0541A01 Item No: 56-F-03 Revision: 2 Date: 09-Aug-2011 Unit: 56 - Sulfolane P.O. No.: Document No.: DS-56-FA-503 Sheet 2 of 10	 سابك sabik CTCI CORPORATION
CONSTRUCTION (Continued)			
9 Bottom: (F Thickness: _____ mm Weld Joint Type: _____ Style: ☐ Flat ☒ Cone Up - Centered ☐ Cone Down - Center ☐ Cone Down - Off-Center ☐ Tilted Slope: 1:120 mm/m Provide Drip Flange: ☐ No ☒ Yes Alternate Specification: _____ Annular Ring: ☐ No ☒ Yes Minimum Width: _____ mm Thickness: _____ mm Sump Required: ☐ No ☒ Yes 10 Foundation: Furnished by: ☐ Purchaser ☐ Vendor ☒ Other Type: _____ Soil Allowable Bearing Pressure: _____ bar(g) Per Spec.: _____ Anchor Size: _____ mm Qty: _____ Foundation Design Loads: Base Shear Force: _____ Wind: _____ N Seismic: _____ N See Note 6 Overturning Moment: _____ N-m Seismic: _____ N-m Ring Forces: Weight of Roof + Shell: New: _____ kg Corroded: _____ kg Roof Live Load: _____ kPa Internal Pressure: _____ bar(g) Partial Vacuum: _____ bar(g) Wind: _____ km/h Seismic: _____ N Bottom Forces: Floor Wt.: New: _____ kg Corroded: _____ kg Product Wt.: _____ kg Water Wt.: _____ kg Internal Pressure: _____ bar(g) Partial Vacuum: _____ bar(g) Other Foundation Loads: _____ Minimum Projection of Foundation Above Grade: later mm			
INSPECTION and TESTING			
11 Responsibility for Heating Water, if Required: ☐ Purchaser ☒ Vendor ☐ Other: Hydrotest Fill Height: Note 9 Min. Hydrotest Temp.: API 650 °C Extended Duration of Hydrotest: Note 9 hours Settlement Measurements Required: ☐ No ☒ Yes Predicted Settlement Profile is Attached: ☒ No ☐ Yes Responsibility for Setting Water Quality: ☐ Purchaser ☒ Vendor Suppl. Test Water Quality Spec.: _____ Test Water Source & Disposal Tie-In Locations: Vendor approved by owner Hydrotest Appendix J Tank: ☐ No ☐ Yes Post-Pressure-Test Activities Required of the Vendor: ☐ Broom Clean ☐ Potable Water Rinse ☒ Dry Interior Other: Note 9			
12 Inspection by: _____ in Shop ; Tank Supplier, Company _____ in Field. Supplemental NDE Responsibility: Tank Supplier Supplemental NDE Spec.: 22854-SP-000-W-002 Positive Material Identification: ☒ No ☐ Yes PMI Requirements: _____ Waive Dimensional Tolerances of Section 7.5: ☒ No ☐ Yes Max. Plate Thickness for Shearing: _____ Shearing not allowed Welds Not Exceeding 6 mm Shall Be Multi-Pass: ☐ No ☐ Yes Welds Exceeding 6 mm Shall Be Multi-Pass: ☐ No ☒ Yes Leak Test Method: Roof: _____ Shell: _____ Nozzle/Manhole Repad Plate: _____ Approved Tank supplier Bottom: _____ Floating Roof Components: _____ procedure			
COATINGS			
Internal Coatings by: ☒ Not Req'd. ☐ Vendor ☐ Others: _____ Per Spec.: _____ External Coating by: ☐ Not Req'd. ☒ Vendor ☐ Others: _____ Per Spec.: T01-S01-SES-PCS-3 Under Bottom Coating by: ☐ Not Req'd. ☒ Vendor ☐ Others: _____ Per Spec.: T01-S01-SES-PCS-9			
ADDITIONAL INFORMATION			
14 Surface Weld Prep.: ☒ Internal: Floating Roof Requirements ☐ External: _____ ☐ Roof: _____ NACE Requirements: ☒ No ☐ Yes Per Std.: _____ 15 Cathodic Protection System: ☐ No ☒ Yes ☐ Internal ☒ External Per Spec.: Impressed Current per E29-E01, E29-S01 16 Fire Protection: ☐ No ☒ Yes Per Spec.: See note 12 17 Leak Detection System: ☐ No ☒ Yes Per Spec.: API 650 Appendix I 18 Release Prevention Barrier: ☐ No ☒ Yes Per Spec.: API 650 Appendix I 19 Tank Measurement System Req'd.: ☐ No ☒ Yes Remote Capability Req'd.: ☐ No ☒ Yes By: Others Per Spec.: 22854-SP-000-J-019 20 Weight Of Tank: Full of Water: _____ kg Empty: _____ kg Shipping: _____ kg Brace/Lift Spec.: _____ 21 References: ☒ API 650 ☒ PIP VESTA002 ☐ PIP VESTA003 ☒ Other: 22854-SP-000-F-001			
REMARKS			
22 Remarks:			
1. Vent vendor to provide vent with bird and insect screen 2. Deleted. 3. Tank bottom to have cone-up centered configuration to provide for completely emptying the tank during emergency. 4. Pump connection on one side of the tank to be provided with inverted nozzle to facilitate connecting to the portable pump. 5. Vendor can provide different sloping configuration if economical. 6. Tank Supplier shall design, procure and install foundations in accordance with specifications B51-S01, B52-E01, B52-S01 and E29-E01. 7. Flange bolts and nuts shall have a Xylan* fluoropolymer coating (* Registered Trademark of Whitford Corporation). 8. Gaskets: 1.6 mm thick flexible graphite with 304 or 316 SS corrugated insert. 9. Hydrotesting shall be in accordance with Specification 22854-SP-000-F-001 Section 11. 10. Roof shall have 360 degree hand rails.			

ابن رشيد ibn rushd FLUOR.	API 650 TANK DATA SHEET Note: This data sheet has been modified from that in the annex of API Standard 650, Eleventh Edition.	Contract: 10E0541A01 Item No: 56-F-03 Revision: 2 Date: 09-Aug-2011 Unit: 56 - Sulfolane P.O. No.: Document No.: DS-56-FA-503 Sheet 3 of 10	 سابك sabik CTCI CORPORATION		
* If box is blank, Vendor shall determine and submit as per Appendix L.					
Table 1 MATERIALS OF CONSTRUCTION					
Component	Material* / Thickness* (mm)	C.A.	Component	Material* / Thickness* (mm)	C.A.
Shell, Course All to	A516 Grade 70 (KCS) /	1.6	Reinforcing Pads	A516 Grade 70 (KCS) /	1.6
Shell, Course to	/		Manhole/Nozzle Necks	A516 Grade 70 (KCS), A106 GR B /	1.6
Shell, Course to	/		Manhole/Nozzle flanges	A516 Grade 70 (KCS), A105	1.6
Shell, Course to	/		Flange Covers	A516 Grade 70 (KCS) /	1.6
Shell, Course to	/		Anchor Attachments	A516 Grade 70 (KCS) /	1.6
Roof	A516 Grade 70 (KCS) /	1.6	Submerged Piping	A106 Grade B /	1.6
Bottom	A516 Grade 70 (KCS) /	1.6	Wetted Structural	+ A36 /	1.6
Annular Ring	A516 Grade 70 (KCS) /	1.6	Non-wetted Structural	+ A36 /	1.6
+ C.A. is to apply to each exposed surface: ☐ No ☒ Yes					
Table 2 BOLTS and ANCHORS					
Component	Head Type	Bolt or Anchor Material	Nut Material	Thread Series	C.A. (mm)
Flange Bolting		A193 Grade B7	A194 Grade 2H		1.6
Structural Bolting					
Anchor Bolts		A307 Grade A	A563		1.6
REMARKS (Continued)					
22 Remarks (Continued):					
11. Vent supplier shall size and supply psv for the floating roof and fixed roof for combined pressure/vacuum relief. Tank pressure/vacuum vent shall be in accordance with API 2000.					
12. Tank supplier to provide battery limit, deluge and water spray system in accordance with Sabic Specification					
13. Design Temperature = 85°C.					
14. CTCI shall confirm PSV nozzle size.					
15. Liquid level: HLL: 7500 mm, LLL: 1000 mm.					
16. Provide one 4" gas tight gauging and sample device. Include all necessary accessories to permit gauging and sampling without venting gas to atmosphere.					
17. Entire tank side wall and roof shall be insulated.					
18. Locate filling and suction nozzles 180 degree apart to allow sufficient residence time for water settling and thermal equilibrium.					
19. Flash point: -28°C					
20. One level indicator to indicate position of internal roof. One level indicator shall extend into the liquid to indicate interface liquid level.					
21. Limit the inlet velocity to 3 ft/s (1 m/s) until inlet pipe is submerged.					
Add distributor at N1 nozzle as detail A					
22. Painting code follows 22854-SP-000-X002.					
23. This tank can contain an interface of hydrocarbons and solvents. Specific gravity@44°C : upper : 0.637 ; lower : 1.240					
24. Set pressure : 14.48 mbar(g) Design Relief Rate : 17737.9 Nm3/hr Air.					

5189

ابن رشيد ibn rushd FLUOR.	API 650 TANK DATA SHEET Note: This data sheet has been modified from that in the annex of API Standard 650, Eleventh Edition.	Contract: 10E0541A01 Item No: 56-F-03 Revision: 2 Date: 09-Aug-2011 Unit: 56 - Sulfolane P.O. No.: Document No.: DS-56-FA-503 Sheet 5 of 10	سابك sabik  CTCI CORPORATION
--	---	---	--

1	OTHER TANK APPURTENANCES		REV
2	23 Platform, Stairway and Railing: Galvanizing Req'd.: ☐ No ☒ Yes	Stairway Style: Helical	
3	Walk Surface Type: Grating	Stair and Walkway Clearance Width: 750 mm	
4	National Safety Standards:	Arch./Struct. Spec.: Angle to horizontal maximum of 45 deg	
5	Gauger's Platform Req'd.: ☐ No ☒ Yes Qty. Req'd: Later	Per Specification: Q03-S20, Note 10	
6	24 Jackets and Other Heaters/Coolers: Jacket Req'd: ☒ No ☐ Yes	Jacket Construction: ☐ Integral ☐ Stand Alone	
7	Type: ☐ Annular Cylinder ☐ Pipe Coil ☐ Half Pipe Helix ☐ Other:		
8	How Attached: ☐ Welded ☐ Bolted		
9	Supplemental Jacket Specification:		
10	Other Heaters/Coolers: ☐ No ☒ Yes Type: ☒ Internal Coils ☐ Bayonet Exchanger ☐ Below Bottom Piping		
11	☐ Other:		
12	Specification for Other Heaters/Coolers: See Tank Heater Data Sheet DS-56-EA-519		
13	Design Pressure: Internal: _____ bar(g) Partial Vacuum: _____ g	Design Temp.: Max. _____ °C Min. _____ °C	
14	25 Mixer/Agitator: Quantity: _____ Size: _____	Per Specification:	
15	26 Insulation: Required: ☐ No ☒ Yes Thickness: 40 mm (Note 17) Material: Mineral Wool with Jacket		1
16	Responsibility for Insulation and Installation: ☒ Vendor ☐ Others:	Per Spec.: 22854-SP-000-N-001, SN	
17	27 Structural Attachments: Lifting Lugs: ☒ No ☐ Yes Description:		
18	Shell Anchorage: ☐ No ☒ Yes Type: By Tank Supplier	Scaffold Cable Support: ☐ No ☐ Yes	
19	28 Various Other Items: Welded Flush-type: ☐ Shell Connection ☐ Cleanout Fitting	Waive Application of Appendix P: ☐ No ☐ Yes	
20	Miscellany #1 _____	Miscellany #2 _____	
21	Miscellany #3 _____	Miscellany #4 _____	
22	Miscellany #5 _____	Miscellany #6 _____	
23	Table 4 OTHER TANK APPURTENANCES		
24			
25	MARK	QTY.	REMARKS
26			
27	PS-xx	Pipe Supports	Later
28	PG-xx	Pipe Guides	Later
29			
30			

API 650 TANK DATA SHEET

Note: This data sheet has been modified
from that in the annex of API Standard 650,
Eleventh Edition.

Contract: 10E0541A01
Item No: 56-F-03
Revision: 2 Date: 09-Aug-2011
Unit: 56 - Sulfolane
P.O. No.:
Document No.: DS-56-FA-503
Sheet 6 of 10

29 Tank Elevation Sketch

VESSEL DIMENSIONS: ID: 9500 mm Height: 9000 mm

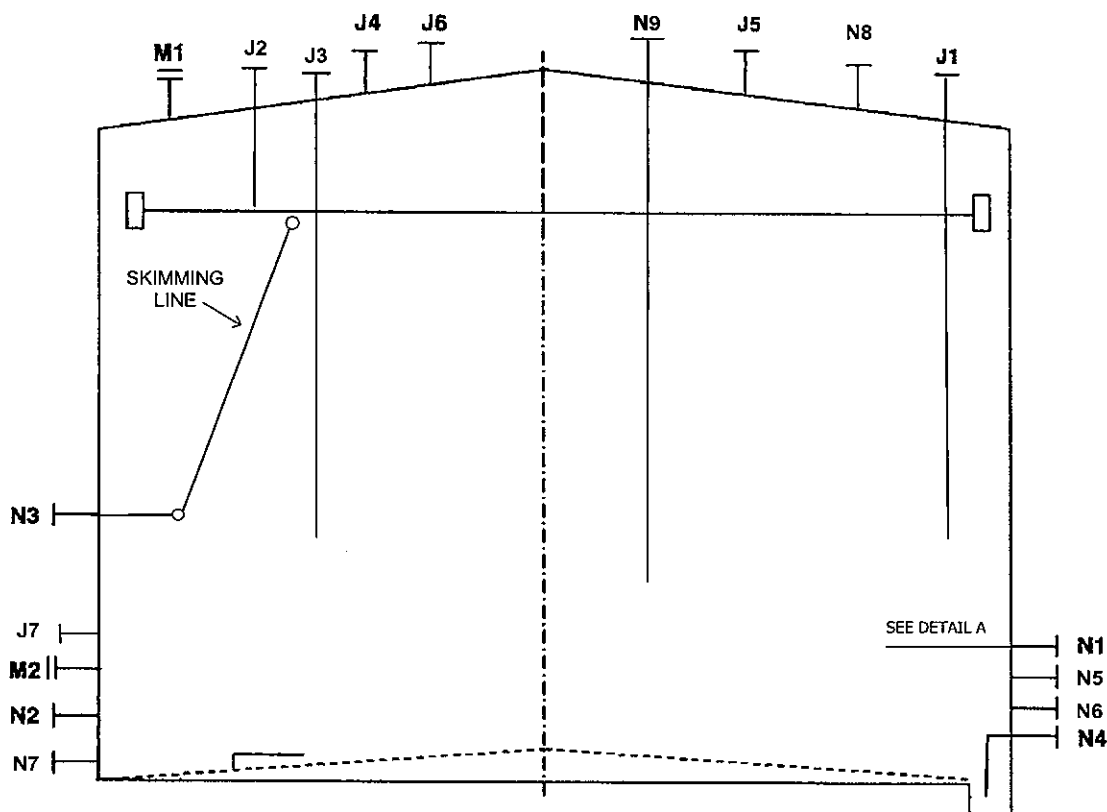

Notes:

1. Add a overflow box on nozzle N3
2. Deleted.
3. Deleted.
4. This tank can contain an interface of hydrocarbons and solvents.
A floating suction system shall be provided to allow pumping the top hydrocarbon layer.

REV

2

1

2

ابن رشد
ibn rushd
FLUOR.

**API 650 TANK
DATA SHEET**

Note: This data sheet has been modified
from that in the annex of API Standard 650,
Eleventh Edition.

Contract:	10E0541A01
Item No:	56-F-03
Revision:	2 Date: 09-Aug-2011
Unit:	56 - Sulfolane
P.O. No.:	
Document No.:	DS-56-FA-503
Sheet	7 of 10


سابك
SABIC


CTCI CORPORATION

REV

1 30 Tank Plan/Nozzle Orientation Sketch

2
3
4
5
6
7
15
16
17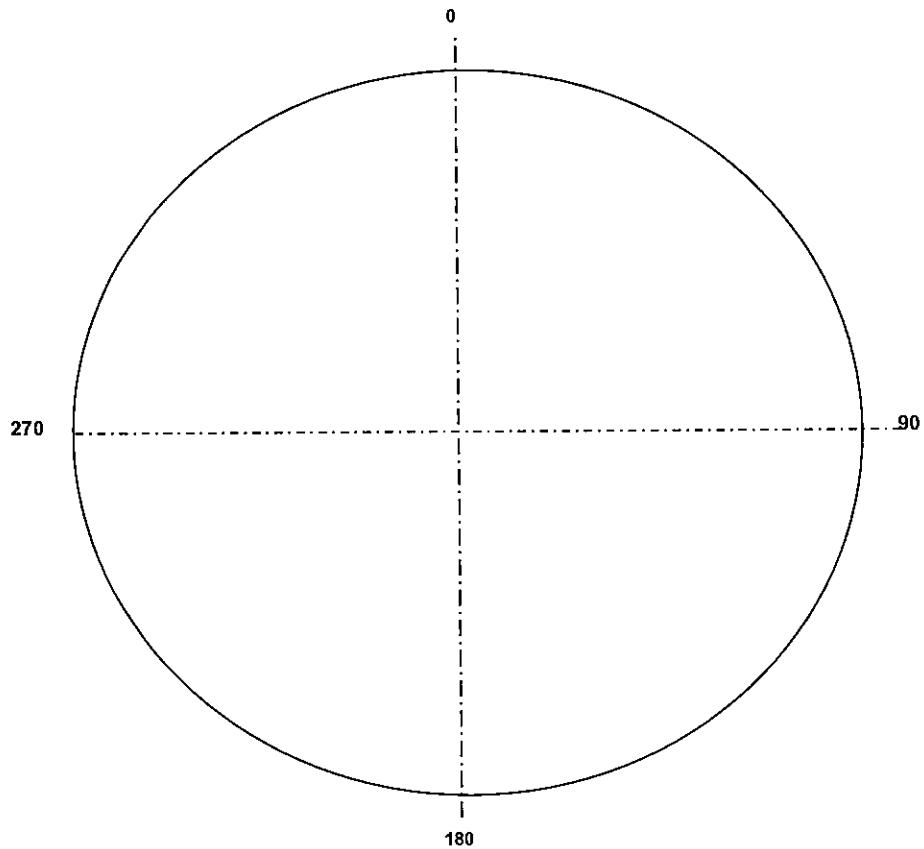
Note:
Orientations will be furnished later

**API 650 TANK
DATA SHEET**

Note: This data sheet has been modified
from that in the annex of API Standard 650,
Eleventh Edition.

Contract: 10E0541A01
Item No: 56-F-03
Revision: 2 Date: 09-Aug-2011
Unit: 56 - Sulfolane
P.O. No.:
Document No.: DS-56-FA-503
Sheet 8 of 10



CTCI CORPORATION

REV

FLOATING ROOF DATA

31 Roof Selection: Design Basis: ☐ Appendix C or ☒ Appendix H Supplemental Spec.: 22854-SP-000-F-003 Section 8
External: ☐ Single Deck Pontoon ☐ Double Deck
Type of Roof: Internal: ☒ Tubular Pontoon ☐ Metallic Sandwich Panel ☐ Other: Spec.:
32 Seals: Primary Seal: ☐ Shoe ☐ Envelope ☐ Wiper/Compression Plate ☐ Other: Spec.:
Shoe Mechanism: ☐ Vendor's Standard ☐ Other:
Electrically Isolate Mechanism from Shoes: ☐ No ☐ Yes Wax Scrapers Required: ☐ No ☐ Yes
Minimum Shoe Thickness: mm Carbon Steel Shoes to be Galvanized: ☐ No ☐ Yes
Secondary Seal: ☐ None ☐ Shoe ☐ Envelope ☐ Wiper ☐ Other Supplemental Spec.:
33 Data For All Floating Roofs:
Overflow Opening in Shell Acceptable: ☒ No ☐ Yes Shell Extension: ☐ No ☐ Yes
Roof Drain Check Valves Required: ☐ No ☐ Yes Roof Drain Isolation Valves Required: ☐ No ☐ Yes
Freeze Protection for Roof Drains Required: ☐ No ☐ Yes Supplemental Requirements:
Roof Drain Piping to Ext. Nozzles: ☐ Vendor Std. ☐ Armored Flex. Pipe ☐ Swirls in Rigid Pipe ☐ Other:
Minimum Deck Thickness: mm Foam Dam? ☐ No ☐ Yes Suppl. Spec.:
Bulkhead Top Edges to be Liquid Tight: ☐ No ☒ Yes Seal Weld Underside of roof: ☐ No ☐ Yes
Electrical Bonding: Shunts: ☐ No ☐ Yes Cable: ☐ No ☐ Yes Suppl. Spec.:
Quantity of Non-Guide Pole Gauge Wells Required: Quantity of Sample Hatches Required:
Guide Pole for Gauging: ☐ No ☐ Yes Datum Plates: ☐ No ☐ Yes
Slots in Guide Pole: ☐ No ☐ Yes Striking Plates: ☐ No ☐ Yes
Guide Pole Emissions Limiting Devices: ☐ Sliding Cover ☐ Pole Wiper ☐ Pole Sleeve ☐ Float ☐ Float Wiper ☐ Pole Cap
Qty. of Roof Manholes: Min. High-Roof Clearance Above Bottom: Operating: 1600 mm Maintenance: 1600 mm
Removable Leg Storage: ☐ No ☐ Yes Leg Sleeves Or ☐ Fixed Low Legs
34 Additional Data For External Roof: Not Applicable
Weather Shield: ☐ No ☐ Yes Supplemental Specification:
Rolling Ladder: ☐ No ☐ Yes Field Adjustable Legs ☐ No ☐ Yes
Design Rainfall Intensity: mm/hr Based on a Minute Duration Associated with the Storm
Design Accumulated 24-Hour Rainfall: mm Based on the Storm
Distortion and Stability Determinations Required: ☐ No ☐ Yes Supplemental Spec.:
Landed Live Load: N
35 Additional Data For Internal Roof:
Two Position Leg: ☐ No ☒ Yes Cable Supported Roof: ☐ No ☐ Yes Fixed Roof Inspection Hatches: ☐ No ☒ Yes
Internal Roof Drain: ☒ No ☐ Yes Omit Distribution Pads Supporting Uniform Live Loads: ☐ No ☐ Yes
Corrosion Gauge Rq'd.: ☐ No ☐ Yes Fixed Ladder Rq'd.: ☐ No ☐ Yes Type of Roof Vent:
Modified Minimum Point Load: ☐ No ☐ Yes Supplemental Specification:
Mfr. To Leak Test: % of Compartments. ☐ In Assembly Yard ☐ In Erected Position ☒ Unknown; see separate contract terms.
Roof Erector's Flotation Test: ☐ Not Required ☐ With Tank Hydrotest ☐ at Completion of Roof ☒ at Later Date: After Tank Test
Flotation Test Media: ☒ Water ☐ Product (see H.6.6.1) Water Quality: ☒ Potable ☐ Other Suppl. Spec.:
Flotation Test: Duration: hrs Fill Height: mm
Flotation Test Items provided by Purchaser (see H.6.7): ☐ None ☐ List attached
Responsible Party for Inspecting Roof during Initial Fill: ☐ Purchaser ☐ Other:

Table 5 FLOATING ROOF MATERIALS

Component	Material/Thickness (mm)	C.A./Coating	Component	Material/Thickness (mm)	C.A./Coating
Deck Plate	CS /	1.6	Datum Plate	/	
Inner Rim Plate	/		Tubular Pontoon	/	
Outer Rim Plate	/		Pontoon Bulkhead	/	
Foam Dam	/		Submerged Pipe	/	
Sandwich Panel Face Pl.	/		Guide Pole	/	
Sandwich Panel Core	/		Secondary Seal	/	
Gauge Well	/		Secondary Seal Fabric	/	
Drain Sumps	/		Wiper Tip	/	
Opening Sleeves	/		Wax Scrapers Required	/	
Floating Suction Lines	/		Weather Seal	/	
Primary Fabric Seal	/		Envelope Fabric	/	
Foam Log Core	/		Shoe Mechanism	/	
Landing Legs	/		Primary Seal Shoe	/	
Landing Leg Bottom Pad	/		Removable Covers	/	
Manhole Necks	/		Rolling Ladder	/	
Vents	/		Inlet Diffusers	/	

ابن رشيد
ibn rushd
FLUOR.

API 650 TANK DATA SHEET

Note: This data sheet has been modified from that in the annex of API Standard 650, Eleventh Edition.

Contract: 10E0541A01
Item No: 56-F-03
Revision: 2 Date: 09-Aug-2011
Unit: 56 - Sulfolane
P.O. No.:
Document No.: DS-56-FA-503
Sheet 9 of 10



36 Heater Nozzle Sketch

Revision
Indication
A


UOP
A Honeywell Company

UOP LLC
25 East Alconquin Road
Des Plaines, Illinois 60017 507, USA

STANDARD DRAWING
3-390-3

STORAGE TANK STEAM AND CONDENSATE NOZZLE

DATE	STATUS	APVD	AUTHD
31DEC08	REVISED	JLS	ROF

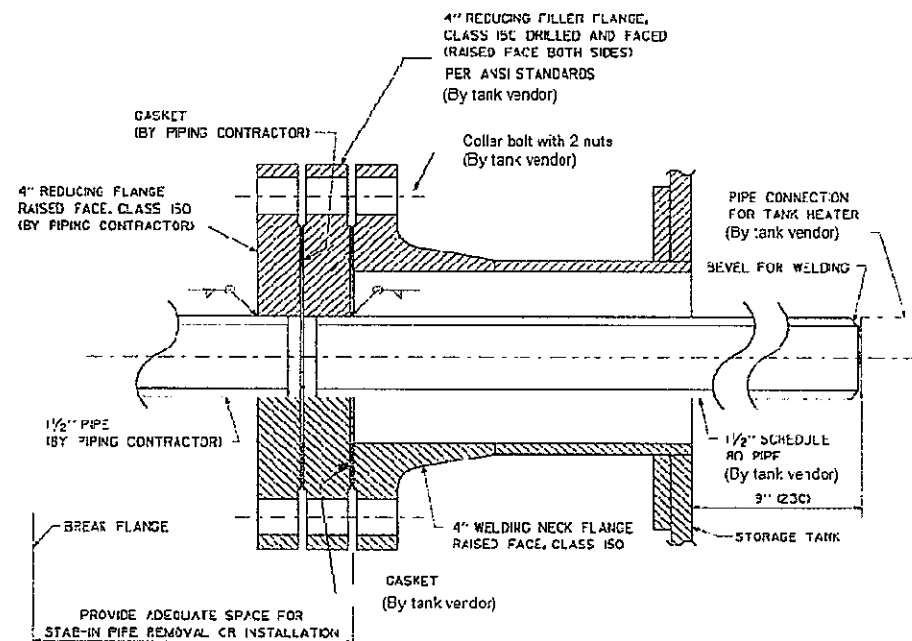

NOTES:

1. ALL INTERNAL STEAM AND CONDENSATE PIPING SHALL BE MADE OF KILLED CARBON STEEL, SCHEDULE 80 PIPE.
2. DIMENSIONS SHOWN IN PARENTHESES ARE IN MILLIMETERS.
3. DETAILS, DIMENSIONS, AND NOTES IN UOP PROJECT SPECIFICATION-36-TANK HEATERS TAKE PRECEDENCE OVER THOSE SHOWN HEREON.

Note: The information in this document is confidential and the property of UOP LLC and must not be disclosed to others or reproduced in any manner or used for any purpose whatsoever without the written permission.

ابن رشد
ibn rushd

API 650 TANK DATA SHEET

Note: This data sheet has been modified
from that in the annex of API Standard 650,
Eleventh Edition.

Contract:	10E0541A01
Item No:	56-F-03
Revision:	2 Date: 09-Aug-2011
Unit:	56 - Sulfolane
P.O. No.:	
Document No.:	DS-56-FA-503
Sheet	10 of 10


سابك
sabc



CTCI CORPORATION

REV

DETAIL A

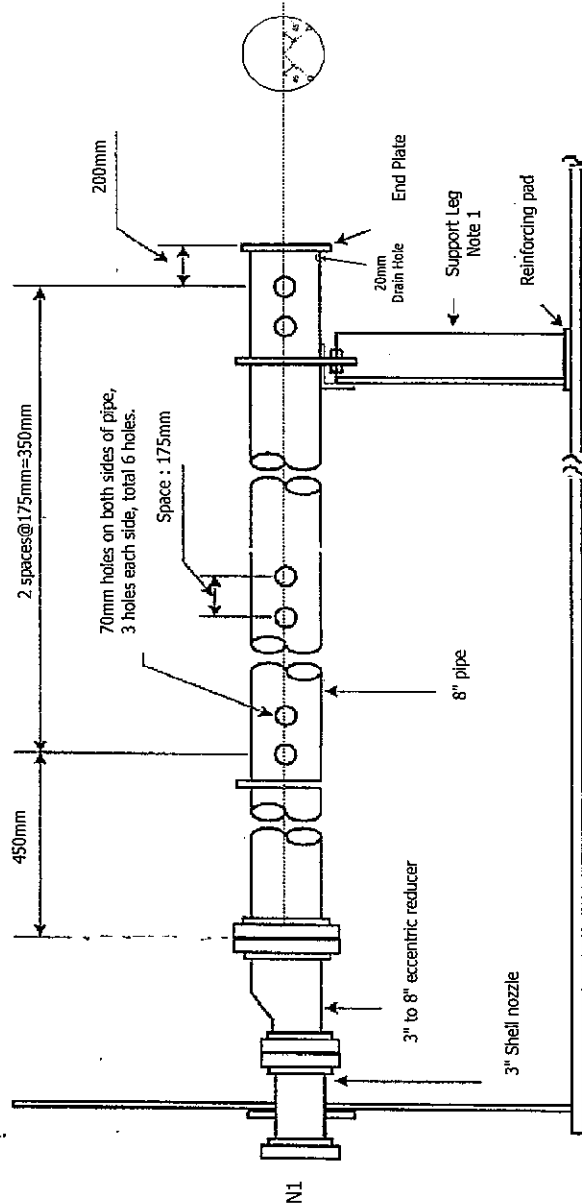

Note :

1. Support shall be confirmed by manufacturer.



ARABIAN INDUSTRIAL FIBERS COMPANY

IR-II AROMATICS PROJECT

PROJECT NO. 10E0541A01

DOCUMENT TITLE:

TOLUENE COLUMN DATA SHEET

DOCUMENT NO:

DS-58-CA-502

						ابن رشد ibn rushd	ARABIAN INDUSTRIAL FIBERS COMPANY YANBU, KINGDOM OF SAUDI ARABIA	CTCI CORPORATION
						CERTIFIED		
						PROJ.	S P L for	
1	Issued For Design	CAG	CMW	YSL	31-Mar-11	MGR	DATE	3/31/11
0	Issue For Approval	CAG	CMW	YSL	9-Mar-11	CLIENT	DATE	
REV	DESCRIPTION	BY	CHK.	APPR.	DATE	PAGE 1 OF 2	XC32A-58-502	

CONTENTS

<u>ITEM</u>	<u>EQUIPMENT NO.</u>	<u>SHEET NO.</u>	<u>REV. NO.</u>	<u>REV. DATE</u>
1.	58-C-02	1 THRU 2 OF 2	1	31-Mar.-2011

Attachment total 1 page.

ابن رشيد ibn rushid	COLUMN DATASHEET	Contract: 10E0541A01	 CTCI CORPORATION
		Equip. No.: 58-C-02	
		Revision: 1 Date: 31-Mar.-2011	
		Unit: 58 - BT Fractionation	
		PO No.:	
Document No.: DS-58-CA-502	Sheet: 1 of 2		

Client: Arabian Industrial Fibers Company Service: Toluene Column	Plant: BT Fractionation Site: Yanbu, Kingdom of Saudi Arabia
--	---

DESIGN SKETCH

VESSEL DIMENSIONS ID: 5200 mm T/T: 35000 mm

DESIGN CONDITIONS

Pressure:	3.5 bar(g)	at	203 °C
Vacuum:	FV bar(g)	at	175 °C
Min. Metal Temp:	9 °C	at	MAWP bar(g)
Liquid Level:	Note1 mm		
Specific Gravity of Liquid:	0.742	at	°C

OPERATING CONDITIONS

Pressure:	Note 2 bar(g)	at	Note 2 °C
Vacuum:	- bar(g)	at	- °C
Low Temperature:	- °C	at	- °C
Hydrogen Partial Press.	- bar(a)	at	- °C

INTERNALS & INSULATION

DESCRIPTION	Bulk Density kg/m³	Liquid Holdup vol%	Pressure Drop bar
Packing:			
Catalyst:			
Mist Eliminator:			
Insulation	40/50 mm Hot	☒ Cold	☐
Fire Proofing	76 mm Yes	☒ No	☐

CONSTRUCTION

	Materials	Corrosion Allowance
Shell:	SA-516-60	3 mm
Heads	SA-516-60	3 mm
Support		mm

SPECIAL CONDITIONS

Stress Relieve (Process Reason Only):	Yes ☐ No ☐
Vessel in Wet Sour Service:	Yes ☐ No ☐
Steamout Required:	Yes ☒ No ☐

	(kg)
EMPTY	
OPERATING	
FULL OF WATER	
(mm)	
TOP HEAD	
SHELL / TRANSITION	
BTM HEAD	
SKIRT	

[illegible]

FOR RECORD

CLIENT : HUN RUSHD
PROJECT : PTA & AROMATICS -
TITLE : AROMATICS
JOB NO. : 51046
DOC. NO. : DS-58-C-002 (1/1)

REVISIONS				
MARK	DATE	BY	APP'D	REVISION
APRD	11/26/96	K. Nakamura	K. Nakamura	
CHKD	11/26/96	K. Nakamura	K. Nakamura	
MADE	11/26/96	K. Nakamura	K. Nakamura	
DATE	11/26/96	K. Nakamura	K. Nakamura	

UOP

25 East Algonquin Road - PO Box 5017 - Des Plaines, Illinois 60017-5017 - U.S.A.

VESSELS

SERVICE TOLUENE COLUMN ITEM NO 58-C-02 C-5802

Design	INT 3.5 BAR(g)	R203°C	(*) BY CONTRACTOR
Conditions	EXT FULL VACUUM	0175°C	
at Top	Metal Temperature (Min)	9°C	
Operating	TOP	123°C	
Conditions	BOTTOM	175°C	

Radiograph	NR
Postweld Heat Treat	NR
Joint Efficiency	NR X

Material Specifications

Heads	SA516-60
Shell	SA516-60

Shell	Thickness	Corrosion
	Required by	Allowance
	Code-in.	in. (Min)
		3

Heads	
	3

	3

Vessel Heads

Top Head	2:1 ELLIPTICAL
Bottom Head	2:1 ELLIPTICAL

Accessories Applied by Fabricator

Ladder & Platform Clips	AS REQUIRED (*)
-------------------------	-----------------

Insulation Clips & Rings	YES
--------------------------	-----

Vessel Support	YES
----------------	-----

Nozzles and Manways

Mark	No	Size	Service
Inches			
AI	1	0	REFLUX
AM	1	24	HANWAY
AO	1	30	VAPOR OUT (*)
AV	1	3	VENT
BU	2	1	TORC-T1 10
CU	2	1	TORC-T1 10
DU	2	1	TORC-T1 10
EU	2	1	TORC-T1 10
FI	1	10	FEED
FH	1	24	HANWAY
GH	1	24	HANWAY
GU	2	1	T1 10
HI	1	46	REDUCLER IN (*) (C)
HL	2	2	LEVEL
HM	1	24	HANWAY
HS	1	3	STEAMOUT
IO	1	20	BTHS OUT

--	--	--	--

--	--	--	--

NOTE - These data are confidential and the property of UOP and shall not be disclosed to others or reproduced in any manner or used for any purpose whatsoever except by written permission or as provided in a signed agreement with UOP relating to such data.

PROJECT SPECIFICATION

560696 - 301 - 1 SHEET 4

REV	DATE	BY	APP'D	REV	DATE	BY	APP'D
0	4/4/95						
1	9/21/95	S. NIE	AK				

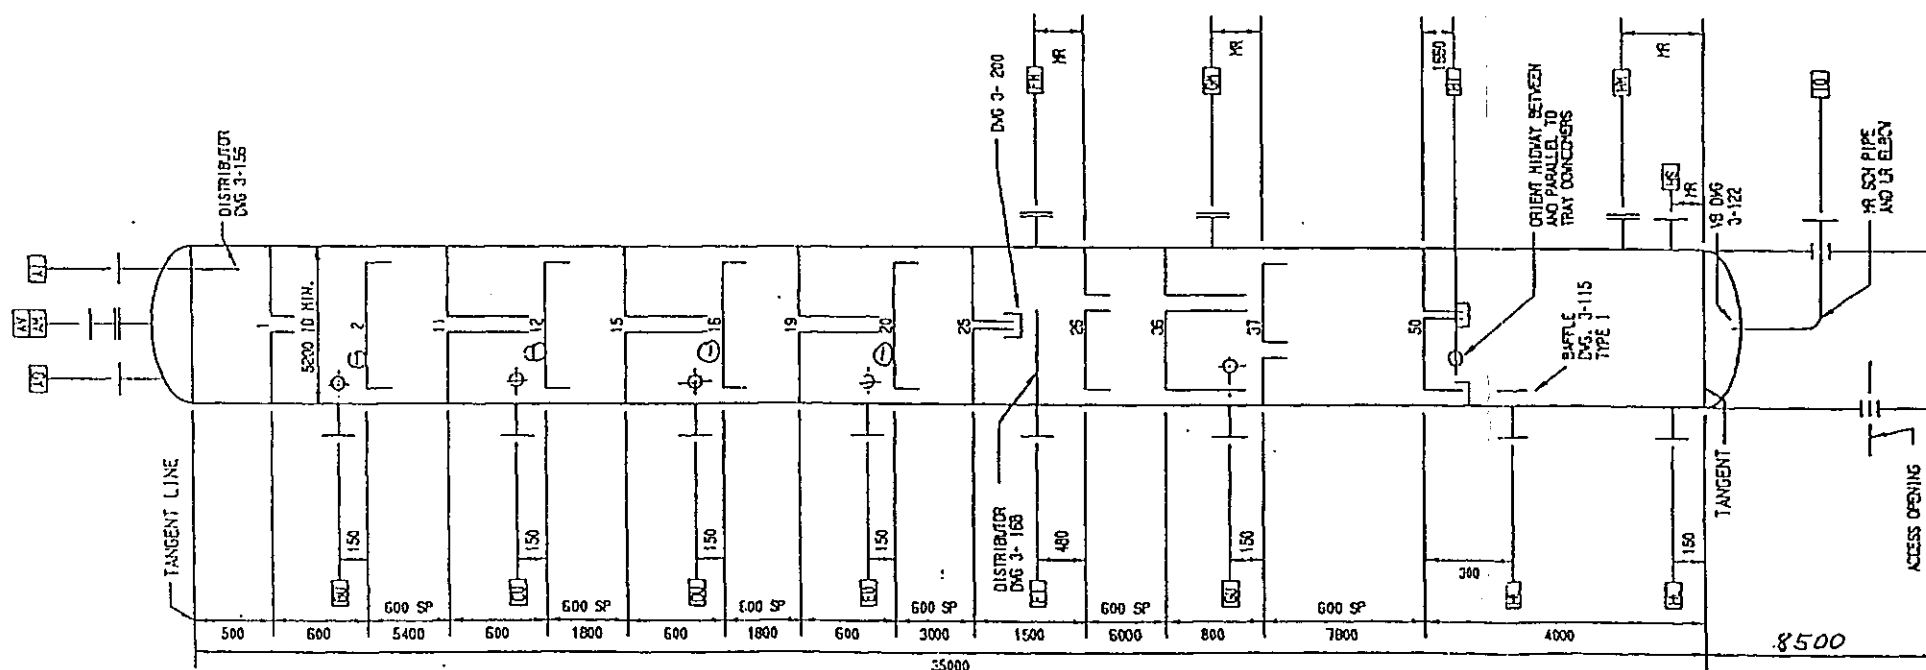

Drawings Referred to in this Specification

3-115-2	3-122-0	3-156-1	3-168-2	3-200-2			
---------	---------	---------	---------	---------	--	--	--

509137



ARABIAN INDUSTRIAL FIBERS COMPANY

IR-II AROMATICS PROJECT

PROJECT NO. 10E0541A01

DOCUMENT TITLE:

TX OXYGEN STRIPPER RECEIVER

DOCUMENT NO:

DS-58-DA-503

						ابن رشد ibn rushd	ARABIAN INDUSTRIAL FIBERS COMPANY YANBU, KINGDOM OF SAUDI ARABIA	 CTCI CORPORATION
3	Revised as Marked	WCC	CMW	YSL	10-Nov-11	CERTIFIED		
2	Revised as Marked	WCC	CMW	YSL	11-Aug-11	PROJ.		
1	Issued for Design	WCC	CMW	YSL	26-Apr-11	MGR _____ DATE _____		
0	Issue For Approval	WCC	CMW	YSL	9-Mar-11	CLIENT _____ DATE _____		
REV	DESCRIPTION	BY	CHK.	APPR.	DATE	PAGE 1 OF 2		XC32B-58-503

 ابن رشيد سابك salbia ilmrushid CTCI CORPORATION	TX OXYGEN STRIPPER RECEIVER DATA SHEET		XC32B-58-503	
			2 OF 2	DATE 14-Nov.-2011
				REV. 3

CONTENTS

<u>ITEM</u>	<u>EQUIPMENT NO.</u>	<u>SHEET NO.</u>	<u>REV. NO.</u>	<u>REV. DATE</u>
1.	58-D-03	1 THRU 2 OF 2	3	14-Nov.-2011

ابن رشيد
ibn rushd
FLUOR

HORIZONTAL VESSEL DATA SHEET


Contract: 10E0541A01
Equip. No.: 58-D-03
Revision : 3 Date : 14-Nov.-2011
Unit : 58 - Benzene Toulene Fract
P.O. No.:
Document No. DS-58-DA-503
Sheet 1 of 2



Client: Arabian Industrial Fibers Company (Ibn Rushd) Plant: Benzene Toulene Fract
Service: TX Oxygen Stripper Receiver Site: Yanbu, Kingdom of Saudi Arabia

DESIGN SKETCH

VESSEL DIMENSIONS: ID: 1300 T/T: 2600

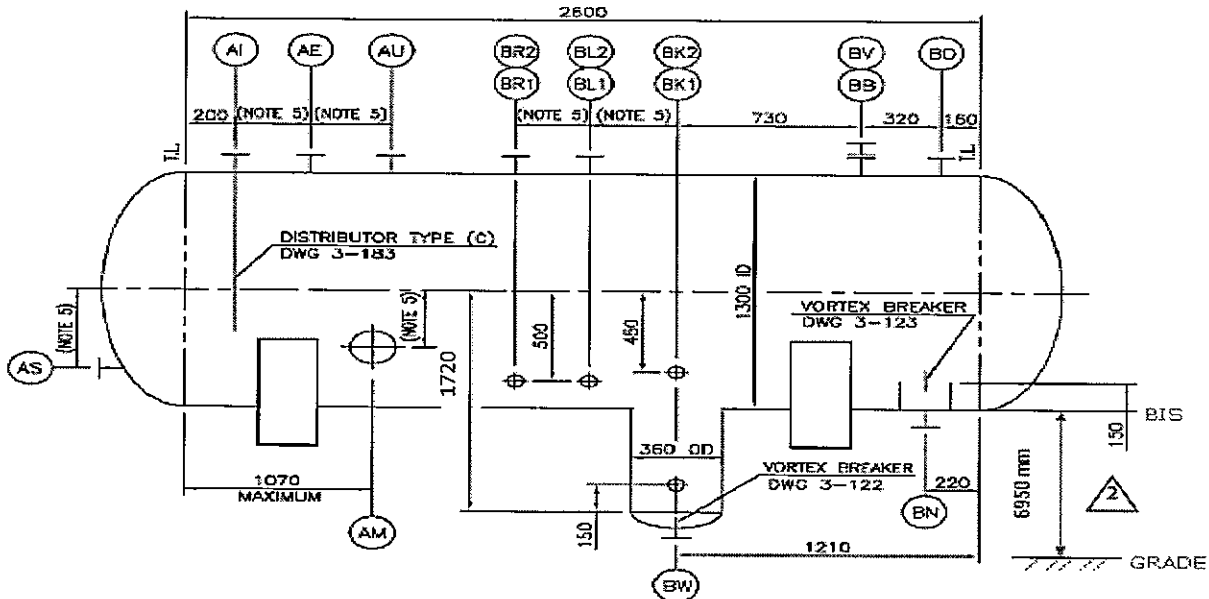

DESIGN CONDITIONS

Pressure:	7.0	bar(g)
At:	120	°C
Vacuum:	FV	bar(g)
At:	120	°C
Min. Design Metal Temp:	6	°C
At:	MAWP	bar(g)
Liquid Level:	(Note 4) (Note 14)	mm
Specific Gravity of Liquid:	0.834	

OPERATING CONDITIONS

Pressure + :	3.1 (Note 5)	bar(g)
At:	52	°C
Vacuum - :		bar(g)
At:		°C
Low Temperature:		°C
At:		bar(g)
Hydrogen Partial Pressure:		bar(g)
At:		°C

INSULATION

Type:	n/a
Req'd Thickness:	n/a
Fireproofing:	n/a

CONSTRUCTION

MATERIALS		CORROSION ALLOWANCE	
Shell:	SA-516-70N(K.C.S)	(Note 7)	mm
Internals:	C.S.	n/a	mm
Lining/Cladding:	n/a	n/a	mm
Head:	SA-516-70N(K.C.S)	(Note 7)	mm
Boot:	SA-516-70N(K.C.S)	(Note 7)	mm

INTERNALS

DESCRIPTION	BULK DENSITY kg/m³	LIQUID HOLDUP Vol. %	ΔP bar
Packing/Tray:	n/a	n/a	n/a
Catalyst:	n/a	n/a	n/a
Mist Eliminator:	n/a	n/a	n/a

NOTES & SPECIAL CONDITIONS

Stress Relieve (Process Reason Only):	No
Vessel In Special Service:	
Steamout Required:	Yes

REV

0

[illegible]



ARABIAN INDUSTRIAL FIBERS COMPANY

IR-II AROMATICS PROJECT

PROJECT NO. 10E0541A01

DOCUMENT TITLE:

RAFFINATE COLUMN RECEIVER DATA SHEET

DOCUMENT NO:

DS-53-DA-505

						ابن رشيد ibn rushd	ARABIAN INDUSTRIAL FIBERS COMPANY YANBU, KINGDOM OF SAUDI ARABIA	 CTCI CORPORATION
						CERTIFIED		
2	Revised As Marked	KCK	CBC	YSL	11-Aug-11	PROJ.		
1	Issued For Design	KCK	CBC	YSL	26-Apr-11	MGR _____ DATE _____		
0	Issue For Approval	KCK	CMW	YSL	9-Mar-11	CLIENT _____ DATE _____		
REV	DESCRIPTION	BY	CHK.	APPR.	DATE	PAGE 1 OF 2		XC32B-53-505

CONTENTS

<u>ITEM</u>	<u>EQUIPMENT NO.</u>	<u>SHEET NO.</u>	<u>REV. NO.</u>	<u>REV. DATE</u>
1.	53-D-05	1 THRU 2 OF 2	2	11-Aug.-2011

Attachment total 1 page.

HORIZONTAL VESSEL

Contract:	10E0541A01	
Equip. No.:	53-D-05	
Revision :	2	Date : 11-Aug.-2011
Unit :	53 - Parex	
P.O. No.:		
Document No.	DS-53-DA-505	
Sheet	1 of 2	

سابقہ
Sahib

CTCI CORPORATION


REV

Client: Arabian Industrial Fibers Company
Service: Raffinate Column Receiver

Plant:	Parex
Site:	Yanbu, Kingdom of Saudi Arabia

DESIGN SKETCH

VESSEL DIMENSIONS: ID: 3505 T/T: 11100

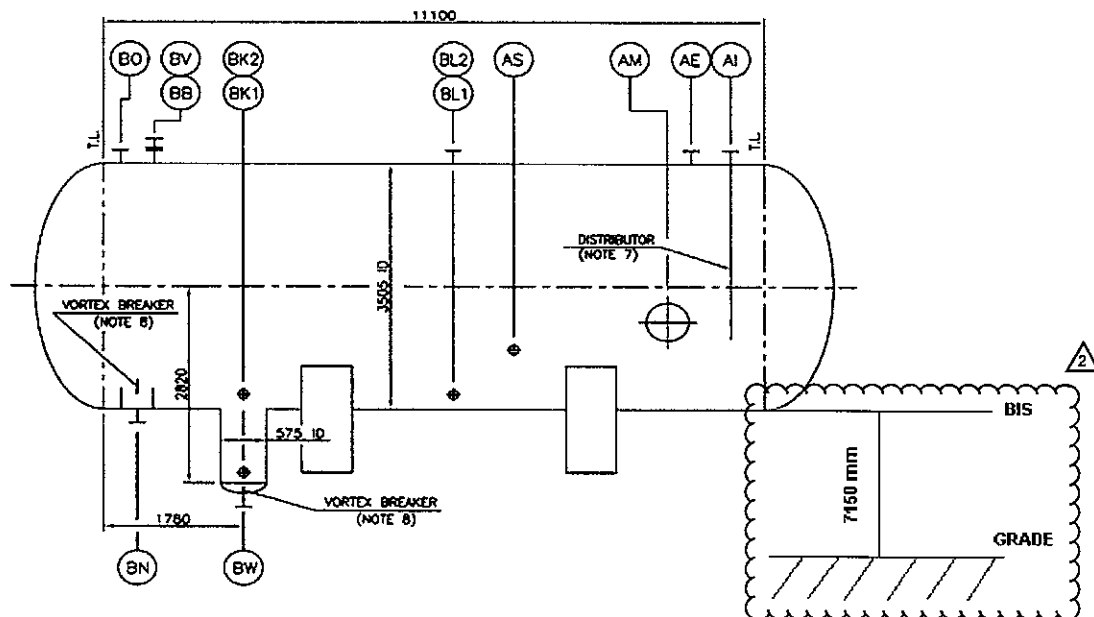

DESIGN CONDITIONS			CONSTRUCTION				
Pressure:	4.5	bar(g)	MATERIALS		CORROSION ALLOWANCE		
At:	215	°C	Shell:	SA-516-70		3	mm
Vacuum:	FV	bar(g)	Internals:	C.S.		n/a	mm
At:	60	°C	Lining/Cladding:	n/a		n/a	mm
Min. Design Metal Temp:	9 (Note 11)	°C	Head	SA-516-70		3	mm
At:	MAWP	bar(g)	Boot	SA-516-70		6	mm
Maximum Liquid Level:	(Note 4, 9)	mm	INTERNALS				
Specific Gravity of Liquid:	0.826		DESCRIPTION	BULK DENSITY kg/m³	LIQUID HOLDUP Vol. %	ΔP bar	
OPERATING CONDITIONS			Packing/Tray:	n/a	n/a	n/a	
Pressure + :	0.07	bar(g)	Catalyst:	n/a	n/a	n/a	
At:	66	°C	Mist Eliminator:	n/a	n/a	n/a	
Vacuum - :		bar(g)					
At:		°C	NOTES & SPECIAL CONDITIONS				
Low Temperature:		°C	Stress Relieve (Process Reason Only):	No			
At:		bar(g)	Vessel In Special Service:				
Hydrogen Partial Pressure:		bar(a)	Steamout Required:	Yes (Design for FV)			
At:		°C					
INSULATION							
Type:	Hot						
Req'd Thickness:	40 mm						
Fireproofing:	Yes (75 mm)						

Notice: This document has not been published and is the sole property of the Fluor Corporation, and is lent to the borrower for his confidential use only, and in consideration of the loan of this drawing, the borrower promises and agrees to return it upon request and agrees that it shall not be reproduced, copied, lent or otherwise disposed of directly or indirectly, nor used for any purpose other than that for which it is specifically furnished.

ابن رشيد ibn rushd FLUOR		HORIZONTAL VESSEL DATA SHEET		Contract: 10E0541A01 Equip. No.: 53-D-05 Revision : 2 Date : 11-Aug.-2011 Unit : 53 - Parex P.O. No. : Document No. DS-53-DA-505 Sheet : 2 of 2		سابك sabik  CTCI CORPORATION	
NOZZLE SCHEDULE							REV
1	2	3	4	5	6	7	8
	TAG	QTY	SIZE in	PRESSURE RATING	DESCRIPTION		
3	AE	1	3	150# RFWN	EQUALIZING		
4	AI	1	12	150# RFWN	INLET W/ INLET PIPE		
5	AM	1	20	150# RFWN	MANWAY W/ DAVIT		
6	AS	1	2	150# RFWN	STEAMOUT (Note 10)	0	
7	BB	1	8	150# RFWN	VENTILATION W/ BLIND		
8	BK1	1	1-1/2	150# RFLWN	LEVEL		
9	BK2	1	1-1/2	150# RFLWN	LEVEL		
10	BL1	1	2	300# RFWN	LEVEL - LLS		
11	BL2	1	2	300# RFWN	LEVEL - LLS		
12	BN	1	12	150# RFWN	OUTLET W/ VORTEX BREAKER		
13	BO	1	4	150# RFWN	VAPOR OUTLET		
14	BV	1	2	150# RFWN	VENT		
15	BW	1	2	150# RFWN	OUTLET W/ VORTEX BREAKER		
16							
17							
18							
19							
20							
21	NOTES:						
26	1) This vessel tag number 53-D-05 is an existing vessel in the same service. The only change is higher design pressure. Existing design condition: 3.9 bar(g) @ 215 °C, new design condition: 4.5 bar(g) @ 215 °C.						0
27	2) Based on vessel fabricator's calculations and MAWP (MAWP 6.5 bar(g) hot and corroded), the vessel is satisfactory for the higher design pressure. CTCI to verify the available thickness after evaluating maintenance records and performing UT testing and confirm. CTCI to vessel is satisfactory provide necessary ASME code documentation for the repair "R" stamp and new nameplate.						0
28	3) Dimensions are in millimeter unless otherwise noted.						0
29	4) Vessel shall have a Normal Liquid Level (NLL) hold-up to vessel centerline. Liquid level: HLL = 2299 mm, LLL = 1201 mm.						0
30	5) Vessel heads and boot are 2:1 Elliptical.						0
31	6) For nozzle elevation and orientation refer to vendor certified drawing no. D96-4754101 (Sheet 1 of 8) Rev.4 dated 6/10/97.						
32	7) For details of distributor refer to vendor certified drawing no. D96-4754101 (Sheet 4 of 8) Rev.2 dated 4/2/97.						
33	8) For details of vortex breaker refer to vendor certified drawing no. D96-4754101 (Sheet 2 of 8) Rev.3 dated 6/10/97.						
34	9) Boot interface liquid level: HLL = 997 mm, LLL = 783 mm.						0
35	10) Steamout at 150 (232 max.) °C and 3.5 (4.1 max.) bar (g).						0
36	11) The Min. Design Ambient Temperature should be 6 °C.						0
37							
38							
53	WEIGHTS ARE BASED ON VENDOR CERTIFIED DRAWING No. D96-4754101						
54	(SHT. 3 of 8) REV.4 DATED 4/2/97						
55	EMPTY					28818	
56	OPERATING					79618	
57	FULL OF WATER					151363	
58	THICKNESS ARE BASED ON VENDOR CERTIFIED DRAWING No. D96-4754101						
59	(SHT. 1 of 8) REV.4 DATED 6/10/97						
60	SHELL					13	
61	HEADS					13	

Notice: This document has not been published and is the sole property of the Fluor Corporation, and is lent to the borrower for his confidential use only; and in consideration of the loan of this drawing, the borrower promises and agrees to return it upon request and agrees that it shall not be reproduced, copied, lent or otherwise disposed of directly or indirectly, nor used for any purpose other than that for which it is specifically furnished.



CLIENT : IBN RUSHD
PROJECT PTA & AROMATICS -
TITLE : AROMATICS
JOB NO. : 51046
DOC. NO. : DS-53-D-005(1/1)

REVISIONS			
MARK	DATE	BY	APP'D
APRD	7/1/8		
CHKD			
MADE			
DATE	Mar. 03 '96	June 29 '96	Feb 03 '97

FOR RECORD

uop 25 East Algonquin Road • PO Box 5017 • Des Plaines, Illinois 60017-5017 • U.S.A.	PROJECT SPECIFICATION 560691 - 301 - 0 SHEET 9			
	REV	DATE	BY	APP'D
	0	6-16-93		

VESSELS

SERVICE	RAFFINATE COLUMN RECEIVER	ITEM NO	DS-53-D-005
---------	---------------------------	---------	-------------

Design	INT 3.9 BAR (g)	6215°C
Conditions	EXT FULL VACUUM	60°C
at Top	Metal Temperature (Min)	9°C
Operating		60°C
Conditions		°C

Radiograph	MR
Postweld Heat Treat	MR
Joint Efficiency	MR X
Material Specifications	
Heads	SAS16-70
Shell	SAS16-70
Drop Leg	SAS16-70
D.L. Head	SAS16-70

Shell	Thickness	Corrosion
	Required by	Allowance
	Code-mm.	mm. (Min)
VESSEL	3	
DROP LEG	6	


Heads	
VESSEL	3
DROP LEG	6

Vessel Heads	
Vessel	2:1 ELLIPTICAL
Drop Leg	2:1 ELLIPTICAL
Accessories Applied by Fabricator	
Ladder & Platform Clips	AS REQUIRED (*)
Insulation Clips & Rings	YES
Vessel Support	YES

Nozzles and Manways			
Mark	No	Size Inches	Service
AE	1	3	EQUALIZING
AI	1	12	INLET
AM	1	2.0	MANWAY
AS	1	2	STEAMOUT
BB	1	8	VENTILATION
BK	2	1 1/2	LEVEL
BL	2	2	LEVEL-LLS (2)
BN	1	12	OUTLET
BO	1	4	VAPOR OUTLET
BV	1	2	VENT
BW	1	2	OUTLET

Class - ANSI CL150
(2) ANSI CL300
Facing - RAISED FACE

Normal Liquid Level = VESSEL CENTERLINE
Specific Gravity = 0.832

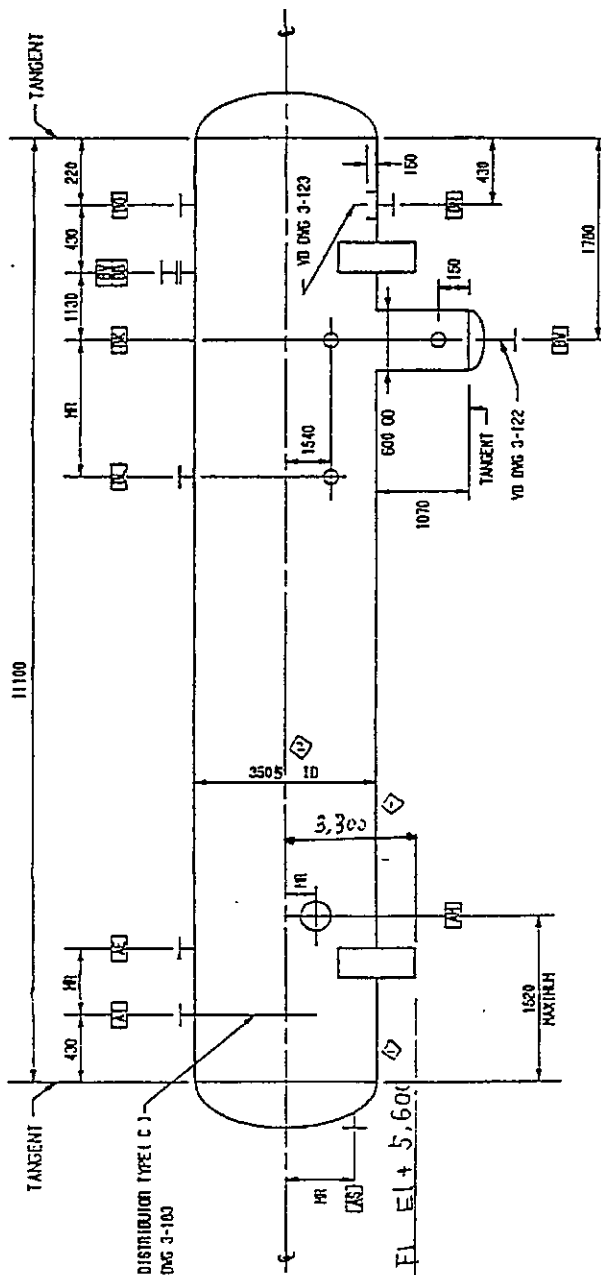

NOTE - These data are confidential and the property of UOP and shall not be disclosed to others or reproduced in any manner or used for any purpose whatsoever except by written permission or as provided in a signed agreement with UOP relating to such data.

Drawings Referred to in this Specification

3-122-0	3-123-0	3-123-0	3-317-1
---------	---------	---------	---------

509220

20



ARABIAN INDUSTRIAL FIBERS COMPANY

IR-II AROMATICS PROJECT

PROJECT NO. 10E0541A01

DOCUMENT TITLE:

EXTRACT COLUMN RECEIVER DATA SHEET

DOCUMENT NO:

DS-53-DA-508

						ابن رشد ibn rushd	ARABIAN INDUSTRIAL FIBERS COMPANY YANBU, KINGDOM OF SAUDI ARABIA	CTCI CORPORATION
						CERTIFIED		
2	Revised As Marked	KCK	CBC	YSL	11-Aug-11	PROJ.		
1	Issued For Design	KCK	CBC	YSL	28-Apr-11	MGR _____ DATE _____		
0	Issue For Approval	KCK	CBC	YSL	9-Mar-11	CLIENT _____ DATE _____		
REV	DESCRIPTION	BY	CHK.	APPR.	DATE	PAGE 1 OF 2		XC32B-53-508

CONTENTS

<u>ITEM</u>	<u>EQUIPMENT NO.</u>	<u>SHEET NO.</u>	<u>REV. NO.</u>	<u>REV. DATE</u>
1.	53-D-08	1 THRU 2 OF 2	2	11-Aug.-2011

Attachment total 1 page.

ابن رشيد ibn rushd FLUOR.	HORIZONTAL VESSEL DATA SHEET	Contract: 10E0541A01 Equip. No.: 53-D-08 Revision: 2 Date: 11-Aug.-2011 Unit: 53 - Parex P.O. No.: Document No. DS-53-DA-508 Sheet 1 of 2	سابك sabik CTCI CORPORATION
Client: Arabian Industrial Fibers Company Service: Extract Column Receiver		Plant: Parex Site: Yanbu, Kingdom of Saudi Arabia	
DESIGN SKETCH			
VESSEL DIMENSIONS: ID: 2300 T/T: 7200 			
DESIGN CONDITIONS		CONSTRUCTION	
Pressure:	4.5 bar(g)	CORROSION ALLOWANCE	
At:	215 °C	Shell:	SA-516-70 3 mm
Vacuum:	FV bar(g)	Internals:	C.S. n/a mm
At:	121 °C	Lining/Cladding:	n/a mm
Min. Design Metal Temp:	9 (Note 10) °C	Head:	SA-516-70 3 mm
At:	MAWP bar(g)		
Maximum Liquid Level:	(Note 4) mm	INTERALS	
Specific Gravity of Liquid:	0.770		
OPERATING CONDITIONS			
Pressure +:	0.07 bar(g)	DESCRIPTION	BULK DENSITY kg/m³
At:	121 °C	Packing/Tray:	n/a
Vacuum -:	bar(g)	Catalyst:	n/a
At:	°C	Mist Eliminator:	n/a
Low Temperature:	°C		
At:	bar(g)	NOTES & SPECIAL CONDITIONS	
Hydrogen Partial Pressure:	bar(a)	Stress Relieve (Process Reason Only): No	
At:	°C	Vessel In Special Service:	
		Steamout Required: Yes (Design for FV)	
INSULATION			
Type:	Hot		
Req'd Thickness:	40 mm		
Fireproofing:	Yes (75 mm)		

Notice: This document has not been published and is the sole property of the Fluor Corporation, and is lent to the borrower for his confidential use only; and in consideration of the loan of this drawing, the borrower promises and agrees to return it upon request and agrees that it shall not be reproduced, copied, lent or otherwise disposed of directly or indirectly, nor used for any purpose other than that for which it is specifically furnished.

ابن رشيد ibn rushd FLUOR		HORIZONTAL VESSEL DATA SHEET		Contract: 10E0541A01 Equip. No.: 53-D-08 Revision : 2 Date : 11-Aug.-2011 Unit : 53 - Parex P.O. No. : Document No. DS-53-DA-508 Sheet : 2 of 2		سابك sabik  CTCI CORPORATION		REV
NOZZLE SCHEDULE								
	TAG	QTY	SIZE in	PRESSURE RATING	DESCRIPTION			
3	AE	1	3	150# RFWN	EQUALIZING			
4	AI	1	10	150# RFWN	INLET W/ INLET PIPE			
5	AM	1	20	150# RFWN	MANWAY W/ DAVIT			
6	AS	1	2	150# RFWN	STEAMOUT (Note 9)		0	
7	BB	1	6	150# RFWN	VENTILATION W/ BLIND			
8	BD	1	2	150# RFWN	DRAIN			
9	BL1	1	2	300# RFWN	LEVEL - LLS			
10	BL2	1	2	300# RFWN	LEVEL - LLS			
11	BN	1	10	150# RFWN	OUTLET W/ VORTEX BREAKER			
12	BO	1	3	150# RFWN	OUTLET			
13	BV	1	2	150# RFWN	VENT			
14								
15								
16								
17								
18								
19								
20								
21								
22								
23								
24								
25								
26							0	
27							0	
28								
29							0	
30							0	
31								
32							0	
33								
34								
35								
36								
37							0	
38							0	
39								
40								
NOTES:

1) This vessel tag number 53-D-08 is an existing vessel in the same service. The only change is higher design pressure. Existing design condition: 3.9 bar(g) @ 215 °C, new design condition: 4.5 bar(g) @ 215 °C.

2) Based on vessel fabricator's calculations and MAWP (MAWP 6.5 bar(g) hot and corroded), the vessel is satisfactory for the higher design pressure. CTCI to verify the available thickness after evaluating maintenance records and performing UT testing and confirm. CTCI to vessel is satisfactory provide necessary ASME code documentation for the repair "R" stamp and new nameplate.

3) Dimensions are in millimeter unless otherwise noted.

4) Vessel shall have a Normal Liquid Level (NLL) hold-up to vessel centerline. Liquid Level: HLL = 1516 mm, LLL = 784 mm.

5) Vessel heads are 2:1 Elliptical

6) For nozzle elevation and orientation refer to vendor certified drawing no. DA-7034-26-001 Rev.3 dated 7/7/97.

7) For details of distributor refer to vendor certified drawing no. DA-7034-26-001 Rev.3 dated 7/7/97.

8) For details of vortex breaker refer to vendor certified drawing no. DA-7034-26-001 Rev.3 dated 7/7/97.

9) Steamout at 150 (232 max.) °C and 3.5 (4.1 max.) bar (g).

10) The Min. Design Ambient Temperature should be 6 °C.

WEIGHTS ARE BASED ON VENDOR CERTIFIED DRAWING No. DA-7034-26-001	
REV 3 DATED 7/7/97	(kg)
EMPTY	8500
OPERATING	23100
FULL OF WATER	43500
THICKNESS ARE BASED ON VENDOR CERTIFIED DRAWING No. DA-7034-26-001	
REV 3 DATED 7/7/97	(mm)
SHELL	12
HEADS	15

Notice: This document has not been published and is the sole property of the Fluor Corporation, and is lent to the borrower for his confidential use only; and in consideration of the loan of this drawing, the borrower promises and agrees to return it upon request and agrees that it shall not be reproduced, copied, lent or otherwise disposed of directly or indirectly, nor used for any purpose other than that for which it is specifically furnished.




FOR RECORD

CLIENT : IBN RUSHD
PROJECT : PTA & AROMATICS -
TITLE : AROMATICS
JOB NO. : 51046
DOC. NO. : D5-93-D-008 (Y1)

REVISIONS			
MARK			
APRD	<i>[Signature]</i>	<i>[Signature]</i>	<i>[Signature]</i>
CHKD	<i>[Signature]</i>	<i>[Signature]</i>	<i>[Signature]</i>
MADE	<i>[Signature]</i>	<i>[Signature]</i>	<i>[Signature]</i>
DATE	<i>[Signature]</i>	<i>[Signature]</i>	<i>[Signature]</i>

NOTE - These data are confidential and the property of UOP and shall not be disclosed to others or reproduced in any manner or used for any purpose whatsoever except by written permission or as provided in a signed agreement with UOP relating to such data.

UOP 25 East Algonquin Road • PO Box 5017 • Des Plaines, Illinois 60017-5017 • U.S.A.		PROJECT SPECIFICATION 560591 - 301 - 0 SHEET 12	
VESSELS		REV DATE BY APP'D REV DATE BY APP'D 0 6-6-95	
SERVICE EXTRACT COLUMN RECEIVER		ITEM NO <u>53-D-08</u>	
Design INT 3.9 BAR (g) 8215 °C (*) BY CONTRACTOR Conditions EXT FULL VACUUM 8121 °C at Top Metal Temperature (Min) 9 °C Operating Conditions 121 °C Radiograph MR Postweld Heat Treat MR Joint Efficiency MR 2			
Material Specifications			
Heads SA516-70 Shell SA516-70			
Thickness Corrosion Required by Allowance Code-mm. mm. (Min) 3			
Heads 3			
Vessel Heads 2:1 ELLIPTICAL			
Drop Leg			
Accessories Applied by Fabricator			
Ladder & Platform Clips AS REQUIRED (*)			
Insulation Clips & Rings YES			
Vessel Support YES			
Nozzles and Manways			
Mark	No	Size Inches	Service
AE	1	3	EQUALIZING
AI	1	10	INLET
AM	1	20	MANWAY
AS	1	2	STEAMOUT
BS	1	6	VENTILATION
BD	1	2	DRAIN
BL	2	2	LEVEL-LLS (2)
BN	1	10	OUTLET
BD	1	3	OUTLET
BV	1	2	VENT
Class - ANSI CL150 (2) ANSI CL300 Facing - RAISED FACE Normal Liquid Level = VESSEL CENTERLINE Specific Gravity = 0.769			

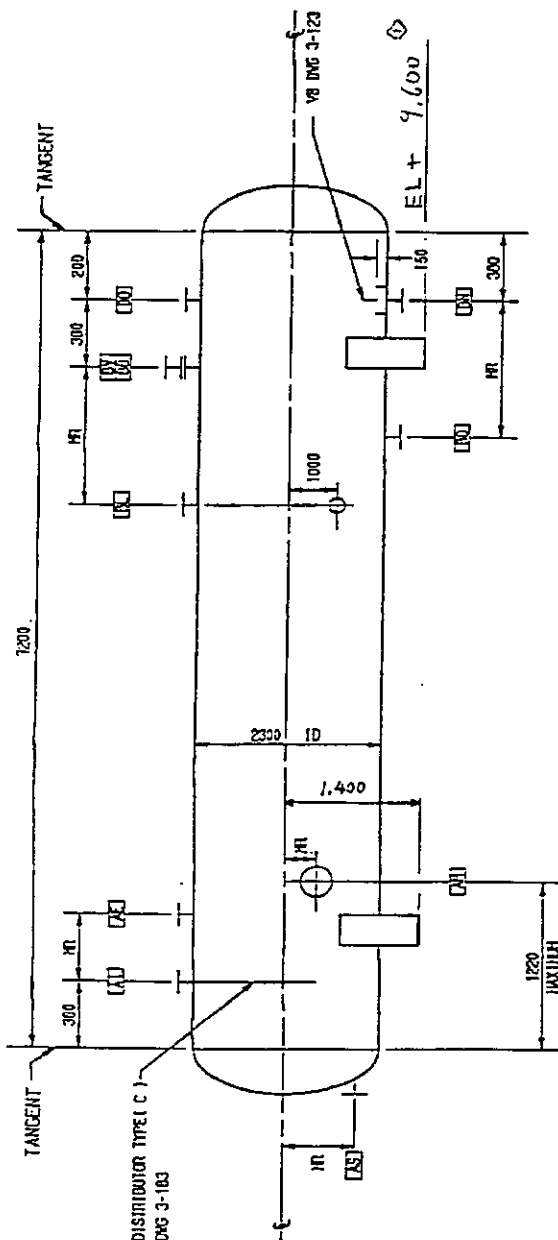

Drawings Referred to in this Specification

3-123-0 3-163-0 3-317-1



ARABIAN INDUSTRIAL FIBERS COMPANY

IR-II AROMATICS PROJECT

PROJECT NO. 10E0541A01

DOCUMENT TITLE:

FINISHING COLUMN RECEIVER DATA SHEET

DOCUMENT NO:

DS-53-DA-510

						ابن رشد ibn rushd	ARABIAN INDUSTRIAL FIBERS COMPANY YANBU, KINGDOM OF SAUDI ARABIA	 CTCI CORPORATION
						CERTIFIED		
2	Revised As Marked	KCK	CBC	YSL	11-Aug-11	PROJ.		
1	Issued For Design	KCK	CBC	YSL	26-Apr-11	MGR	DATE	
0	Issue For Approval	KCK	CBC	YSL	9-Mar-11	CLIENT	DATE	
REV	DESCRIPTION	BY	CHK.	APPR.	DATE	PAGE 1 OF 2		XC32B-53-510

FINISHING COLUMN RECEIVER
 DATA SHEET

XC32B-53-510

2 OF 2

DATE
 11-Aug.-2011
 REV.
 2

CONTENTS

<u>ITEM</u>	<u>EQUIPMENT NO.</u>	<u>SHEET NO.</u>	<u>REV. NO.</u>	<u>REV. DATE</u>
1.	53-D-10	1 THRU 2 OF 2	2	11-Aug.-2011

Attachment total 1 page.

ابن رشيد
ibn rushd
FLUOR.


HORIZONTAL VESSEL

Contract: 10E0541A01
Equip. No.: 53-D-10
Revision: 2 Date: 11-Aug.-2011
Unit: 53 - Parex
P.O. No.:
Document No. DS-53-DA-510
Sheet 1 of 2

سابك
sabic

Client: Arabian Industrial Fibers Company Plant: Parex
Service: Finishing Column Receiver Site: Yanbu, Kingdom of Saudi Arabia

DESIGN SKETCH

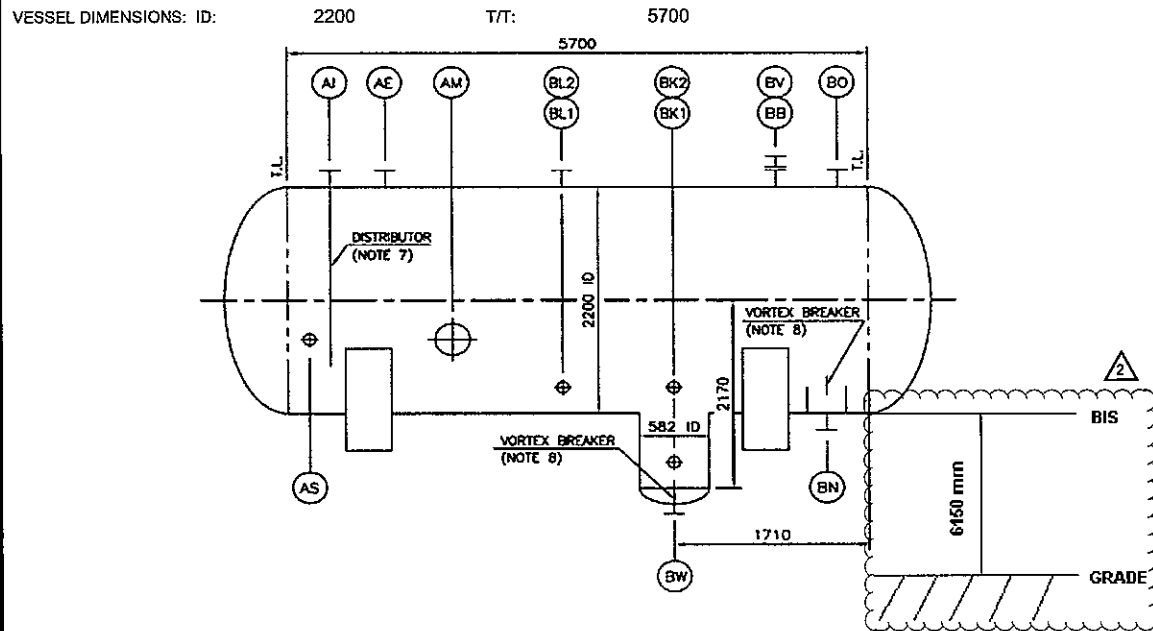

DESIGN CONDITIONS			CONSTRUCTION		
Pressure:	4.5	bar(g)	Shell:	SA-516-70	CORROSION ALLOWANCE
At:	121	°C	Internals:	C.S.	3 mm
Vacuum:	FV	bar(g)	Lining/Cladding:	n/a	n/a mm
At:	66	°C	Head:	SA-516-70	3 mm
Min. Design Metal Temp:	9 (Note 11)	°C	Boot:	SA-516-70	6 mm
At:	MAWP	bar(g)			
Maximum Liquid Level:	(Note 4, 9)	mm			
Specific Gravity of Liquid:	0.812				
OPERATING CONDITIONS			INTERNALS		
Pressure +:	0.07	bar(g)	DESCRIPTION	BULK DENSITY kg/m³	LIQUID HOLDUP Vol. %
At:	66	°C	Packing/Tray:	n/a	n/a
Vacuum -:		bar(g)	Catalyst:	n/a	n/a
At:		°C	Mist Eliminator:	n/a	n/a
Low Temperature:		°C			
At:		bar(g)	NOTES & SPECIAL CONDITIONS		
Hydrogen Partial Pressure:		bar(a)	Stress Relieve (Process Reason Only):	Yes (Boot Head only)	
At:		°C	Vessel In Special Service:		
			Steamout Required:	Yes (Design for FV)	
INSULATION					
Type:	Hot				
Req'd Thickness:	40 mm				
Fireproofing:	Yes (75 mm)				

Notice: This document has not been published and is the sole property of the Fluor Corporation, and is lent to the borrower for his confidential use only; and in consideration of the loan of this drawing, the borrower promises and agrees to return it upon request and agrees that it shall not be reproduced, copied, lent or otherwise disposed of directly or indirectly, nor used for any purpose other than that for which it is specifically furnished.

ابن رشيد ibn rushd FLUOR		HORIZONTAL VESSEL DATA SHEET		Contract: 10E0541A01 Equip. No.: 53-D-10 Revision : 2 Date : 11-Aug.-2011 Unit : 53 - Parex P.O. No. : Document No. DS-53-DA-510 Sheet : 2 of 2		سابك sabik  CTCI CORPORATION		
NOZZLE SCHEDULE							REV	
	TAG	QTY	SIZE in	PRESSURE RATING	DESCRIPTION			
1	AE	1	2	150# RFWN	EQUALIZING			
2	AI	1	8	150# RFWN	INLET W/ INTERNAL PIPE			
3	AM	1	20	150# RFWN	MANWAY W/ DAVIT			
4	AS	1	2	150# RFWN	STEAMOUT (Note 10)		0	
5	BB	1	6	150# RFWN	VENTILATION W/ BLIND			
6	BK1	1	1-1/2	150# RFLWN	LEVEL			
7	BK2	1	1-1/2	150# RFLWN	LEVEL			
8	BL1	1	2	300# RFWN	LEVEL - LLS			
9	BL2	1	2	300# RFWN	LEVEL - LLS			
10	BN	1	8	150# RFWN	OUTLET W/ VORTEX BREAKER			
11	BO	1	3	150# RFWN	OUTLET			
12	BV	1	2	150# RFWN	VENT			
13	BW	1	2	150# RFWN	OUTLET W/ VORTEX BREAKER			
14								
15								
16								
17								
18								
19								
20								
21	NOTES: 1) This vessel tag number 53-D-10 is an existing vessel in the same service. The only change is higher design pressure. Existing design condition: 3.9 bar(g) @ 121 °C, new design condition: 4.5 bar(g) @ 121 °C. 2) Based on vessel fabricator's calculations and MAWP (MAWP 6.37 bar(g) hot and corroded), the vessel is satisfactory for the higher design pressure. CTCI to verify the available thickness after evaluating maintenance records and performing UT testing and confirm. CTCI to vessel is satisfactory provide necessary ASME code documentation for the repair "R" stamp and new nameplate. 3) Dimensions are in millimeter unless otherwise noted. 4) Vessel shall have a Normal Liquid Level (NLL) hold-up to vessel centerline. Liquid level: HLL = 1466 mm, LLL = 734 mm. 5) Vessel heads and boot are 2:1 Elliptical. 6) For nozzle elevation and orientation refer to vendor certified drawing no. DA-7034-28-001 Rev.3 dated 6/30/97. 7) For details of distributor refer to vendor certified drawing no. DA-7034-28-001 Rev.3 dated 6/30/97. 8) For details of vortex breaker refer to vendor certified drawing no. DA-7034-28-001 Rev.3 dated 6/30/97. 9) Boot interface liquid level: HLL = 997 mm, LLL = 783 mm. 10) Steamout at 150 (232 max.) °C and 3.5 (4.1 max.) bar (g). 11) The Min. Design Ambient Temperature should be 6 °C.						0	
22								0
23								0
24								0
25								0
26								0
27								0
28								0
29								0
30								0
31								0
32								
33								
Notice: This document has not been published and is the sole property of the Fluor Corporation, and is lent to the borrower for his confidential use only; and in consideration of the loan of this drawing, the borrower promises and agrees to return it upon request and agrees that it shall not be reproduced, copied, lent or otherwise disposed of directly or indirectly, nor used for any purpose other than that for which it is specifically furnished.



CLIENT : IBN RUSHD
PROJECT : PTA & AROMATICS -
TITLE : AROMATICS
JOB NO. : 51046
DOC. NO. : DS-53-D-010 (1/1)

		REVISIONS			
MARK		①	②	③	④
APRD	<i>gag</i>	<i>gag</i>	<i>7/1/86</i>	<i>7/1/86</i>	<i>7/1/86</i>
CHKD	<i>W. H. H. H.</i>	<i>W. H. H. H.</i>	<i>W. H. H. H.</i>	<i>W. H. H. H.</i>	<i>W. H. H. H.</i>
MADE	<i>W. H. H. H.</i>	<i>W. H. H. H.</i>	<i>W. H. H. H.</i>	<i>W. H. H. H.</i>	<i>W. H. H. H.</i>
DATE	<i>Mar. 08 '86</i>	<i>APR 07/86</i>	<i>Mar. 24/86</i>	<i>Jun. 03/86</i>	<i>Feb. 03/87</i>

25 East Algonquin Road - PO Box 5017 - Des Plaines, Illinois 60017-5017 - U.S.A.

VESSELS

PROJECT SPECIFICATION

560691 - 301 - 1 SHEET 14

REV	DATE	BY	APP'D	REV	DATE	BY	APP'D
0	6-16-95						
1	12-15-95	AEW	SMU				

NOTE - These data are confidential and the property of UOP and shall not be disclosed to others or reproduced in any manner or by any means whatsoever except by written permission or as provided in a signed agreement with UOP relating to such data.

SERVICE		FINISHING COLUMN RECEIVER	
Design	INT 3.9 BAR (g)	e121 °C	(F) BY CONTRACTOR

Design	INT 3.9 BAR (p)	e121 °C
Conditions	EXT FULL VACUUM	o 65 °C
at Top	Metal Temperature(Min)	9 °C
Operating		66 °C
Conditions		°C
Radiograph		MR
Postweld Heat Treat		MR
Joint Efficiency		MR %

Material Specifications	
Heads	SA516-70
Shell	SA516-70
Drop Leg	SA516-70
D.L. Head	SA516-70

Shell	Thickness Required by Code-mm.	Corrosion Allowance mm. (Min)
-------	--------------------------------------	-------------------------------------

VESSEL	3
DROP LEG	6

Head		
------	--	--

VESSEL		3
DEEP LEG		6

DRG: 220		
Vessel Heads		

Vessel	2:1 ELLIPTICAL
Drop leg	2:1 ELLIPTICAL

Accessories Applied by Fabricator	
Ladder & Platform Climb	AS REQUIRED (IF

Insulation Clips & Rings	YES
Vessel Support	YES

VESSEL SUPPORT		YES
Nozzles and Manways		
	Size	

Mark	No	Size Inches	Service
AE	1	2	EQUAL 12 IN

AL	1	2	ELGALIZING
AI	1	8	INLET
AM	1	20	MANUAY

AS	1	20	12	HARWAY
AS	1	2		STEAMOUT
BB	1	5		VENTILATION

ES	1	6	VENTILATION
2K	2	1 1/2	LEVEL
PL	3	3	LEVEL 11.5

SL	2	2	LEVEL-LLS	(2)
EN	1	8	OUTLET	
EN	1	2	OUTLET	

2U	1	3	OUTLET
2V	1	2	VENT
2W	1	2	OUTLET

SN	1	2	FOOTLET
	1	1	

1	1	1	1
1	1	1	1
1	1	1	1


[illegible]

Class - ANSI CL150
(2) ANSI CL200

(2) ANSI CL300
Facing - RAISED FACE


Normal Liquid Level = VESSEL CENTERLINE

Specific Gravity = 0.824

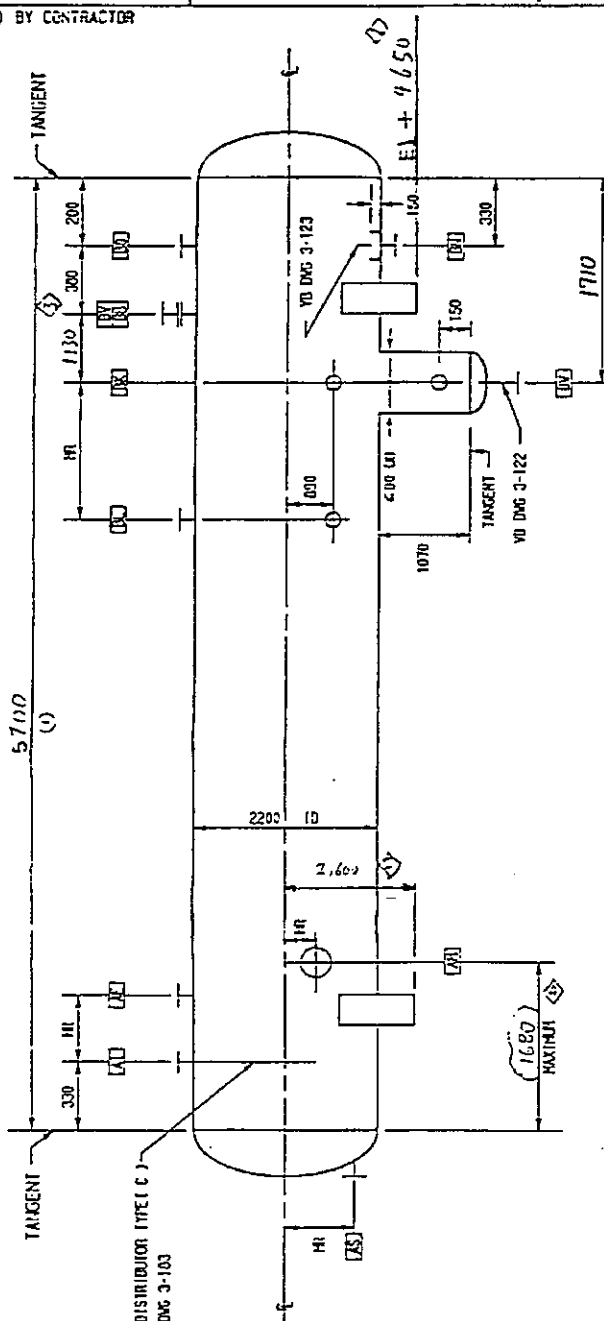

Drawings Referred to in this Specification

3-122-0	3-123-0	3-183-0	3-317-1			
---------	---------	---------	---------	--	--	--

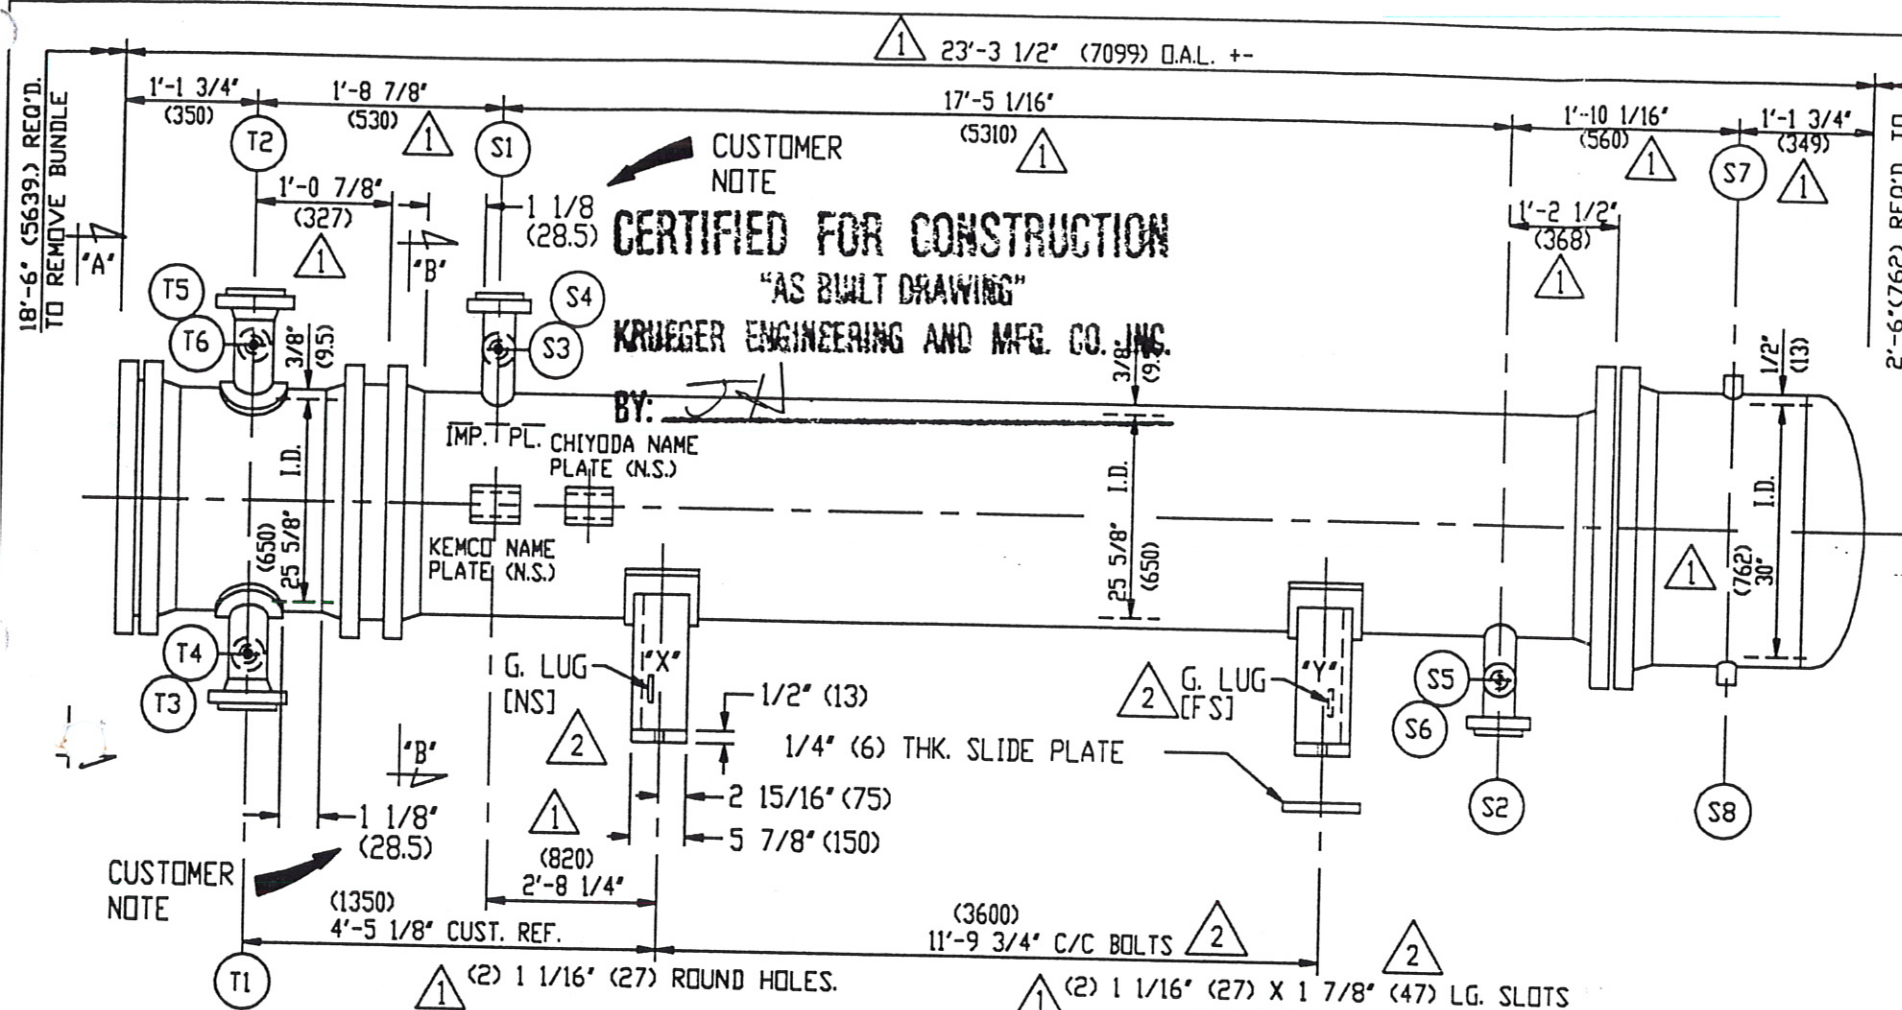

CUSTOMER NOTE

CERTIFIED FOR CONSTRUCTION

"AS BUILT DRAWING"

KRUEGER ENGINEERING AND MFG. CO. INC.

BY: *[Signature]*

IMP. PL. CHIYODA NAME PLATE (N.S.)

KEMCO NAME PLATE (N.S.)

G. LUG [NS] 1/2" (13)

1/4" (6) THK. SLIDE PLATE

2 15/16" (75)

5 7/8" (150)

(820)

2'-8 1/4"

(1350)

4'-5 1/8" CUST. REF.

(3600)

11'-9 3/4" C/C BOLTS

(2) 1 1/16" (27) ROUND HOLES.

(2) 1 1/16" (27) X 1 7/8" (47) LG. SLOTS

DESIGN DATA	SHELL	TUBE
DESIGN PRESSURE P.S.I.G.	188. (12.9 Bar g)	160. (11. Bar g)
VACUUM PRESSURE	F.V. @ 351°F (177°C)	
TEST PRESSURE P.S.I.G.	294. (20.27 Bar g)	282. (19.44 Bar g)
DESIGN TEMP. Deg.F.	419. (215.C)	248. (120.C)
MDMT Deg. F.	48. (9.C)	48. (9.C)
OPER. TEMP. IN/OUT °F(°C)	350/122 (177/50)	104/122 (40/50)
CORROSION ALLOWANCE	.1250" (3.2)	.1250" (3.2)
NUMBER OF PASSES	1.	2.
FLUID NAME	HYDROCARBON	COOLING WATER
RADIOGRAPHY	SPOT	SPOT
HEAT TREAT REQUIRED	NO	NO

ESTIMATED WEIGHTS, LBS.

DRY: 13000. (5897.Kg) BUNDLE: 6800. (3085.Kg) WET: 17500. (7938.Kg)

SPECIFICATIONS

ASME CODE SECT. VIII DIV.1, 1995 ED., 1995 ADD. (STAMP YES)

TEMA CLASS R [7 TH. ED.]

NATIONAL BOARD REGISTRATION REQUIRED

MATERIAL			
CHANNEL:	SA-516-70	CHAN. FLG.:	SA-105N
SHELL:	SA-516-70	SHELL:	SA-105N
TUBESHEETS:	SA-516-70N	BOLTING:	SA-193-B7/SA-194-2H
BAFFLES:	SA36orEQUAL	FLTG HEAD:	SA-105N/SA-516-70
TUBES:	SA-214		
(516.) 3/4" (19.05)	O.D. X .0830" (2.11)	(M.V.) X 20'-0" (6096)	LG.
TUBE PITCH	15/16" (23.8)		SURFACE 1937.SQ.FT. (180.M2)

GENERAL NOTES

ALL BOLT HOLES TO STRADDLE NATURAL CENTER LINES.

TUBE-TUBESHEET JOINT: ROLLED W/ GROOVES.

ALL MATERIALS COMPLY WITH UCS 66 (a),(c) & (d)

INSULATION THK: SHELL = 2" (50) PP; CHANNEL = NONE

CARBON CONTENT = 0.25% MAX.

TOLERANCE PER TEMA (7TH. ED.) & UOP STD. SPECS.

FIREPROOFING: 3" (75) REG. CONCRETE.

REF. DESIGN & DWG'S: DS-53-E-112; SK-53-E-012; SK-54-L-506-12.

ALL DIMENSIONS IN () ARE IN METRIC.

GASKETS: .175" (4.44) THK. 316SS SP. WD. GRAFOIL W/ 316SS INNER RING

RIB: 3/16" (4.76) THK. 316SS DBL. JKT'D. GRAFOIL

2 SETS OF SPARE GASKETS REQUIRED + 10% BOLTS/NUTS. (MIN. 2-SETS)

PAINT: SEE DWG 96-0730-2 FOR PAINT REQUIREMENTS

NOZZLE SCHEDULE				
MK	QT	DESCRIPTION	PROCESS	AUXILIARIES
S1	1	4" 150#RF LWN	INLET	
S2	1	4" 150#RF LWN	OUTLET	
T1	1	8" 150#RF WN	INLET	
T2	1	8" 150#RF WN	OUTLET	
S7	1	3/4" 6000#CPLG.	VENT	W/ PLUG
S8	1	3/4" 6000#CPLG.	DRAIN	W/ PLUG
S4	2	3/4" 6000#CPLG.	P.I.	W/ PLUG
S3	2	1" 150#RF LWN	T.I.	W/ BLIND
T4	2	3/4" 6000#CPLG.	P.I.	W/ PLUG
T3	2	1" 150#RF LWN	T.I.	W/ BLIND

	SHELL SIDE	TUBE SIDE
MAWP (HOT & CORRODED)	194 PSI (13.37 Bar g) LTD BY BODY FLG.	188 PSI (12.96 Bar g) LTD BY FLTG. HD. FLG.
MAP (NEW & COLD)	196 PSI (13.5 Bar g) LTD BY BODY FLG.	188 PSI (12.96 Bar g) LTD BY FLTG. HD. FLG.

CUST: CHIYODA CORPORATION
(ARABIAN INDUSTRIAL FIBERS CO.)




PROJECT: IBN - RUSHD AROMATICS PROJECT

P.O. NO: SAYPOH0027

ITEM NO: 53-E-12

SERVICE: DESORBENT SUMP TANK PUMPOUT COOLER









CHIYODA CORPORATION	
JOB NO. 51046	IBN RUSHD AROMATICS PROJECT
P.O. NO. SAYPOH0027	
REQ. NO. MR-50-E-004	
IDENT. NO. 53-E-12-DW-0001	
DATE	
DATE	
DATE	

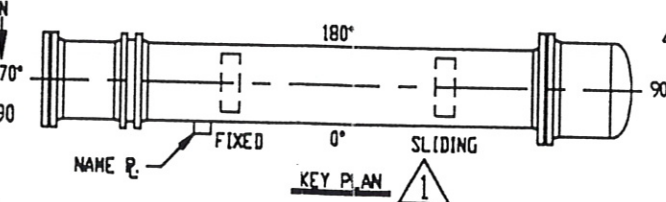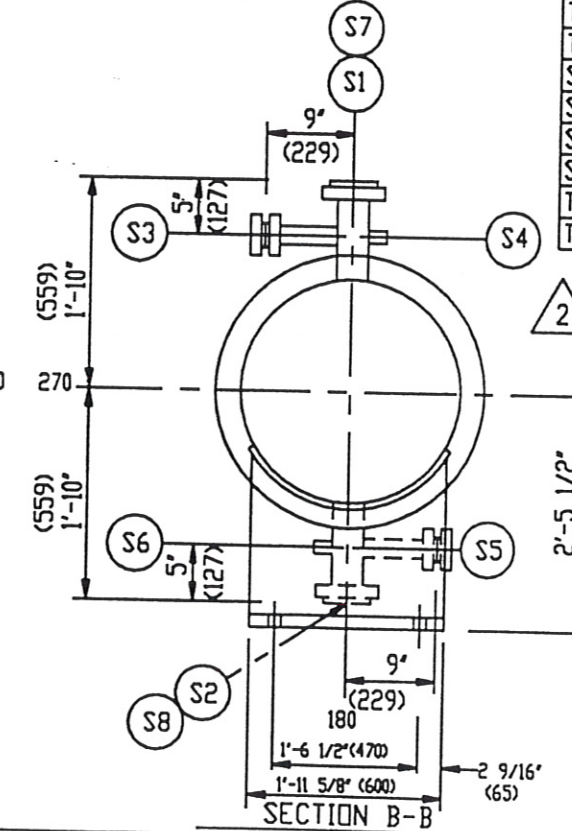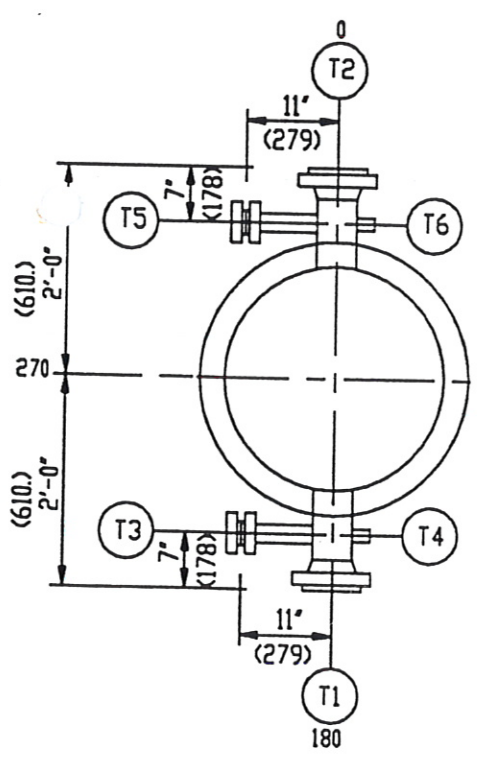

FOR RECORD

NO.	DATE	REVISIONS
2	1- 3-97	REV. PER CUSTOMER
1	3-23-96	REV. IN ACCORDANCE WITH CUSTOMER COMMENTS.

ASSEMBLY AND SPECIFICATIONS FOR			
ONE 25.625-240 (650-6096) A E S			
DWN. BY	mrh	KRUEGER ENGR. & MFG. CO. INC	HOUSTON, TEXAS
DATE	7- 3-96		
CKD. BY	JMH	DWG. NO.	96-0730-1
		REV.	2

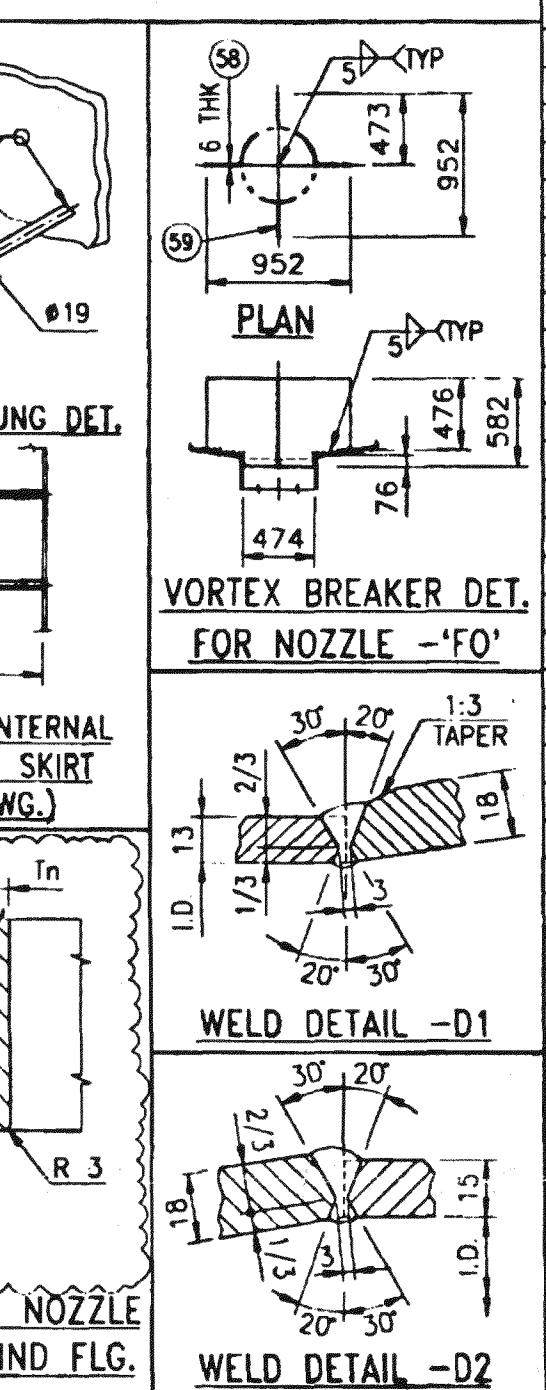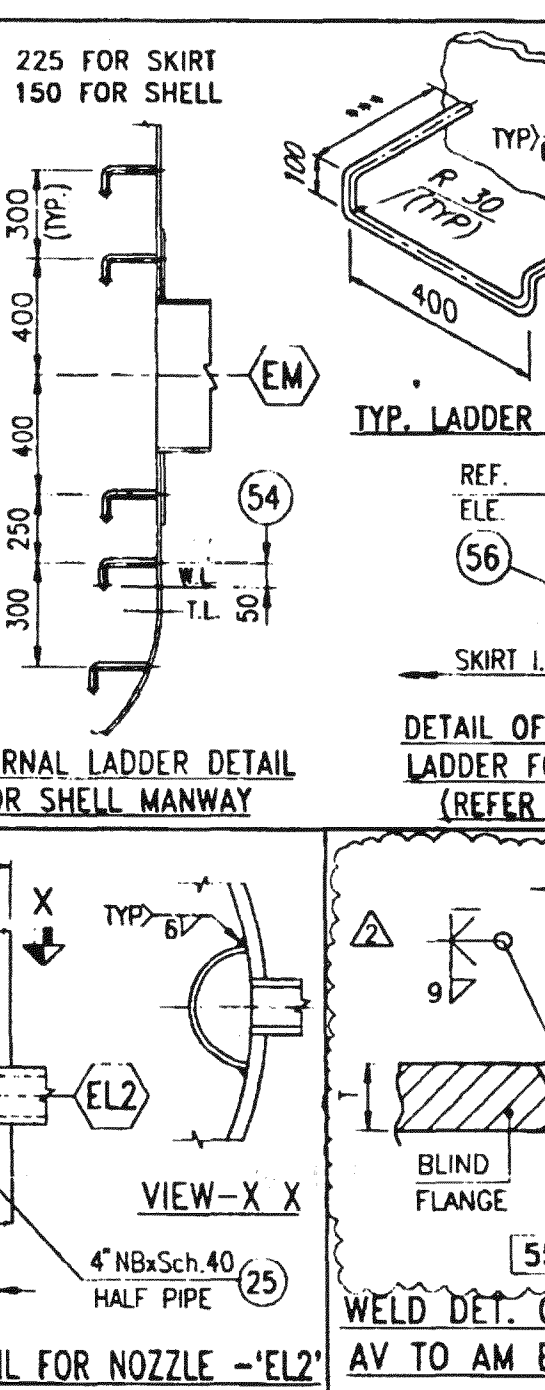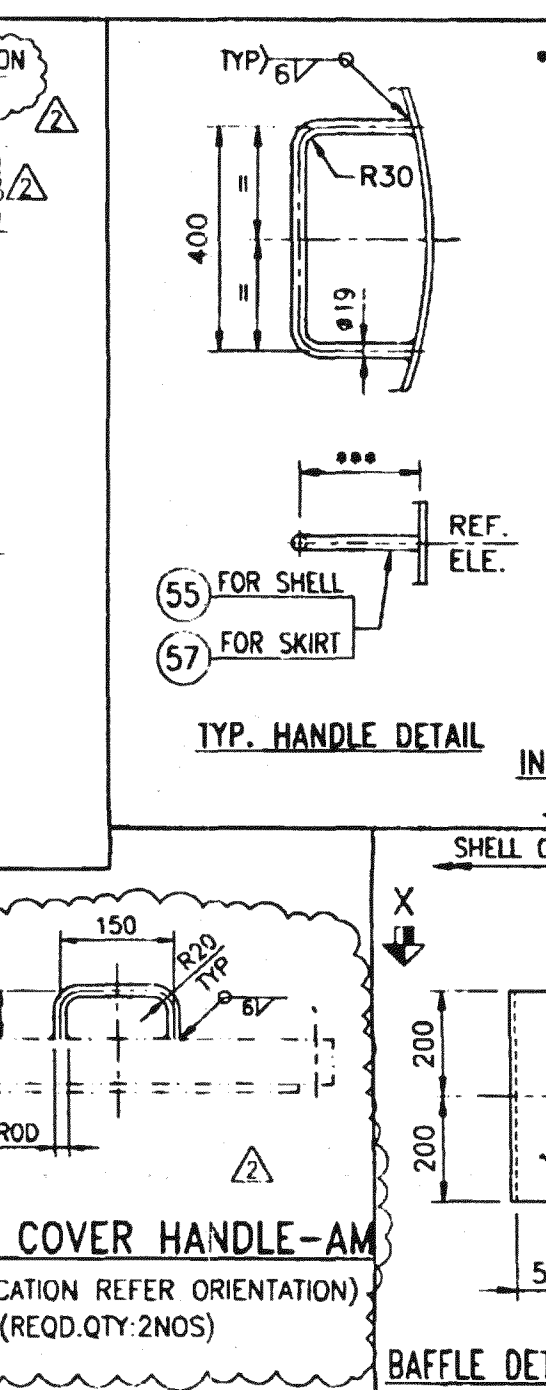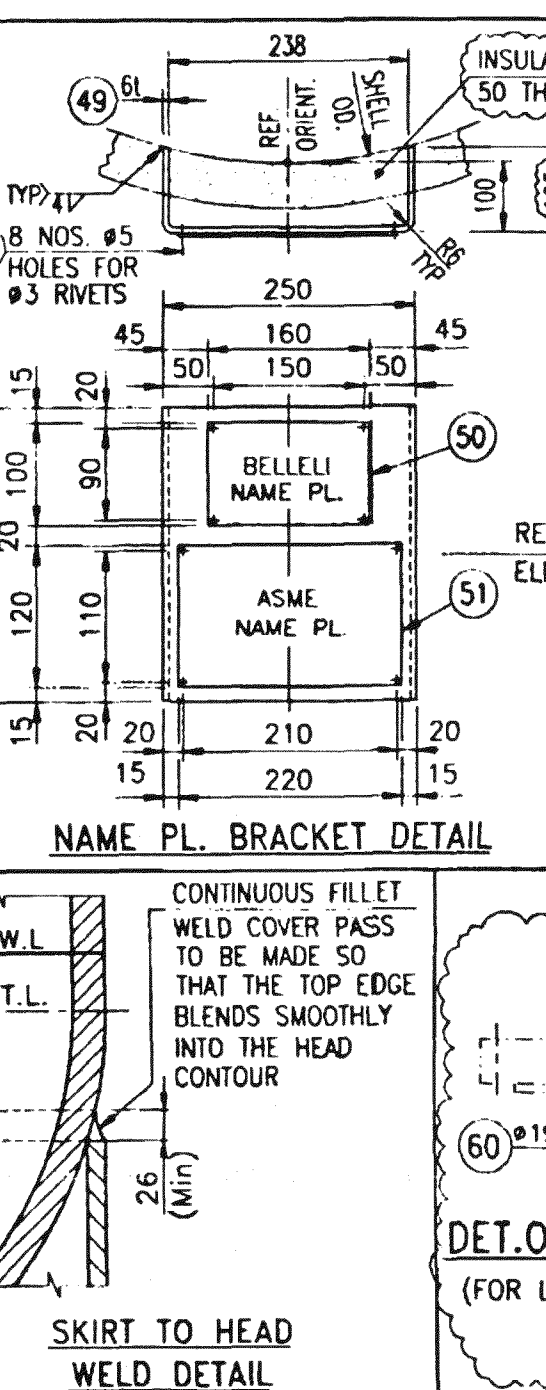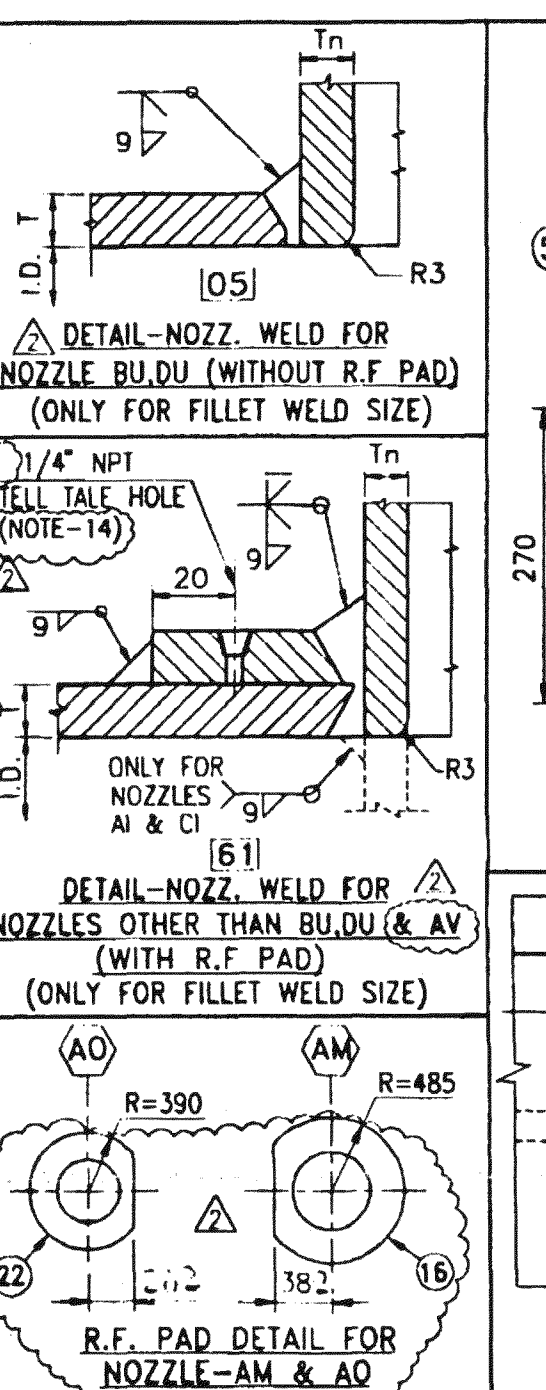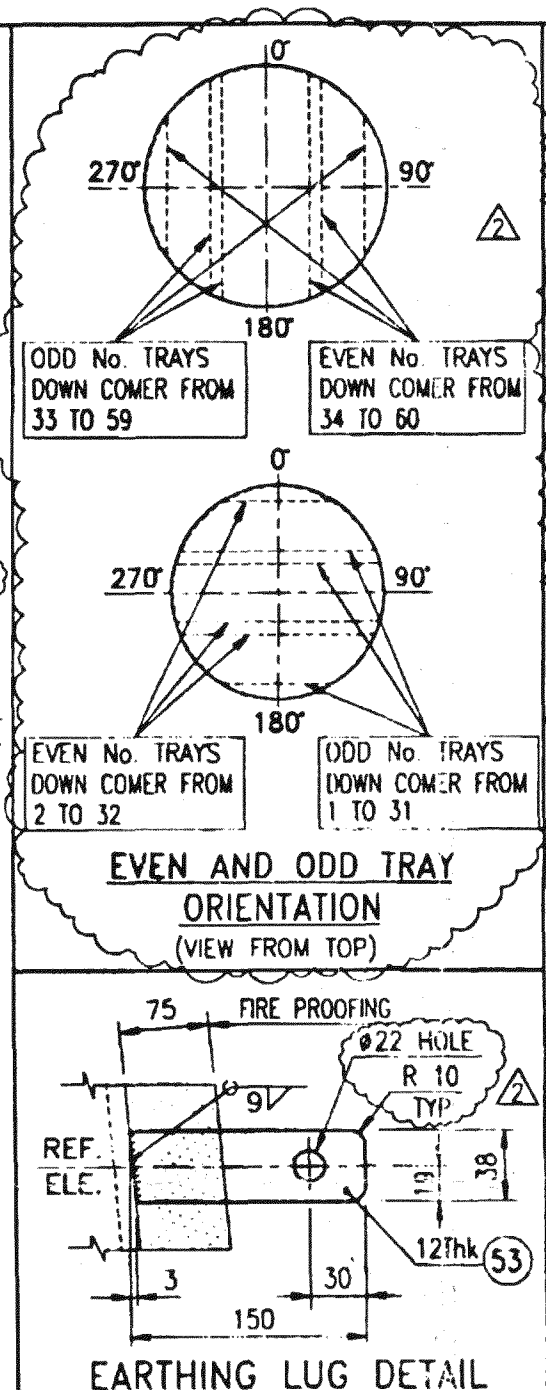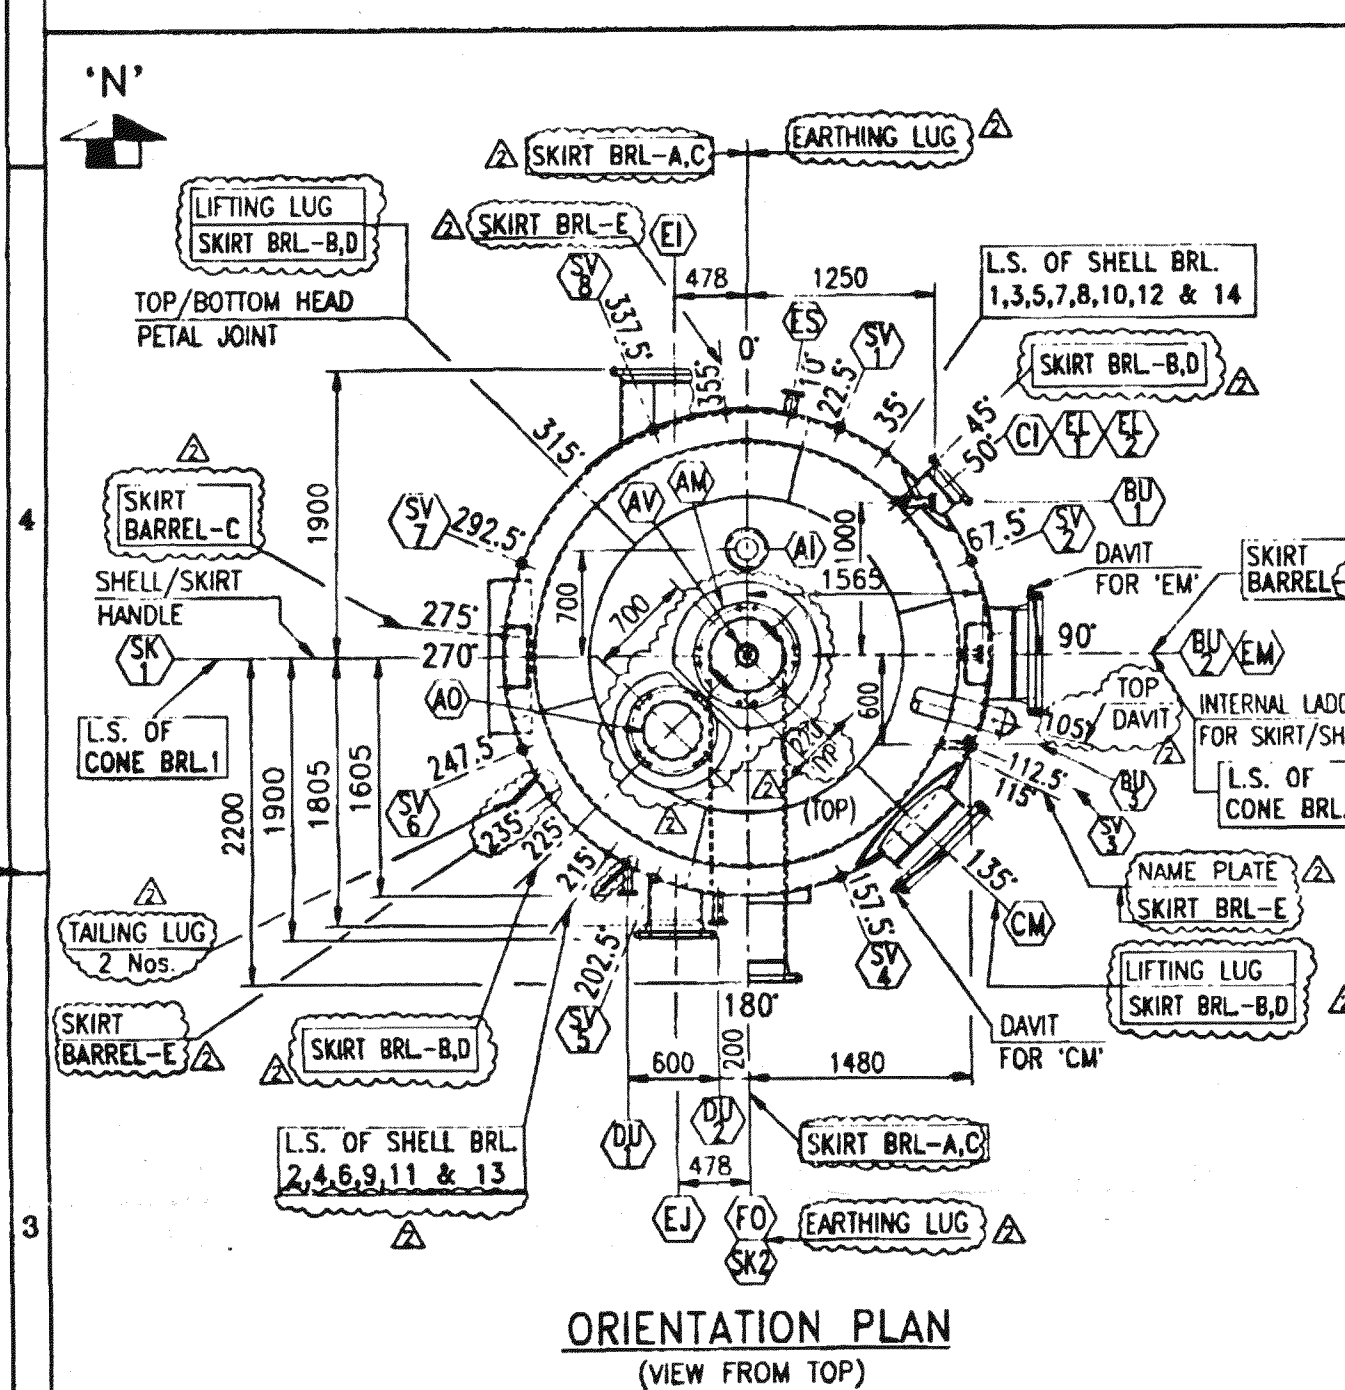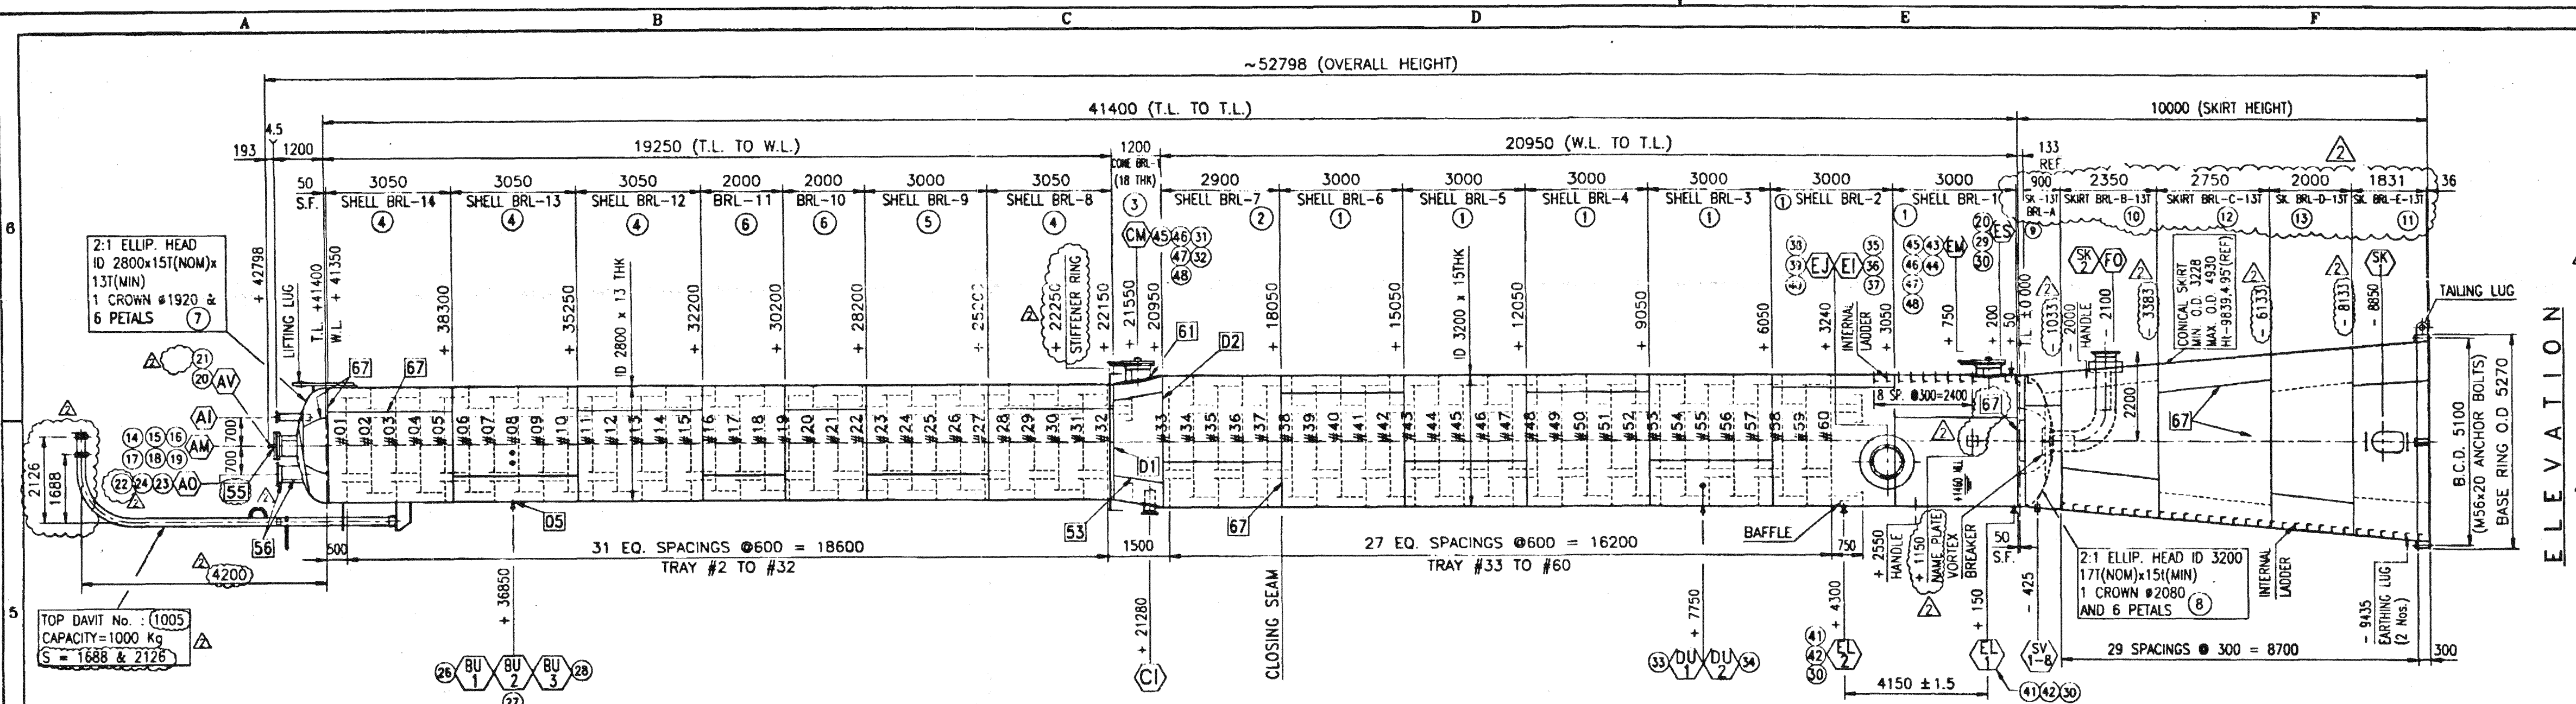

BELLELI REFERENCE DRAWINGS	
DA-7033-03-002	DETAIL DRAWING
DA-7033-03-003	FORMED HEAD TOP
DA-7033-03-004	FORMED HEAD BOTTOM
DA-7033-03-005	DETAIL OF INTERVALLS
DA-7033-03-006	TOP DAVIT
DA-7033-03-007	BELLELI NAME PLATE
DA-7033-03-008	ASME NAME PLATE
DA-7033-03-009	TRAY SUPPORT DETAILS (6 SHEETS)
DA-7033-03-010	CLIPS FOR PLAT. & LAD(2 SHEETS)
DA-7033-03-011	CLIPS FOR INSUL. FIRE PROOFING & PIPE SUPP.
ST-7033-03-001	FINISH REQUIREMENT
DO-7033-03-001	SHIPPING & TESTING ARRANGEMENT
DA-7033-03-001	DAVIT ARRANGEMENT


GENERAL NOTES	
1.	MARK INDICATES THE BSH WELD STANDARD NUMBER.
2.	MARK INDICATES THE POSITION NUMBER WITH REFERENCE TO LIST OF MATERIAL
3.	MARK INDICATES THE NOZZLE MARK NUMBER.
4.	SHOP HYD. TEST GASKETS :- (i) BLINDED NOZZLES WILL HAVE JOB GASKETS. (ii) ALL OTHER NOZZLES WILL HAVE CAF GASKET.
5.	SPARE PARTS:- ITEMS COMMISSIONING/STARTUP OPERATIONAL SHOP HYD. TEST
6.	GASKETS 200% 100% 100% 100%
7.	FASTENERS 10%(MIN. 2 SETS) 10%(MIN. 2 SETS) 100%
8.	ALL BOLTS & NUTS SHALL BE OF UNC SERIES UPTO & INCLUDING 1" SIZE & RUN ABOVE 1" SIZE
9.	FLANGES UPTO & INCLUDING 24" NB SHALL BE AS PER ANSI B16.5 & ABOVE 24" NB SHALL BE AS PER ANSI B16.47 SERIES B.THE FLANGE FACE FINISH SHALL BE 3.2 TO 6.3 MICROMETER
10.	DELETED
11.	MINIMUM TEMPERATURE OF HYDROTEST WATER SHALL BE 17°C AND THE TEST PRESSURE SHALL BE HELD FOR HALF AN HOUR PER INCH OF THICKNESS WITH ONE HOUR MINIMUM.
12.	EACH REINFORCING PAD OR SEGMENT THEREOF SHALL BE PROVIDED WITH ONE No. (Two Nos FOR NOZZLES 15" NB AND ABOVE 180° APART) 1/4" NPT. TELL TALE HOLE AS PER ANSI B1.20.1. ALL R.F. PAD WELDS SHALL BE TESTED TO 15 PSIG MINIMUM WITH AIR & SOAPY BUBBLE TEST
13.	A PERMANENT REFERENCE WORKLINE FOR VERTICAL VESSELS BOTTOM TAN LINE SHALL BE PUNCHMARKED AROUND THE VESSEL PERIMETER AT 0.90,180 & 270° AND HORIZONTAL VESSELS CENTER LEVEL SHALL BE PUNCHMARKED ON BOTH SIDES SURFACES OF SHELL NEAR THE HEAD.
14.	TRAY SUPPORT RINGS CROSSING THE LONG SEAM OF SHELL BARRELS SHALL BE CONTINUOUSLY WELDED ALSO ON THE LONG SEAM AFTER FLUSH GRIND AND RADIOGRAPH FOR A DISTANCE OF 150 mm BEYOND THE ATTACHMENT WELD.
15.	TRAYS WHICH ARE FREE ISSUE SUPPLY AND INSTALLED AT SITE BY CHYODA.
16.	ALL TRAY ELEVATIONS ARE SHOWN TO TOP OF SUPPORT RINGS.
17.	THE VESSEL SHALL BE THOROUGHLY CLEANED INSIDE & OUTSIDE AND SHALL BE FREE OF ALL DIRT, WELD ROD STUBS & LOOSE FOREIGN MATERIALS Etc.
18.	ALL REMOVABLE INTERNALS SHALL PASS THROUGH THE NEAREST MANHOLE.
19.	LONGITUDINAL SEAM OF FABRICATED NOZZLES FROM PLATE SHALL BE 100% RADIOGRAPHED
20.	WELD SEAMS COMING UNDER MISC. ATTACHMENTS SHALL BE GROUND SMOOTH & RADIOGRAPHED FOR A DISTANCE OF 150mm BEYOND THE ATTACHMENT WELD.
21.	ALL NOZZLES AND MANWAY THAT DO NOT EXTEND INTO THE VESSEL SHALL BE FINISHED FLUSH WITH THE INSIDE & THE INNER EDGE SHALL BE ROUNDED OFF TO A MIN 3mm RADIUS.
22.	NOZZLE POSITIONS ON VESSEL ELEVATIONS ARE CONVENTIONAL. FOR TRUE LOCATION SEE NOZZLE ORIENTATION PLAN.
23.	NOZZLE PROJECTION IS FROM CENTER LINE OF VESSEL TO GASKET FACE OF FLANGE UNLESS SPECIFIED OTHERWISE.
24.	ALL FLANGE BOLT HOLES SHALL STRADDLE VERTICAL AND/OR NORTH SOUTH CENTER LINES UNLESS SHOWN OTHERWISE.
25.	ALL DIMENSIONS ARE IN MILLIMETERS UNLESS OTHERWISE SPECIFIED.

NOZZLE SCHEDULE.	
MARK	QTY
SK2	1
SK1	1
SV1	8
FO	1
ES	1
EM	1
ELV2	2
EJ	1
EJ1	1
DMV2	2
CM	1
CI	1
BU1	3
AV	1
AO	1
AM	1
AI	1
MARK	QTY
SK2	1
SK1	1
SV1	8
FO	1
ES	1
EM	1
ELV2	2
EJ	1
EJ1	1
DMV2	2
CM	1
CI	1
BU1	3
AV	1
AO	1
AM	1
AI	1


DESIGN DATA	
33.	FABRICATION WEIGHT
32.	FULL OF WATER WEIGHT OF SITE
31.	OPERATING WEIGHT
30.	ERECTION WEIGHT
29.	MANUFACTURER'S SERIAL NO.
28.	MANUFACTURER'S JOB NUMBER
27.	MANUFACTURER'S NAME
26.	CODE STAMP
25.	DESIGN CODE
24.	SERVICE
23.	VOLUME
22.	FIREPROOFING
21.	INSULATION (BY OTHERS)
20.	SPECIFIC GRAVITY
19.	OPERATING FLUID
18.	INSPECTION AUTHORITY
17.	WIND SPEED/EXPOSURE CATEGORY
16.	EARTHQUAKE DESIGN
15.	MINIMUM DESIGN METAL TEMPERATURE
14.	CHARPY IMPACT TEST
13.	ULTRASONIC EXAMINATION
12.	POST WELD HEAT TREATMENT
11.	JOINT EFFICIENCY (SHELL/HEAD/CONE)
10.	RADIOGRAPHY (SHELL/HEAD/CONE)
9.	CORROSION ALLOWANCE
8.	M.A.W.P. AT DESIGN TEMPERATURE
7.	M.A.P. (NEW & COLD)
6.	FIELD HYDROTEST PRESSURE (CORROD)
5.	SHOP HYDROTEST PRESSURE (HOR)
4.	OPERATING TEMPERATURE (TOP/BOT)
3.	OPERATING PRESSURE (TOP/BTM)
2.	DESIGN TEMPERATURE (INT/EXT)
1.	DESIGN PRESSURE (INT/EXT)

SPARES FOR GASKETS & FASTENERS ARE INCLUDED IN LOM	
SA 193 Gr B7/SA 194 Gr 2H	
4.5mm THK SS 316 SPIRAL WOUND GRAPHITE FILLED WITH SS 316 INNER AND SS/CS OUTER CENTERING RING	
TOTAL WT. = 62381.8 Kgs.	
ITEM NO.	DESCRIPTION
62	STIFFENER RING
61	STIFFENER RING
60	STIFFENER RING
59	VORTEX BREAKER
58	VORTEX BREAKER
57	HANDLE #19
56	ROD #19
55	HANDLE #19
54	ROD #19
53	EARTHING LUG
52	RIVET #3
51	ASME NAME PL.
50	BELLELI NAME PL.
49	NAME PL. BRACKET
48	ST-2N1 1 1/4" BUN
47	CK 24" 12.150 RF
46	RF 24" 12.150 BRF
45	F 24" 12.150 WNR
44	RP 001150/620/151
43	NOZZLE NECK
42	PI 2" 160
41	F 2" 160 3003 WNR
40	RP 00680/366/151
39	NOZZLE NECK
38	F 14" 12.150 WNR
37	RP 001325/721/151
36	NOZZLE NECK
35	F 28" 12.150 WNR
34	F 1" 150 WNR
33	F 1" 150 WNR
32	RP 001150/620/181
31	NOZZLE NECK
30	RP 00150/70/151
29	PI 2" 160
28	F 1" 150 WNR
27	F 1" 150 WNR
26	F 1" 150 WNR
25	PI 4" 40 HALF PIPE
24	NOZZLE NECK
23	F 16" 12.150 WNR
22	RP PAD (SEE DET.)
21	F 2" 160
20	F 2" 160 150 WNR
19	ST-2N1 1 1/4" BUN
18	CK 20" 150 RF
17	RF 20" 150 BRF
16	RP PAD (SEE DET.)
15	NOZZLE NECK
14	F 20" 12.150 WNR
13	SK BRL 00 4266/4612
12	SK BRL 00 3790/4266
11	SK BRL 00 4612/4930
10	SK BRL 00 3383/3790
9	SK BRL 00 3227/3383
8	EH 03200/17(NOM)
7	EH 02800/15(NOM)
6	SH BRL 12.13
5	SHELL BRL-9
4	SH BRL-8,12,13,14
3	CONE BRL 03200/2800
2	SH BRL-7
1	SH BRL-1,2,3,4,5,6




LIST OF MATERIAL	
CHYODA PETROSTAR LTD.	
JOB NO. 54001 IBN RUSHD AROMATICS PROJECT	
PO NO. SAY-POPO002	
REQ NO. MR-50-C-003	
IDENT NO. 54001-IB-0001	
DATE 14.12.2019	
FOR ONE OF THE FOLLOWING	
FOR TWO OF THE FOLLOWING	
FOR THREE OF THE FOLLOWING	
FOR FOUR OF THE FOLLOWING	
FOR FIVE OF THE FOLLOWING	
FOR SIX OF THE FOLLOWING	
FOR SEVEN OF THE FOLLOWING	
FOR EIGHT OF THE FOLLOWING	
FOR NINE OF THE FOLLOWING	
FOR TEN OF THE FOLLOWING	
FOR ELEVEN OF THE FOLLOWING	
FOR TWELVE OF THE FOLLOWING	
FOR THIRTEEN OF THE FOLLOWING	
FOR FOURTEEN OF THE FOLLOWING	
FOR FIFTEEN OF THE FOLLOWING	
FOR SIXTEEN OF THE FOLLOWING	
FOR SEVENTEEN OF THE FOLLOWING	
FOR EIGHTEEN OF THE FOLLOWING	
FOR NINETEEN OF THE FOLLOWING	
FOR TWENTY OF THE FOLLOWING	
FOR TWENTY ONE OF THE FOLLOWING	
FOR TWENTY TWO OF THE FOLLOWING	
FOR TWENTY THREE OF THE FOLLOWING	
FOR TWENTY FOUR OF THE FOLLOWING	
FOR TWENTY FIVE OF THE FOLLOWING	
FOR TWENTY SIX OF THE FOLLOWING	
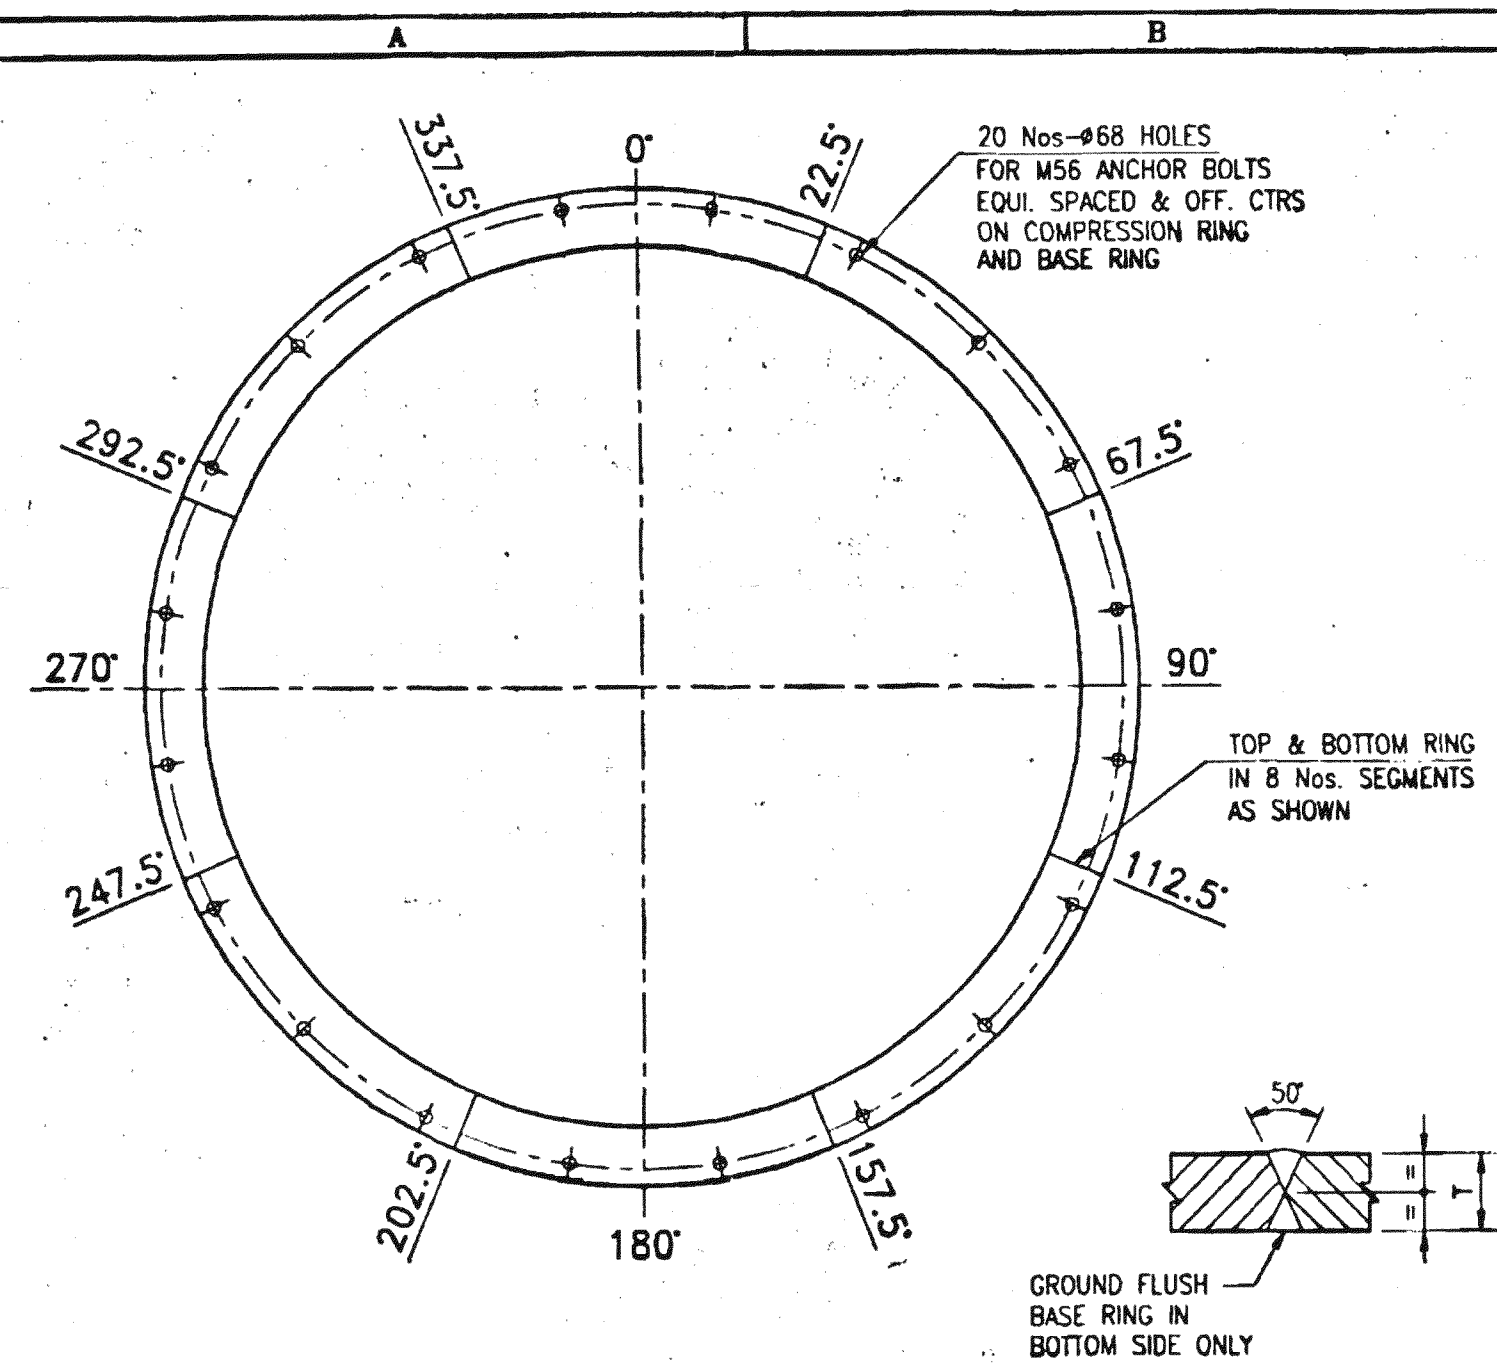




- PLATE WASHER (Pos.4) TO BE SHIPPED LOOSE, WIRE TOGETHER & ATTACH SECURELY TO VESSEL FOR SHIPMENT.

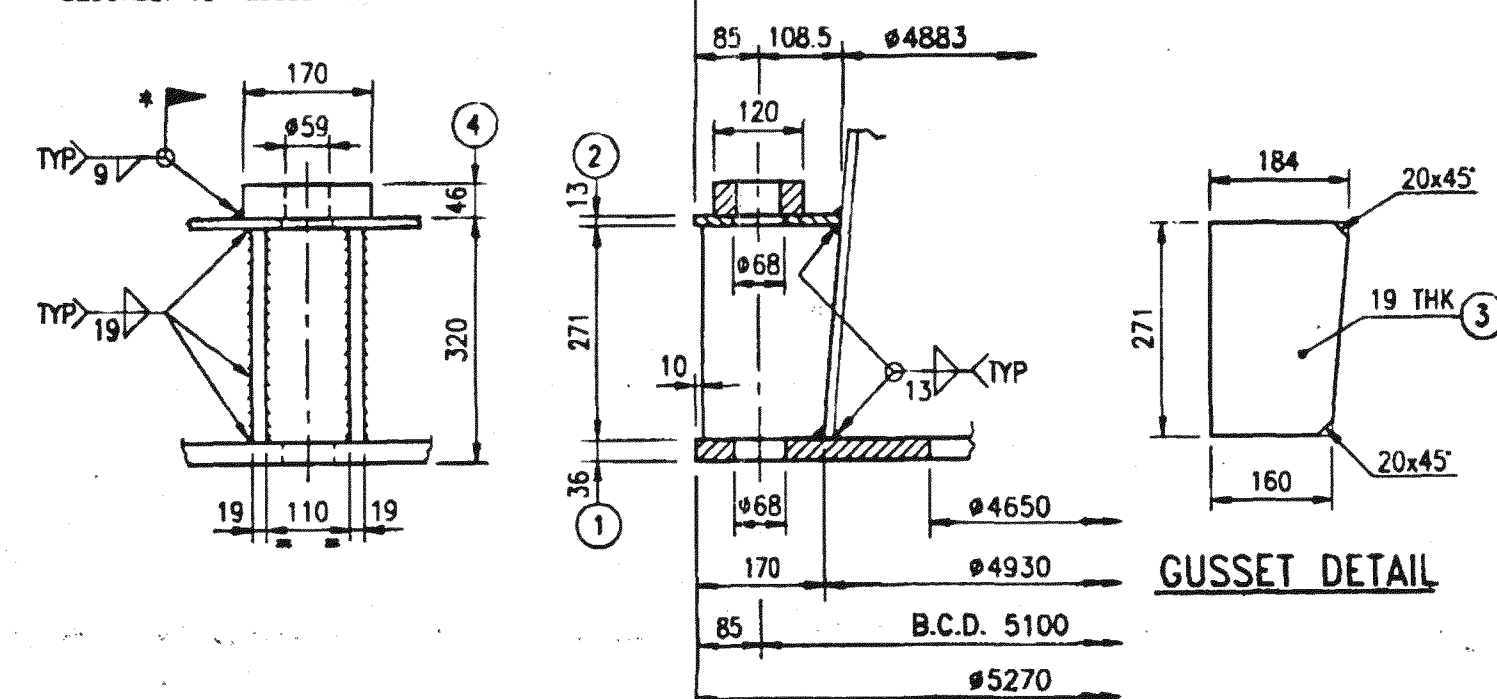

SKIRT AND ANCHOR CHAIR DETAIL

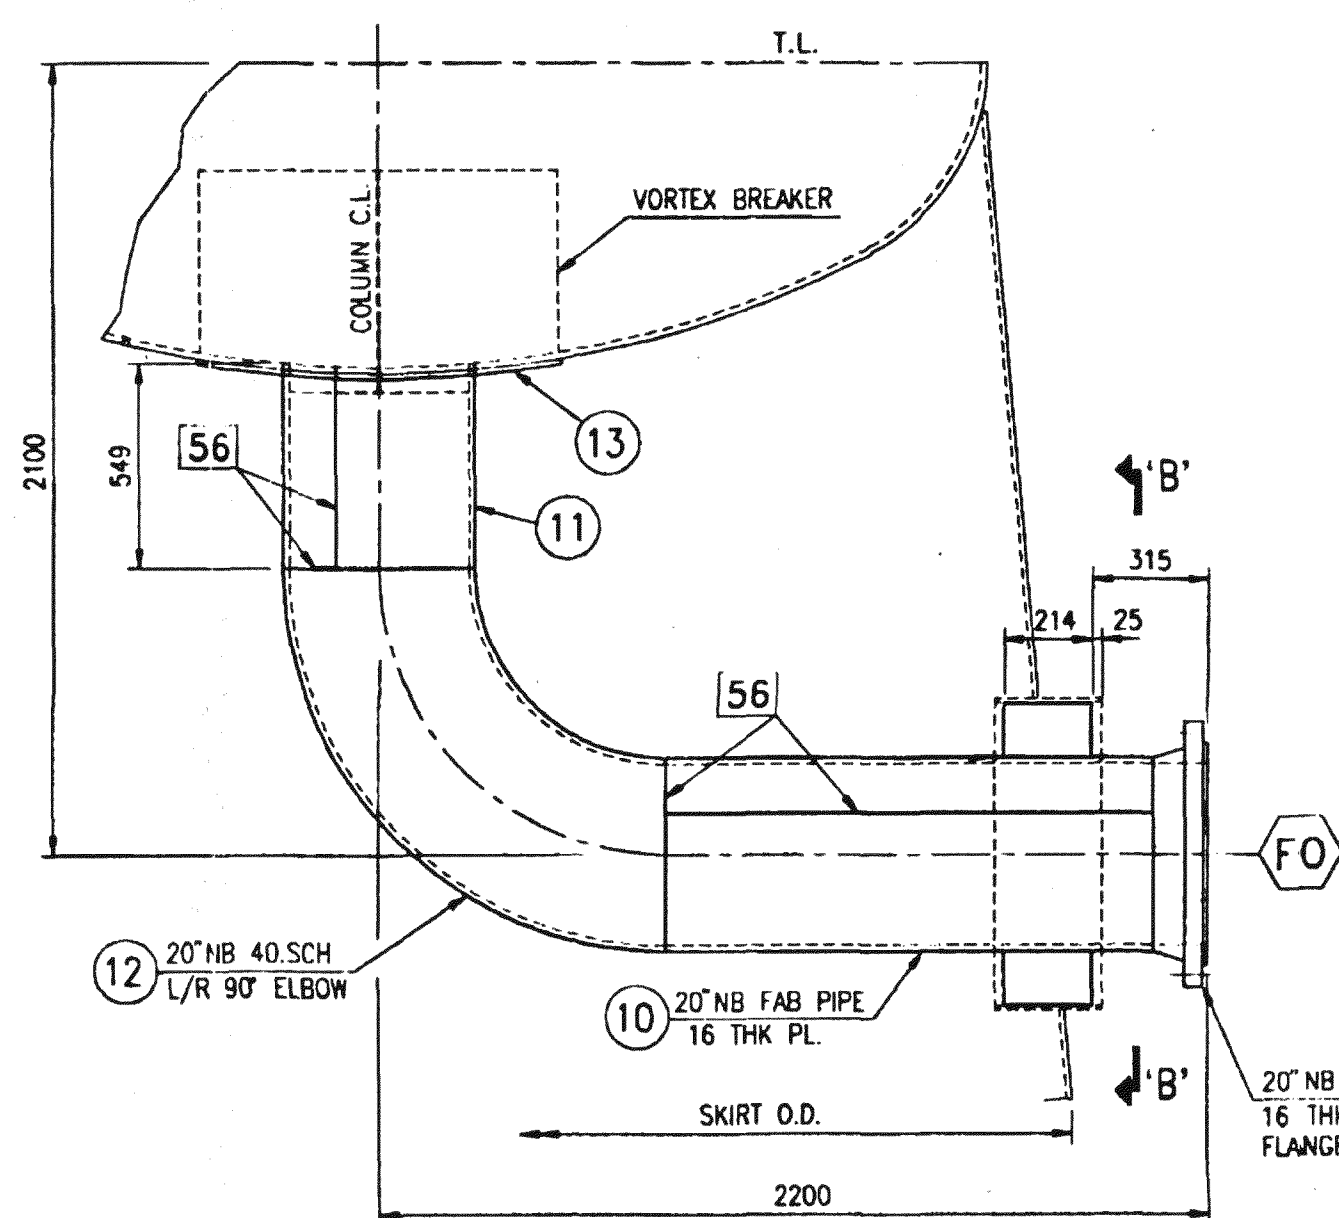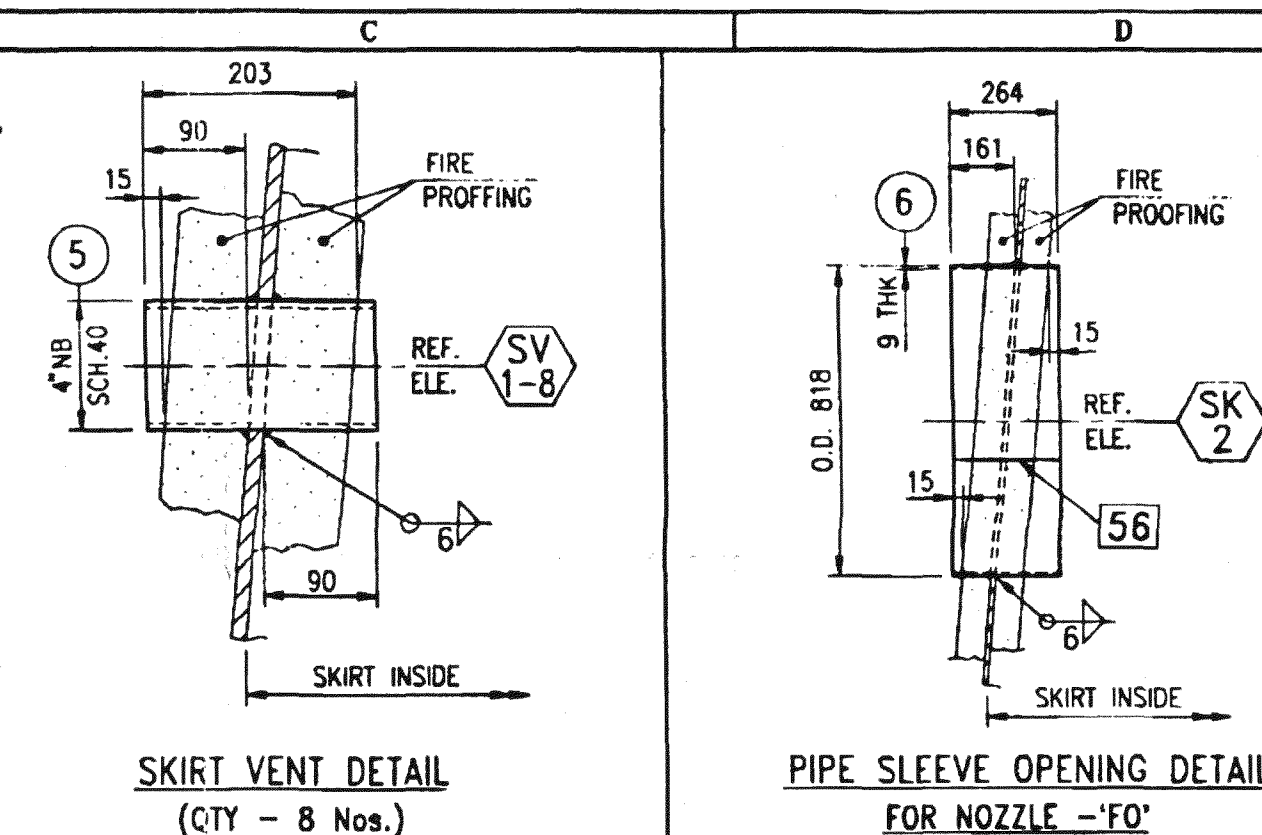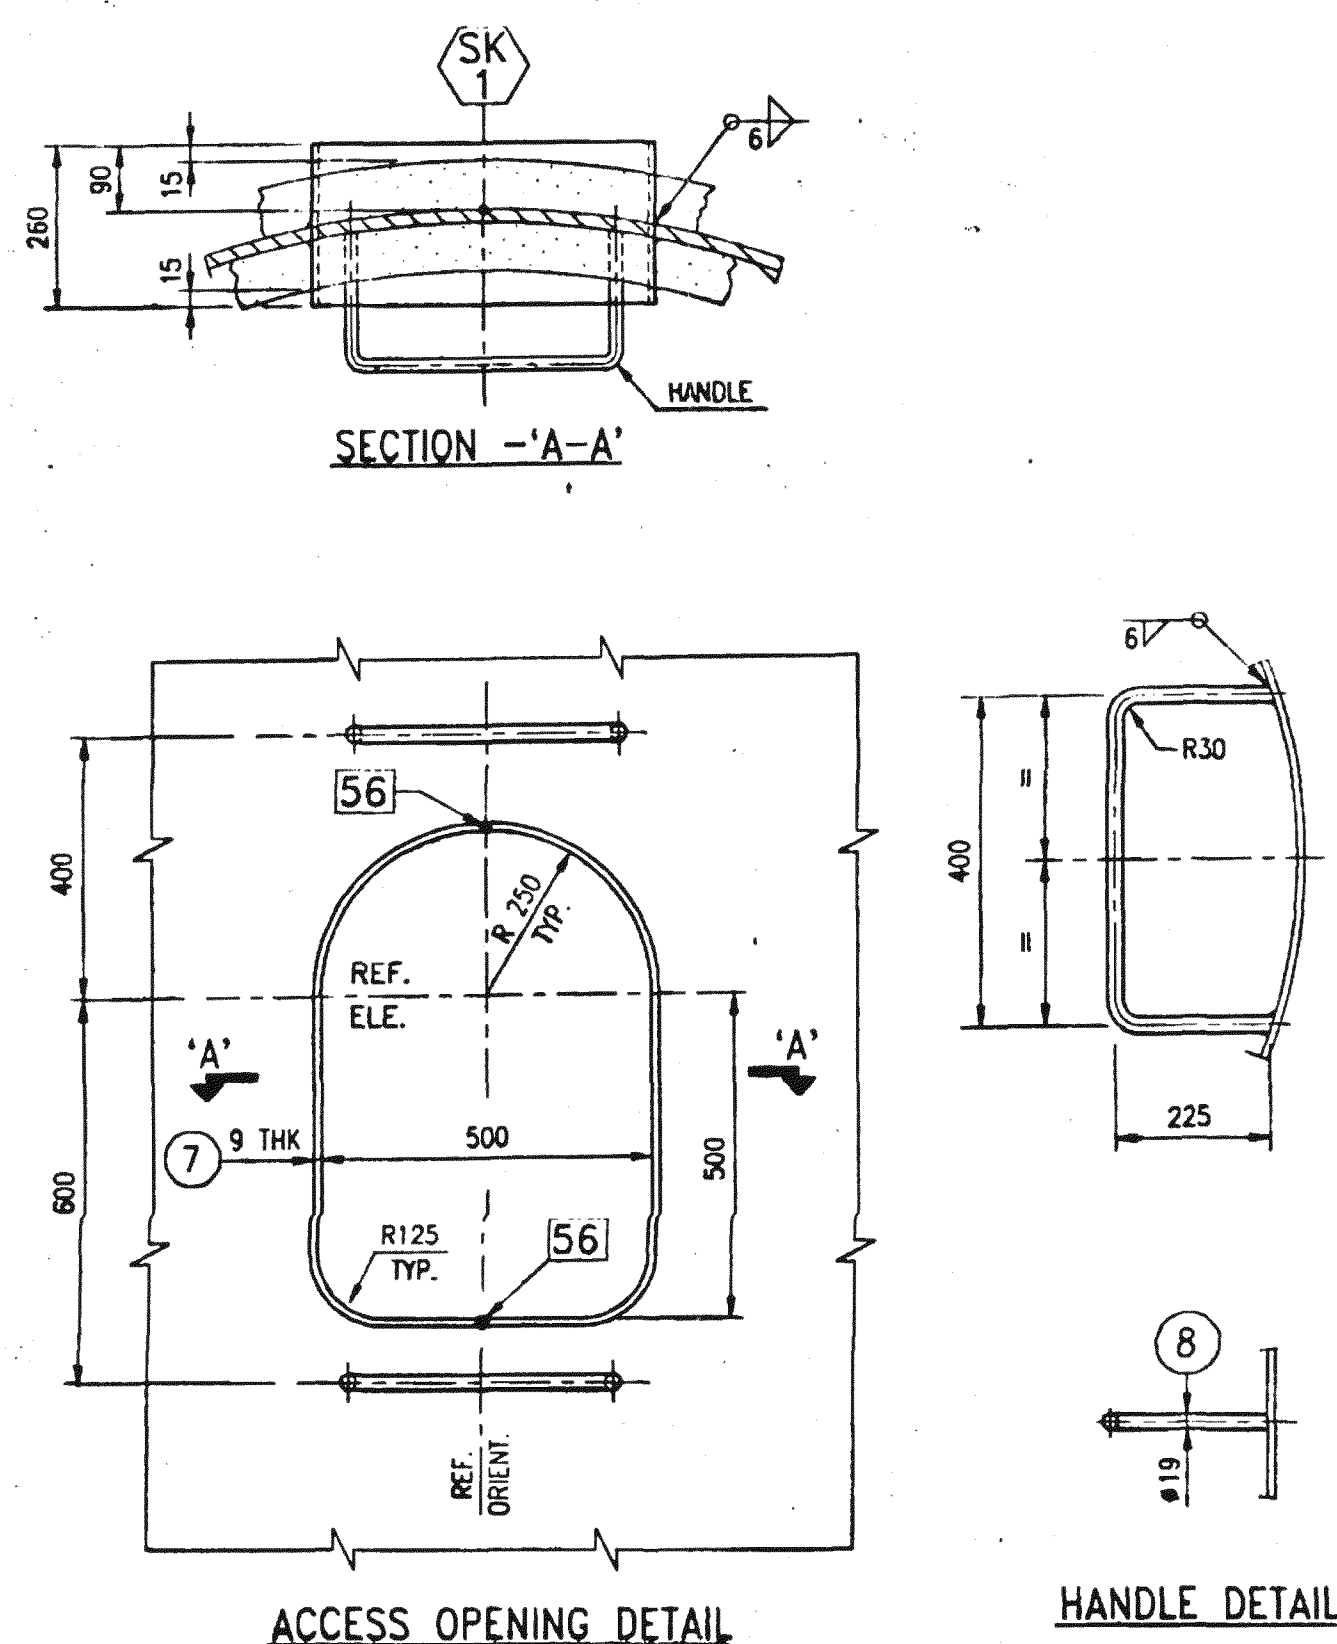


DETAIL OF NOZZLE - 'FO'

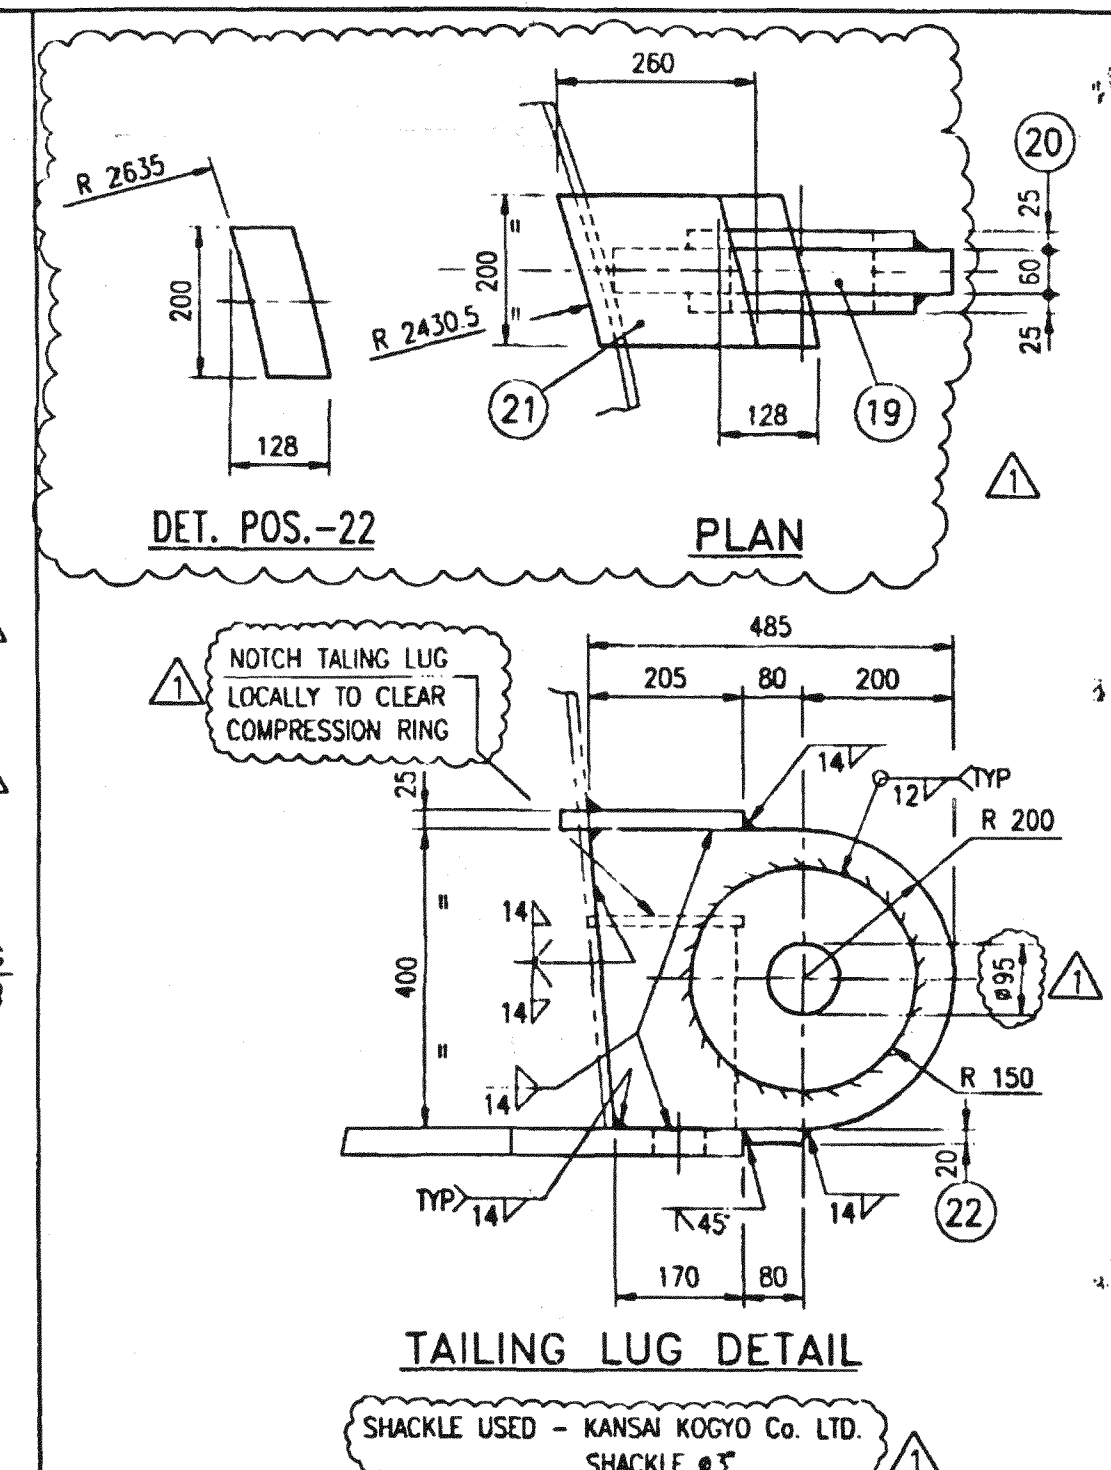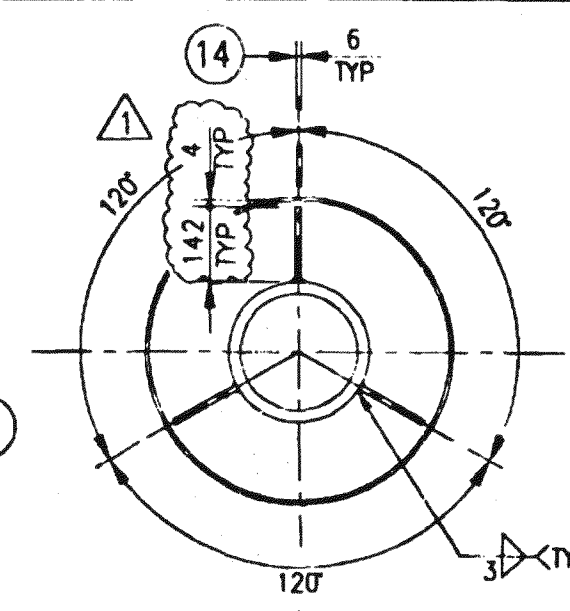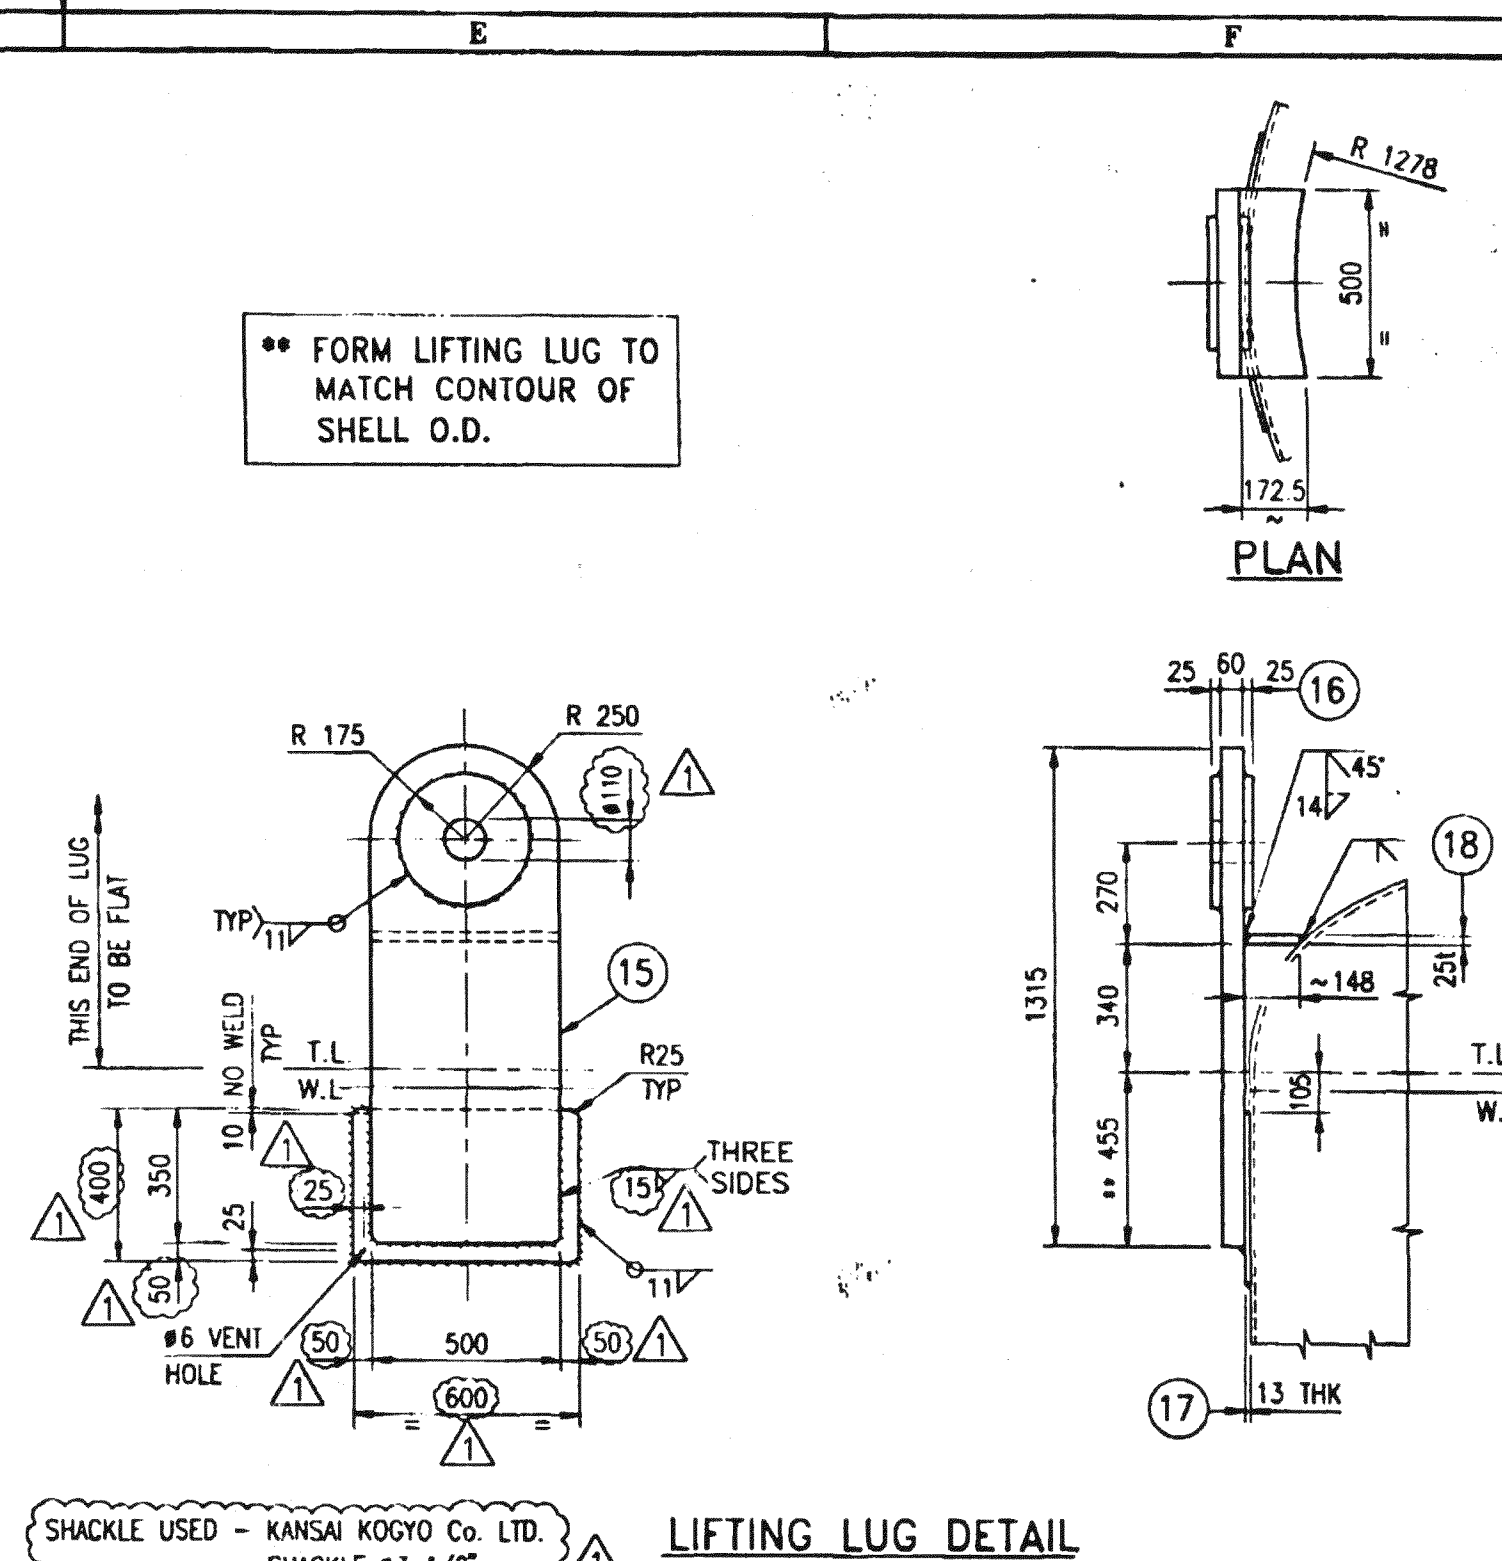


TOTAL WT. = (5119.5 Kgs.)												
23	2	BEAM HEA 400	4823	0	0	602.0	1204.0	A36				
22	2	STIFFENER (SEE DWG)	200	128	20.0	4.0	8.0	A36	70334011.63		703300-001	
21	2	STIFFENER (SEE DWG)	250	200	25.0	10.2	20.4	A36	70334011.64		703300-001	
20	4	RING OD300 ID195	0	0	0	12.5	50.0	A36	70334011.64		703300-001	
19	2	TAILING LUG	485	400	60.0	91.4	182.8	A36	70334011.69		703300-001	
18	2	STIFFENER	500	173	25.0	17.0	34.0	A516GR-70	70334011.52		703300-001	
17	2	PAD	600	400	13.0	25.0	50.0	A516GR-70	70334011.08		703300-001	
16	4	RING OD350 ID110	0	0	25.0	17.0	68.0	A36	70334011.64		703300-001	
15	2	LIFTING LUG	1315	500	60.0	309.7	619.4	A36	70334011.69		703300-001	
14	3	STIFFENER	214	142	6.0	1.5	4.5	A516GR-70	LP0645172550000	STOCK		
13	1	RF PAD OD 970x518	0	0	17.0	70.5	70.5	A516GR-70	70334011.18		703300-001	
12	1	EL 20" - 40 LR/90°	0	0	0	147.0	147.0	SA234GMPB	70334090.05		703300-090	
11	1	NOZZLE NECK	1546	549	16.0	106.6	106.6	SA516GR-70	70334011.16		703300-001	
10	1	NOZZLE NECK	1546	1294	16.0	251.2	251.2	SA516GR-70	70334011.16		703300-001	
9	1	F 20"150° HWRF-16	0	0	0	78.0	78.0	SA105	7033404F23		703300-004	
8	2	HANDLE #19	816	0	0	1.8	3.6	A36	7033420P01		703300-020	
7	1	ACCESS OPENING	2027	260	9.0	40.5	40.5	A36	629505109P06	STOCK		
6	1	PIPE WAY OPENING	2542	264	9.0	47.4	47.4	A36	629505109P06	STOCK		
5	8	PI C# 40	203	0	0	3.3	26.4	A106GRB	7033406119		703300-006	
4	20	PLAIN WASHER	170	120	46.0	7.4	148.0	A36	70334011.67		703300-001	
3	40	GUSSET PLATE	271	184	19.0	7.0	280.0	A36	70334011.62		703300-001	
2	1	1 R. OD 5270x4883	0	0	13.0	314.8	314.8	A36	70334011.59		703300-001	
03-02	1	1 R. OD 5270x4550	0	0	36.0	1364.4	1364.4	A36	70334011.66		703300-001	
FAM.	QTY FOR ONE FAM.	DESCRIPTION	LENGTH	WIDTH	THICK	WT. IN Kg.	MAT'L	MAT'L CODE	RDA. NO.			

UNSEEN CERTIFIED	HEAVY INDUSTRIES LTD. IS DRAFT	 CHIYODA PETROSTAR LTD. JOB NO. 54001/BN RUSHD AROMATICS PROJECT PO NO. SAY-POP0002 REQ NO. MR-50-C-003 IDENT NO. 54001-DW-0002	<table border="1" style="width: 100%; border-collapse: collapse;"> <tr> <td style="width: 50%; font-size: small;"> ☒ AND COMMENTS PARALLEL IN PROGRESS WITH COMMENTS DATED 10/10/96 </td> <td style="width: 50%; font-size: small;"> SHEET NO. 105 2/10/96 </td> </tr> <tr> <td style="font-size: small;"> ALSO NOT INDICATED WITH PARALLELISM </td> <td style="font-size: small;"> DATE 10/10/96 </td> </tr> </table> PURCHASER'S PERMISSION TO PROCEED TO REVIEW TAKEN ON VENDOR POINTS SHALL NOT RELIEVE VENDOR FROM ITS RESPONSIBILITIES OR LIABILITIES UNDER PURCHASE ORDER.	☒ AND COMMENTS PARALLEL IN PROGRESS WITH COMMENTS DATED 10/10/96	SHEET NO. 105 2/10/96	ALSO NOT INDICATED WITH PARALLELISM	DATE 10/10/96
☒ AND COMMENTS PARALLEL IN PROGRESS WITH COMMENTS DATED 10/10/96	SHEET NO. 105 2/10/96						
ALSO NOT INDICATED WITH PARALLELISM	DATE 10/10/96						
1	01.03.97	REVISED AS PER CLIENT'S COMMENTS AND ISSUED FOR CONSTRUCTION	RJP				
0	10.10.96	ISSUED FOR APPROVAL	RJP				
REV. DATE		DESCRIPTION	DRAWN CHK'D APP'D				
SCALE: 1 : 40 CLIENT: CHIYODA/BN RUSHD. ORDER: SAY-POP0002		بيليلي السعودية HEAVY INDUSTRIES LTD. AL- JUBAIL, KINGDOM OF SAUDI ARABIA.					
APPROVED FOR CONSTRUCTION BY: A.K.BANERJEE DATE: 10/10/96		ARABIAN INDUSTRIAL FIBRES COMPANY (BN RUSHD.) PTA & AROMATICS PROJECT - AROMATICS DEHEPTANIZER (54-C-01) DETAIL DRAWING					
QUESTO DISEGNO NON PUO ESSERE COPIATO RIPRODOTTO MOSTRATO A TERZI SENZA NOSTRA AUTORIZZAZIONE		DRAWING NO. DA-7033-03-002	REV. 1				

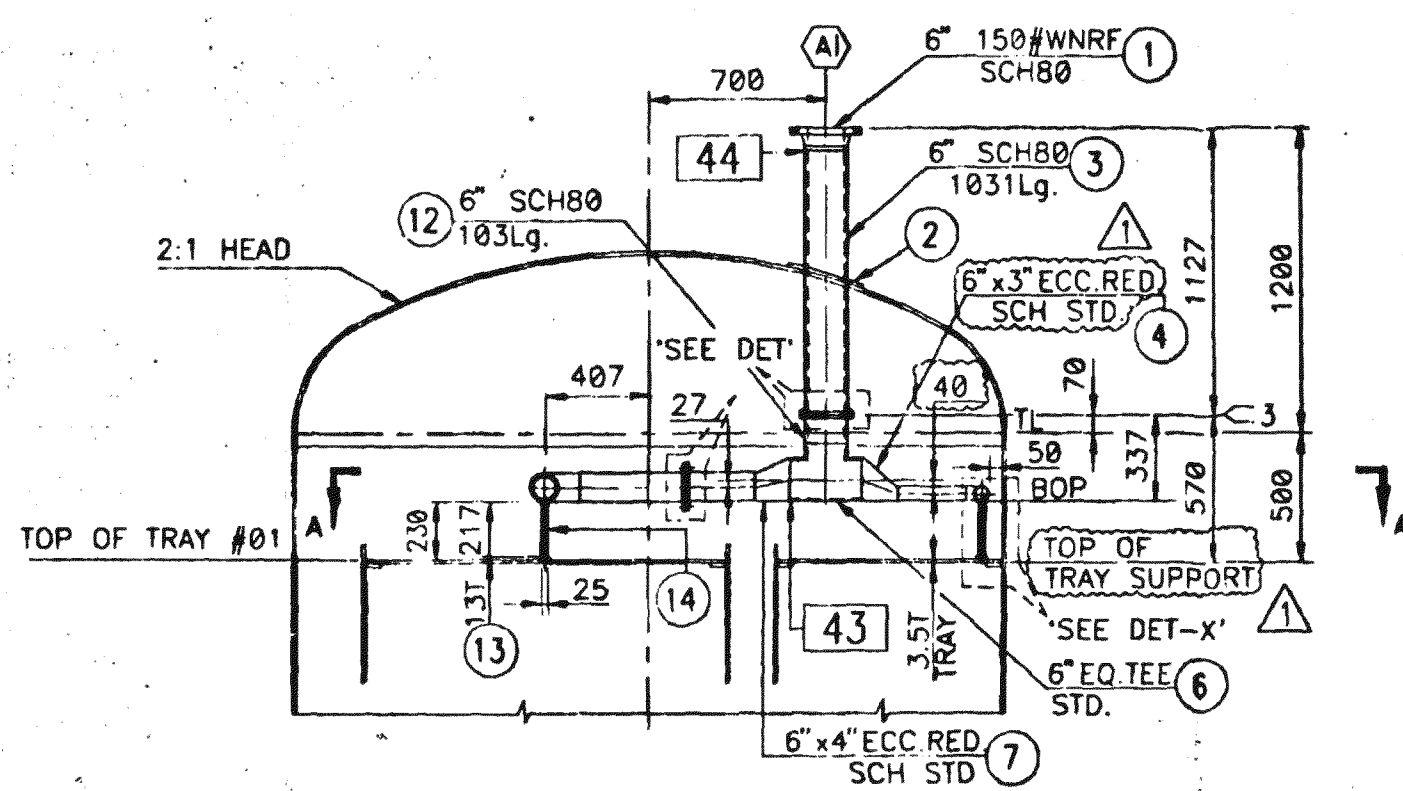


ELEVATION-NOZZLE-AI

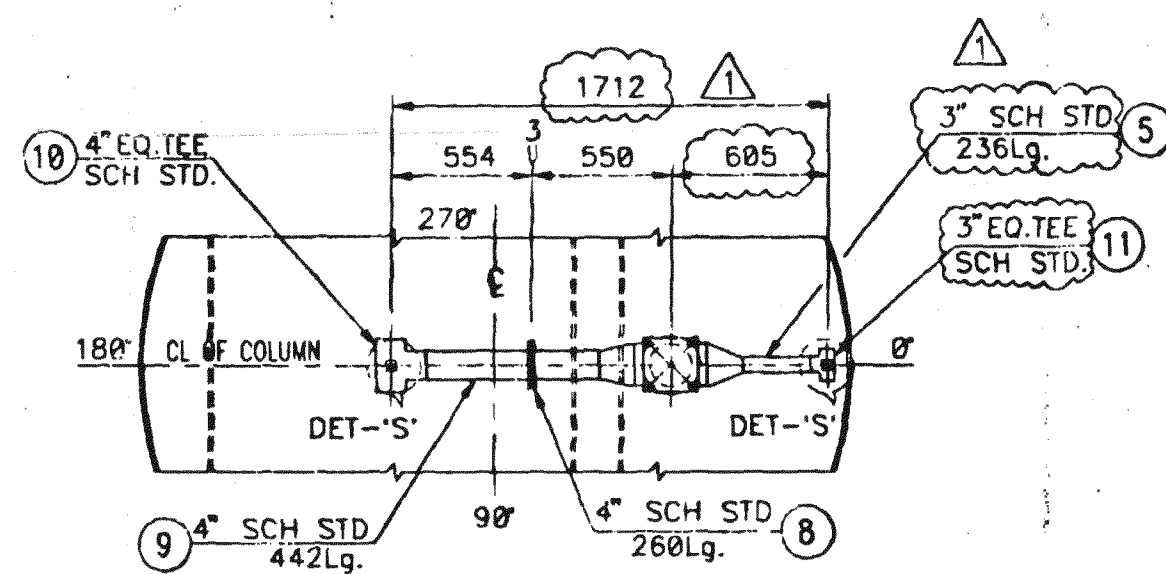


SECTION-AA

DETAIL-NOZZLE-AI

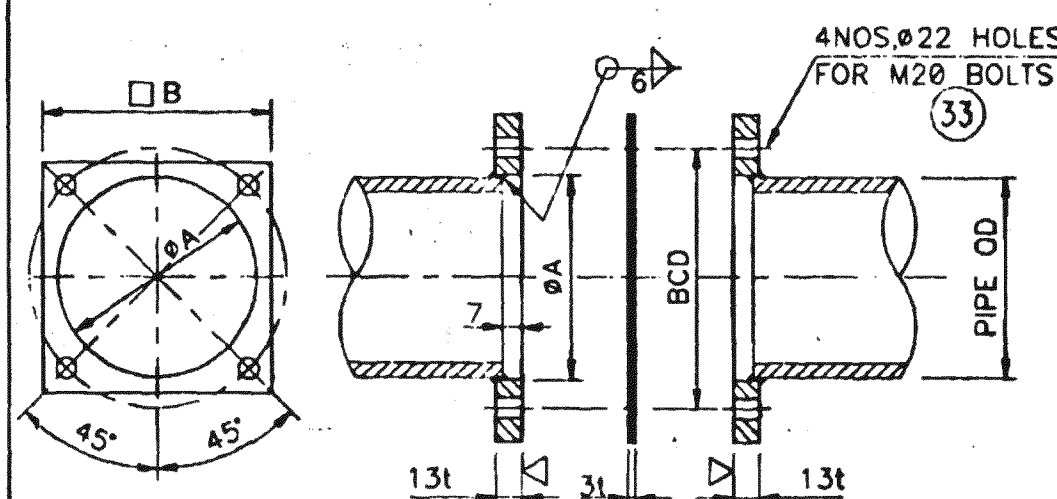


PIPE SIZE	ØA	□'B'	BCD	POS No.
4"	116	177	179	(29) (30)
6"	170	215	233	(31) (32)


DETAIL - PLATE FLANGE-AI

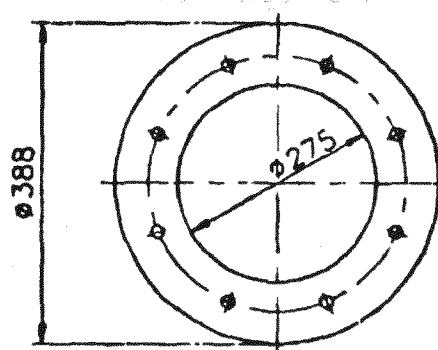

DETAIL - PLATE FLANGE-CI

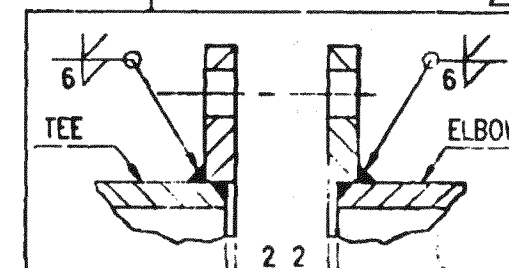

DETAIL 'C'

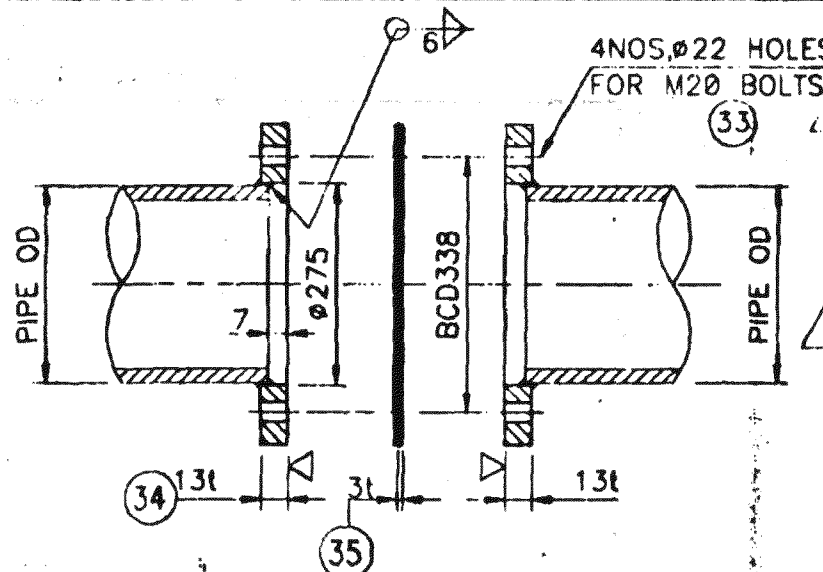

TOTAL WT. = 476.5 Kgs.									
ITEM NO.	DESCRIPTION	LENGTH	WIDTH	THICK	WT. IN Kg.	MAT'L	MAT'L CODE	RDA. NO.	
36	1 TEE 10" STD	0	0	0.0	41.3	SA234WPB	7033409C11	703300-009	
35	2 CK 388/375/3T	0	0	0.0	0.2	GRAFOIL			
34	4 RING 388/275/16T	0	0	0.0	6.0	SA516G70	7033401L16	703300-001	
33	24 B+INT M20	60	0	0.0	0.1	SA193B7/SA194Z	06502020080	STOCK	
32	1 CK (SEE DWG)	0	0	3.0	0.0	GRAFOIL			
31	2 PLATE FLG.-N	215	215	16.0	6.2	SA516G70	7033401L16	703300-001	
30	1 CK (SEE DWG)	0	0	3.0	0.0	GRAFOIL			
29	2 PLATE FLG.-N	177	177	16.0	4.4	SA516G70	7033401L16	703300-001	
28	1 BAR SUPPORT	217	25	13.0	0.5	SA516G70	7033401L05	703300-001	
27	2 BAR SUPPORT	327	25	13.0	0.8	SA516G70	7033401L05	703300-001	
26	1 PI 10" STD-CI	280	0	0.0	12.1	SA106GB			
25	1 ER 10/6" STD	0	0	0.0	10.4	SA234WPB			
24	1 PI 6" STD-CI	886	0	0.0	25.0	SA106GB			
23	1 ER 10/8" STD	0	0	0.0	10.7	SA234WPB			
22	1 TEE 8" STD	0	0	0.0	27.2	SA234WPB			
21	1 TEE 6" STD	0	0	0.0	14.9	SA234WPB			
20	1 E 10" STD LR90	0	0	0.0	76.0	SA234WPB			
19	1 E 10" STD LR45	0	0	0.0	38.0	SA234WPB			
18	1 PI 10" STD-CI	307	0	0.0	18.0	SA106GB			
17	1 PI 10" STD-CI	286	0	0.0	3.0	SA106GB	7033406T08	703300-006	
16	1 F-10" 150# WNRFB	0	0	0.0	25.0	SA105	7033404F11	703300-004	
15	1 RP 510/283/16T	0	0	0.0	14.4	SA516G70N	7033401L16	703300-001	
14	1 BAR SUPPORT	217	25	13.0	0.6	SA516G70	7033401L05	703300-001	
13	4 WEAR PLATE	40	40	13.0	0.2	SA516G70	7033401L05	703300-001	
12	1 PI 6" STD-N	103	0	0.0	2.9	SA106GB			
11	1 TEE 3" STD	0	0	0.0	3.8	SA234WPB			
10	1 TEE 4" STD	0	0	0.0	4.1	SA234WPB			
9	1 PI 4" STD-N	442	0	0.0	7.0	SA106GB	6355A06T03	STOCK	
8	1 PI 4" STD-N	260	0	0.0	4.2	SA106GB	6355A06T03	STOCK	
7	1 ER 6"/4" STD	0	0	0.0	4.0	SA234WPB			
6	1 TEE 6" STD	0	0	0.0	16.5	SA234WPB	7033409C09	703300-009	
5	1 PI 3" STD-N	236	0	0.0	2.7	SA106GB			
4	1 ER 6"/3" STD	0	0	0.0	3.8	SA234WPB			
3	1 PI 6" STD-N	1031	0	0.0	44.0	SA106GB	7033406T05	703300-006	
2	1 RP 300/178/13T	0	0	0.0	5.0	SA516G70N	7033401L05	703300-001	
03-05	1 F-6" 150# WNRFB	0	0	0.0	11.0	SA105	7033404F08	703300-004	

LIST OF MATERIAL

CHIYODA PETROSTAR LTD.
 JOB NO. 54001 IBN RUSHD AROMATICS PROJECT
 PO NO. SAY-POP0002
 REQ NO. MR-50-C-003
 IDENT NO. 54C01-DW-0005
 DATE Mar. 08 '97
 PURCHASER'S PERMISSION TO PROCEED OR REVIEW
 TAKEN ON VENDOR PRINTS SHALL NOT RELIEVE
 VENDOR FROM ITS RESPONSIBILITIES OR LIABILITIES
 UNDER PURCHASE ORDER.


REV.	DATE	DESCRIPTION	DRAWN	CHK'D	APP'D
1	8.3.97	REVISED AS PER CLIENT'S COMMENTS & ISSUED FOR CONSTRUCTION.	Rama rad		
0	19.2.97	ISSUED FOR APPROVAL	Rama rad	YOGESH HAIDER	AKB

SCALE: 1 : 30
 CLIENT: CHIYODA/IBN RUSHD.
 ORDER: SAY-POP0002
 APPROVED FOR CONSTRUCTION BY: AKB
 DATE: 8/3/97

BELLELI SAUDI **بياليبي السعودية**
 HEAVY INDUSTRIES LTD.
 AL- JUBAIL, KINGDOM OF SAUDI ARABIA.
 ARABIAN INDUSTRIAL FIBRES COMPANY (IBN RUSHD.)
 PTA & AROMATICS PROJECT - AROMATICS
 DEHEPTANIZER (54-C-01)


DETAIL OF INTERNALS
 DRAWING NO. DA-7033-03-005
 REV. 1

QUESTO DISEGNO NON PUO ESSERE COPIATO RIPRODOTTO
 MOSTRATO A TERZI SENZA NOSTRA AUTORIZZAZIONE
 THIS DRAWING IS NOT TO BE REPRODUCED IN WHOLE OR
 PART NOR EMPLOYED FOR ANY PURPOSE OTHER THAN SPECIFICALLY
 PERMITTED IN WRITING BY BELLELI SAUDI HEAVY IND.LTD.

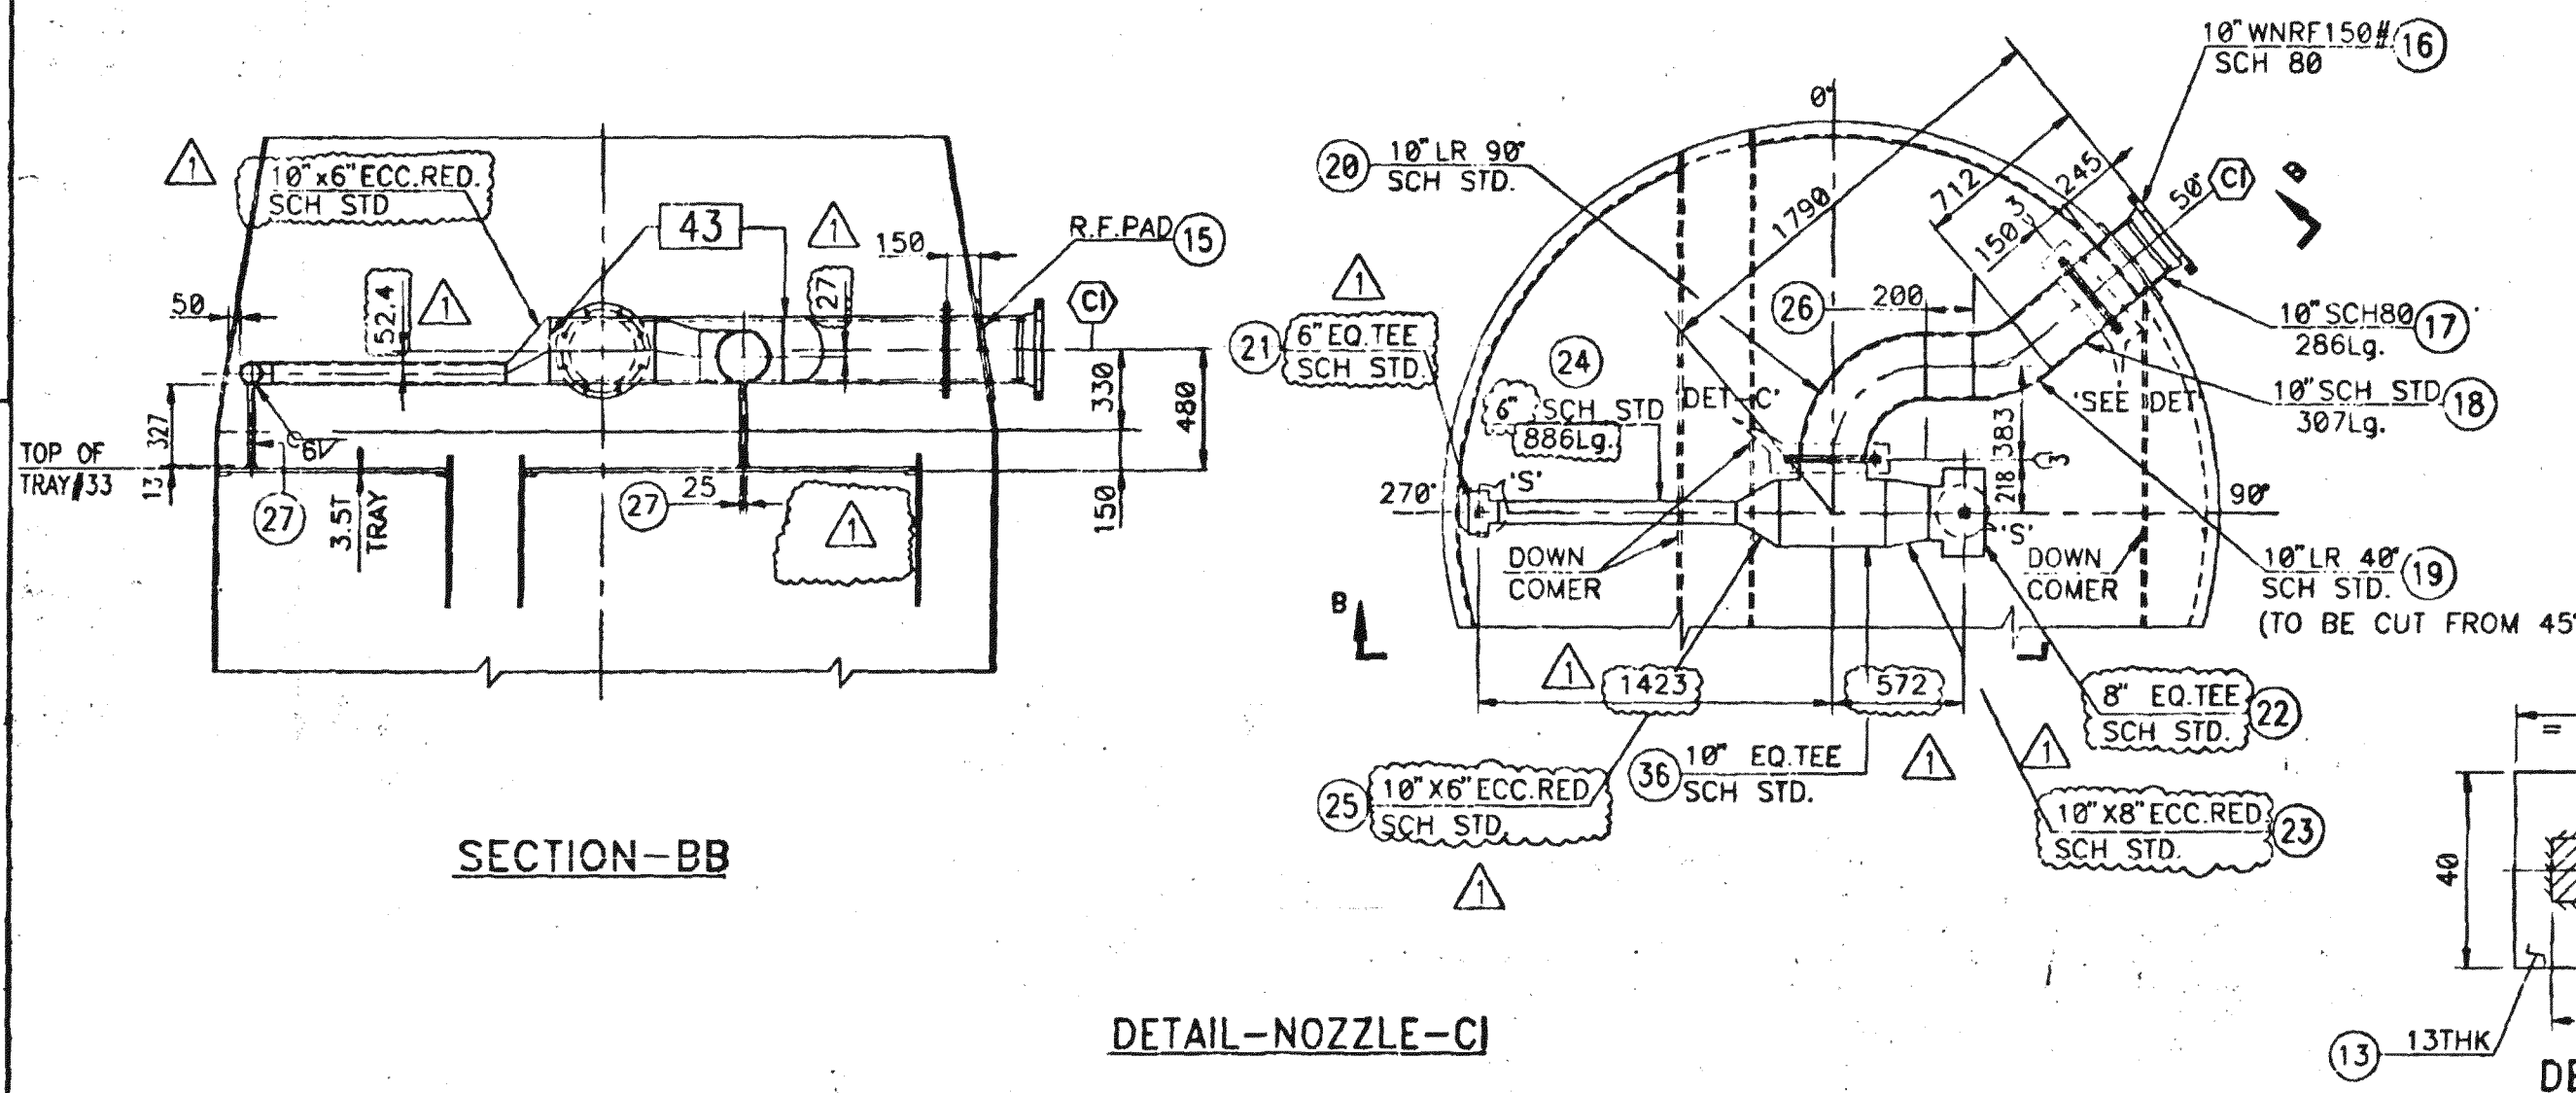




SECTION-BB

DETAIL-NOZZLE-CI


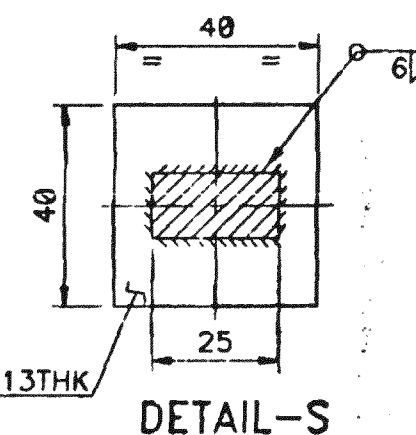


DETAIL-S

FILE NAME: 7033-03-005

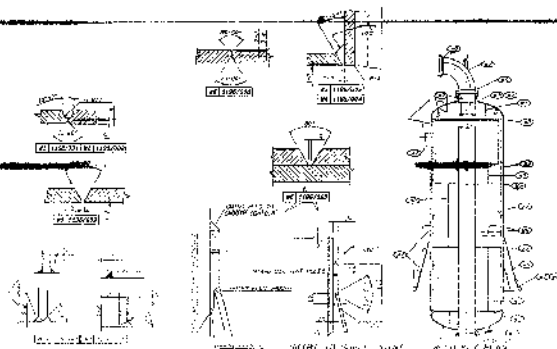
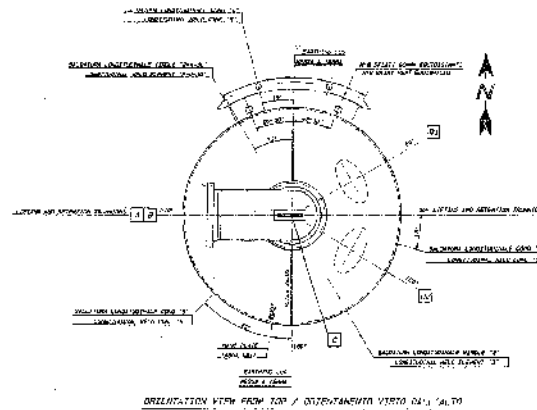
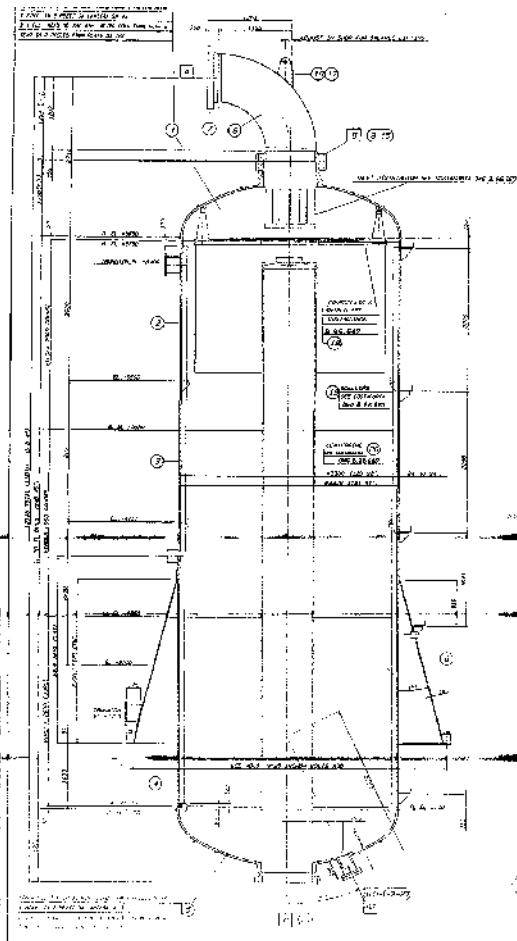


GENERAL INFORMATION																			
1. TITLE	REACTOR CORE DESIGN																		
2. PROJECT NO.	100-1000																		
3. DRAWING NO.	100-1000-100																		
4. SCALE	AS SHOWN																		
5. DATE	11/10/51																		
6. DRAWN BY	J. H. BROWN																		
7. CHECKED BY	J. H. BROWN																		
8. APPROVED BY	J. H. BROWN																		
9. REVISIONS	<table border="1"> <thead> <tr> <th>NO.</th> <th>DESCRIPTION</th> <th>DATE</th> </tr> </thead> <tbody> <tr> <td>1</td> <td>INITIAL DESIGN</td> <td>11/10/51</td> </tr> <tr> <td>2</td> <td>REVISION 1</td> <td>11/10/51</td> </tr> <tr> <td>3</td> <td>REVISION 2</td> <td>11/10/51</td> </tr> </tbody> </table>			NO.	DESCRIPTION	DATE	1	INITIAL DESIGN	11/10/51	2	REVISION 1	11/10/51	3	REVISION 2	11/10/51				
NO.	DESCRIPTION	DATE																	
1	INITIAL DESIGN	11/10/51																	
2	REVISION 1	11/10/51																	
3	REVISION 2	11/10/51																	
10. MATERIALS	<table border="1"> <thead> <tr> <th>PART</th> <th>MATERIAL</th> <th>QUANTITY</th> <th>UNIT</th> </tr> </thead> <tbody> <tr> <td>1</td> <td>STEEL</td> <td>100</td> <td>LB</td> </tr> <tr> <td>2</td> <td>BRASS</td> <td>50</td> <td>LB</td> </tr> <tr> <td>3</td> <td>COPPER</td> <td>25</td> <td>LB</td> </tr> </tbody> </table>			PART	MATERIAL	QUANTITY	UNIT	1	STEEL	100	LB	2	BRASS	50	LB	3	COPPER	25	LB
PART	MATERIAL	QUANTITY	UNIT																
1	STEEL	100	LB																
2	BRASS	50	LB																
3	COPPER	25	LB																
11. WEIGHT	100 LB																		
12. DIMENSIONS	100" x 100" x 100"																		
13. COMMENTS	REACTOR CORE DESIGN 100-1000 11/10/51																		
AS BUILT 100-1000 11/10/51																			
REVIEWED BY AUTH. INSPECTOR 100-1000 11/10/51																			
REACTOR 100-1000 11/10/51																			

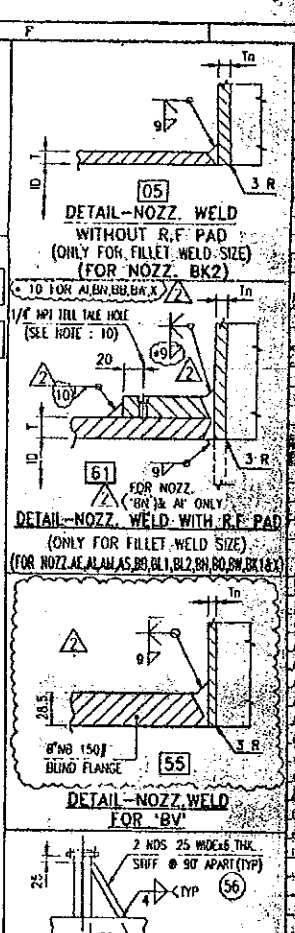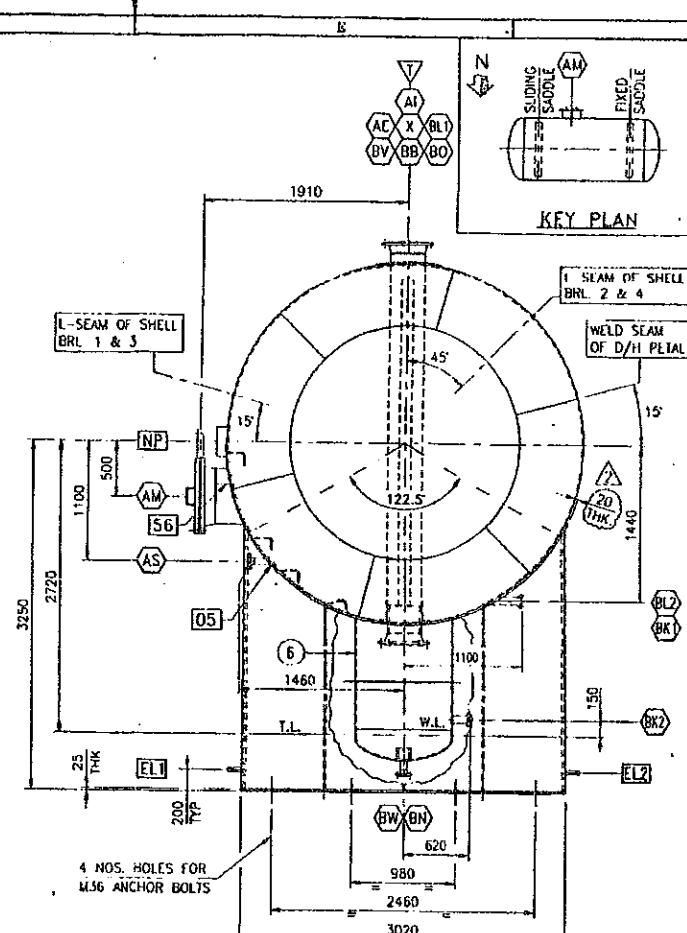

4.5mm THK SS 316 SPIRAL WOUND GRAPHITE FILLED WITH SS 316 INNER AND SS /CS OUTER CENTERING RING

</

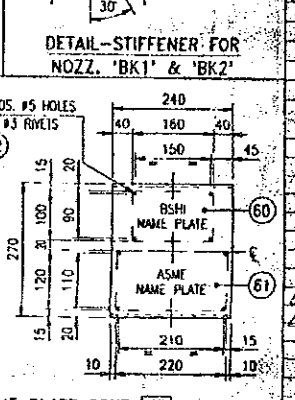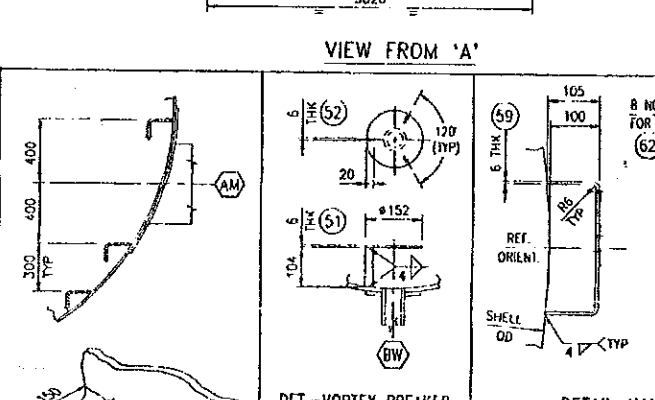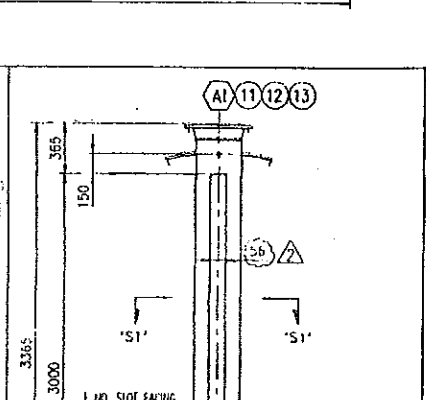

22. V - DENOTES TOP
21. FOR CARBON AND CARBON MANGANESE STEEL THE CARBON CONTENT SHALL BE LIMITED TO 0.25% MAXIMUM
20. THE LONGITUDINAL BEAD SEAMS OF NOZZLES INSTALLED HORIZONTALLY SHALL BE POSITIONED ABOVE CENTER LINE
19. BEAD SEAMS SHALL BE FULLY RADIOGRAPHED, HEAD TO SHELL SEAL SHALL BE SPOT RADIOGRAPHED
PER UW-11(c)(5)(D), OTHER SEAMS SHALL BE SPOT RADIOGRAPHED PER UW-11(b).
18. THE LONGITUDINAL BUTT WELD OF NOZZLES FABRICATED FROM PLATE SHALL BE 100% RADIOGRAPHED
17. MARK INDICATES THE BSHI WELD STANDARD NUMBER.
MARK INDICATES THE POSITION NUMBER WITH REFERENCE TO LIST OF MATERIAL
MARK INDICATES THE NOZZLE MARK NUMBER.

DET.-WORKER BREAKER		DETAIL NAME		
BOOF HEAD	SHELLS RELIEF WING	630 ± 10°C	205°C / MIN ABOVE 427°C	60 MIN
Part	Procedure	Holding temp. °C	Heating rate °C/h	Hold time min
HEAT TREATMENT				
33.	FABRICATION WEIGHT		Kg	
32.	FULL OF WATER WEIGHT		Kg	
31.	OPERATING WEIGHT		Kg	

minutes	260°C / HR UPIO 427°C	AS PER BELLEI STD. PROCEDURE PR-HIT-001
Cooling rate °C/h	Temperature measured furnace/part Qty of Sensors	
21000		
120800		
64900		

01	1	1	SHELL BL	-1	10411	3000	14 C	34325	34325	54516G70	7035401134	703300-001	
FAM.	ITEM	QTY	DESCRIPTION		LENGTH	WIDTH	THICK	WT. IN Kp.			MAT'L	MAT'L CODE*	RDA. NO.
								For ONE POS.	For ONE FAM.				

LIST OF MATERIAL

10411 3000 14 C 34325 34325 54516G70 7035401134 703300-001

ITEM QTY DESCRIPTION

CONTOGA PETROSTAR LTD.

JOB NO. 54001 TEL B30 ARMORY ROAD

PO NO. SAY-POFG001

16.	SHOP HYD. TEST GASKETS :- (1) BLINDED NOZZLES WILL HAVE JOB GASKETS. (2) ALL OTHER NOZZLES WILL HAVE CAF GASKET.				
15.	SPARE PARTS:	ITEMS	COMMISSIONING/STARTUP	OPERATIONAL	SHOP HYD. TEST
		GASKETS	200%	100%	100%
		FASTENERS	100%(MIN. 2 SETS)	100%(MIN. 2 SETS)	NOT REQUIRED
	QTY OF SPARES FOR GASKETS AND FASTENERS ARE INCLUDED IN LIST OF MATERIALS				
14.	ALL BOLTS & NUTS SHALL BE OF UNIFORM SIZE UP TO & INCLUDING 1" SIZE & RUN ABOVE 1" SIZE				
13.	FLANGES UP TO & INCLUDING 24" NB SHALL BE AS PER ANSI B16.5 & THE FLANGE FACE FINISH SHALL BE 3.2 TO 6.3 MICROMETER				
12.	CLEANED				
11.	MINIMUM TEMPERATURE OF HYDROTEST WATER SHALL BE 17°C AND THE TEST PRESSURE SHALL BE HELD FOR HALF AN HOUR PER INCH OF THICKNESS WITH ONE HOUR MINIMUM.				
10.	EACH REINFORCING PAD OR SEGMENT THEREOF SHALL BE PROVIDED WITH ONE No. (Two Nos. for NOZZLES 16" AND ABOVE & 180° APART) 1/4" HPT, TELL TALE HOLE AS PER ANSI B1.20.1. ALL R.F. PAD WELDS SHALL BE TESTED TO 15 PSIG MINIMUM WITH AIR & SOAPY BUBBLE TEST.				
9.	A PERMANENT REFERENCE WORKLINE FOR VERTICAL VESSELS' BOTTOM TAN LINE SHALL BE PUNCHMARKED AROUND THE VESSEL PERIMETER AT 0.90, 1.80 & 2.70' AND HORIZONTAL VESSELS, CENTER LEVEL SHALL BE PUNCHMARKED ON BOTH SIDE SURFACES OF SHELL NEAR THE HEAD.				
8.	THE VESSEL SHALL BE THOROUGHLY CLEANED INSIDE & OUTSIDE AND SHALL BE FREE OF ALL DIRT, WELD ROD STUBS & LOOSE FOREIGN MATERIALS ETC.				
7.	ALL REMOVABLE INTERNALS SHALL PASS THROUGH THE NEAREST MAINHOLE.				
6.	WELD SEAMS COMING UNDER MISG. ATTACHMENTS SHALL BE GRIND SMOOTH & RADIOGRAPHED FOR A DISTANCE OF 150mm BEYOND THE ATTACHMENT WELD				
5.	ALL NOZZLES AND MANWAY THAT DO NOT EXTEND INTO THE VESSEL SHALL BE FINISHED FLUSH WITH THE INSIDE & THE INNER EDGE SHALL BE ROUNDED OFF TO A MIN. 3mm RADIUS				
4.	NOZZLE POSITIONS ON VESSEL ELEVATIONS ARE CONVENTIONAL FOR THAT LOCATION SEE NOZZLE ORIENTATION PLAN.				
3.	NOZZLE PROJECTION IS FROM CENTER LINE OF VESSEL TO GASKET FACE OF FLANGE UNLESS SPECIFIED OTHERWISE.				
2.	ALL FLANGE BOLT HOLES SHALL STRADDLE VERTICAL AND/OR NORTH-SOUTH CENTER LINES UNLESS SHOWN OTHERWISE.				
1.	ALL DIMENSIONS ARE IN MILLIMETERS UNLESS OTHERWISE SPECIFIED.				

GENERAL NOTES

X	Y	Z	DESCRIPTION
1	6"	1865	RELIEF
BW	1	2"	SEE DGC DRAIN W/VB
BV	1	2"	SEE DGC VENT
BO	1	4"	1815 BLANKETING
BN	1	12"	1865 OUTLET W/VB
BL2	1	2"	SEE DGC LEVEL
BL1	1	2"	1815 LEVEL
BK2	1	1 1/2"	SEE DGC LEVEL
BK1	1	1 1/2"	SEE DGC LEVEL
BS	1	8"	1865 VENTILATION W/BF
AS	1	2"	SEE DGC STIFAMOUT
AM	1	20"	SEE DGC MAINWAY W/BF + DAVIT
AI	1	12"	1865 INLET W/INT. DISTR. PIPE
AE	1	3"	1815 EQUALIZING
			O.D. SC
			NOZZLE

DETAIL-INTERNAL LUG

Technical drawing of a detail-internal lug. The drawing shows a cross-section of a lug with various dimensions: a total width of 145, a central hole diameter of 22, a hole offset of 9, a thickness of 12 THK, a fillet radius of R 10, and a distance of 30 from the edge to the hole center. A dimension of 58 is shown for the outer radius. A note '25' is also present near the hole.

DETAIL-EARTHING LUG

	27.0	WNRI	300#	300	14				
15	11.07	WNRI	150#	150	10				
20	8.74	WNRI	150#						
20	11.15	WNRI	150#	210	14				
20	10.748	WNRI	150#	610	14				
20	8.74	WNRI	150#	150	14				
20	8.74	WNRI	150#						
20	14.5	WNRI	150#						
20	14.5	WNRI	150#	SEE DWG.					
20	12.7	WNRI	150#	400	14				
20	8.74	WNRI	150#	150	14				
20	7.12	WNRI	150#	970	14				
20	17.748	WNRI	150#	610	14				
20	11.13	WNRI	150#	180	14				
20	THK.	TYPE	RATING LB	O.D.	THK				
20	NOZZ.	FLANGE	REIN.	PAD					

29.	ERECTOR WEIGHT	Kg
29.	MANUFACTURER'S SERIAL NO.	
28.	MANUFACTURER'S JOB NUMBER	
27.	MANUFACTURER'S NAME	
26.	CODE STAMP	
25.	DESIGN CODE	
24.	SERVICE	
23.	VOLUME	m ³
22.	FIREPROOFING	mm
21.	INSULATION	mm
20.	SPECIFIC GRAVITY	
19.	OPERATING FLUID	
18.	INSPECTION AUTHORITY	
17.	WIND SPEED/EXPOSURE CATEGORY	km/hr
16.	EARTHQUAKE DESIGN	
15.	MINIMUM DESIGN METAL TEMPERATURE	°C
14.	CHARPY IMPACT TEST	
13.	ULTRASONIC EXAMINATION	
12.	POST WELD HEAT TREATMENT	
11.	JOINT EFFICIENCY (SHELL/HEAD)	%
10.	RADIOGRAPHY (SHELL/HEAD)	
9.	CORROSION ALLOWANCE	mm
8.	M.A.W.P. AT DESIGN TEMPERATURE	bars
7.	M.A.P. (NEW & COLD)	bars
6.	FIELD HYDROTEST PRESSURE (CORRODED)	bars
5.	SHOP HYDROTEST PRESSURE (HOB)	bars
4.	OPERATING TEMPERATURE	°C
3.	OPERATING PRESSURE	bars
2.	DESIGN TEMPERATURE (INT/EXT)	°C
1.	DESIGN PRESSURE (INT/EXT)	bars
No.	DESIGN CONDITIONS	UNITS

NOZZ.

DESIGN D

21000	
2408	
7034-42	
PELLELLI SAUDI HEAVY IND. LTD.	
YES	
ASME SEC VIII DIV.1	
1995 EDITION	
BENZENE COLUMN RECEIVER	
94.69	
75-AROUND SADDLES (BY OTHERS)	
40-HOI ON BOOT ONLY (BY OTHERS)	
0.616	
HYDROCARBON	
CLIENT/ABS	
125/C	
ASCE 7-88 ZONE 1	
9 0	
NO	
NO	
NO	
85/100	
R14 AS PER UG-116(c) SEE NOTE 19	
3.0 (6.0 FOR BOOT)	
6.67 (LIMITED BY SHELL)	
8.66 (LIMITED BY SHELL)	
10 0	
12.54 (AT TOP)	
B2.0	
121.0/82 0	
3.6/FV	
VALUES	

RECD BY: 		REC NO. MR-50-D-011 IDENT NO. 56001-DW-0001	
1. APPROVED 2. REVISIONS 3. COMMENTS 4. DATE		5. SIGNATURE 6. DATE	
THIS DOCUMENT IS LOANED TO YOU BY THE NATIONAL BUREAU OF STANDARDS-101 UNDER PURCHASE ORDER			

2	12.03.97	REVISED AS PER CLIENT'S COMMENTS AND MARKED	RUP	7/8/97	1
1	02.11.96	CLIENT'S COMMENTS REVISED & ISSUED FOR CONSTRUCTION	DERECK	AL/HWEEK	AKB
0	20.06.96	ISSUED FOR APPROVAL & INTERNAL COMMENTS	DERECK	AL/HWEEK	AKB
REV.	DATE	DESCRIPTION	DRAWN	CHK'D	APP

NO. REQUIRED: 1 : 3		BELLELI SAUDI, بيليلي السعودية HEAVY INDUSTRIES LTD. AL - JUBAIL, KINGDOM OF SAUDI ARABIA. المملكة العربية السعودية الجبيل	
CLIENT: JHIYODA/IBN RUSHD ORDER: SAY-POPO000		ARABIAN INDUSTRIAL FIBRES COMPANY (IBN RUSHD) PTA & AROMATICS PROJECT - AROMATICS BENZENE COLUMN RECEIVER (58-D-D1) GENERAL ASSEMBLY	
APPROVED FOR CONSTRUCTION DATE: 04.11.96	APPROVED FOR CONSTRUCTION DATE: 04.11.96	APPROVED FOR CONSTRUCTION DATE: 04.11.96	APPROVED FOR CONSTRUCTION DATE: 04.11.96

APPROVED FOR CONSTRUCTION DATE: 04.11.96	APPROVED FOR CONSTRUCTION DATE: 04.11.96	APPROVED FOR CONSTRUCTION DATE: 04.11.96	APPROVED FOR CONSTRUCTION DATE: 04.11.96
---	---	---	---

APPROVED FOR CONSTRUCTION DATE: 04.11.96	APPROVED FOR CONSTRUCTION DATE: 04.11.96	APPROVED FOR CONSTRUCTION DATE: 04.11.96	APPROVED FOR CONSTRUCTION DATE: 04.11.96
---	---	---	---

APPROVED FOR CONSTRUCTION DATE: 04.11.96	APPROVED FOR CONSTRUCTION DATE: 04.11.96	APPROVED FOR CONSTRUCTION DATE: 0
---	---	--------------------------------------

BELLELI SAUDI HEAVY INDUSTRIES LTD. AS BUILT CERTIFIED BY <u> </u>		CHIHODA PETROSTAR LTD. JOB NO. 54001 ENR RUSH AROMATICS PROJECT PO NO. SAY-POP0001 REC. NO. WFR-50-0-011 IDENT. NO. 580032-04-0001 ☒	
ALL INFORMATION CONTAINED HEREIN IS UNCLASSIFIED DATE <u> </u> BY <u> </u> EXCEPT WHERE SHOWN OTHERWISE THIS DOCUMENT IS THE PROPERTY OF CHIHODA PETROSTAR LTD. IT IS TO BE RETURNED TO THE COMPANY IMMEDIATELY UPON REQUEST NO REPRODUCTION OR DISSEMINATION OF THIS INFORMATION IS TO BE MADE WITHOUT THE WRITTEN PERMISSION OF CHIHODA PETROSTAR LTD. UNLESS OTHERWISE SPECIFIED IN THE CONTRACT		PLACARDS FOR INFORMATION IN PROJECTS OF REVENUE THEIR OR VOUCHER POINTS SHALL NOT BE VOUCHER FROM THE RESPONSIBILITIES OR DAMAGES UNDER PURCHASE ORDER	

REV.	DATE	DESCRIPTION	DRAWN	CHK'D	APP'D
3	03.07.97	REVISED AS MARKED Δ & AS BUILT.	R. AL	MOHAMMAD	
2	13 Mar 97	REVISED AS MARKED Δ AS PER CLIENT'S COMMENTS	Arum	R. AL	AKB
1	11.11.96	DWG. GENERALLY REVISED & ISSUED FOR CONSTRUCTION	DERECK	R. AL HADER	AKB
0	05.06.96	ISSUED FOR APPROVAL & INTERNAL COMMENTS	SURFRAZ	R. AL R. AL	NATH

No. REQUIRED : 1 UNIT					
-----------------------	--	--	--	--	--

SCALE 1:30 CLIENT CHIHODA/IBN RUSHO ORDER SAY-POP0001 APPROVED FOR CONSTRUCTION BY A.K. BAKR/RE DATE 16 Nov '98	بيلعلي السعودية HEAVY INDUSTRIES LTD. AL - KHARJ, KINGDOM OF SAUDI ARABIA ARABIAN INDUSTRIAL FIBRES COMPANY (IBN RUSHO) PTA & AROMATICS PROJECT-AROMATICS TOLUENE CUMULUM RECEIVERS (580032-02) GENERAL ASSEMBLY	المصنعات البتروكيمياوية المحدودة الجبيل
--	--	--

QUESTO DISEGNO NON PUO' ESSERE COPIATO REPRODUCED NOTRATO A TELER SENZA NOSTRA AUTORIZAZIONE	DRAWING NO.	REV.
---	-------------	------

THIS DRAWING IS NOT TO BE REPRODUCED IN WHOLE OR PART NOR EMPLOYED FOR ANY PURPOSE OTHER THAN SPECIFICALLY PERMITTED BY WRITING BY BELLELI SAUDI HEAVY IND LTD	DA-7034-43-001	3
--	----------------	---

REV	DATE	REASON FOR REVISION	BY	CHK	APP
1	96.12	REVISED AS MARKED	D.C. KIM	SHIM	WON
2	96.12	REVISED AS MARKED	D.C. KIM	SHIM	WON
3	96.12	REVISED AS MARKED	D.C. KIM	SHIM	WON
4	96.12	REVISED AS MARKED	D.C. KIM	SHIM	WON





REV	DATE	REASON FOR REVISION	BY	CHK	APP
1	96.12	REVISED AS MARKED	D.C. KIM	SHIM	WON
2	96.12	REVISED AS MARKED	D.C. KIM	SHIM	WON
3	96.12	REVISED AS MARKED	D.C. KIM	SHIM	WON
4	96.12	REVISED AS MARKED	D.C. KIM	SHIM	WON

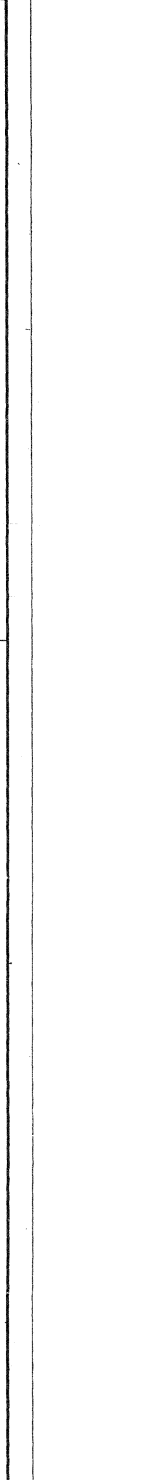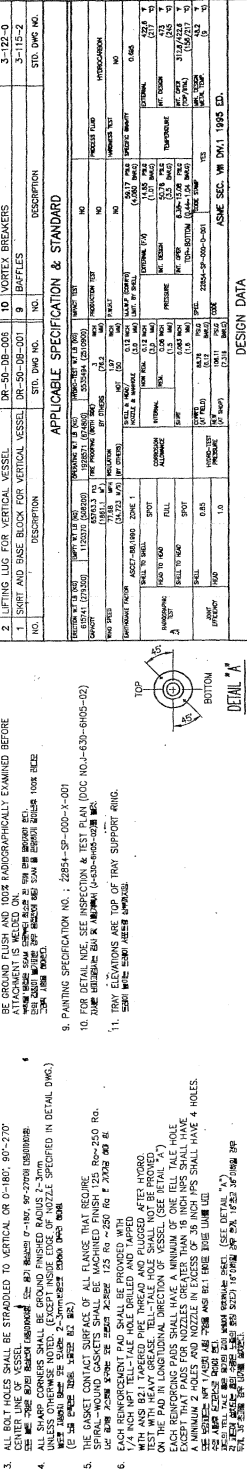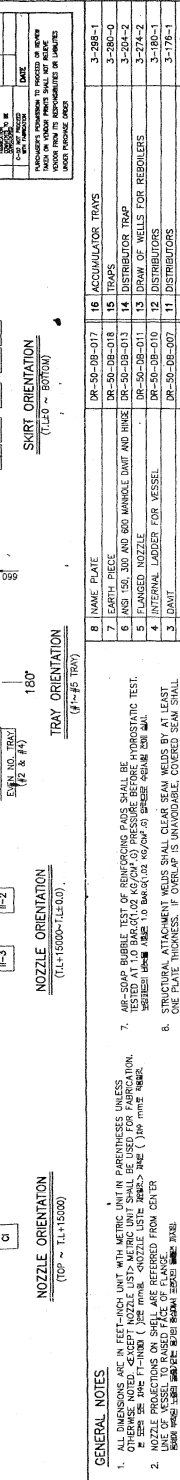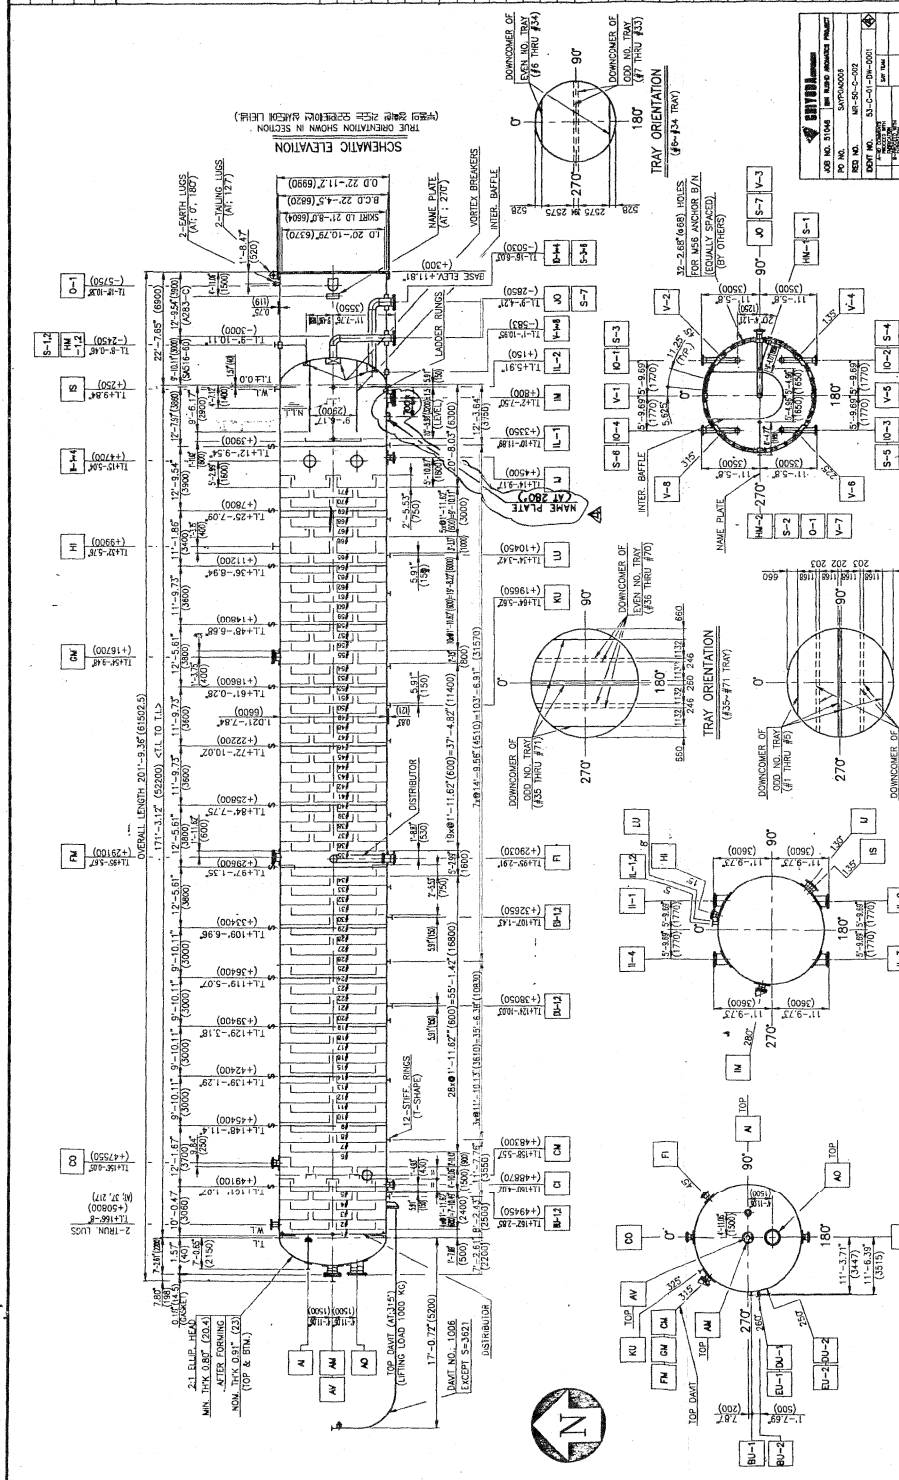


REV	DATE	REASON FOR REVISION	BY	CHK	APP
1	96.12	REVISED AS MARKED	D.C. KIM	SHIM	WON
2	96.12	REVISED AS MARKED	D.C. KIM	SHIM	WON
3	96.12	REVISED AS MARKED	D.C. KIM	SHIM	WON
4	96.12	REVISED AS MARKED	D.C. KIM	SHIM	WON

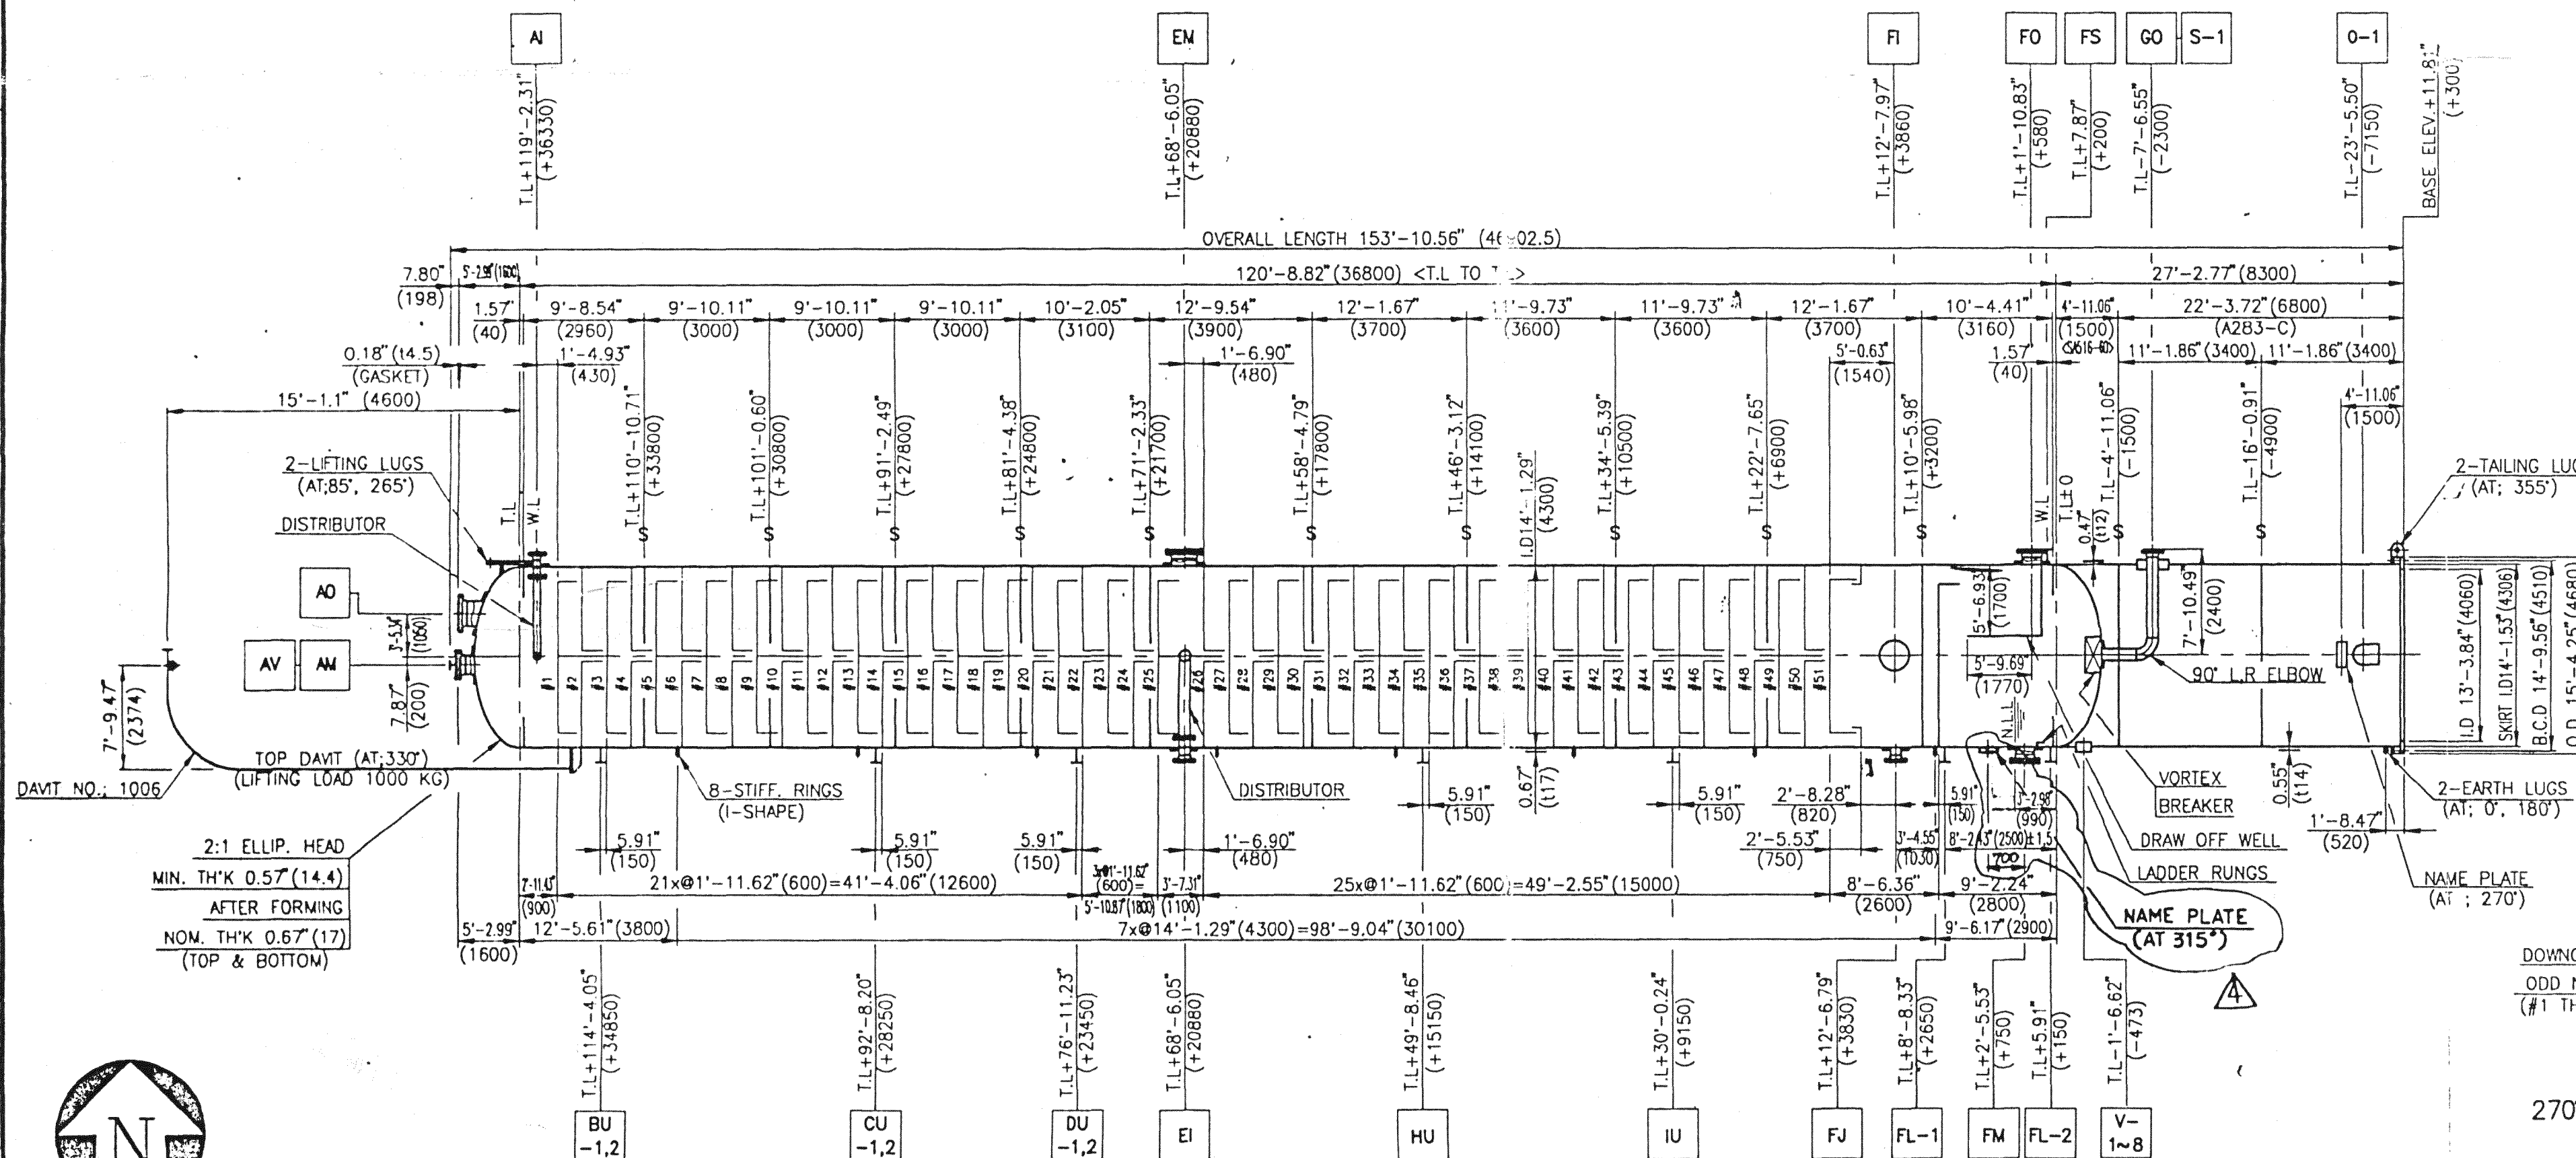


SCHEMATIC ELEVATION
TRUE ORIENTATION SHOWN IN SECTION
(부품의 실제 위치는 단면도에 따라 나타냄)

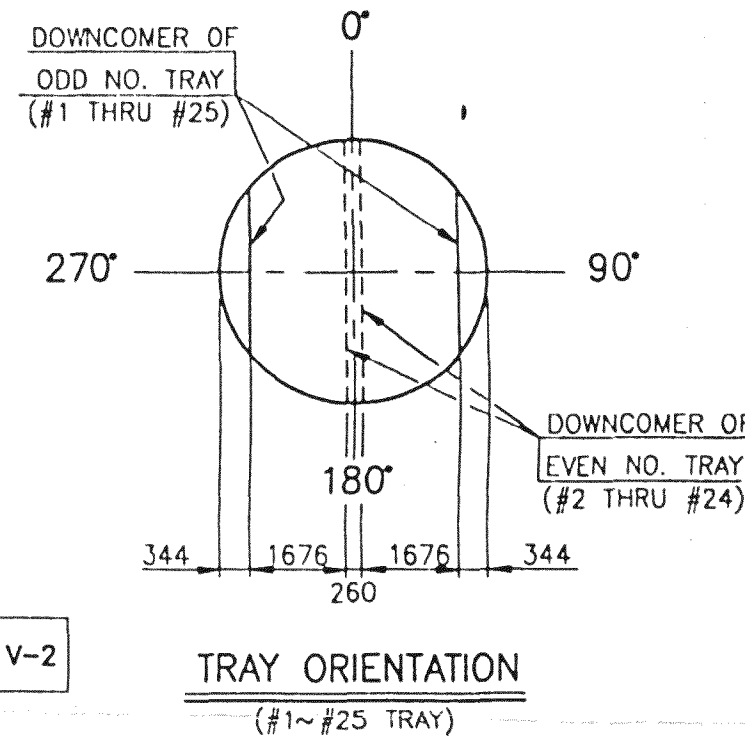


TRAY ORIENTATION
(#1~#25 TRAY)

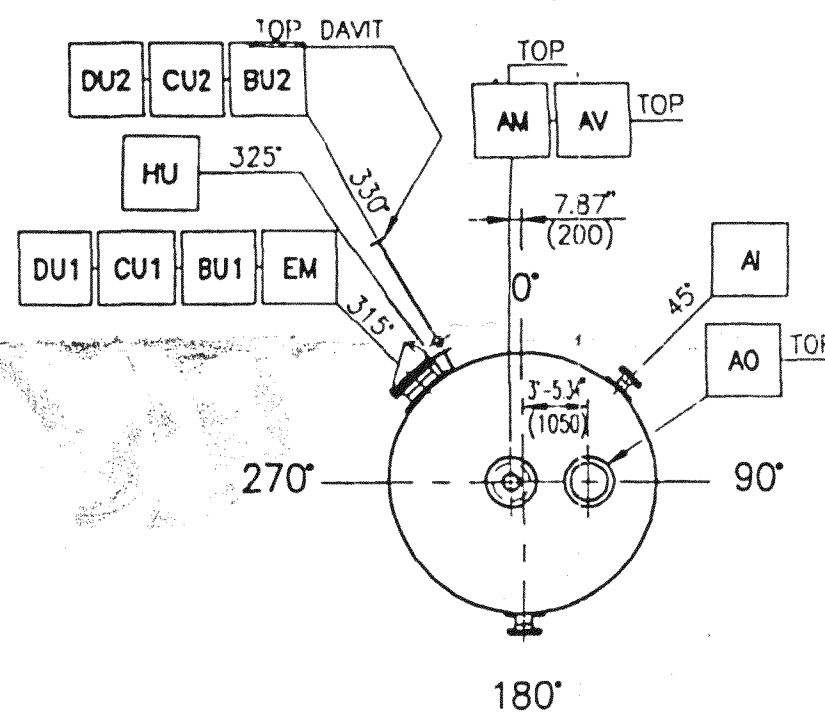


NOZZLE ORIENTATION
(TOP~T.L+15000)

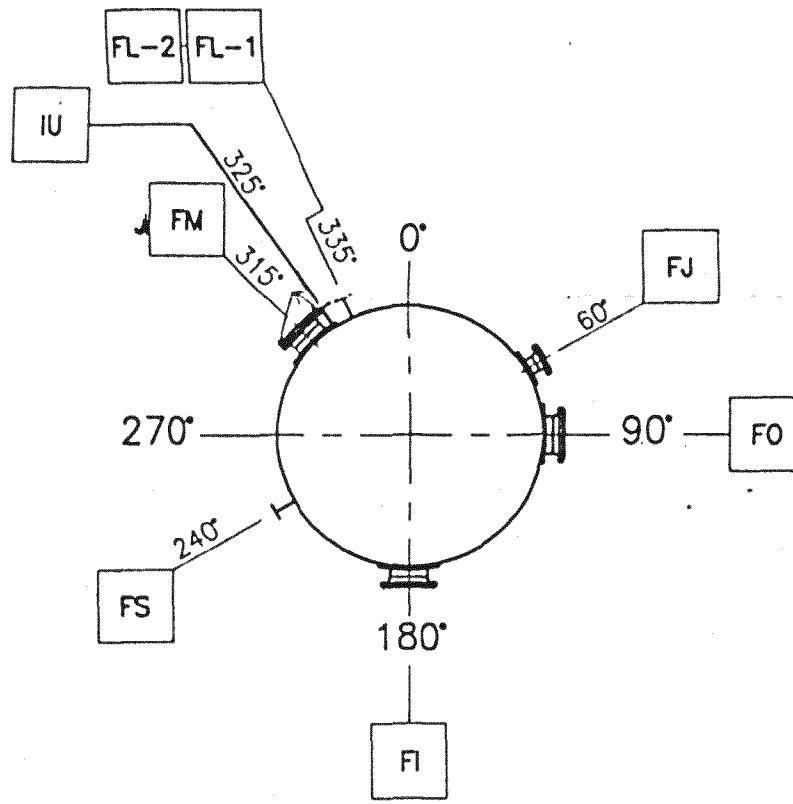

NOZZLE ORIENTATION
(T.L+15000~T.L+0)

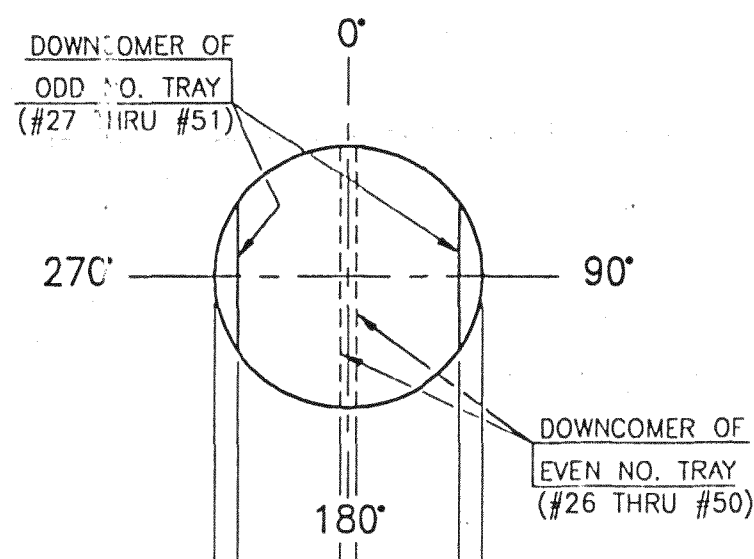

TRAY ORIENTATION
(#26~#51 TRAY)

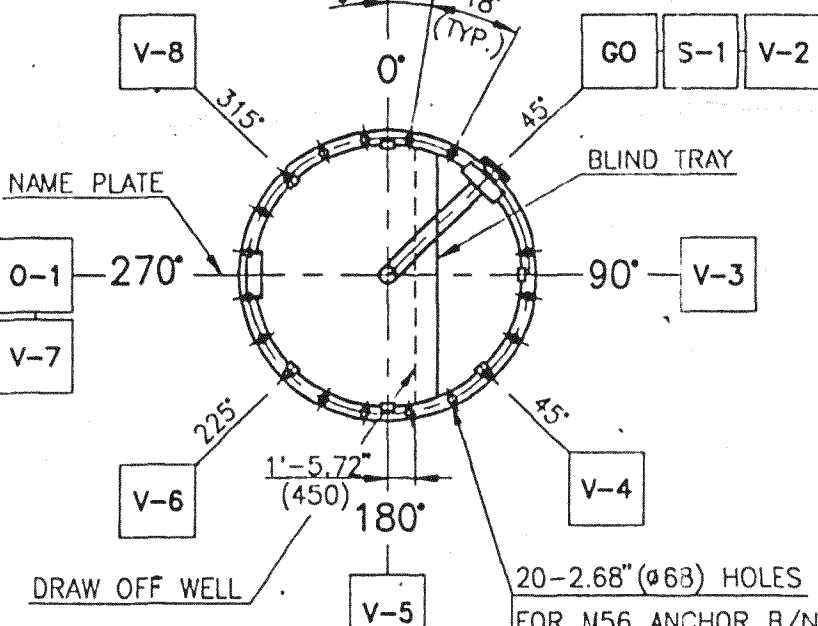


SKIRT ORIENTATION
(T.L+0 ~ BOTTOM)

JOB NO. 51046		IBN RUSHD AROMATICS PROJECT	
PO NO. SAYPOAD006		REV. NO. 53-C-02-002	
IDENT NO. 53-C-02-DW-0001		DATE	
A-NO. 53-C-02-DW-0001		DATE	
C-NO. 53-C-02-DW-0001		DATE	

GENERAL NOTES

- ALL DIMENSIONS ARE IN FEET-INCH UNIT WITH METRIC UNIT IN PARENTHESES UNLESS OTHERWISE NOTED. (EXCEPT NOZZLE LIST) METRIC UNIT SHALL BE USED FOR FABRICATION. (단, 단면도 및 상세도에는 mm로 표시함. (NOZZLE LIST는 제외함) 단면도 및 상세도에는 mm로 표시함.)
- NOZZLE PROJECTIONS ON SHELL ARE REFERRED FROM CENTER LINE OF VESSEL TO RAISED FACE OF FLANGE. (단면도 및 상세도에는 8개의 중심선에서 0.125인치 (3.175mm)를 기준으로 표시함.)
- ALL BOLT HOLES SHALL BE STRADDLED TO VERTICAL OR 0°-180°, 90°-270° CENTER LINE OF VESSEL. (단면도 및 상세도에는 8개의 중심선에서 0.125인치 (3.175mm)를 기준으로 표시함.)
- ALL SHARP CORNERS SHALL BE ROUNDED FINISHED RADIUS 2-3mm UNLESS OTHERWISE NOTED. (EXCEPT INSIDE EDGE OF NOZZLE SPECIFIED IN DETAIL DWG.) (단면도 및 상세도에는 8개의 중심선에서 0.125인치 (3.175mm)를 기준으로 표시함.)
- THE GASKET CONTACT SURFACE OF ALL FLANGE THAT REQUIRE SPIRAL-WOUND GASKETS SHALL BE MACHINED FINISH 125 Ra~250 Ra. (단면도 및 상세도에는 8개의 중심선에서 0.125인치 (3.175mm)를 기준으로 표시함.)
- EACH REINFORCEMENT PAD SHALL BE PROVIDED WITH 1/4 INCH NPT TELL-TALE HOLE DRILLED AND TAPPED WITH 1/4 INCH NPT TAPERED PIPE THREADED AND PLUGGED AFTER HYDRO TEST WITH HEAVY GREASE. TELL TALE HOLE SHALL NOT BE PROVIDED ON THE PAD IN LONGITUDINAL DIRECTION OF VESSEL. (SEE DETAIL "A") EACH REINFORCING PADS SHALL HAVE A MINIMUM OF ONE TELL TALE HOLE EXCEPT THAT PADS FOR NOZZLES GREATER THAN 16 INCH NPS SHALL HAVE A MINIMUM 2 HOLES AND NOZZLE IN EXCESS OF 36 INCH NPS SHALL HAVE 4 HOLES. (단면도 및 상세도에는 8개의 중심선에서 0.125인치 (3.175mm)를 기준으로 표시함.)
- AIR-SOAP BUBBLE TEST OF REINFORCING PADS SHALL BE TESTED AT 1.0 BAR.G (1.02 KG/CM².G) PRESSURE BEFORE HYDROSTATIC TEST. (단면도 및 상세도에는 8개의 중심선에서 0.125인치 (3.175mm)를 기준으로 표시함.)
- STRUCTURAL ATTACHMENT WELDS SHALL CLEAR SEAM WELDS BY AT LEAST ONE-PLATE THICKNESS. IF OVERLAP IS UNAVOIDABLE, COVERED SEAM SHALL BE GROUND FLUSH AND 100% RADIOGRAPHICALLY EXAMINED BEFORE ATTACHMENT IS WELDED ON. (단면도 및 상세도에는 8개의 중심선에서 0.125인치 (3.175mm)를 기준으로 표시함.)
- PAINTING SPECIFICATION NO. : 22854-SP-000-X-001
- FOR DETAIL NDE, SEE INSPECTION & TEST PLAN (DOC NO. J-631-6H05-02) (단면도 및 상세도에는 8개의 중심선에서 0.125인치 (3.175mm)를 기준으로 표시함.)
- TRAY ELEVATIONS ARE TOP OF TRAY SUPPORT RING. (단면도 및 상세도에는 8개의 중심선에서 0.125인치 (3.175mm)를 기준으로 표시함.)

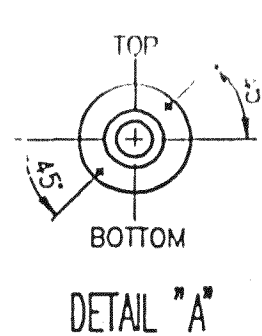

NO.	DESCRIPTION	STD. DWG. NO.	NO.	DESCRIPTION	STD. DWG. NO.
7	EARTH PIECE	DR-50-DB-018	13	TRAPS	3-280-0
6	ANSI 150, 300 AND 600 MANHOLE DAVIT AND HINGE	DR-50-DB-013	12	DISTRIBUTORS	3-150-3
5	FLANGED NOZZLE	DR-50-DB-011	11	DRAW OF WELLS FOR REBOILERS	3-274-1
4	INTERNAL LADDER FOR VESSEL	DR-50-DB-010	10	DISTRIBUTORS	3-162-1
3	DAVIT	DR-50-DB-007	9	VORTEX BREAKERS	3-122-0
2	LIFTING LUG FOR VERTICAL VESSEL	DR-50-DB-006	8	NAME PLATE	DR-50-DB-017
1	SKIRT AND BASE BLOCK FOR VERTICAL VESSEL	DR-50-DB-001			

APPLICABLE SPECIFICATION & STANDARD

ITEM	DESCRIPTION	STANDARD
1	DESIGN	ASME SEC. VIII DIV.1 1995 ED.
2	MATERIAL	ASME SEC. VIII DIV.1 1995 ED.
3	WELDING	ASME SEC. VIII DIV.1 1995 ED.
4	PAINTING	22854-SP-000-D-001
5	INSULATION	22854-SP-000-D-001
6	REINFORCEMENT	22854-SP-000-D-001
7	SKIRT	22854-SP-000-D-001
8	DAVIT	22854-SP-000-D-001
9	LIFTING LUG	22854-SP-000-D-001
10	INTERNAL LADDER	22854-SP-000-D-001
11	DRAW OF WELLS	22854-SP-000-D-001
12	DISTRIBUTORS	22854-SP-000-D-001
13	TRAPS	22854-SP-000-D-001

REV.	DATE	REASON FOR REVISION	DWN.	CHK.	APP.
1	'96.7.2	REVISED AS MARKED	D.C.KWAG	G.Y.SHIN	D.H.WON
2	'96.8.19	REVISED AS-MARKED	D.C.KWAG	G.Y.SHIN	D.H.WON
3	'96.11.21	REVISED AS MARKED			
4	'96.11.21	REVISED AS MARKED			

(*) : INTEGRAL SELF-REINFORCING FLANGE.

ITEM	NO.	SIZE	TYPE	QTY	REMARK
V-1~8	8	4"	40	-	SKIRT VENT
S-1	1	1.63 (40.6)	(11)	-	SKIRT SLEEVE
O-1	1	1.63 (40.6)	(11)	-	SKIRT ACCESS

ITEM	NO.	SIZE	TYPE	QTY	REMARK
HU/10	2	1" I.D.	ANSI 150#	2317	-
GO	1	10"	80	17	510
FS	1	2"	160	17	150
FO	1	18"	0.47 (112)	2417	17 870
FM	1	24"	0.47 (112)	2467	17 1150
FL-12	2	2"	160	2317	17 130
FJ	1	10"	80	2367	17 510
FI	1	34"	0.47 (112)	2467	17 1300
EM	1	24"	0.47 (112)	2467	17 1150
EI	1	10"	80	2367	17 510
DU-12	2	1" I.D.	ANSI 150#	2317	-
DU-12	2	1" I.D.	ANSI 150#	2317	-
BU-12	2	1" I.D.	ANSI 150#	2317	-
AV	1	2"	160	2367	17 510
AO	1	24"	0.47 (112)	2467	17 1150
AM	1	24"	0.47 (112)	2467	17 1150
AI	1	6"	80	2367	17 300

NOZZLE LIST






* : SPIRAL WOUND 316 S.S W/GRAPHITE FILLER 316 S.S I.R. & C.S O.R.

ITEM	NO.	SIZE	TYPE	QTY	REMARK
SKIRT	SAS16-60	HEAD	SAS16-60	INSULATION SUPPORT	SAS16-60/A283-C
SKIRT	SAS16-60/A283-C	LIFTING LUG / PAD	A283-C/SAS16-60	VORTEX BREAKER	SAS16-60
SKIRT	SAS16-60/A283-C	TRAY SUPPORT	SAS16-60	TRAY SUPPORT	SAS16-60
SKIRT	SAS16-60/A283-C	MANHOLE NECK	SAS16-60	MANHOLE NECK	SAS16-60
SKIRT	SAS16-60/A283-C	NAME PLATE/BRAKET	SAS16-60	NAME PLATE/BRAKET	SAS16-60
SKIRT	SAS16-60/A283-C	EARTH LUG	304 S.S/A283-C	EARTH LUG	304 S.S
SKIRT	SAS16-60/A283-C	INTERNAL RING	A36	INTERNAL RING	A36
SKIRT	SAS16-60/A283-C	ANCHOR BOLT/NUT	A307-B/A563-A	ANCHOR BOLT/NUT	A307-B/A563-A









MATERIAL SPECIFICATION

ITEM	NO.	SIZE	TYPE	QTY	REMARK
SKIRT	SAS16-60	HEAD	SAS16-60	INSULATION SUPPORT	SAS16-60/A283-C
SKIRT	SAS16-60/A283-C	LIFTING LUG / PAD	A283-C/SAS16-60	VORTEX BREAKER	SAS16-60
SKIRT	SAS16-60/A283-C	TRAY SUPPORT	SAS16-60	TRAY SUPPORT	SAS16-60
SKIRT	SAS16-60/A283-C	MANHOLE NECK	SAS16-60	MANHOLE NECK	SAS16-60
SKIRT	SAS16-60/A283-C	NAME PLATE/BRAKET	SAS16-60	NAME PLATE/BRAKET	SAS16-60
SKIRT	SAS16-60/A283-C	EARTH LUG	304 S.S/A283-C	EARTH LUG	304 S.S
SKIRT	SAS16-60/A283-C	INTERNAL RING	A36	INTERNAL RING	A36
SKIRT	SAS16-60/A283-C	ANCHOR BOLT/NUT	A307-B/A563-A	ANCHOR BOLT/NUT	A307-B/A563-A

2:1 ELLIP. HEAD
MIN. TH'K 14.4
AFTER FORMING
NOM. TH'K 17
2
02

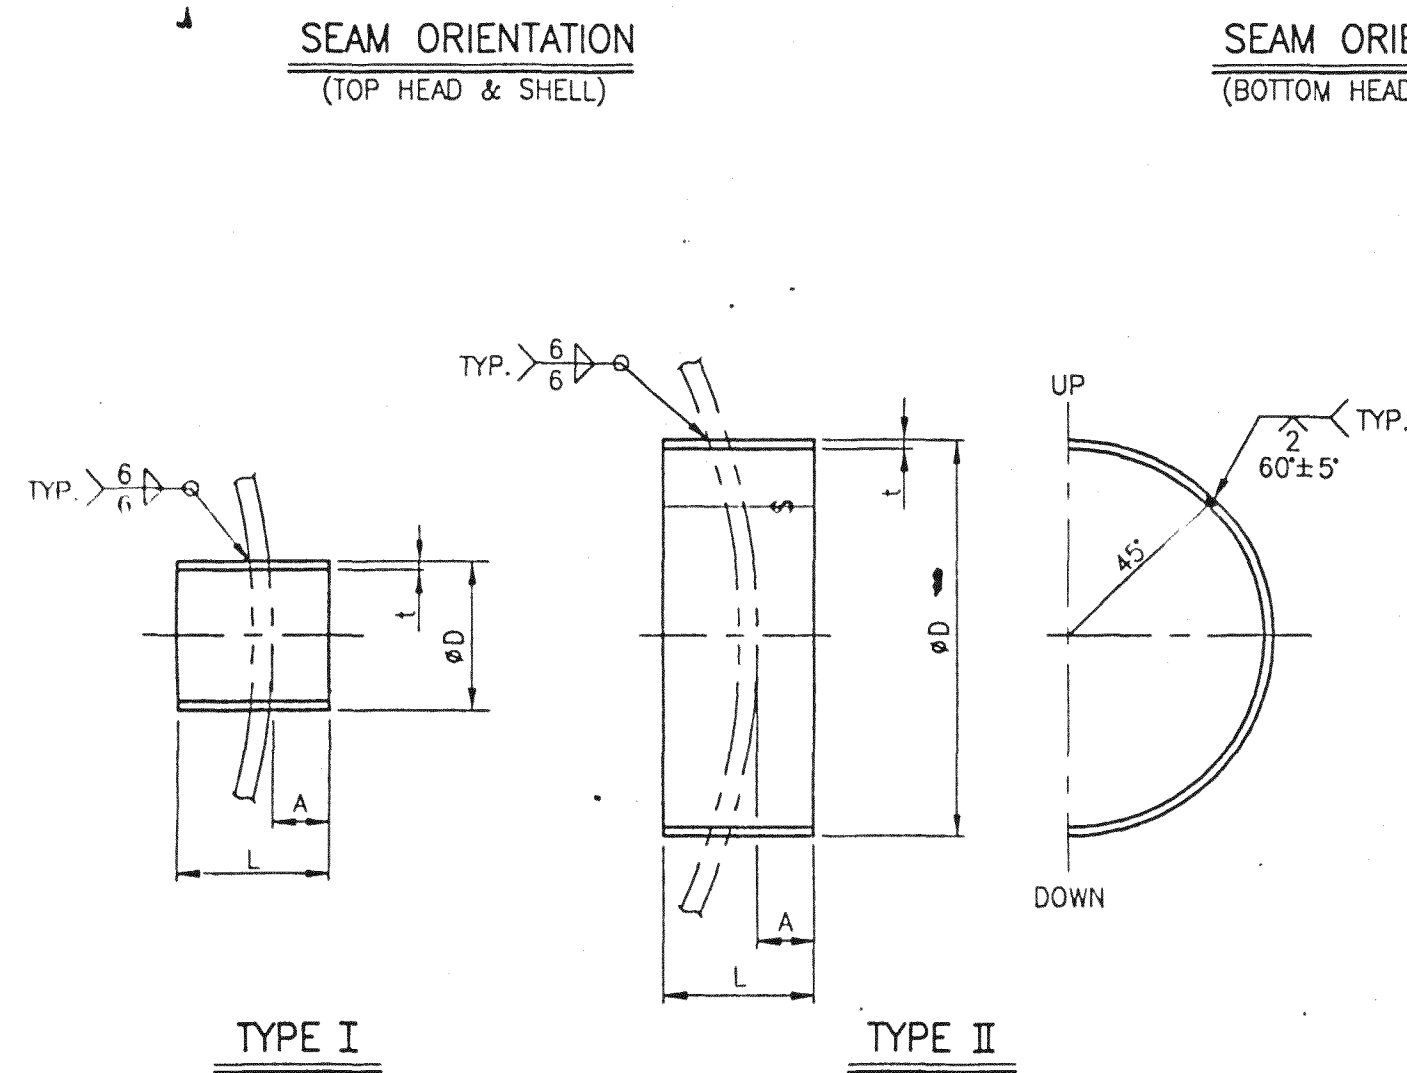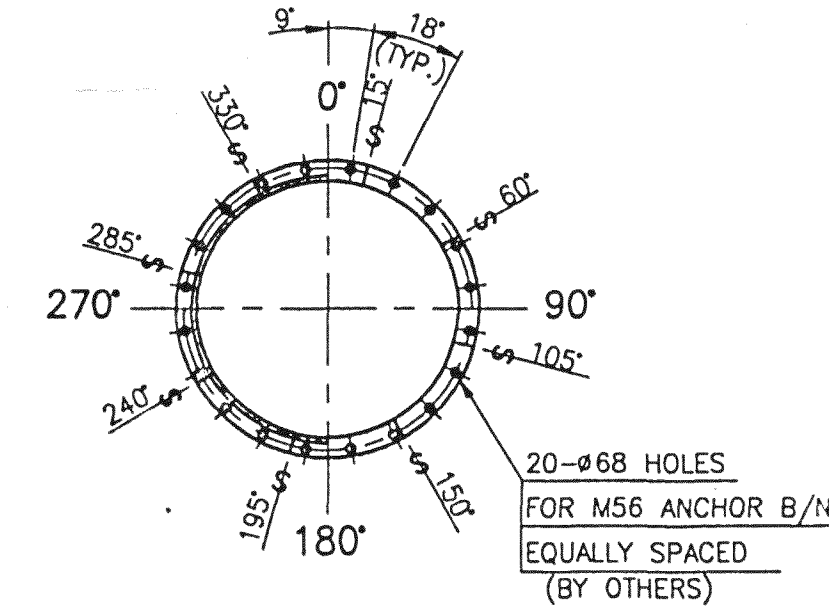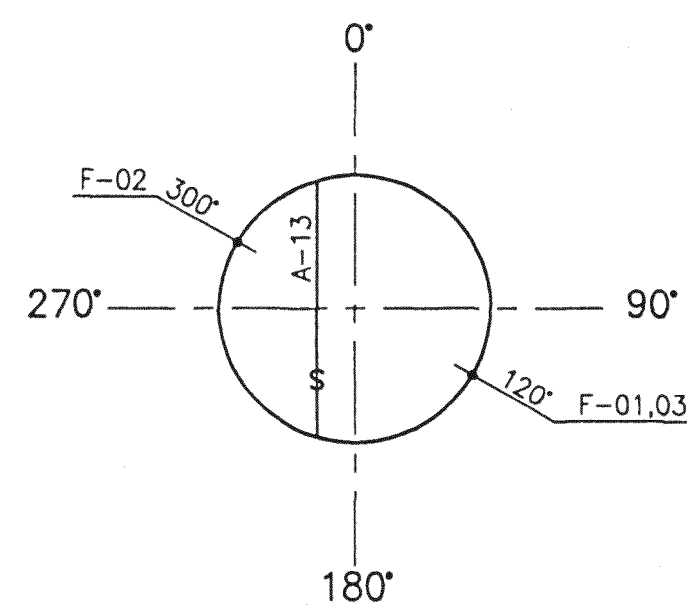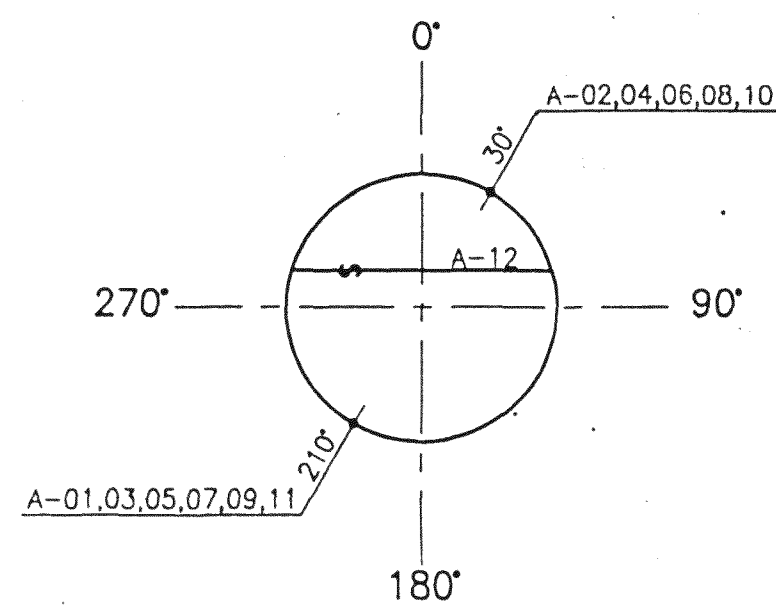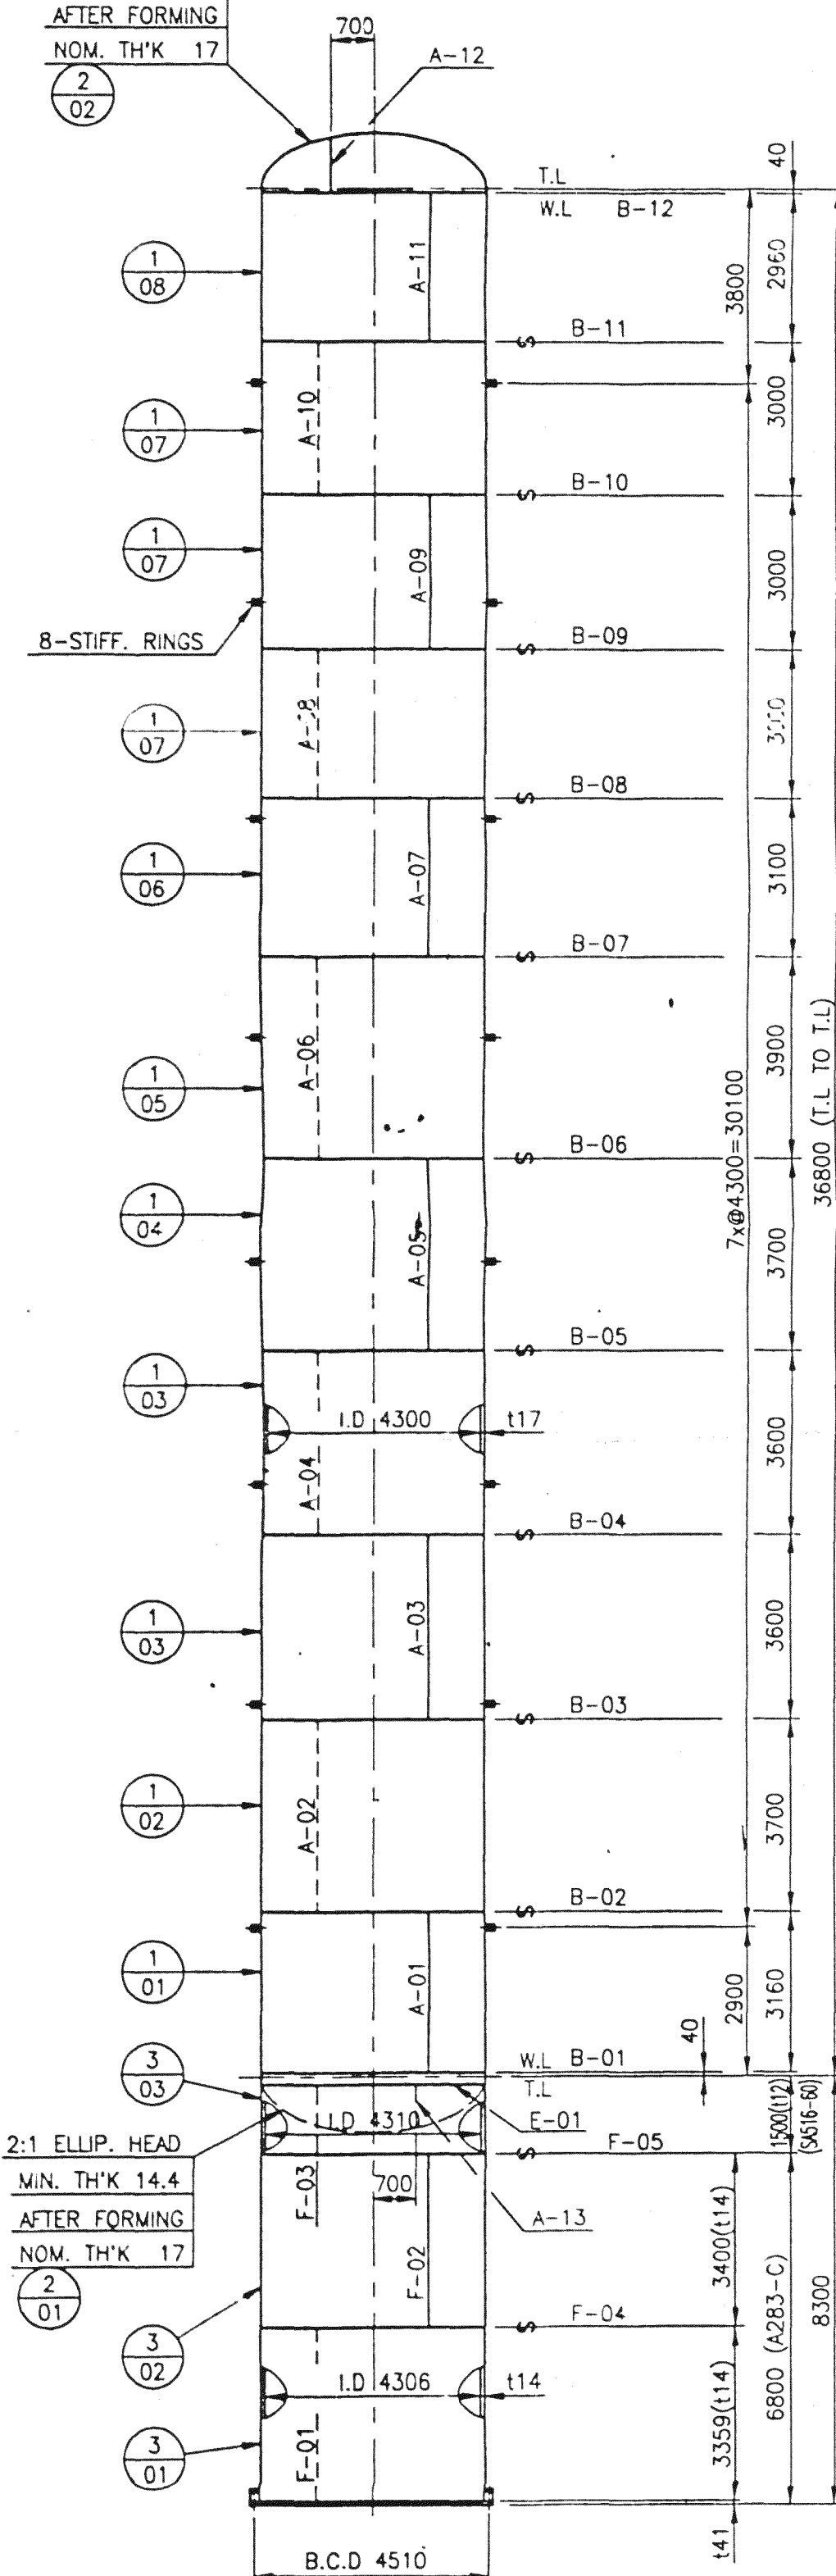

MARK	PART NO.	PART NAME	DIMENSIONS				TYPE	QTY	REMARKS
V-1~8	3 08	SKIRT VENT	114.3	6.0	90	193	I	8	4"XS/40
O-1	3 09	SKIRT ACCESS	522	11	90	210	III	1	
S-1	3 10	SKIRT SLEEVE	492	11	90	208	II	1	

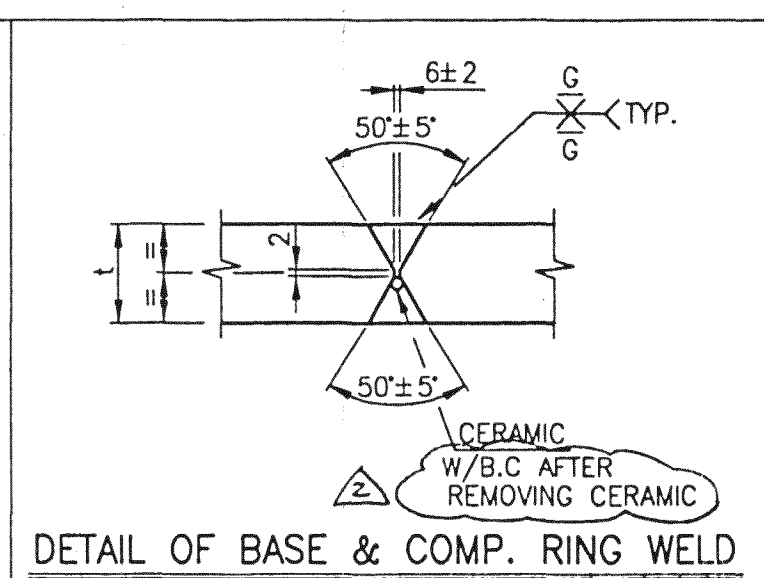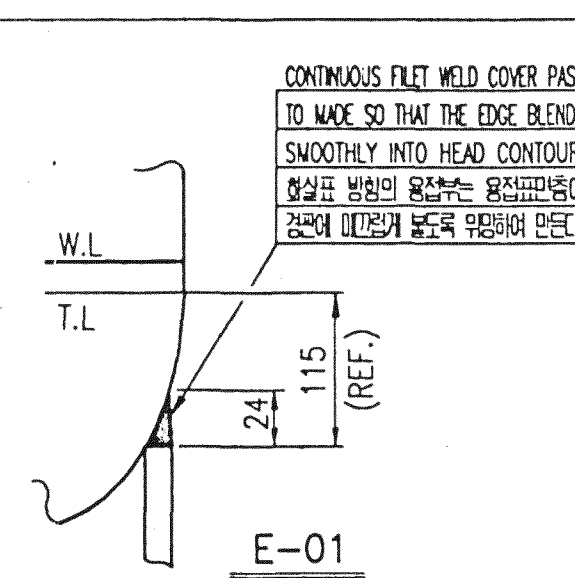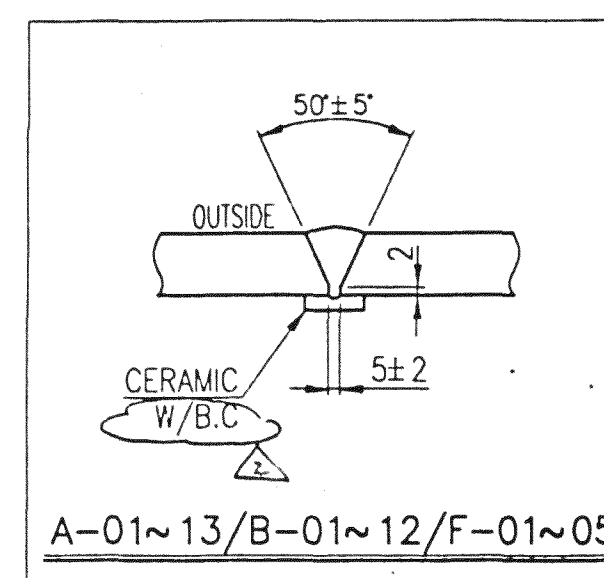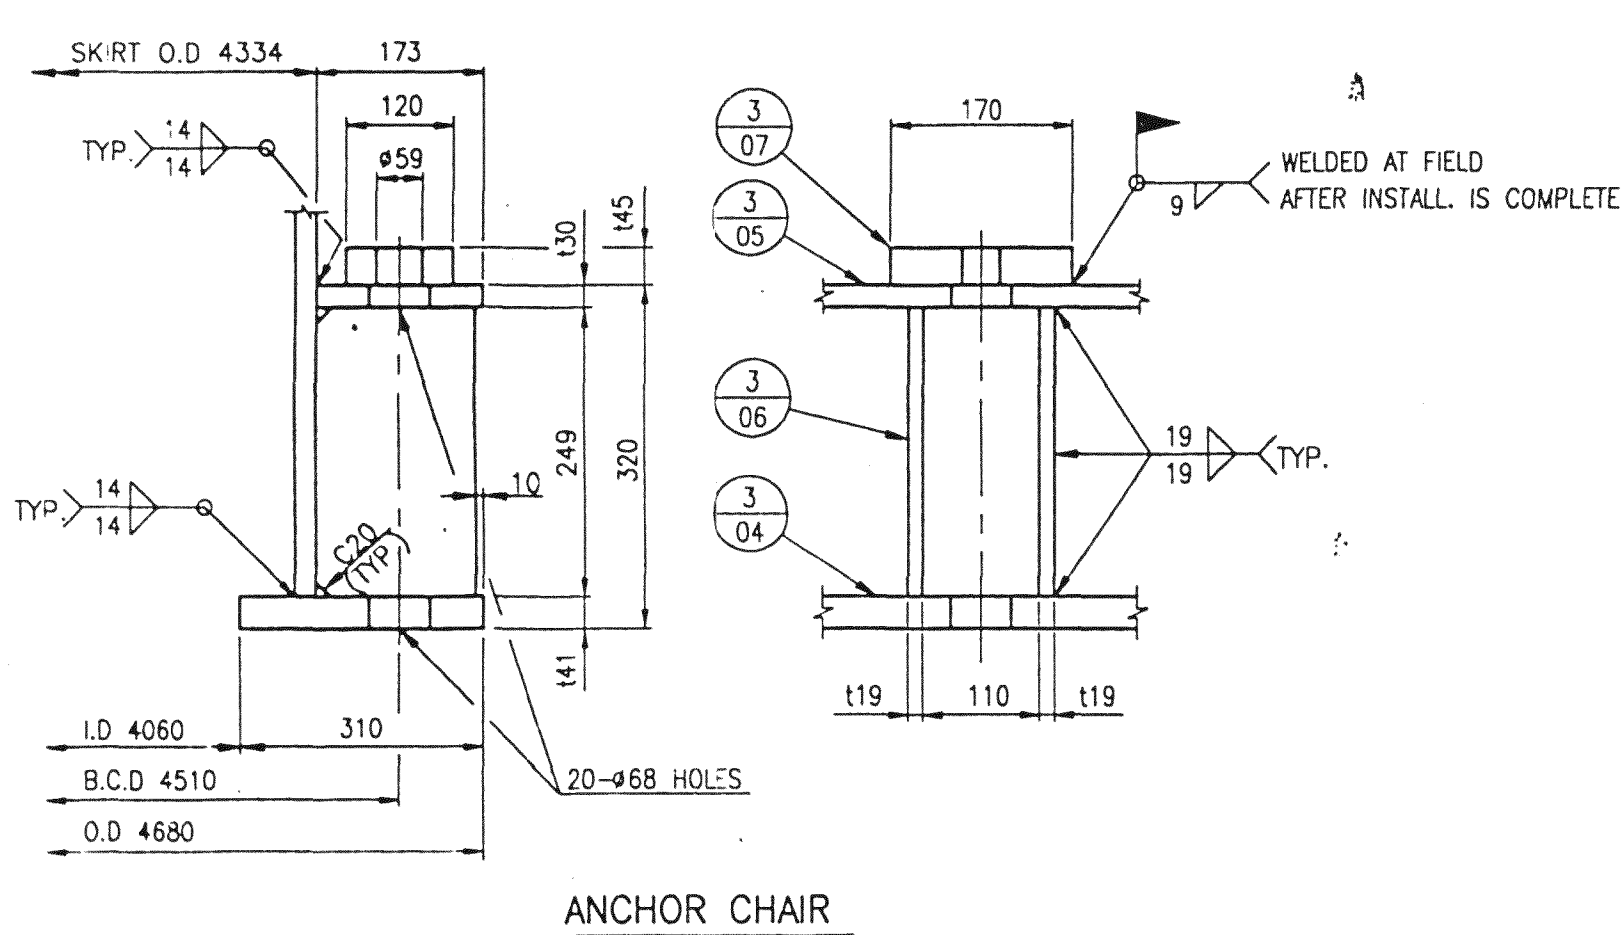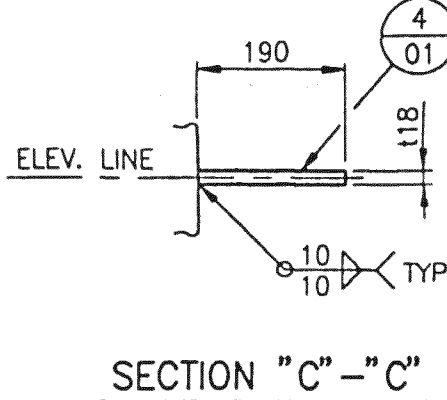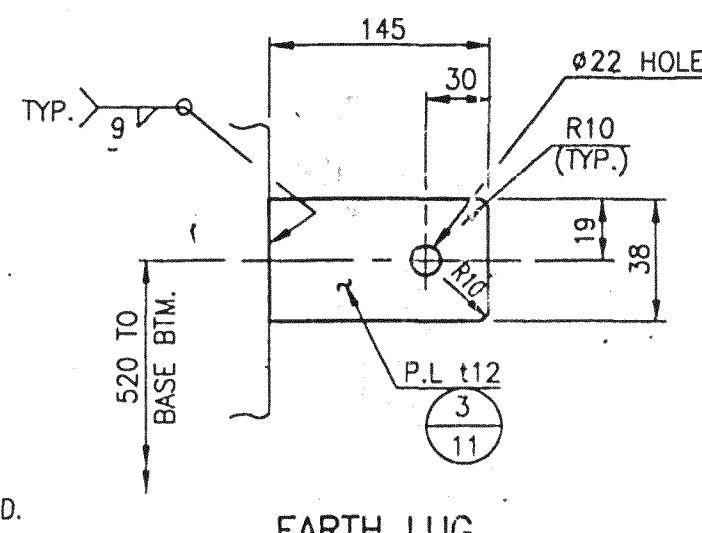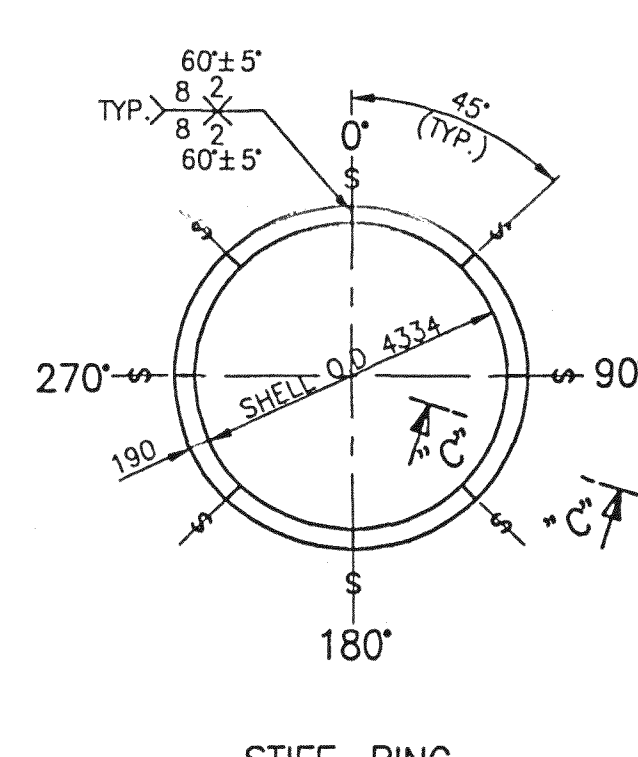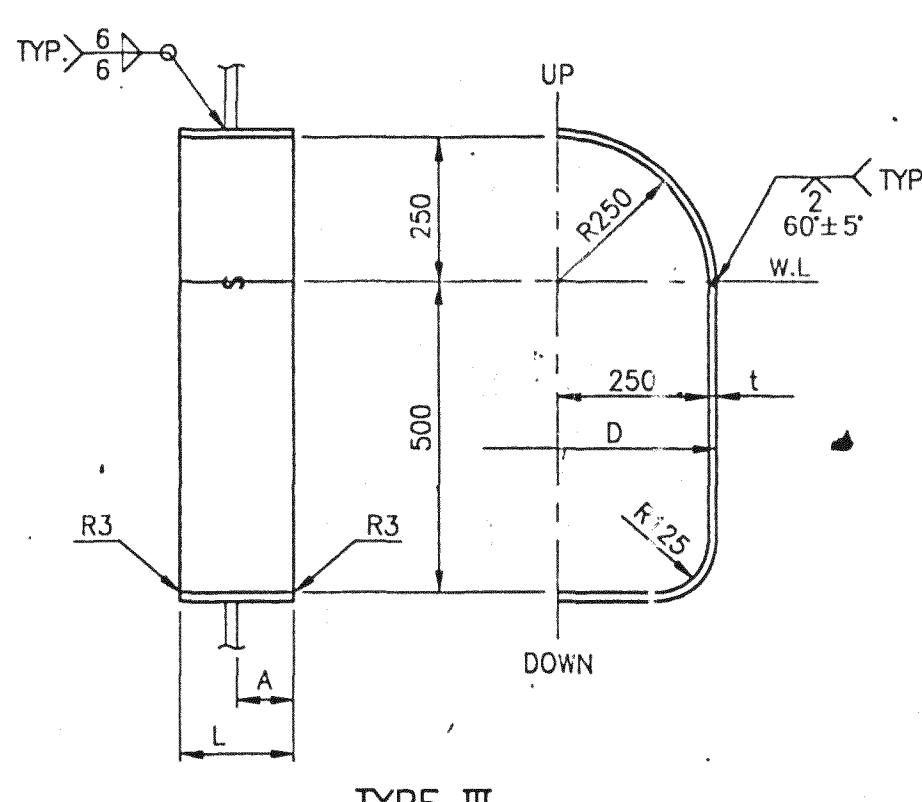










JOB NO. 51046		IBN RUSHD AROMATICS PROJECT	
P.O. NO.	SAYPOA0006	MR-50-C-002	
REQ. NO.	MR-50-C-002		
IDENT NO.	53-C-02-DW-0002		
DATE			
PURCHASER'S PERMISSION TO PROCEED OR REVIEW TAKEN ON VENDOR PRINTS SHALL NOT RELIEVE VENDOR FROM ITS RESPONSIBILITIES OR LIABILITIES UNDER PURCHASE ORDER			

M/K	DATE	REASON FOR REVISION	DWN	CHK	APP
△	'96.7.18	REVISED AS MARKED	D.C.KWAG	G.Y.SHIN	D.H.WON
△	'96.9.20	REVISED AS MARKED			
△					

4	01	STIFF. RING	SA516-60	t18x1.D4334x0.D4714	8	3053	8 SEGT	
3	11	EARTH LUG	304 S.S	t12x38x145	2	1		
10		SKIRT SLEEVE	A283-C	t11x208x1511	1	28		
09		SKIRT ACCESS	A283-C	t11x210x2213	1	41		
08		SKIRT VENT	A53-B	4"XS/40-193L	8	25		
07		WASHER PLATE	A283-C	t45x120x170	20	144		
06		GUSSET PLATE	A283-C	t19x163x249	40	242		
05		COMP. RING PLATE	A283-C	t30x1.D4334x0.D4680	1	577	8 SEGT	
04		BASE RING PLATE	A283-C	t41x1.D4060x0.D4680	1	1370	8 SEGT	
03		SKIRT PLATE	SA516-60	t12x1385x13578	1	1772		
02		SKIRT PLATE	A283-C	t14x3400x13572	1	5072		
3	01	SKIRT PLATE	A283-C	t14x3359x13572	1	5010		
2	02	2:1 ELLIP. HEAD	SA516-60	t17x1.D4300, SF40	1	2853	2 SEGT	
2	01	2:1 ELLIP. HEAD	SA516-60	t17x1.D4300, SF40	1	2853	2 SEGT	
1	08	SHELL PLATE	SA516-60	t17x2960x13562	1	5357		
07				t17x3000x13562	3	16289		
06				t17x3100x13562	1	5611		
05				t17x3900x13562	1	7059		
04				t17x3700x13562	1	6696		
03				t17x3600x13562	2	13031		
02				t17x3700x13562	1	6696		
1	01	SHELL PLATE	SA516-60	t17x3160x13562	1	5720		

PART NO.	PART NAME	MATERIALS	DIMENSIONS	QTY	WEIGHT (KG)	REMARKS
51046	IBN RUSHD PTA & AROMATICS PROJECT-AROMATICS					
P/O NO.	SAYPOA0006	ARABIAN INDUSTRIAL FIBERS CO., LTD.				
MR. SER. NO.	PV-97-038					
DWN	D.C.KWAG	'96.5.21				
DES	Y.S.JUNG	'96.5.23				
CHK	G.Y.SHIN	'96.5.27				
APP	D.H.WON	'96.5.28				
THIRD ANGLE PROJECTION	SCALE	REF. DWG. NO.	DWG. NO.			
	NONE		67069-0502			

INDUSTRIAL PLANT DIVISION		HYUNDAI	
ULSAN KOREA		HEAVY INDUSTRIES CO., LTD.	

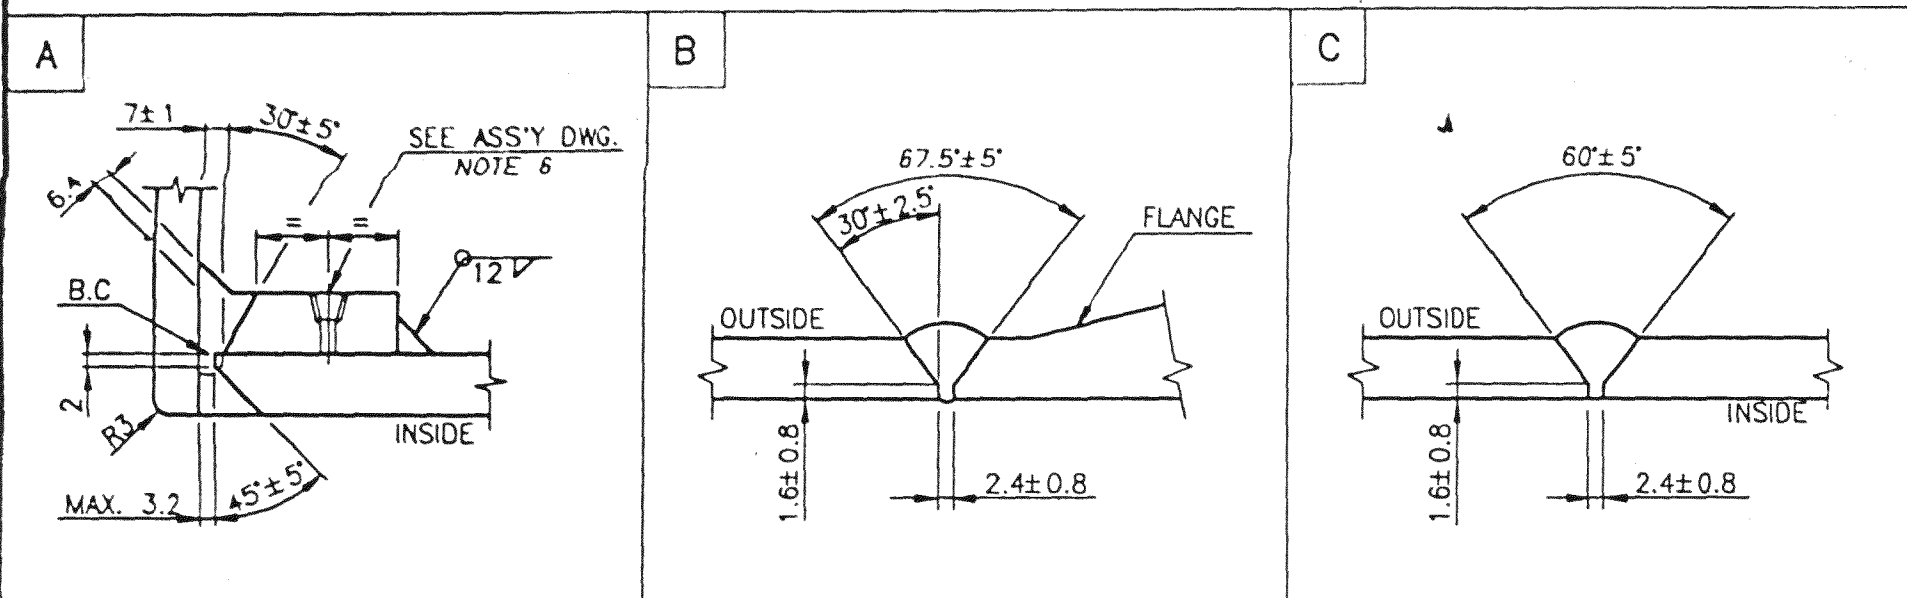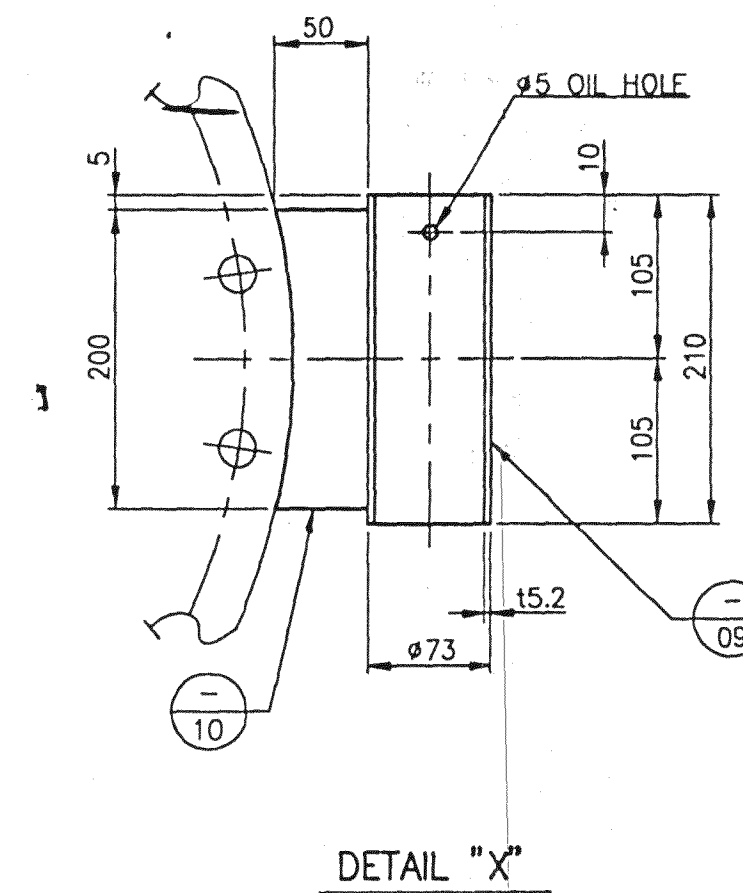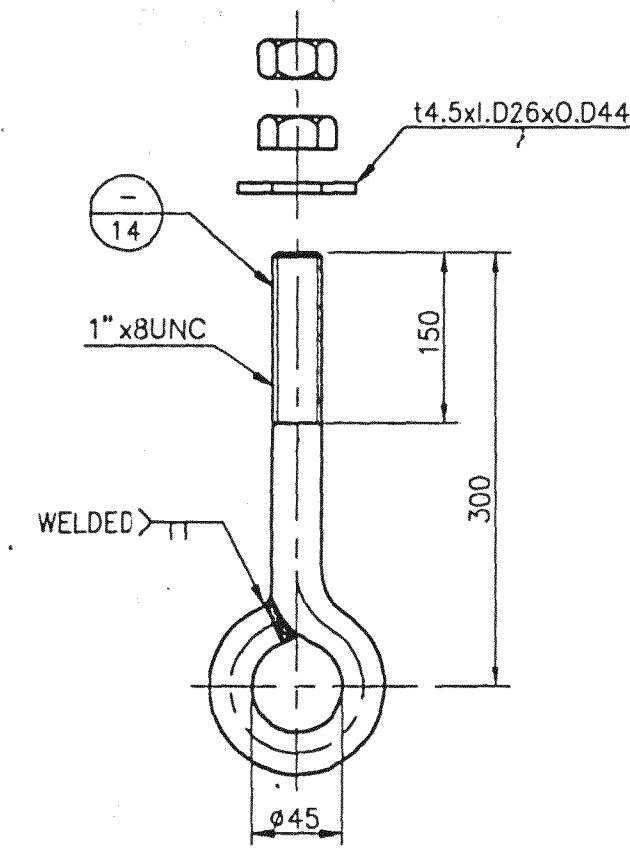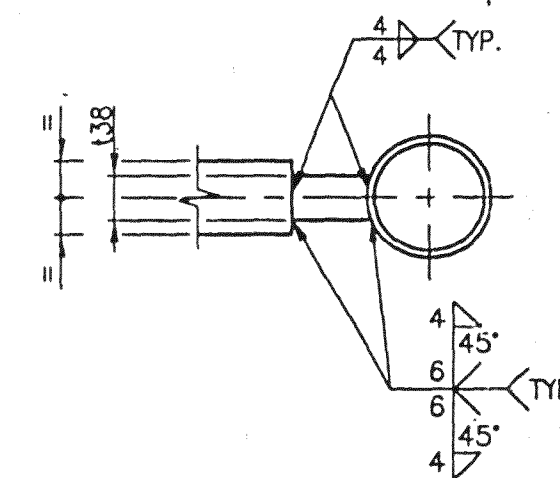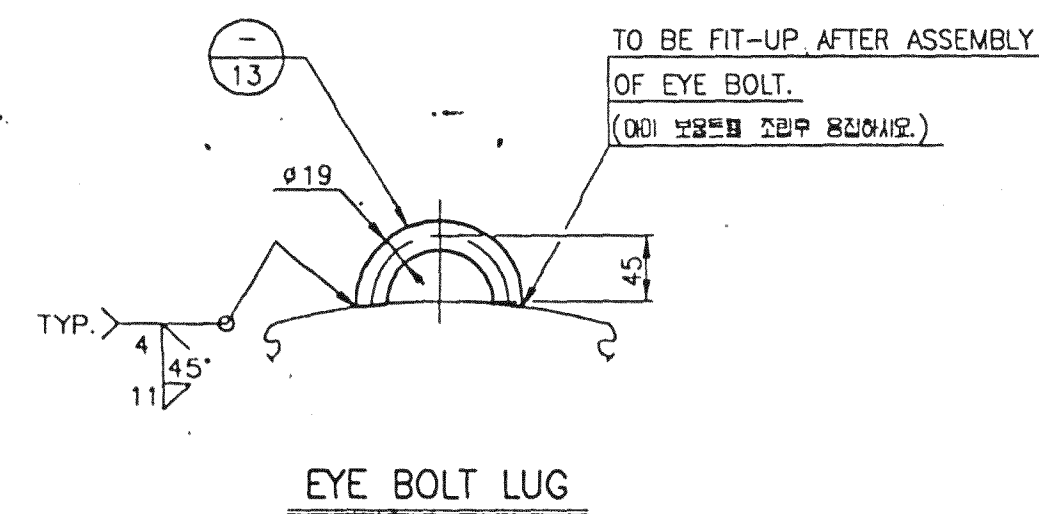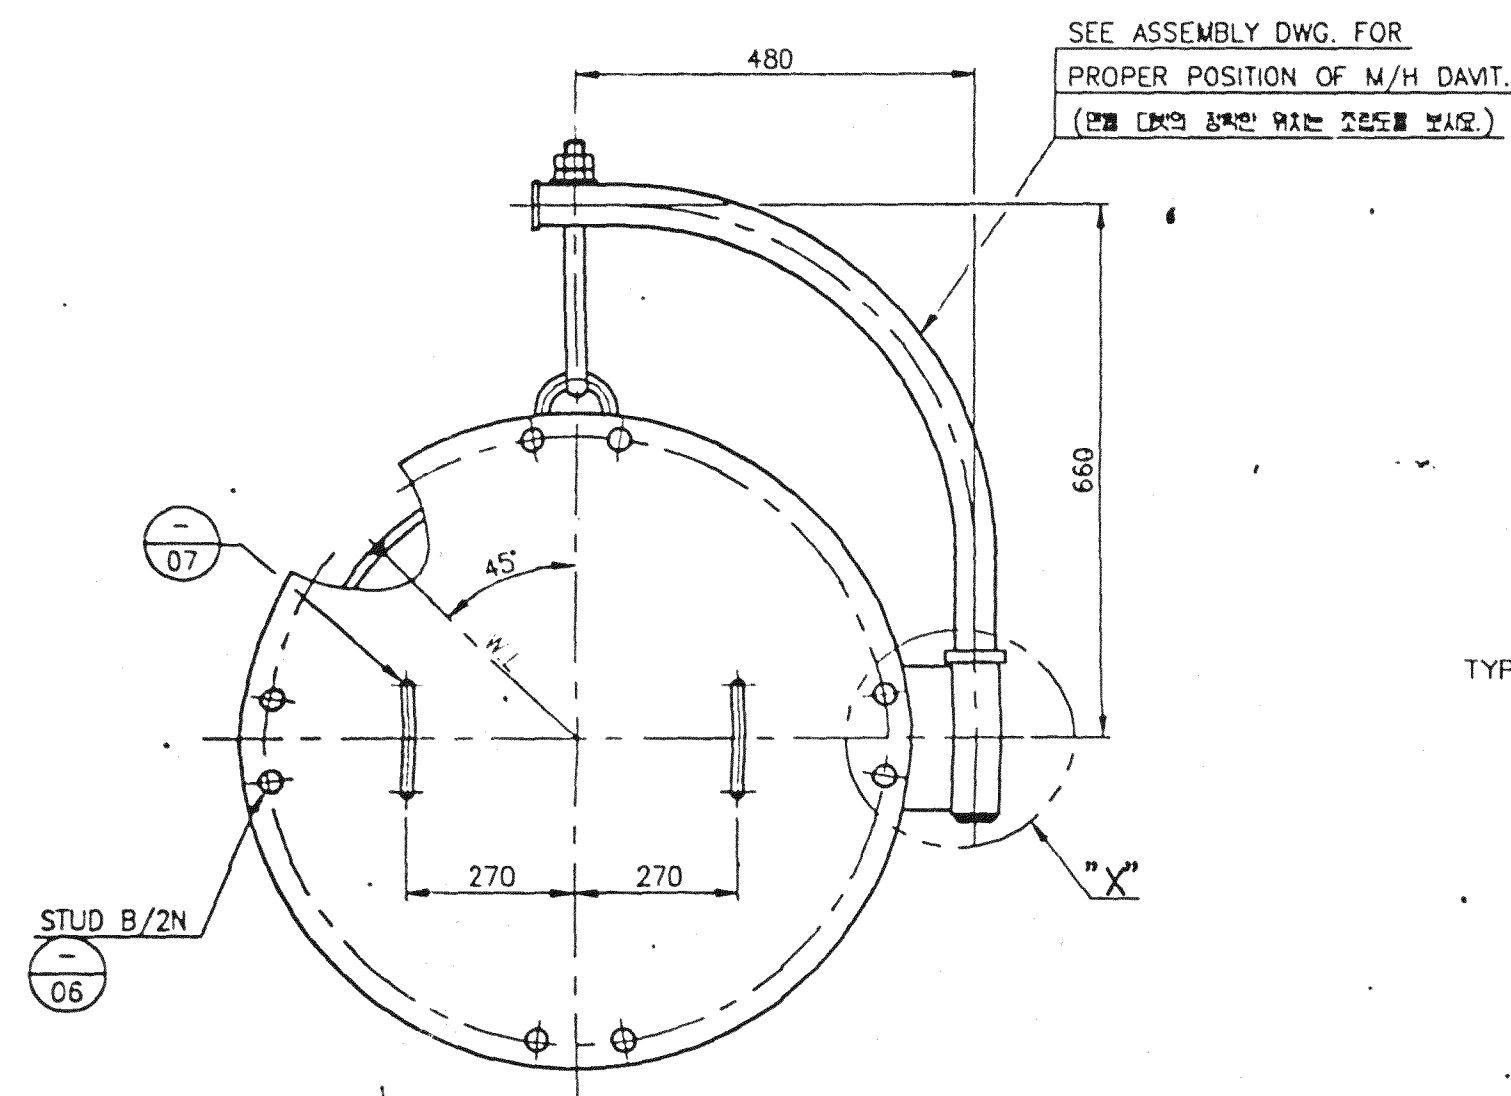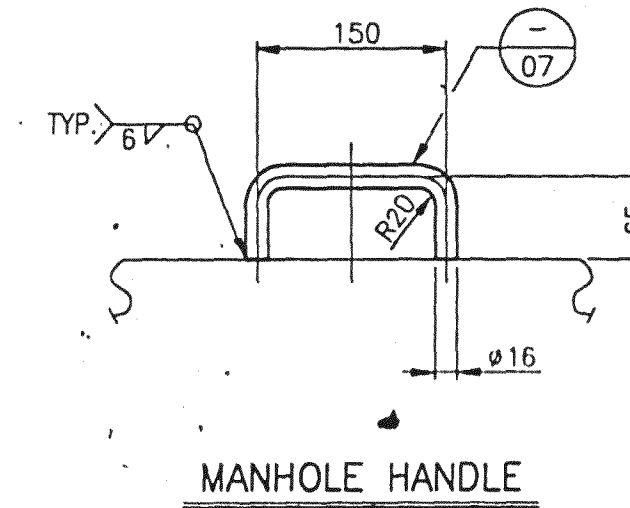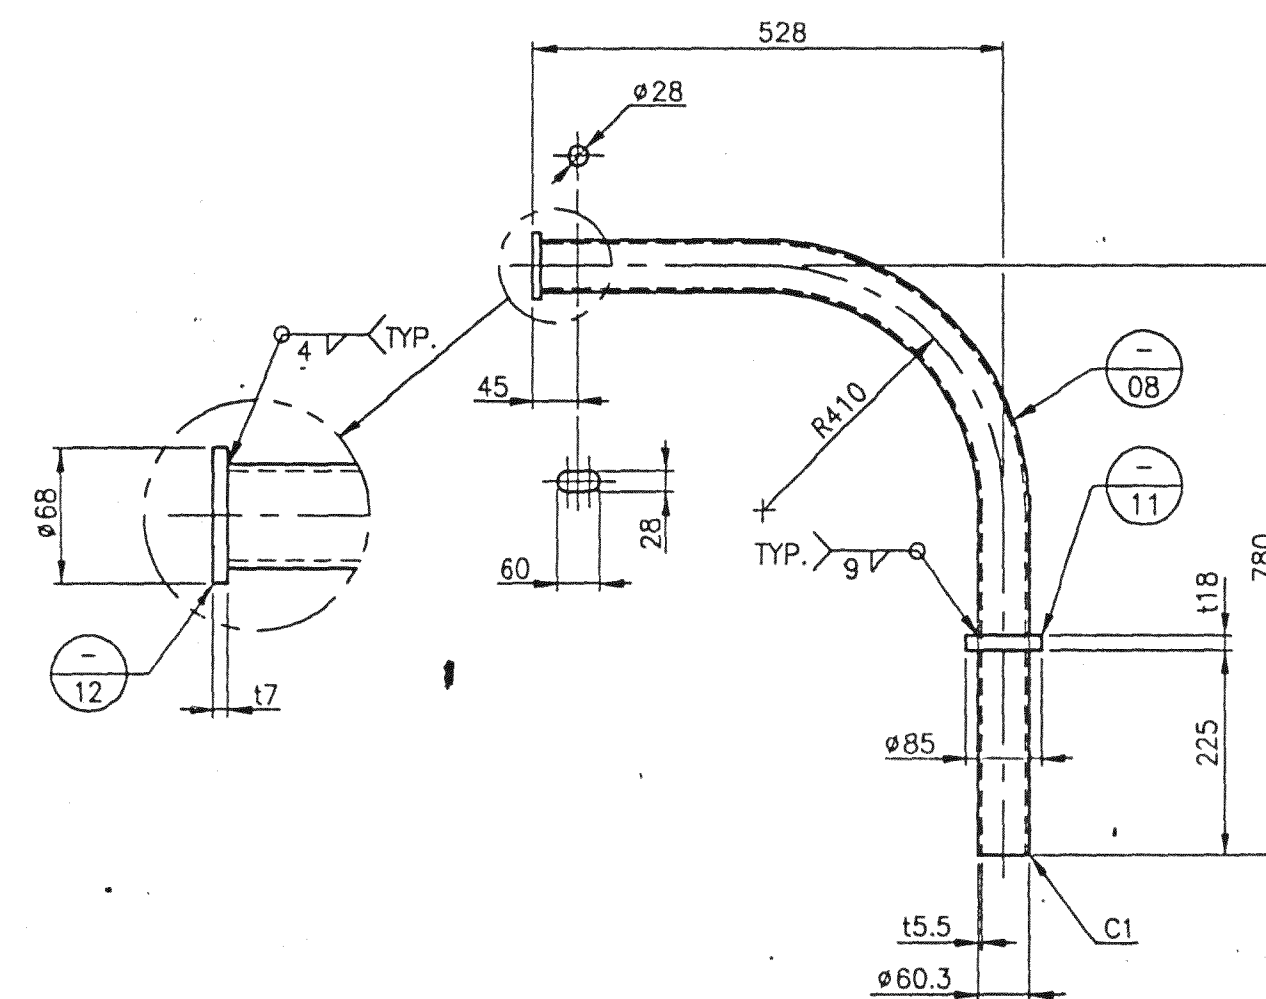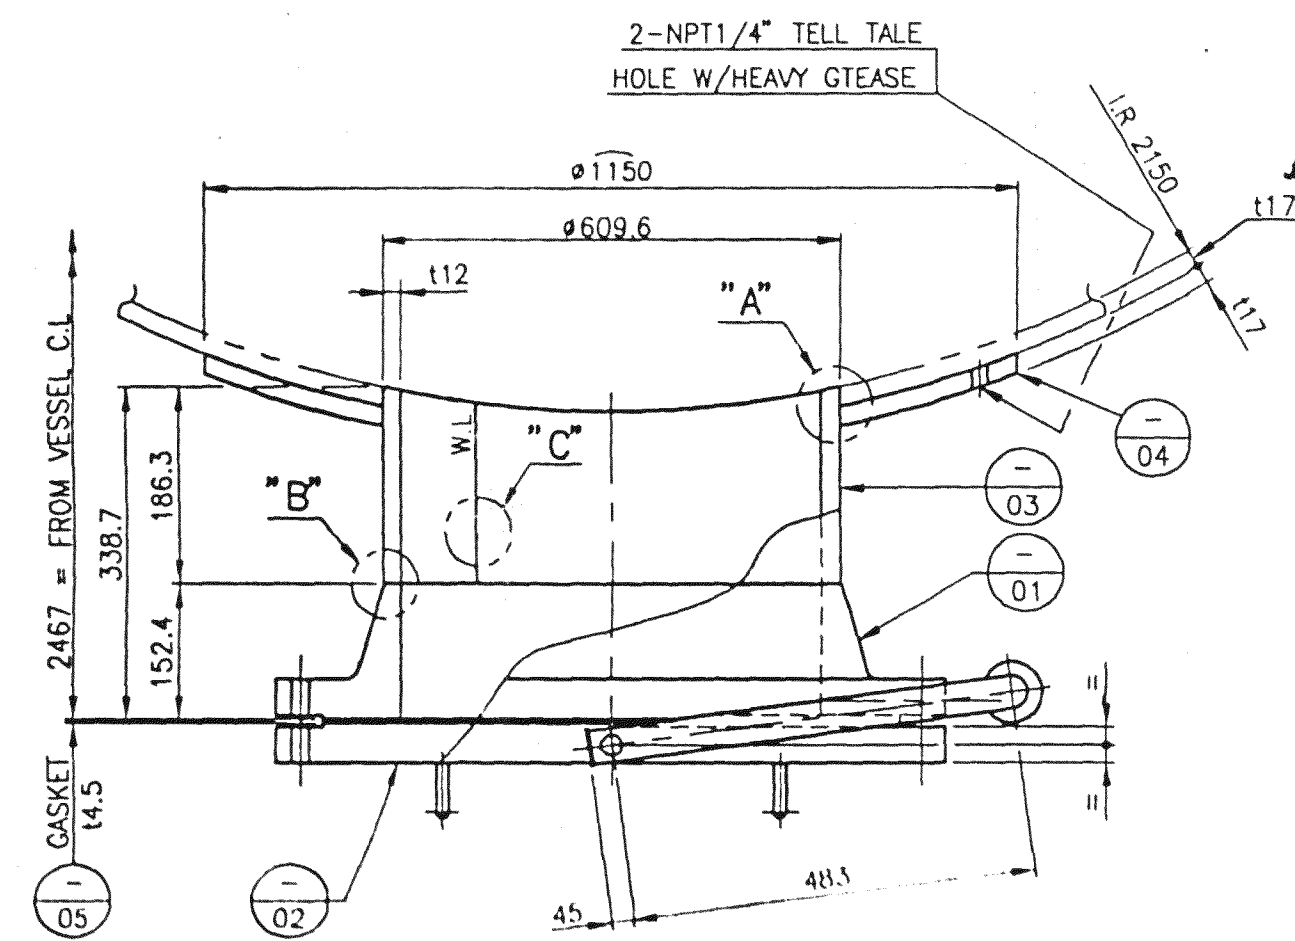


W/K	DATE	REASON FOR REVISION	DMN	CHK	APP
△					
△					
△					

NOTE :

1. GASKET ; SPIRAL WOUND 316 S.S W/GRAPHITE FILLER
316 S.S I.R. & C.S O.R.
2. W.P.S NO. F-0101-101 OR F-0101-301 SHALL BE APPLIED TO
ALL WELDS EXCEPT A,B & C JOINTS UNLESS OTHERWISE NOTED.
- (불포화 에폭시 또는 AB & C JOINTS에만 적용 필요)
F-0101-101 또는 F-0101-301 함.)

							T.W =	983 KG
EM FM	14	EYE B/2N/W	A193-B7/A194-2H	1"x8UNC-300L	2SET	4		
	13	EYE BOLT LUG	A36	ø19x145L	2	1		
	12	END PLATE	A283-C	17xø68	2	-		
	11	SUP'P RING PLATE	A283-C	118xL.D63xO.D85	2	1		
	10	SUPPORT PLATE	A283-C	138x50x200	2	6		
	09	SLEEVE PIPE	A53-B	2+1/2"xS/40-210L	2	4		
	08	DAWT PIPE	A53-B	2"xS/80-1126L	2	18		
	07	HANDLE	A36	ø16x280L	4	2		
	06	STUD B/2N	SA193-B7/SA194-2H	1+1/4"x8UN-200L	KOSET	70		
	05	GASKET	SEE NOTE 1	24"x14.5, 150#	2	6		
	04	REINF. PAD	SA516-60	117xL.D624xO.D1150	2	196		
	03	NOZZLE NECK	SA516-60	112x187x1877	2	66	1	
	02	BLO-RF FLANGE	SA105	24", 150#	2	373		ANSI B16.5
EM FM	01	WN-RF FLANGE	SA105	24"xL.D585.6, 150 #	2	236		ANSI B16.5
	PART NO.	PART NAME	MATERIALS	DIMENSIONS	QTY PER SET	WEIGHT (KG)	REMARKS	

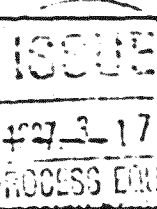JOB NO.		51046		CUSTOMER		SET(S)	
P/O NO.		SAYPOAD006		ARABIAN INDUSTRIAL FIBERS CO., LTD.		1	
MFG. SER. NO.		PV-97-038					
DWN		PROJECT		IBN RUSHD PTA & AROMATICS PROJECT-AROMATICS			
DES		TITLE		EXTRACT COLUMN			
CHK				53-C-02			
APP				DETAIL OF MANHOLE			
THRD ANGLE PROTECTION SCALE		REF. DIM. NO.		DIM. NO.		67069-0503	
 NONE		-				 0	

		GSI GLOBAL SECURITY INCORPORATED	
JOB NO. 51046		ITEM RUSSO AROMATICS PROJECT	
PO NO.		SAYPA0006	
REQ NO.		MR-50-C-002	
IDENT NO.		53-C-02-DW-0003	
A-PROJECTS PROCESSED WITH FABRICATION		SAY TEAM	
B-PROJECTS WITH FABRICATION QUANTITIES TO BE FORWARDED			
C-DO NOT PROCESS WITH FABRICATION		DATE	
PURCHASER'S PERMISSION TO PROCEED OR REVIEW TAKEN ON VENDOR PRICES SHALL NOT RELIEVE VENDOR FROM ITS RESPONSIBILITIES OR LIABILITIES UNDER PURCHASE ORDER			

INDUSTRIAL PLANT
DIVISION
ULSAN KOREA



HYUNDAI
HEAVY INDUSTRIES CO., LTD.

현대중공업주식회사 프렌트 사업본부



PLAN OF DISTRIBUTOR

PLAN OF DISTRIBUTOR

SECTION "E" - "E"

SECTION "D" - "D"

NOZZLE	EI
	10"

(DETAIL "H")

NOZZLE

AI
6"



(DETAIL "F")

DETAIL "K"

DETAIL "L"

VIEW "G"

VIEW "J"

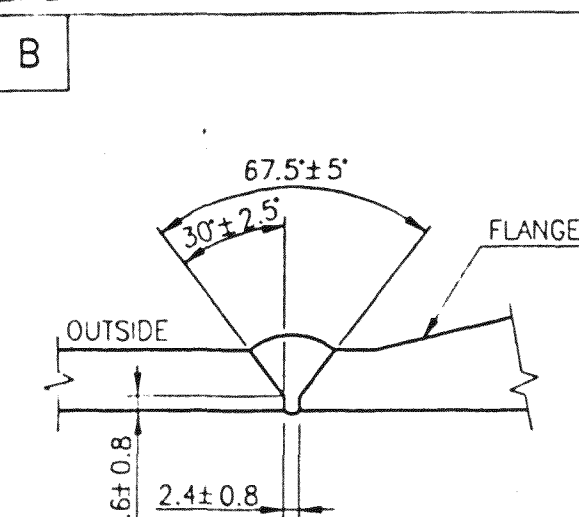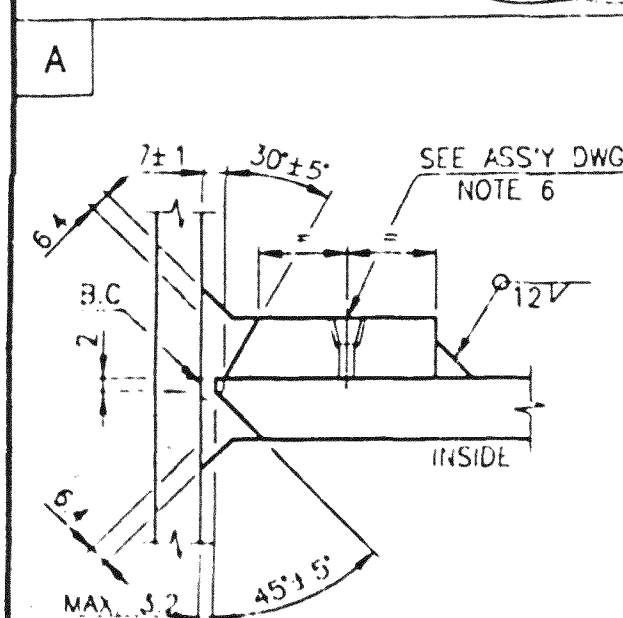

FITTING TO PIPE & FITTING WELD


M/K	DATE	REASON FOR REVISION	DWN	CHK	APP
△	8/3/30	REVISED AS MARKED	8/3	8/5	(W)
△					
△					

NOTE :

1. TRIAL FIT-UP AT SHOP WITHOUT TRAY TO SUIT FOR ACTUAL WORKS.
(실제 SITE 조립시 정확도를 위하여 SHOP 에서 가조립 실시함.)

T.W = 640 KG					
			</		

AS 10-11	BILL OF MATERIALS
----------	-------------------

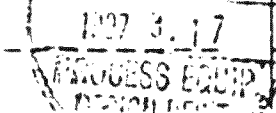
JOB NO.	S1046	CUSTOMER	SET(S)
P/O NO.	SAYPOA0006	ARABIAN INDUSTRIAL FIBERS CO., LTD.	1
MFG SER. NO.	PV-97-038		
DIN	PROJECT		
D.C.KWAG	'96,7,11	IBN RUSHD PTA & AROMATICS PROJECT-AROMATICS	
DOS			
Y.S.JUNG	'96,7,15	TITLE	
CHK		EXTRACT COLUMN	
G.Y.SHIN	'96,7,18	53-C-02	
APP		DETAIL OF DISTRIBUTOR	
D.H.WON	'96,7,18		
REID WHOLE PROJECT	SCALE	REF. DING. NO.	DING NO.
	NONE	-	6T069-0507
			0

INDUSTRIAL PLANT
DIVISION
ULSAN KOREA











HYUNDAI
HEAVY INDUSTRIES CO., LTD.






현대중공업주식회사 프랜트 사업본부

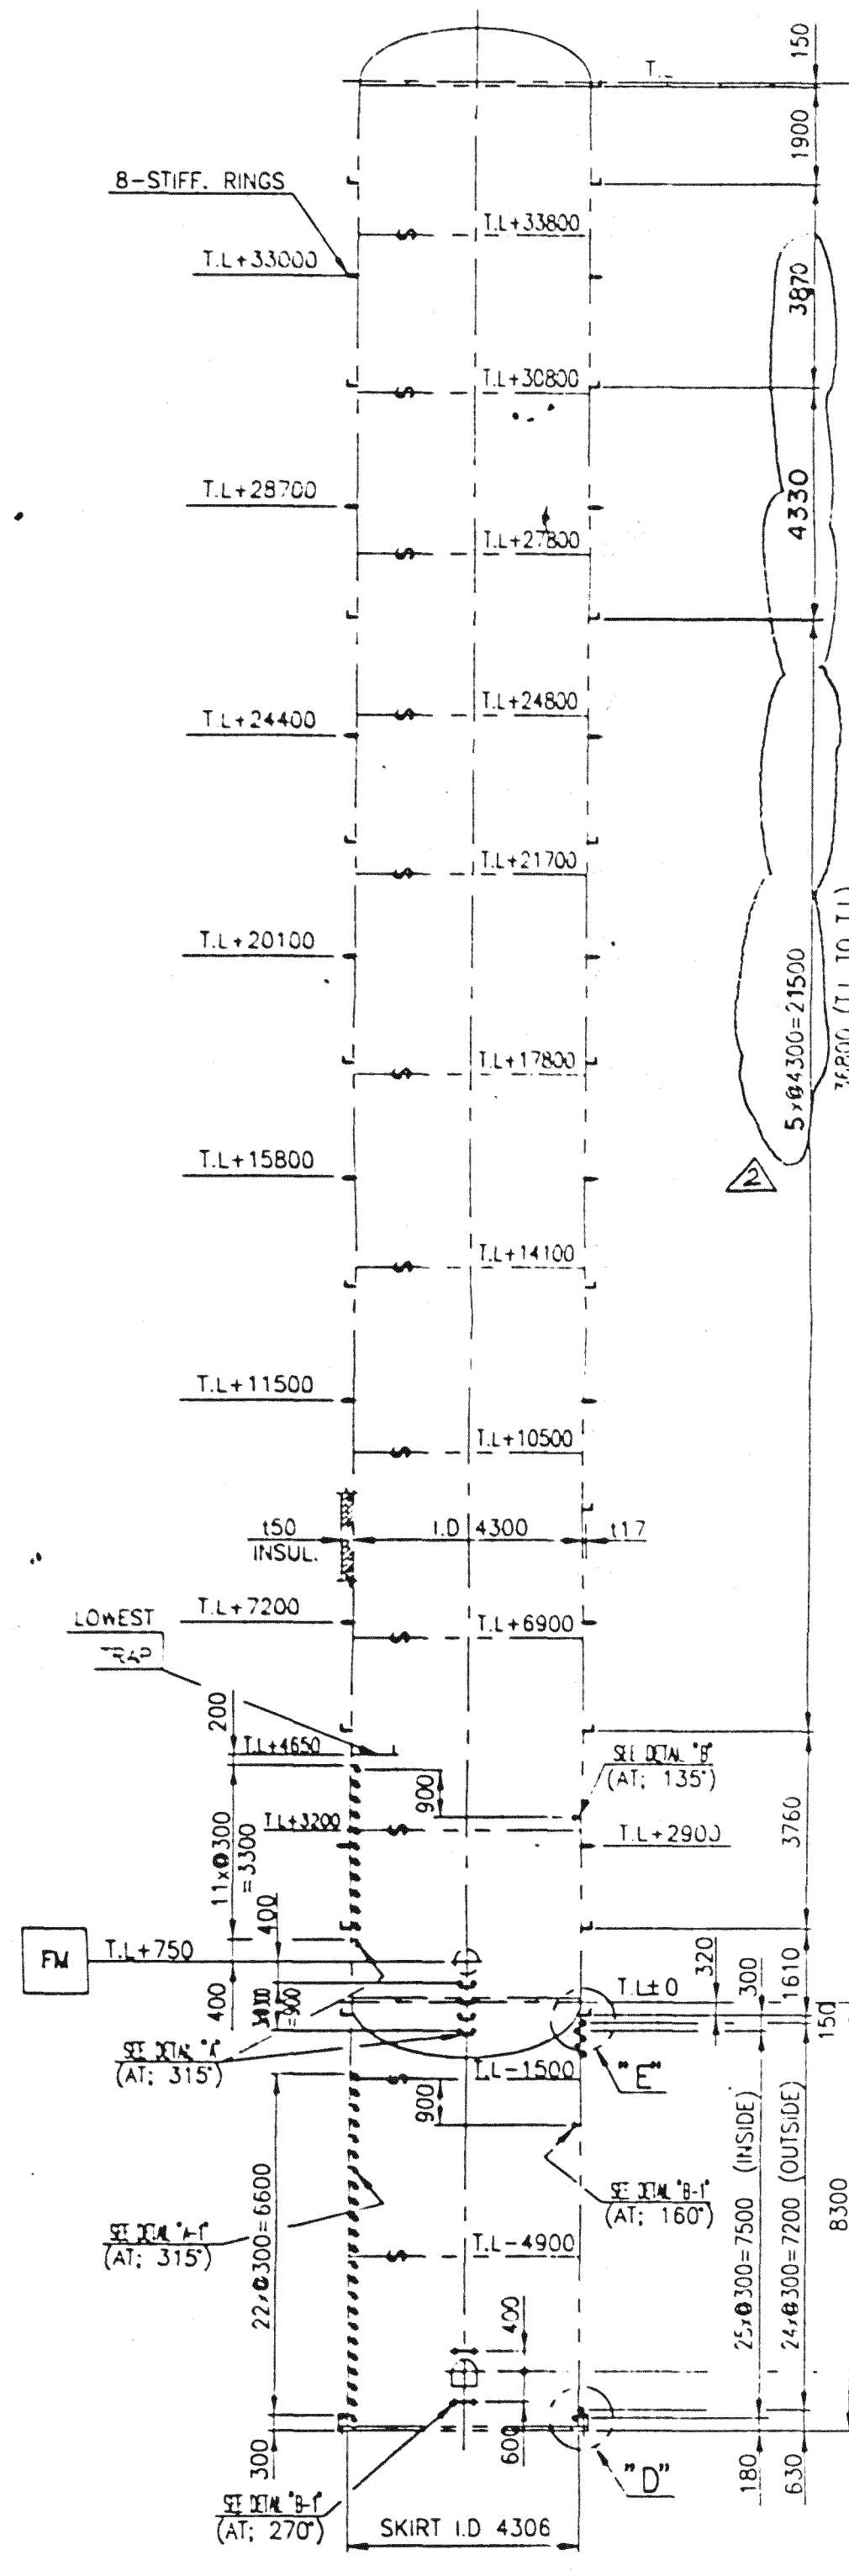

SCHEMATIC ELEVATION
TRUE ORIENTATION SHOWN IN SECTION
(부분의 중첩한 각도는 20도에서 30도 사이로 나타남)

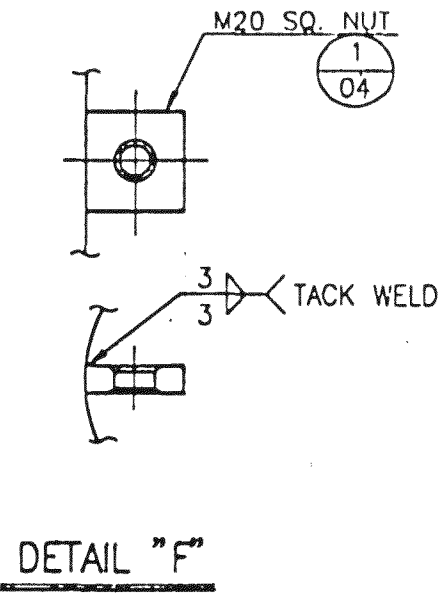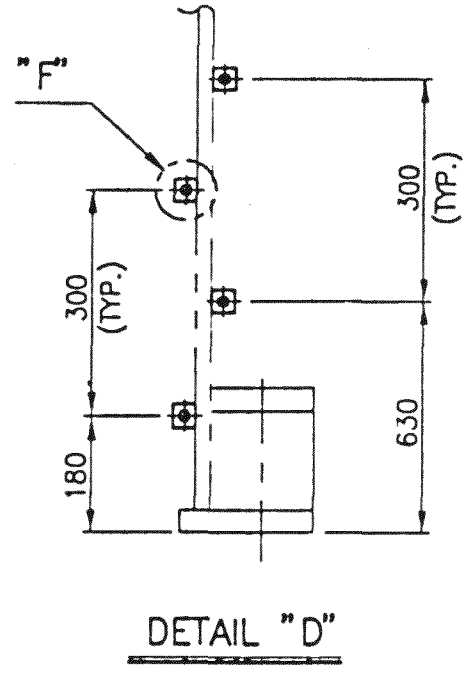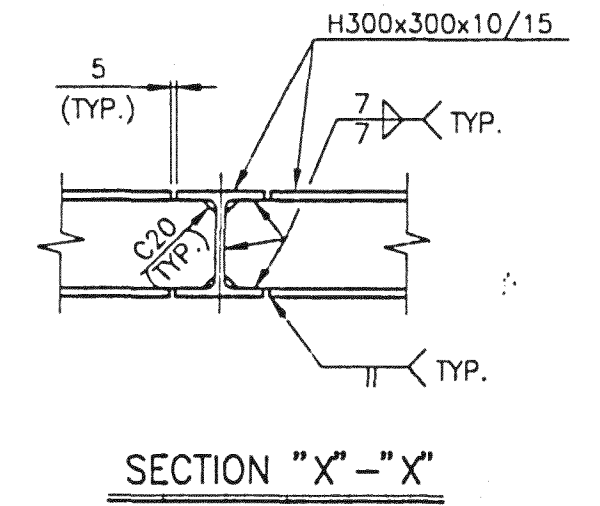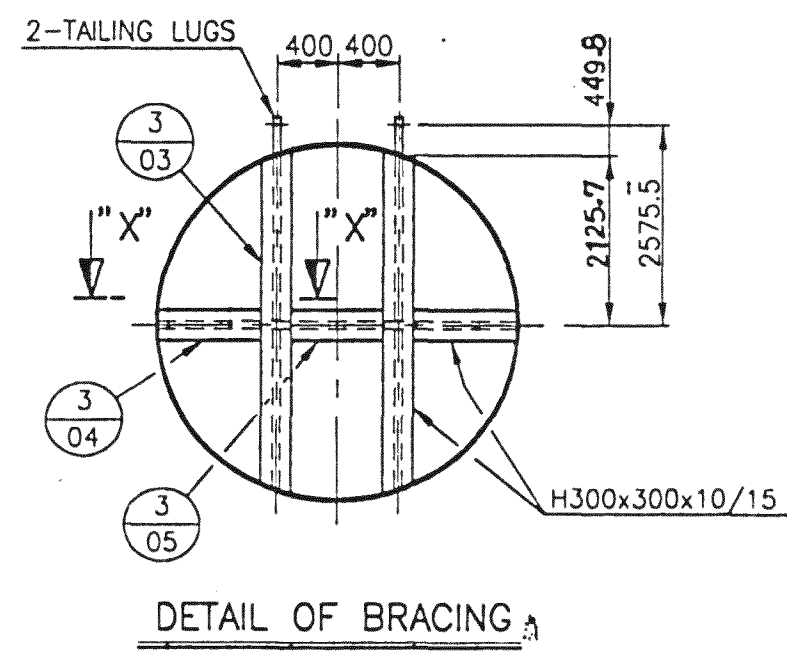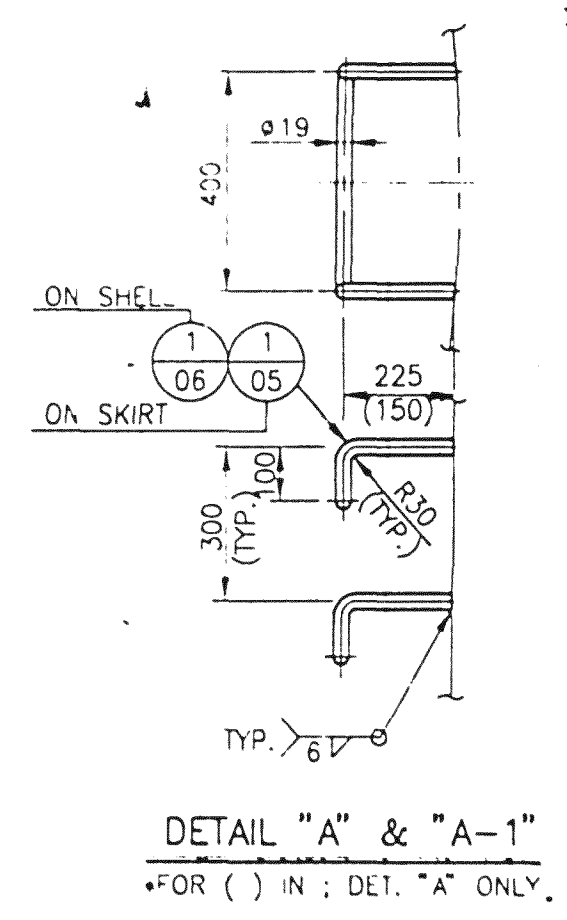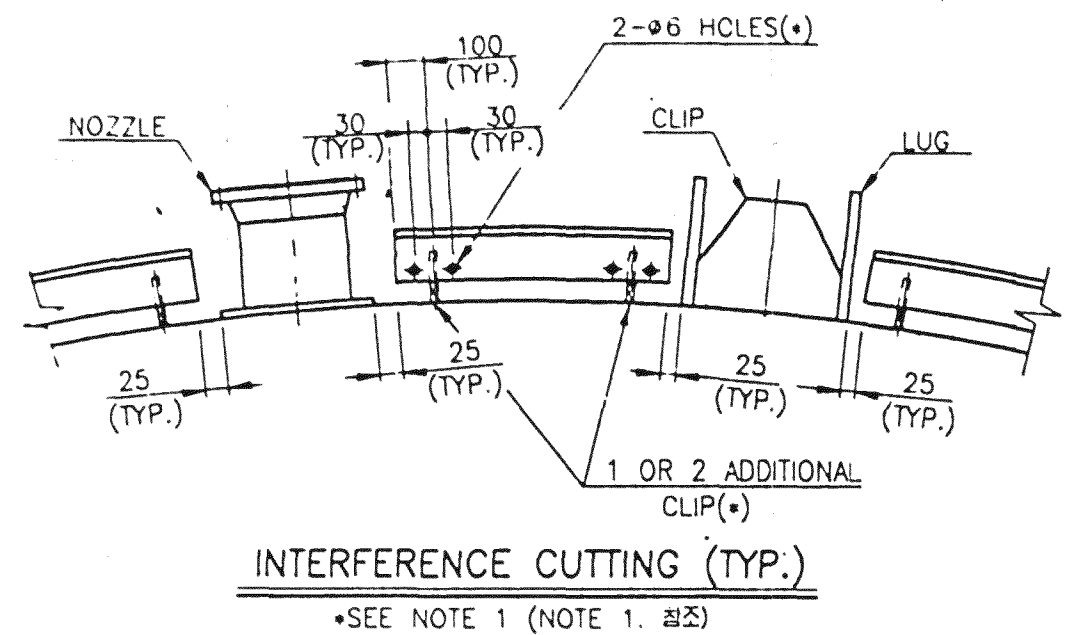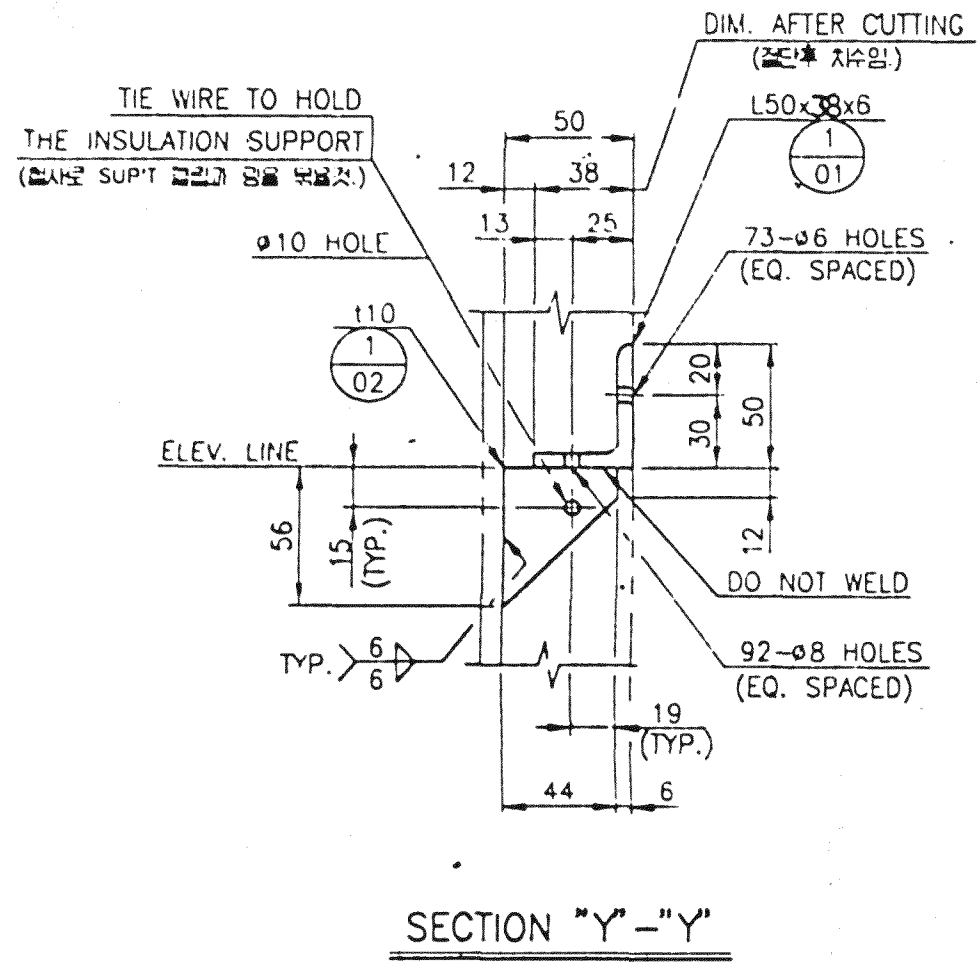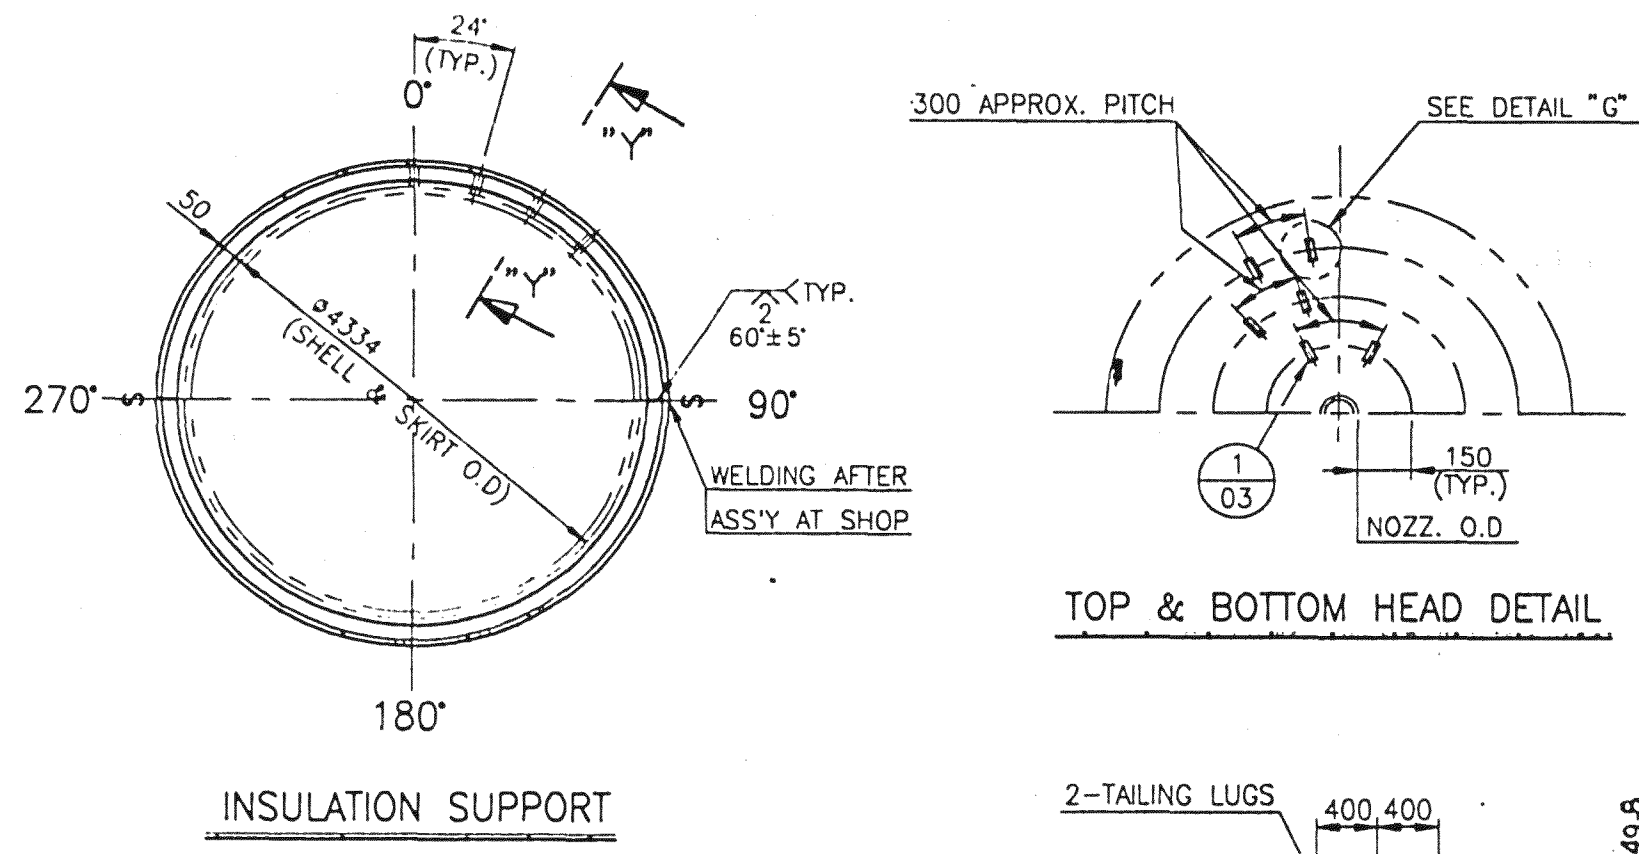

DETAIL 'F'

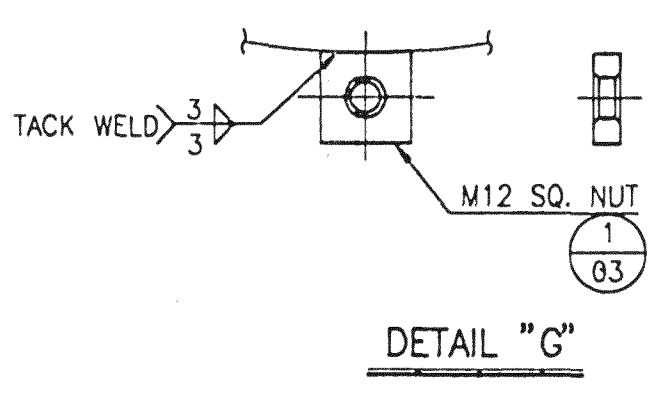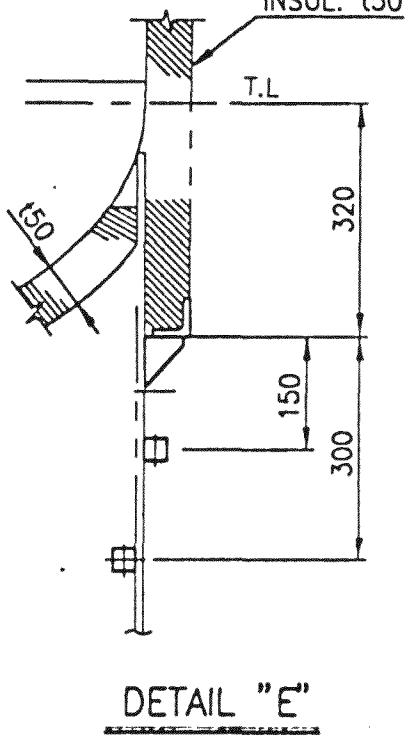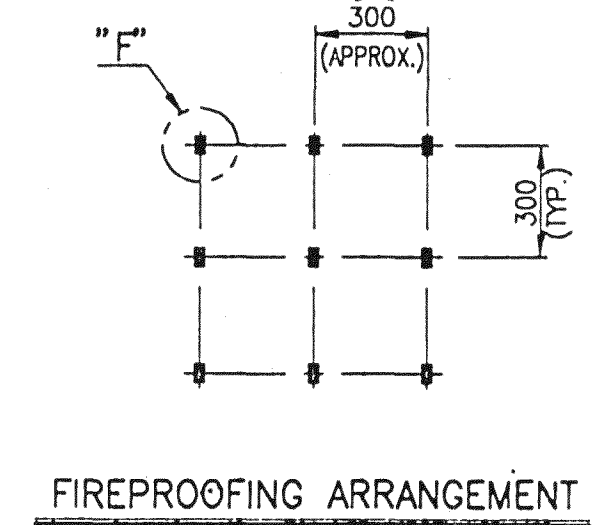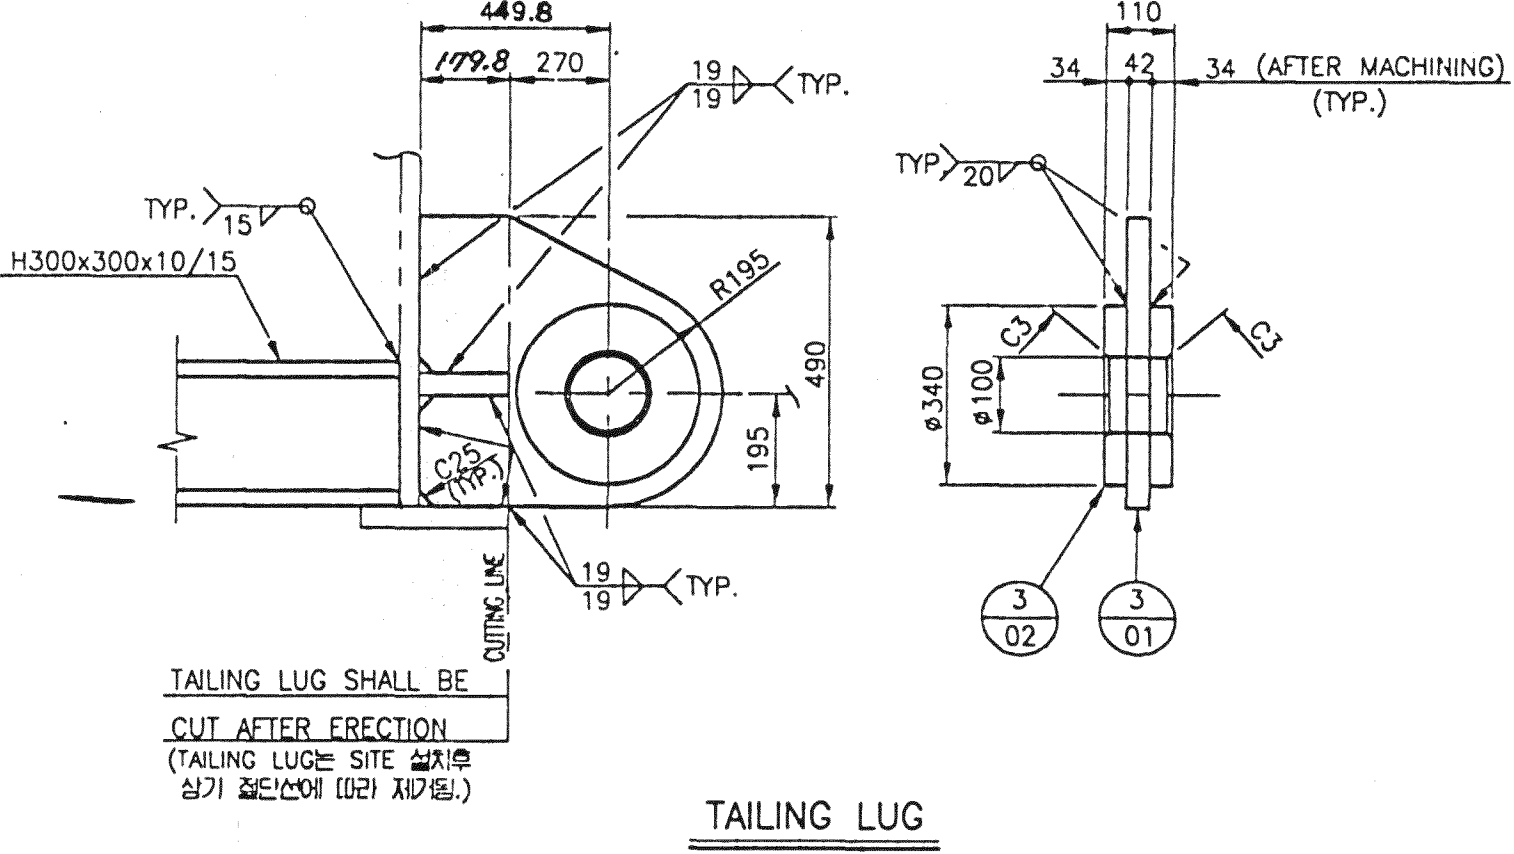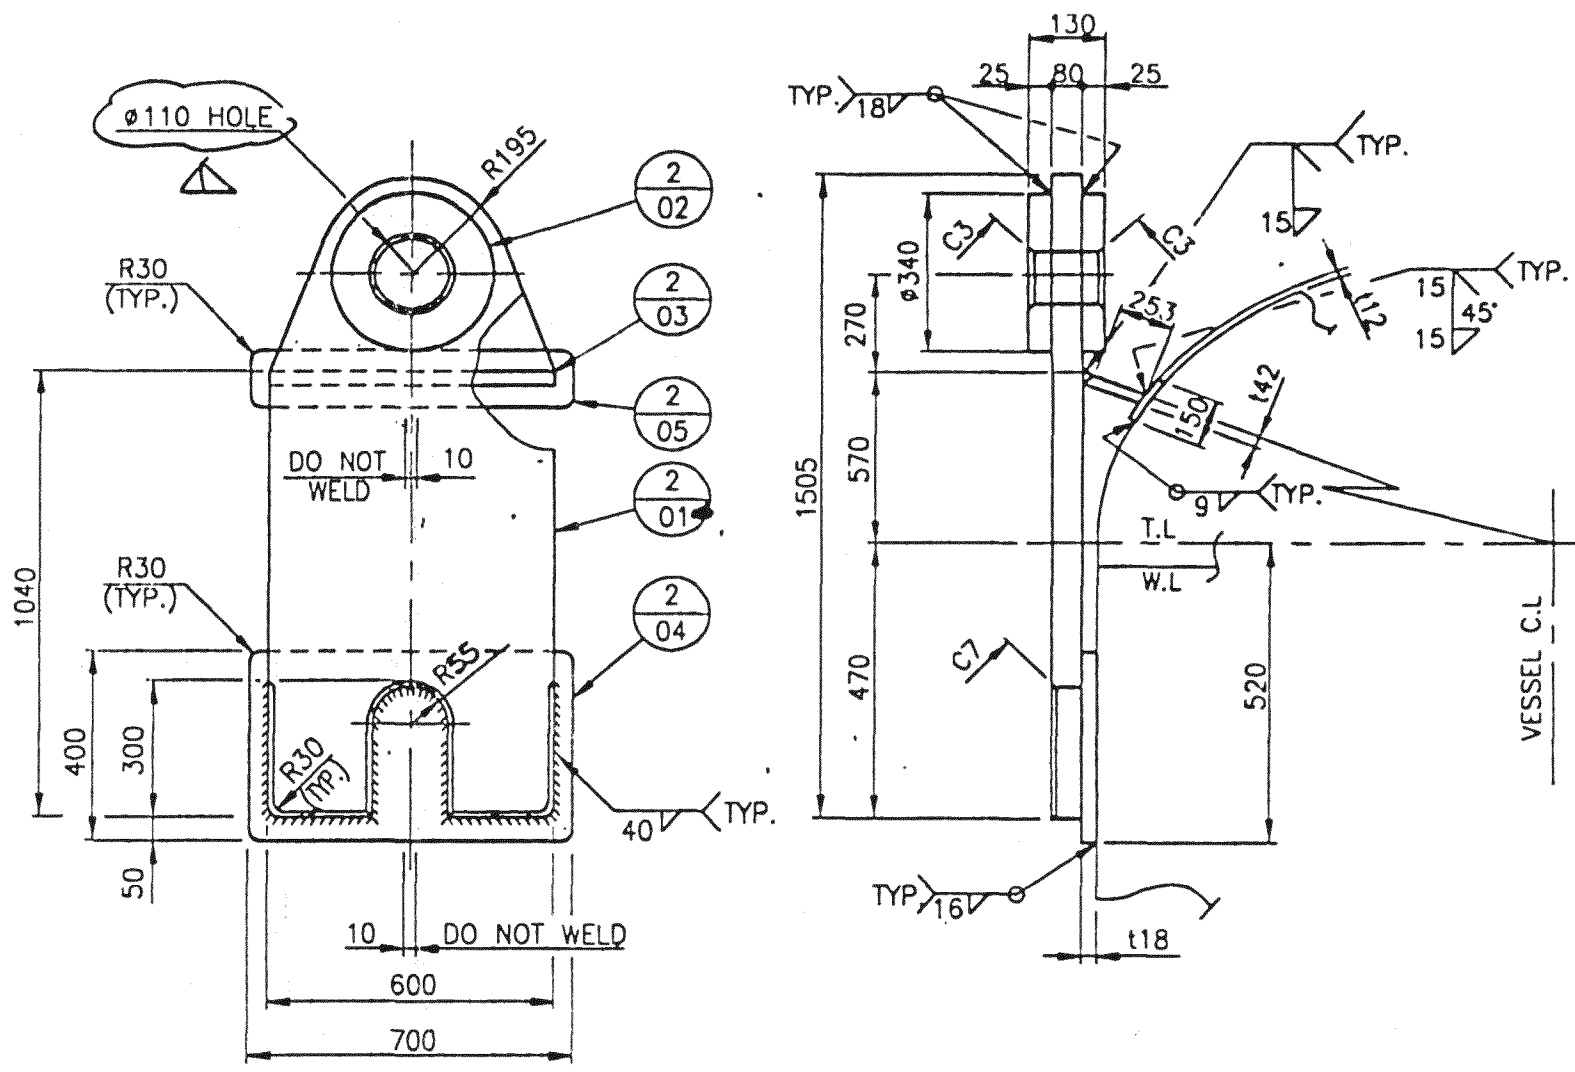


SHIYODA CORPORATION JOB NO. 51046 IBN RUSHD AROMATICS PROJECT PO NO. SAYPOA0006 REQ NO. NR-50-C-002 IDENT NO. 53-C-02-DW-0008		DATE PURCHASER'S PERMISSION TO PROCEED OR REVIEW TAKEN ON VENDOR PRINTS SHALL NOT RELIEVE VENDOR FROM ITS RESPONSIBILITIES OR LIABILITIES UNDER PURCHASE ORDER	
--	--	--	--

W/K	DATE	REASON FOR REVISION	DWN	CHK	APP
1	96.10.15	REVISED AS MARKED	3/3	1/1	2/3
2	96.12.8	REVISED AS MARKED	1/5	1/1	2/3

NOTE
1. TIE WIRE TO FASTEN THE ADDITION CLIP WITH SUPPORT RING FOR INTERFERENCE CUTTING PART.
(2. 20도에서 30도 사이로 나타남) CLIP 이 부속이 고장일수 있음(1. 20도에서 30도 사이로 나타남) CLIP (1개 또는 2개)를 부속하고 SUPPORT RING 에 HOLE를 주어 고장일수 있음)















					T.W = 3869 KG	
3	05	BRACING	SS400	H300x300x10/15-790L	1	75
4	04	BRACING	SS400	H300x300x10/15-1748L	2	329
	03	BRACING	SS400	H300x300x10/15-4277L	2	804
	02	PAD PLATE	A283-C	t34x1.D100x0.D340	4	89 USED 138
3	01	TAILING LUG	A283-C	t42x490x645	2	208 USED 150
2	05	REINF. PAD	SA516-60	t12x150x700	2	20
4	04	REINF. PAD	SA516-60	t18x400x700	2	80
	03	SUP'T PLATE	A283-C	t42x253x600	2	100
	02	PAD PLATE	A283-C	t25x.D110x0.D340	4	64
2	01	LIFTING LUG	A283-C	t80x600x1505	2	1135
1	08	HANDLE	A36	ø19x700L	1	2
4	07	HANDLE	A36	ø19x850L	3	6
	06	LADDER RUNG	A36	ø19x900L	16	32
	05	LADDER RUNG	A36	ø19x1050L	23	54
	04	SQ. NUT	SS400	M20	2350	151
	03	SQ. NUT	SS400	M12	480	9
4	02	INSUL. SUP'T CLIP	SA516-60	t10x44x56	165	32
1	01	INSUL. SUP'T RING	SS400	L50x38x6-13930L	11	679
PART NO.	PART NAME	MATERIALS	DIMENSIONS		QTY	WT(KG)
						RE MARKS

BILL OF MATERIALS			
JOB NO.	51046	CUSTOMER	IBN RUSHD PTA & AROMATICS PROJECT-AROMATICS
P/O NO.	SAYPOA0006	ARABIAN INDUSTRIAL FIBERS CO., LTD.	1
REV. NO.	PV-97-038	PROJECT	EXTRACT COLUMN
DWN	D.C.KWAG	DES	J.S.LEE
CHK	G.Y.SHIN	APP	D.H.WON
THIRD PARTY PROJECTION	SCALE	REF. DWG. NO.	DWG. NO.
NONE	-	-	6T069-0508
INDUSTRIAL PLANT DIVISION ULSAN KOREA			
HYUNDAI HEAVY INDUSTRIES CO., LTD.			
현대중공업주식회사 프랜트 사업본부			

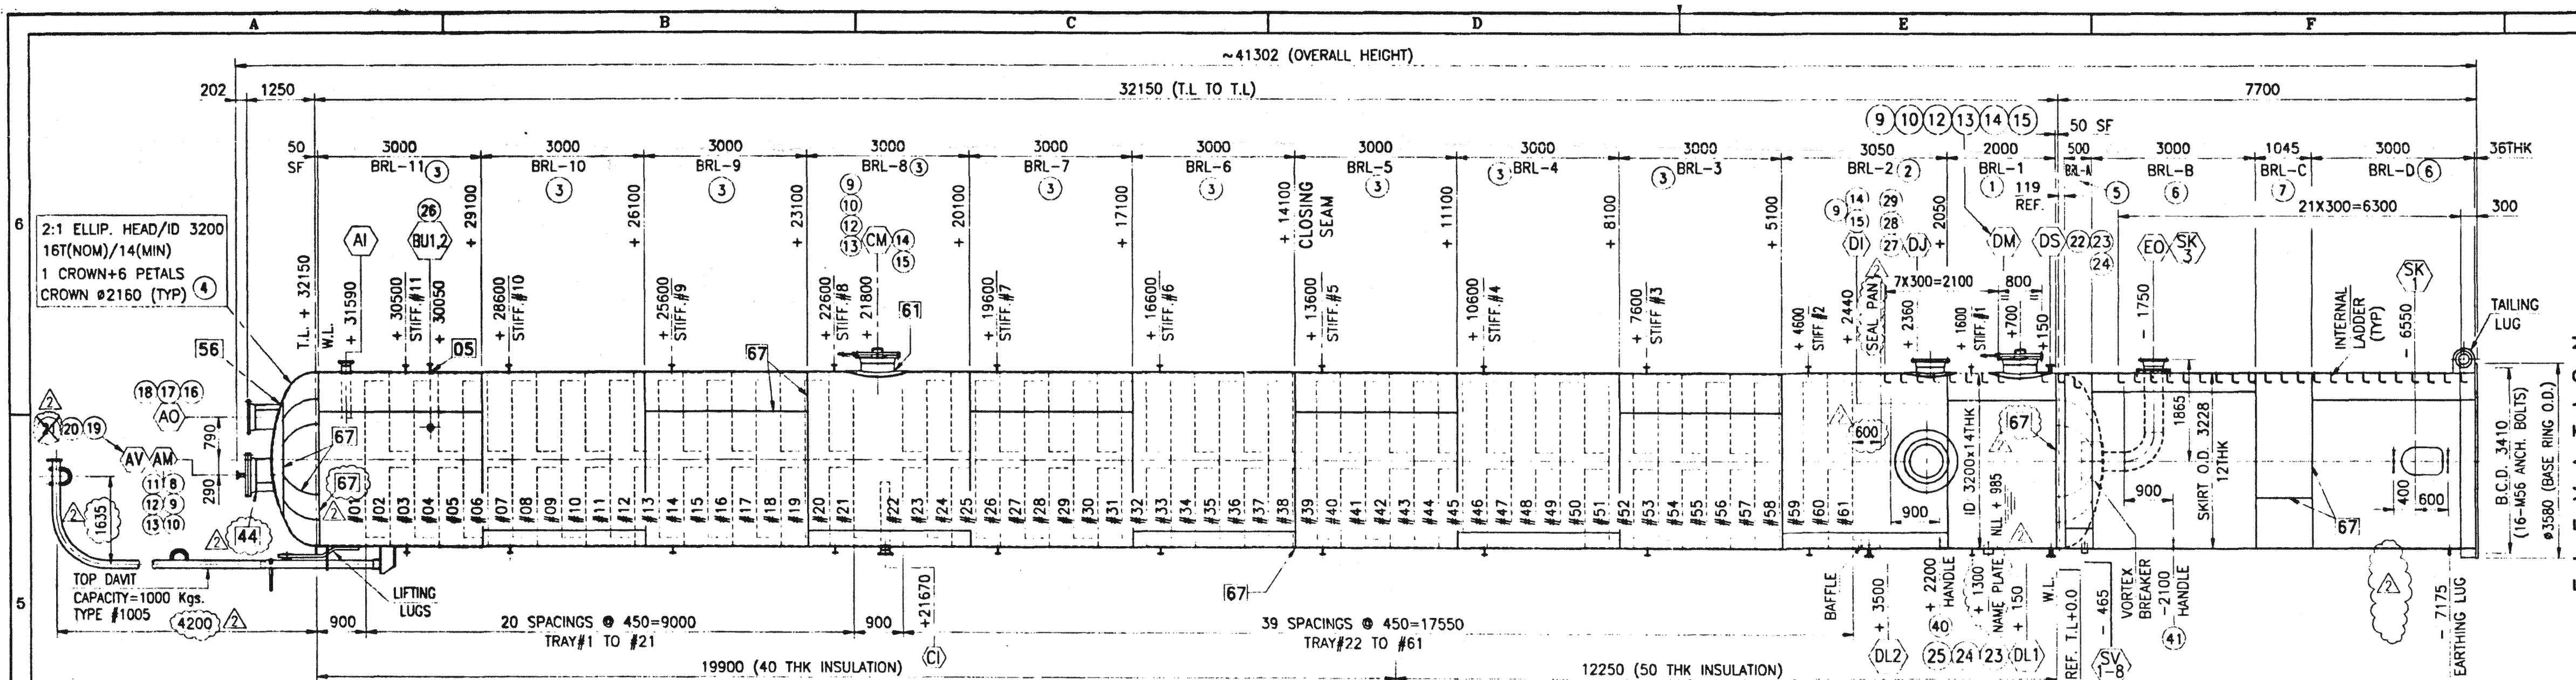

SPARES FOR GASKETS AND STUD/NUTS ARE INCLUDED IN LOM

• SA193 GR.B7/SA194 GR.2H
• 4.5mm THK SS 316 SPIRAL WOUND GRAPHITE FILLED WITH SS 316 INNER AND SS/CS OUTER CENTERING RING.

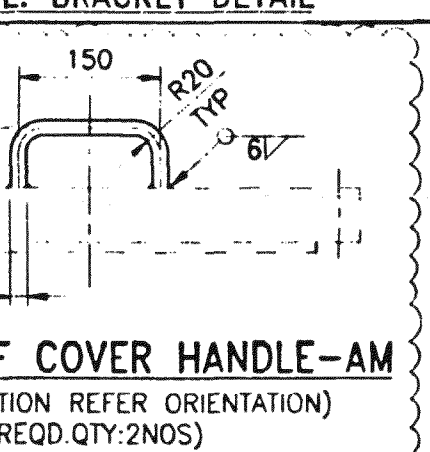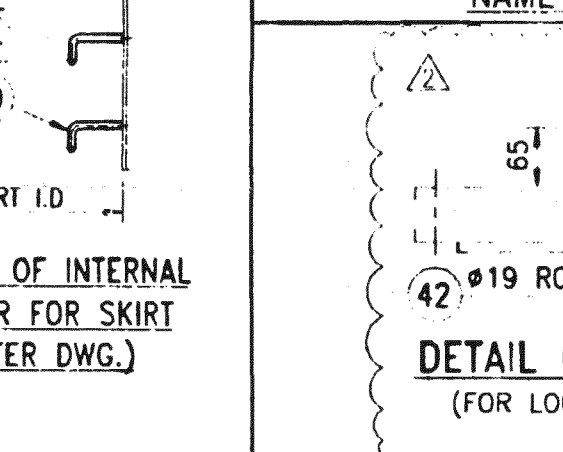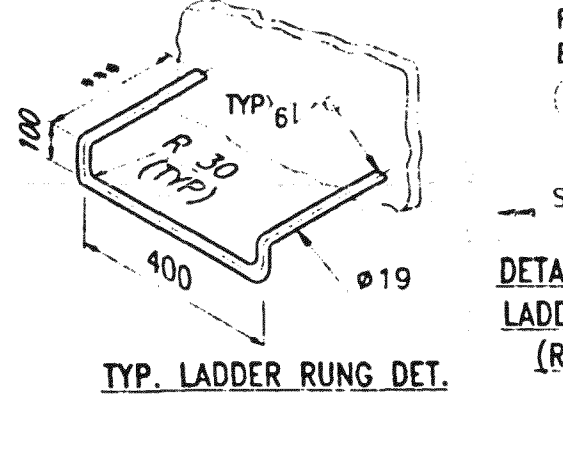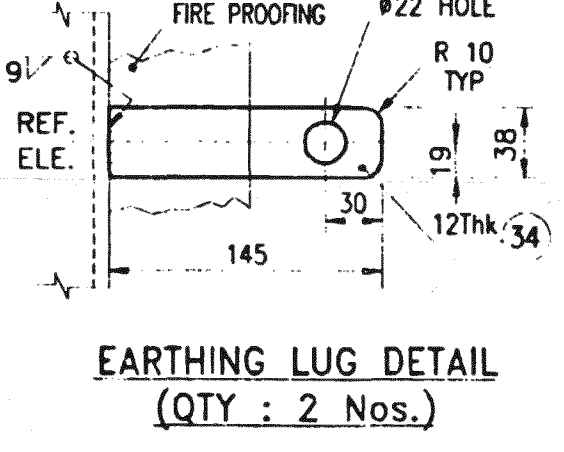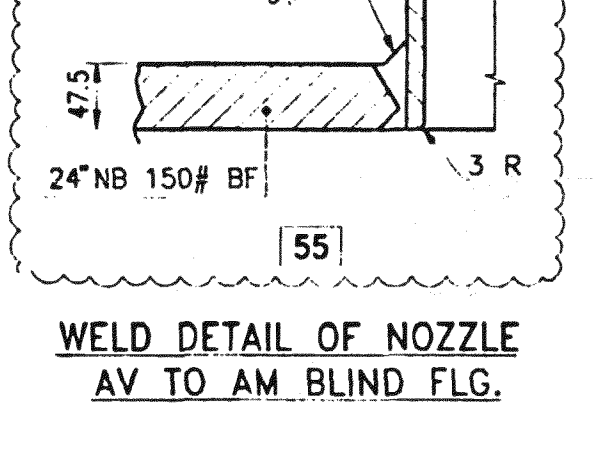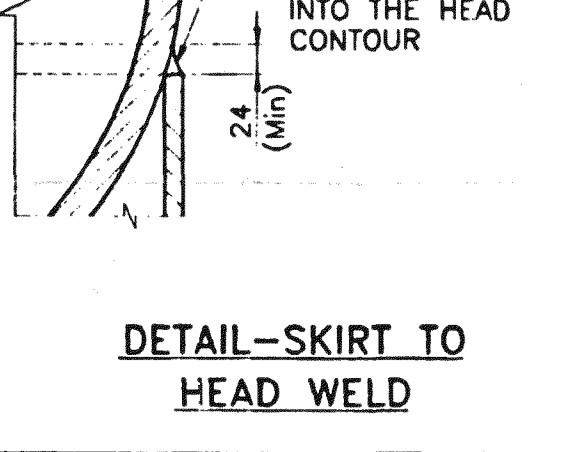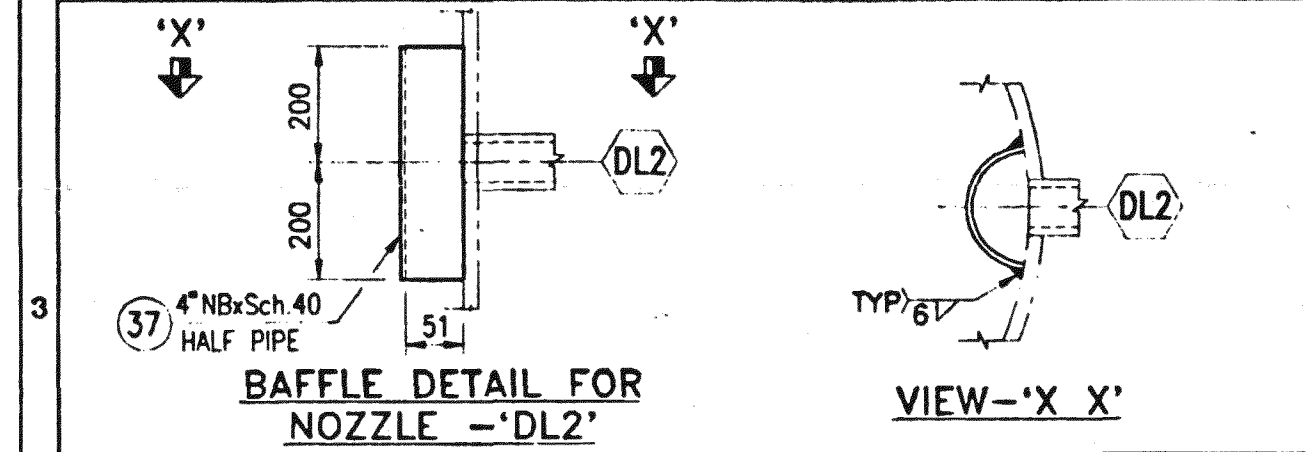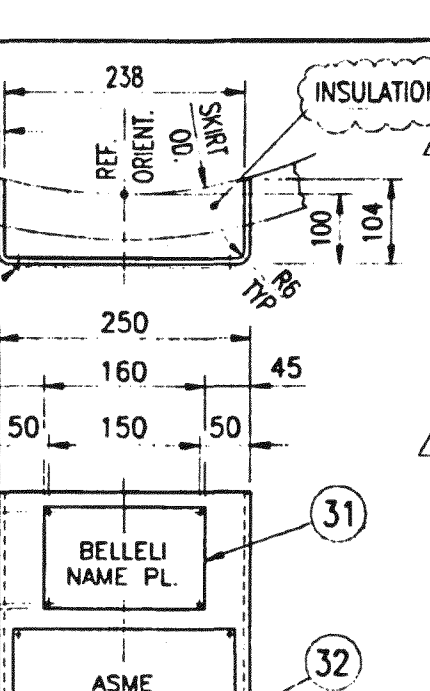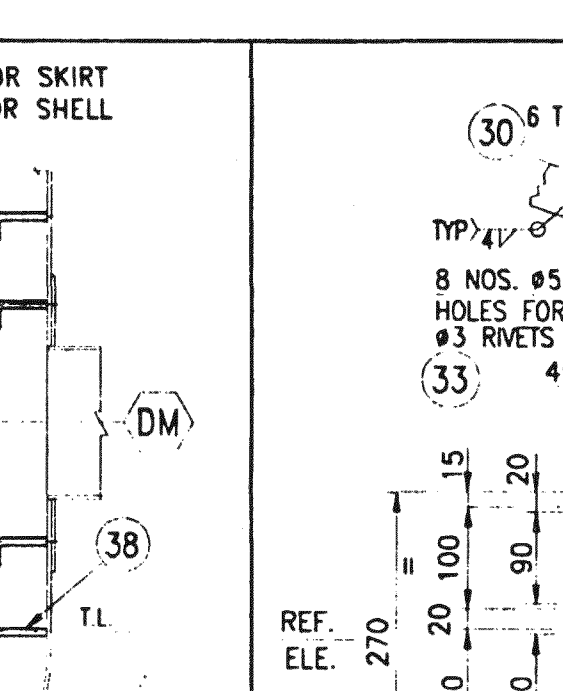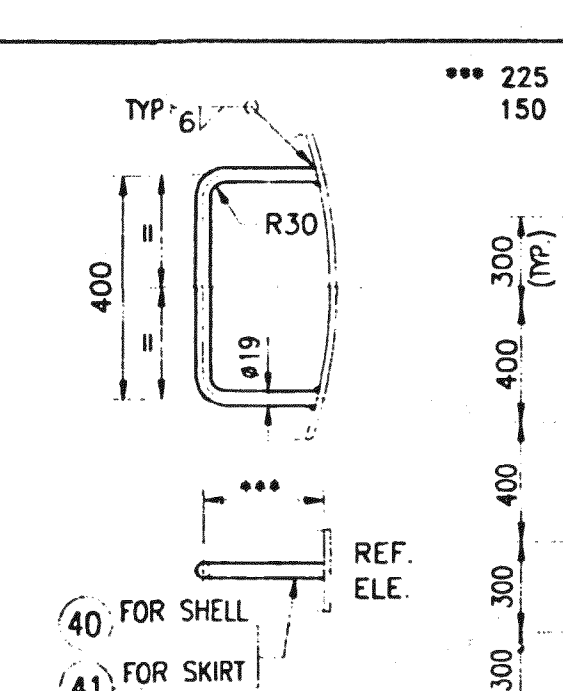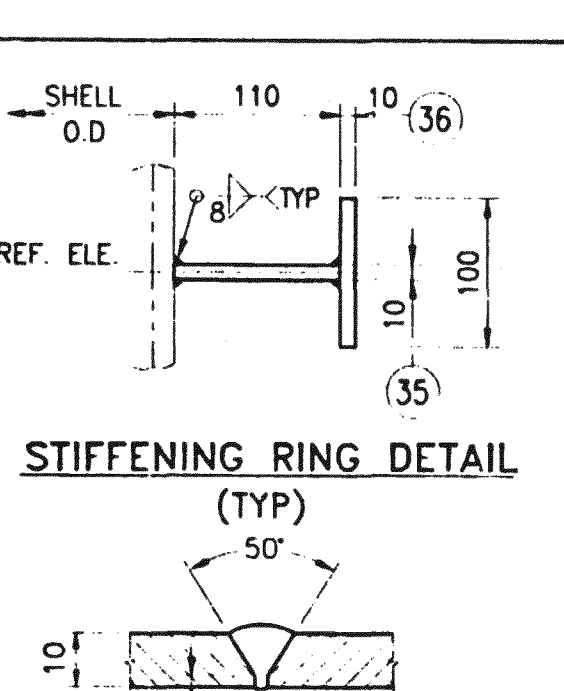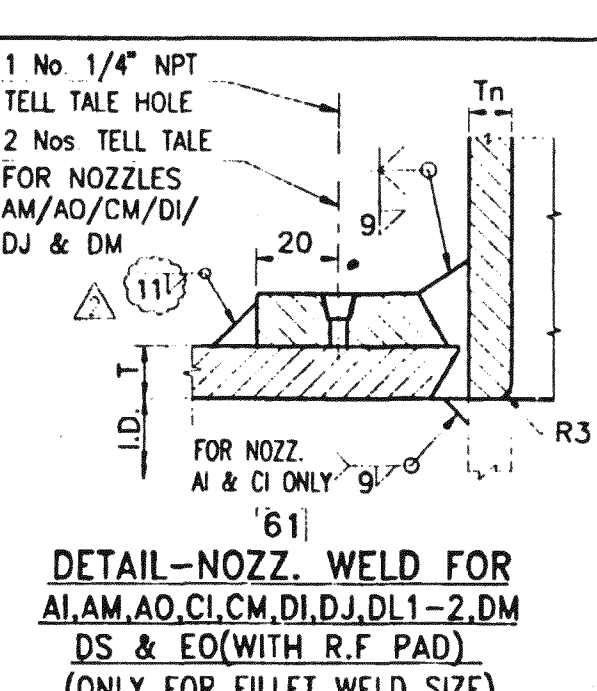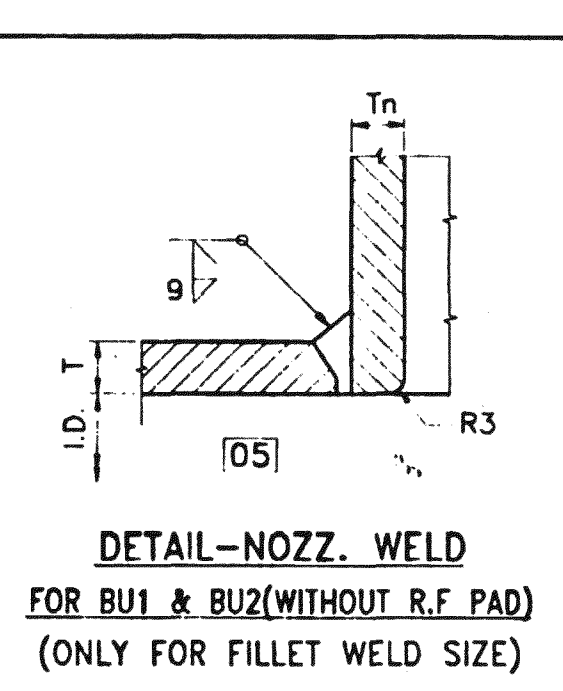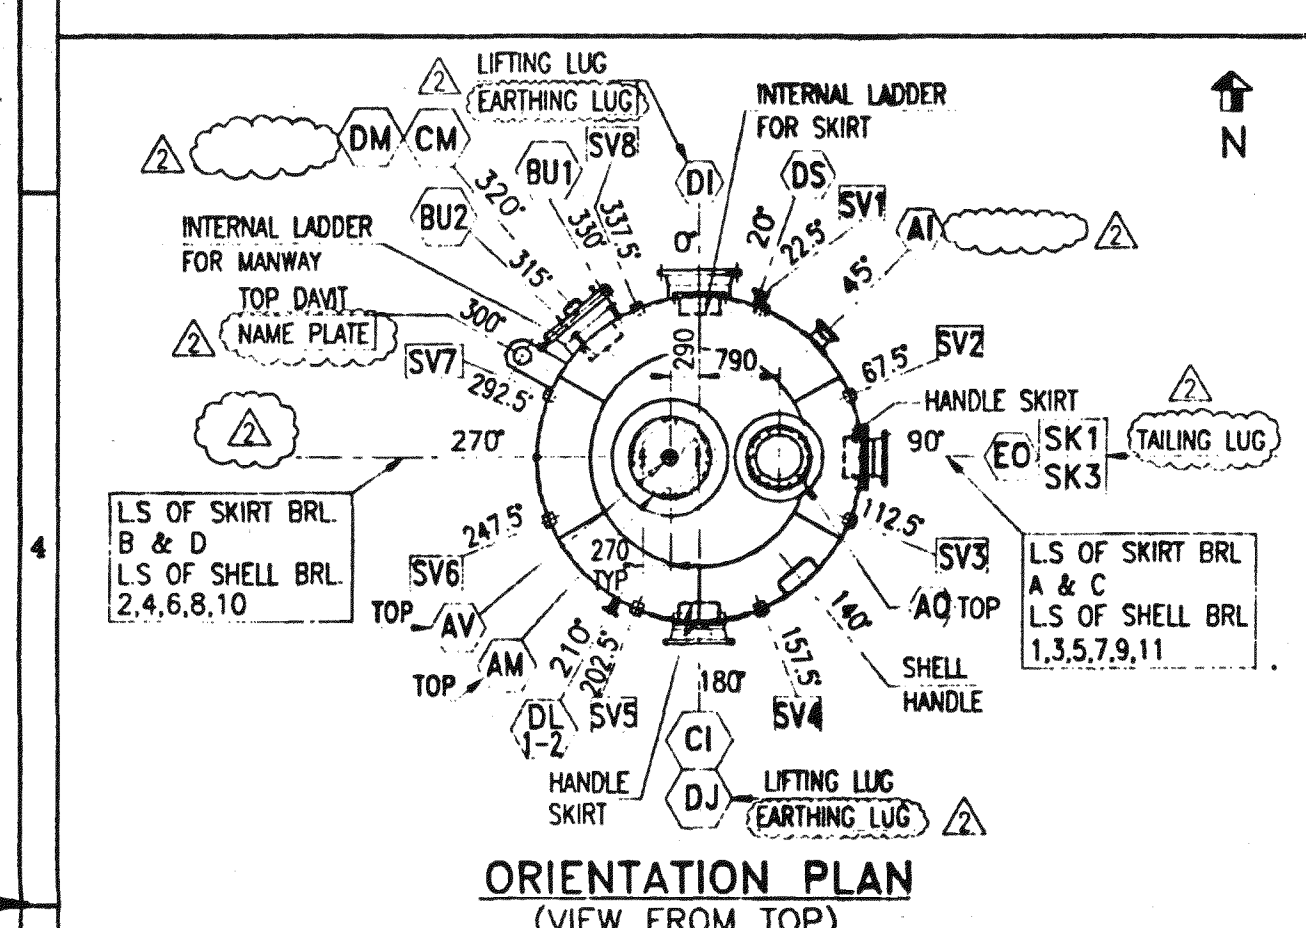








BELLELI REFERENCE DRAWINGS	
DA-7033-01-002	DETAILS DRAWING
DA-7033-01-003	FORMED HEAD - TOP & BOTTOM
DA-7033-01-004	DETAIL OF INTERNALS
DA-7034-00-002	DAVIT ARRANGEMENT
DA-7033-01-006	TOP DAVIT
DA-7033-01-007	BELLELI NAME PLATE
DA-7033-01-008	ASME NAME PLATE
DA-7033-01-009	TRAY SUPPORT DETAIL (6 SHEETS)
DA-7033-01-010	CLIPS FOR PLATFORM/LADDERS (2 SHTS)
DA-7033-01-011	CLIPS FOR INSUL. FIRE PROOFING & PIPE SUPP.
ST-7033-01-001	FINISH REQUIREMENTS
DO-7033-01-001	SHIPPING/TESTING ARRANGEMENT

21	MARK INDICATES THE BSHI WELD STANDARD NUMBER.
22	MARK INDICATES THE POSITION NUMBER WITH REFERENCE TO LIST OF MATERIAL
23	MARK INDICATES THE NOZZLE MARK NUMBER.
24	SHOP HYD. TEST GASKETS - () BLUNDED NOZZLES WILL HAVE JOB GASKETS.
25	WEIGHT OF TRAYS, FIREPROOFING.
26	FOR CARBON AND CARBON MANGANESE STEEL THE CARBON CONTENT SHALL BE LIMITED TO 0.25% MAXIMUM
27	THE LONGITUDINAL WELD SEAMS OF NOZZLES INSTALLED HORIZONTALLY SHALL BE POSITIONED ABOVE CENTER LINE

MARK	QTY	SIZE	SERVICE	NOZZLE NECK	NOZZ. FLANGE	REIN. PAD
SK3	1	10	628.0	PLT	9.00	
SK1	1	10	610.0	PLT	9.00	
SVI-8	8	4"	114.3	40	6.02	
EO	1	14"	356	PLT	12.0	WNRF 150# 680 16
DS	1	2"	60.3	160	8.74	WNRF 150# 150 14
DM	1	24"	610.0	PLT	12.0	WNRF 150# 1150 14
DL1,2	2	2"	60.3	160	8.74	WNRF 300# 150 14
DJ	1	20"	508.0	PLT	12.0	WNRF 150# 970 14
CI	1	24"	610	PLT	12.0	WNRF 150# 1150 14
DM	1	24"	610.0	PLT	12.0	WNRF 150# 1150 14
CI	1	4"	114.3	120	11.13	WNRF 150# 210 14
BU1,2	2	1"	50.8	12	12.7	LWNRF 150# 870 16
AV	1	2"	60.3	160	8.74	WNRF 150# 150 14
AO	1	18"	457.0	PLT	12.0	WNRF 150# 1150 14
AI	1	24"	610	PLT	12.0	WNRF 150# 1150 14
AM	1	6"	168.3	80	10.97	WNRF 150# 300 14

No.	DESIGN CONDITIONS	UNITS	VALUES
33	FABRICATION WEIGHT	Kg	~63100 (SEE NOTE-23)
32	FULL OF WATER WEIGHT (AT SITE)	Kg	397603
31	OPERATING WEIGHT	Kg	163603
30	ERECTION WEIGHT	Kg	72719 (SEE NOTE-24)
29	MANUFACTURER'S SERIAL No.		2361
28	MANUFACTURER'S JOB NUMBER		7033-01
27	MANUFACTURER'S NAME		BELLELI SAUDI HEAVY IND. LTD.
26	CODE STAMP		YES
25	DESIGN CODE		ASME SEC VIII DIV.1
24	SERVICE		1995 EDITION
23	VOLUME	m ³	272
22	FIREPROOFING (BY OTHERS)	mm	75 (BOTH SIDES OF SKIRT)
21	INSULATION (BY OTHERS) TOP/BOTTOM	mm	40/50
20	SPECIFIC GRAVITY		0.726
19	OPERATING FLUID		HYDRO CARBON
18	INSPECTION AUTHORITY		CLIENT/BSHI/ABS
17	WIND SPEED/EXPOSURE CATEGORY	km/hr	125/C
16	EARTHQUAKE DESIGN		ASCE-7.88 ZONE 1
15	MINIMUM DESIGN METAL TEMPERATURE	°C	9
14	CHARPY IMPACT TEST		NO (EXEMPTED AS PER UG 20)
13	ULTRASONIC EXAMINATION		NO
12	POST WELD HEAT TREATMENT		NO
11	JOINT EFFICIENCY (SHELL/HEAD)	%	85 / 100
10	RADIOGRAPHY (SHELL/HEAD)		SPOT (RT)/FULL (SEE NOTE-22)
9	CORROSION ALLOWANCE (SUPPORT)	mm	3 (1.6)
8	M.A.W.P. AT DESIGN TEMPERATURE	barG	7.9 (LIMITED BY SHELL)
7	M.A.P. (NEW & COLD)	barG	8.3 (LIMITED BY SHELL)
6	FIELD HYDROTEST PRESSURE (CORROSION)	barG	5.25 (AT TOP)
5	SHOP HYDROTEST PRESSURE (HOR)	barG	13.08 (AT TOP)
4	OPERATING TEMPERATURE (TOP/BTM)	°C	124/166
3	OPERATING PRESSURE (TOP/BTM)	bar (abs)	194/166
2	DESIGN TEMPERATURE - (INT/EXT)	°C	3.5/FULL VACUUM
1	DESIGN PRESSURE	barG	


TOTAL WT. = 49477.3 Kgs.									
ITEM NO.	ITEM DESCRIPTION	LENGTH	WIDTH	THICK	WT. IN Kg.	MAT'L	MAT'L CODE	RDA	NO.
42	2 HANDLE-#19	255	0	0.0	0.4	0.8	A36	7033402001	703300-020
41	1 HANDLE-#19	816	0	0.0	1.8	1.8	A36	7033402001	703300-020
40	1 HANDLE-#19	666	0	0.0	1.5	1.5	A36	7033402001	703300-020
39	22 ROD-#19	982	0	0.0	2.3	50.6	A36	7033402001	703300-020
38	11 ROD-#19	832	0	0.0	1.9	20.9	A36	7033402001	703300-020
37	1 PI 4"-40(HALF PIPE)	400	0	0.0	6.5	6.5	A106GRB	7033406119	703300-001
36	11 TOP PLATE	10864	100	10.0	85.2	937.2	A283GRC	7033401157	703300-001
35	11 RING 3448/3228/10T	0	0	0.0	90.6	996.6	AS16GR70	7033401128	703300-001
34	2 EARTHING LUG	145	38	12.0	0.5	1.0	SS304	2077A1601	STOCK
33	8 RIVET #5	20	0	0.0	2.0	16.0	COPPER	7033421801	703300-021
32	1 ASME NAME PL	220	120	5.0	0.6	0.6	SS304	000100050122	STOCK
31	1 BELLELI NAME PL	160	100	5.0	0.4	0.4	SS304	000100050122	STOCK
30	1 NAME PL BRACKET	438	270	6.0	5.6	5.6	SAS16GR70	LP060A5172500800	STOCK
29	1 RP 00970/518/14T	0	0	0.0	58.0	58.0	SAS16GR70	7033401112	703300-001
28	1 F 2"-150/WNRF	0	0	0.0	77.1	77.1	SA105	7033404F16	703300-004
27	1 NOZZ. NECK-DJ	1558	141	12.0	20.7	20.7	SAS16GR70	7033401104	703300-001
26	2 F 1"-150/WNRF	165	0	0.0	2.5	5.0	SA105	7033404F01	703300-004
25	2 PI 2"-150	102	0	0.0	1.1	2.2	SA105GRB	7033406101	703300-006
24	3 RP 00150/70/14T	0	0	0.0	1.5	4.5	SAS16GR70	7033401112	703300-001
23	3 F 2"-150/WNRF	0	0	0.0	2.7	8.2	SA105	7033404F03	703300-004
22	1 PI 2"-150	102	0	0.0	1.1	1.1	SA105GRB	7033406101	703300-006
21	0 DELETED	0	0	0.0	0.0	0.0			
20	1 F 2"-150/WNRF	0	0	0.0	2.7	2.7	SA105	7033404F03	703300-004
19	1 PI 2"-150	134	0	0.0	1.5	1.5	SA105GRB	7033406101	703300-006
18	1 RP 00870/467/18T	0	0	0.0	53.2	53.2	SAS16GR70	7033401116	703300-001
17	1 F 18"-150/WNRF	0	0	0.0	63.6	63.6	SA105	7033404F15	703300-004
16	1 NOZZ. NECK-AO	1398	496	12.0	65.4	65.4	SAS16GR70	7033401104	703300-001
15	3 RP 001150/620/14T	0	0	0.0	81.0	243.0	SAS16GR70	7033401112	703300-001
14	3 NOZZ. NECK-CM/DLM	1879	192	12.0	34.0	102.0	SAS16GR70	7033401104	703300-001
13	12 ST+2NT 1 1/4" BUN	178	0	0.0	1.7	12.4		7033411802	703300-011
12	12 OK 24"-150/ RF	0	0	0.0	0.0	0.0		7033412004	703300-012
11	1 RP 001150/620/16T	0	0	0.0	92.5	92.5	SAS16GR70	7033401116	703300-001
10	3 F 24"-150/ RF	0	0	0.0	187.0	561.0	SA105	7033404F21	703300-004
9	4 F 24"-150/WNRF	0	0	0.0	118.0	472.0	SA105	7033404F17	703300-004
8	1 NOZZ. NECK-AM	1879	360	12.0	63.7	63.7	SAS16GR70	7033401104	703300-001
7	1 SKIRT ERL-C	10103	1045	12.0	994.5	994.5	A36	7033401158	703300-001
6	2 SKIRT BRL-BAD	10103	3000	12.0	2858.0	5716.0	A36	7033401158	703300-001
5	1 SKIRT ERL-A	10103	500	12.0	475.9	475.9	SAS16GR70	7033401104	703300-001
4	2 EH 0320015T(NOM)	0	0	0.0	1356.4	2672.8	SAS16GR70	7033401116	703300-001
3	3 SHELL ERL-3	10097	3000	14.0	3329.0	9986.1	SAS16GR70	7033401109	703300-001
2	1 SHELL ERL-2	10097	3050	14.0	3384.5	3384.5	SAS16GR70	7033401110	703300-001
1	1 SHELL ERL-1	10097	2000	14.0	2219.3	2219.3	SAS16GR70	7033401112	703300-001

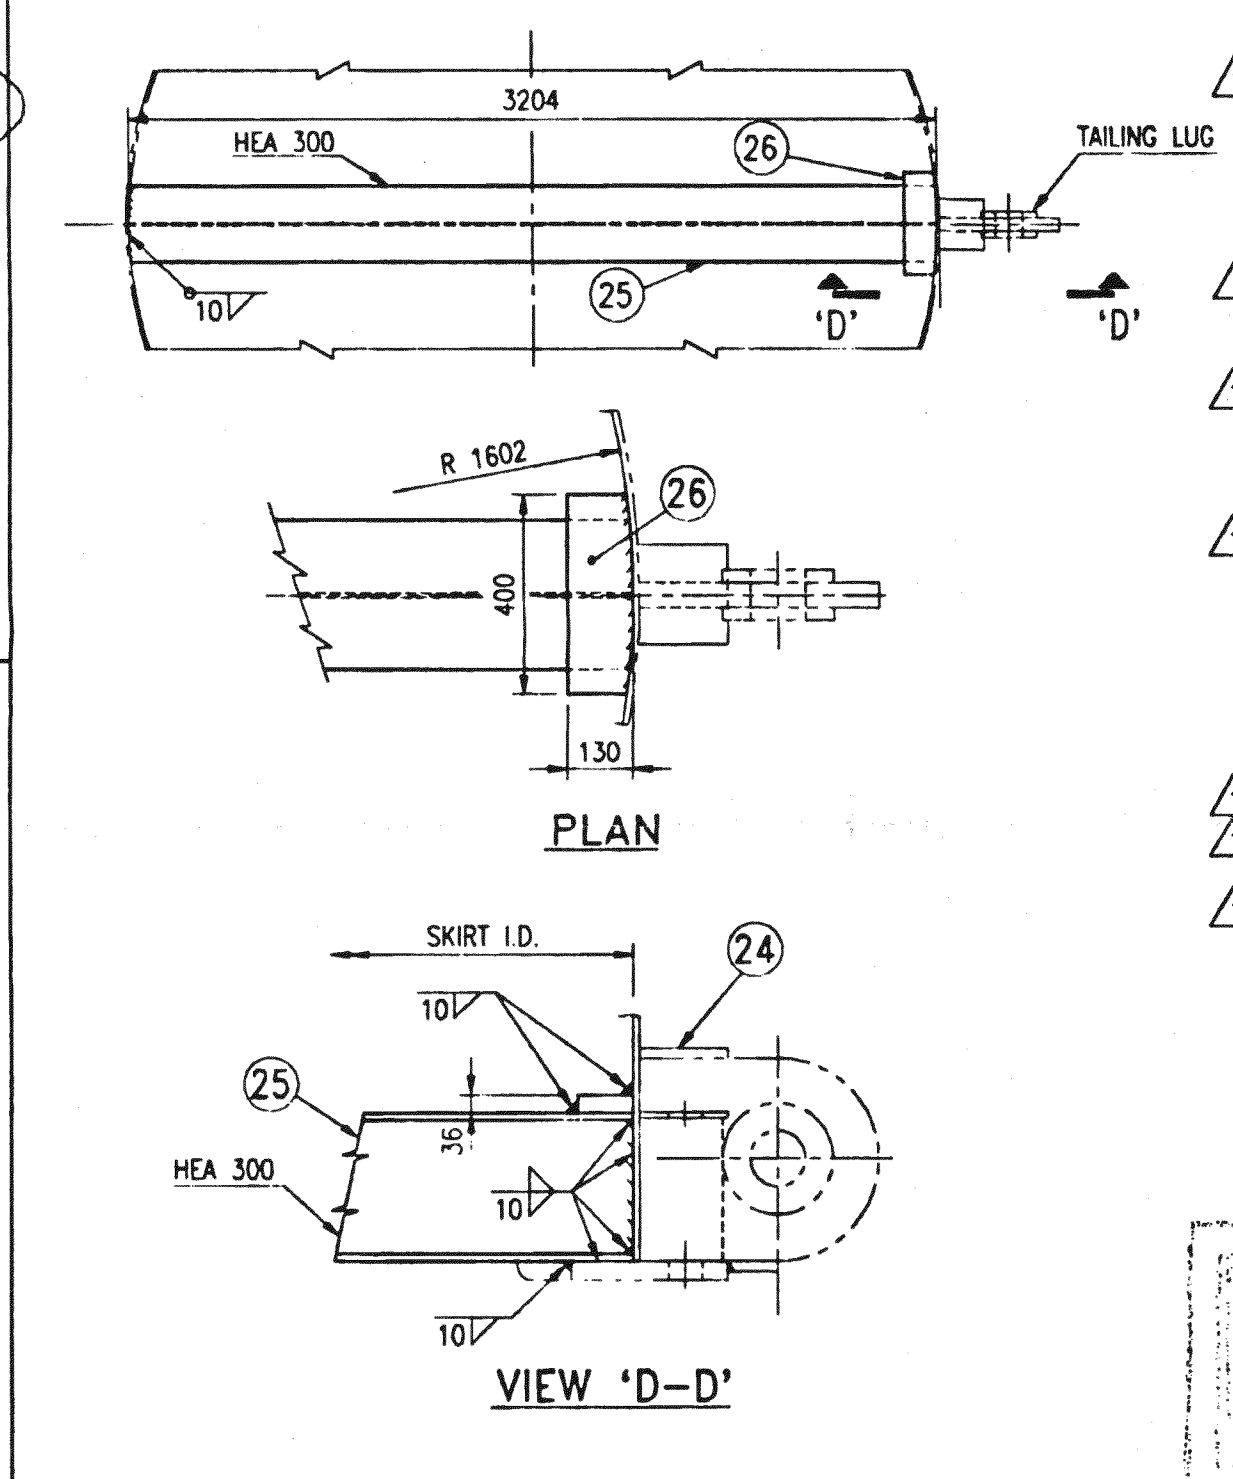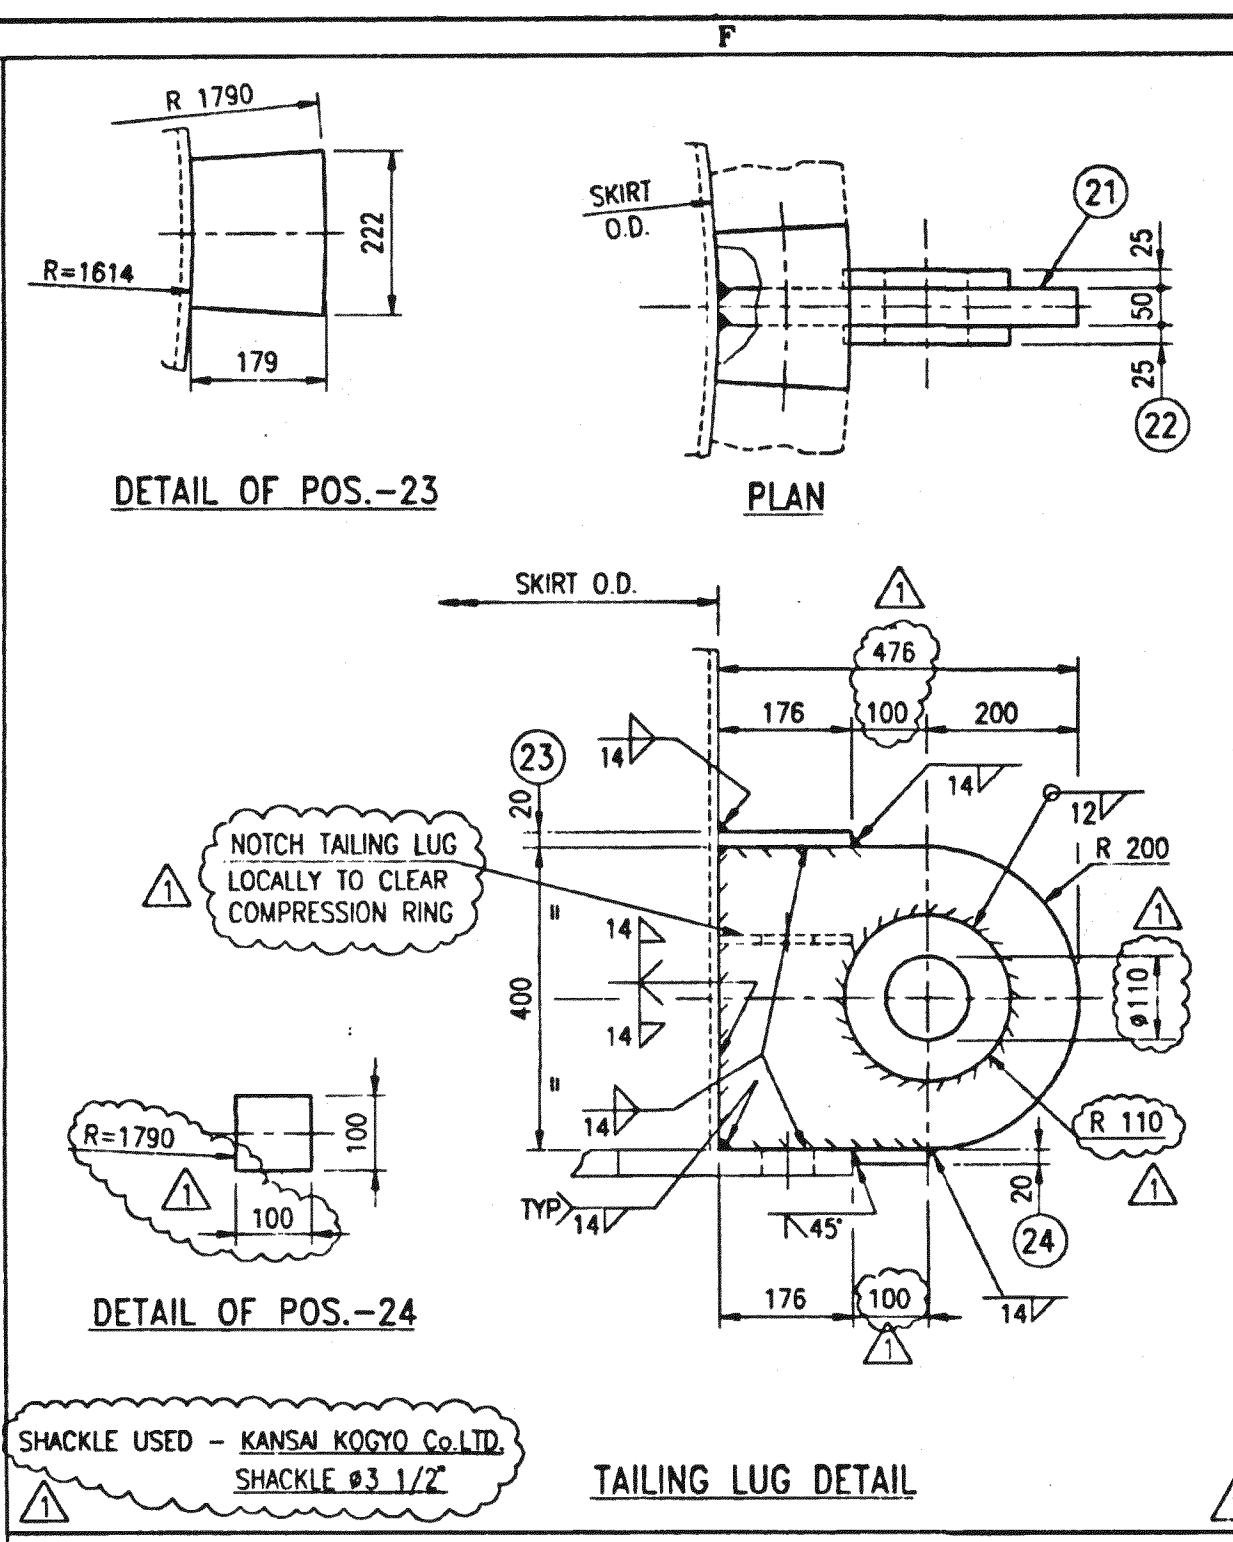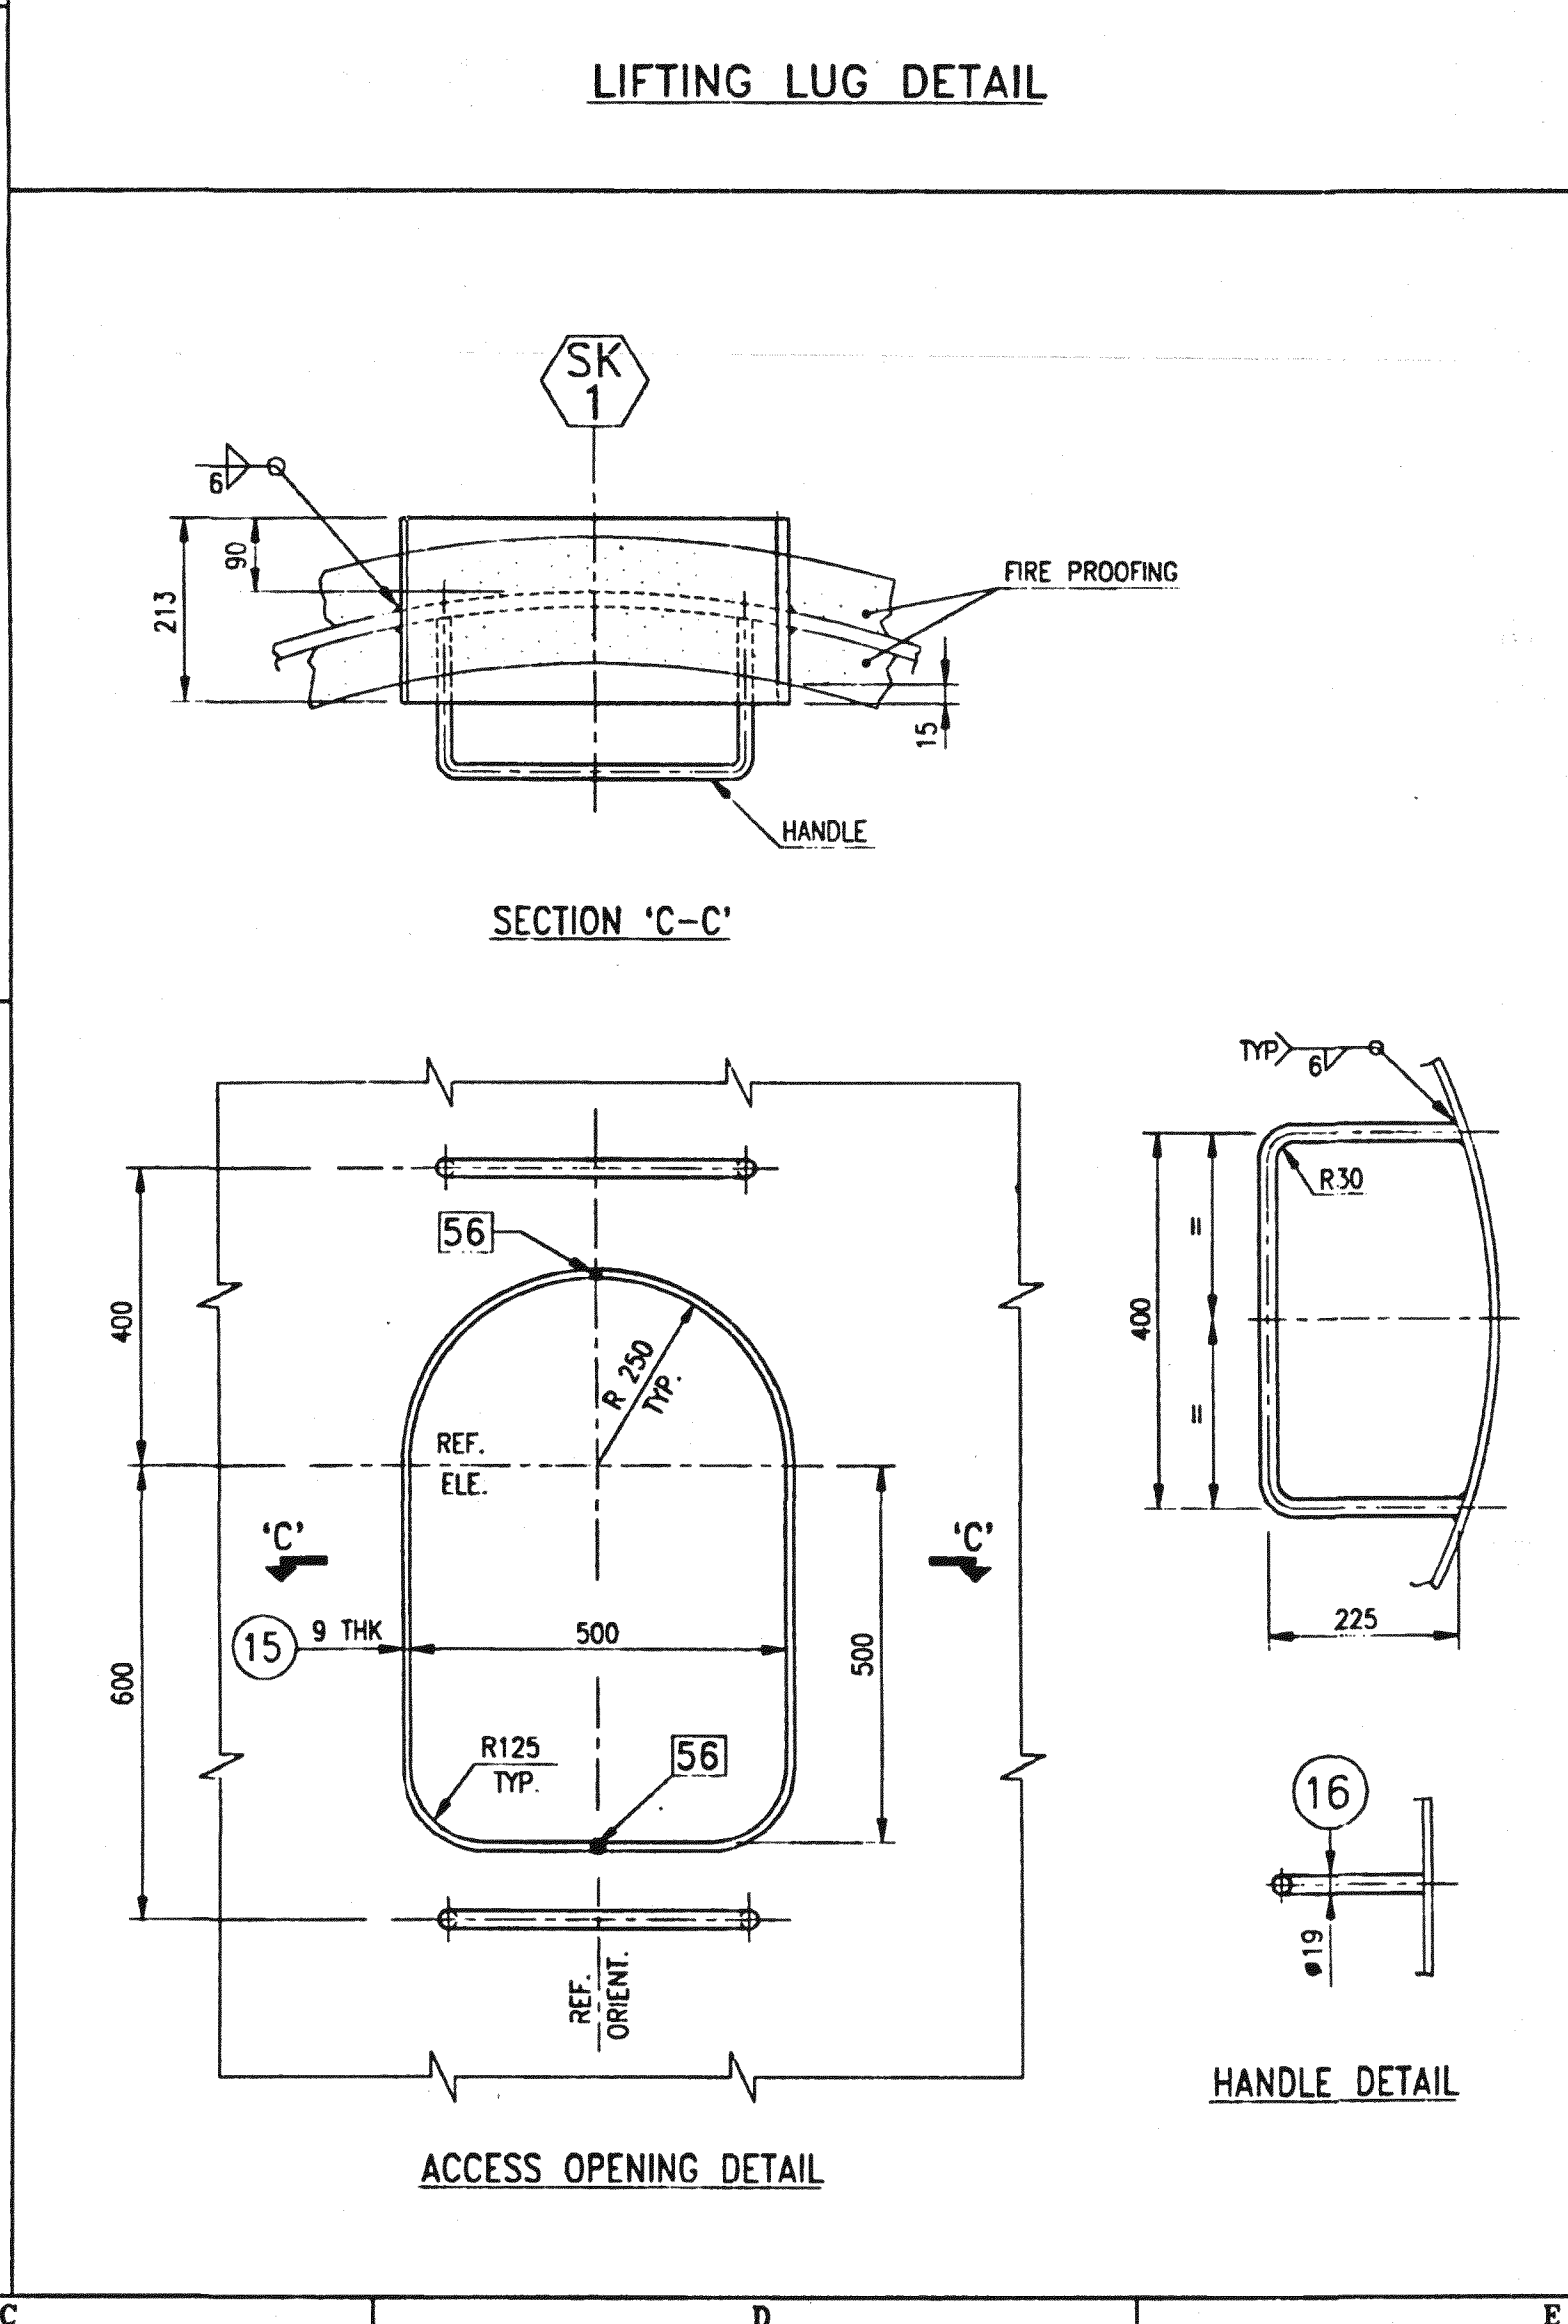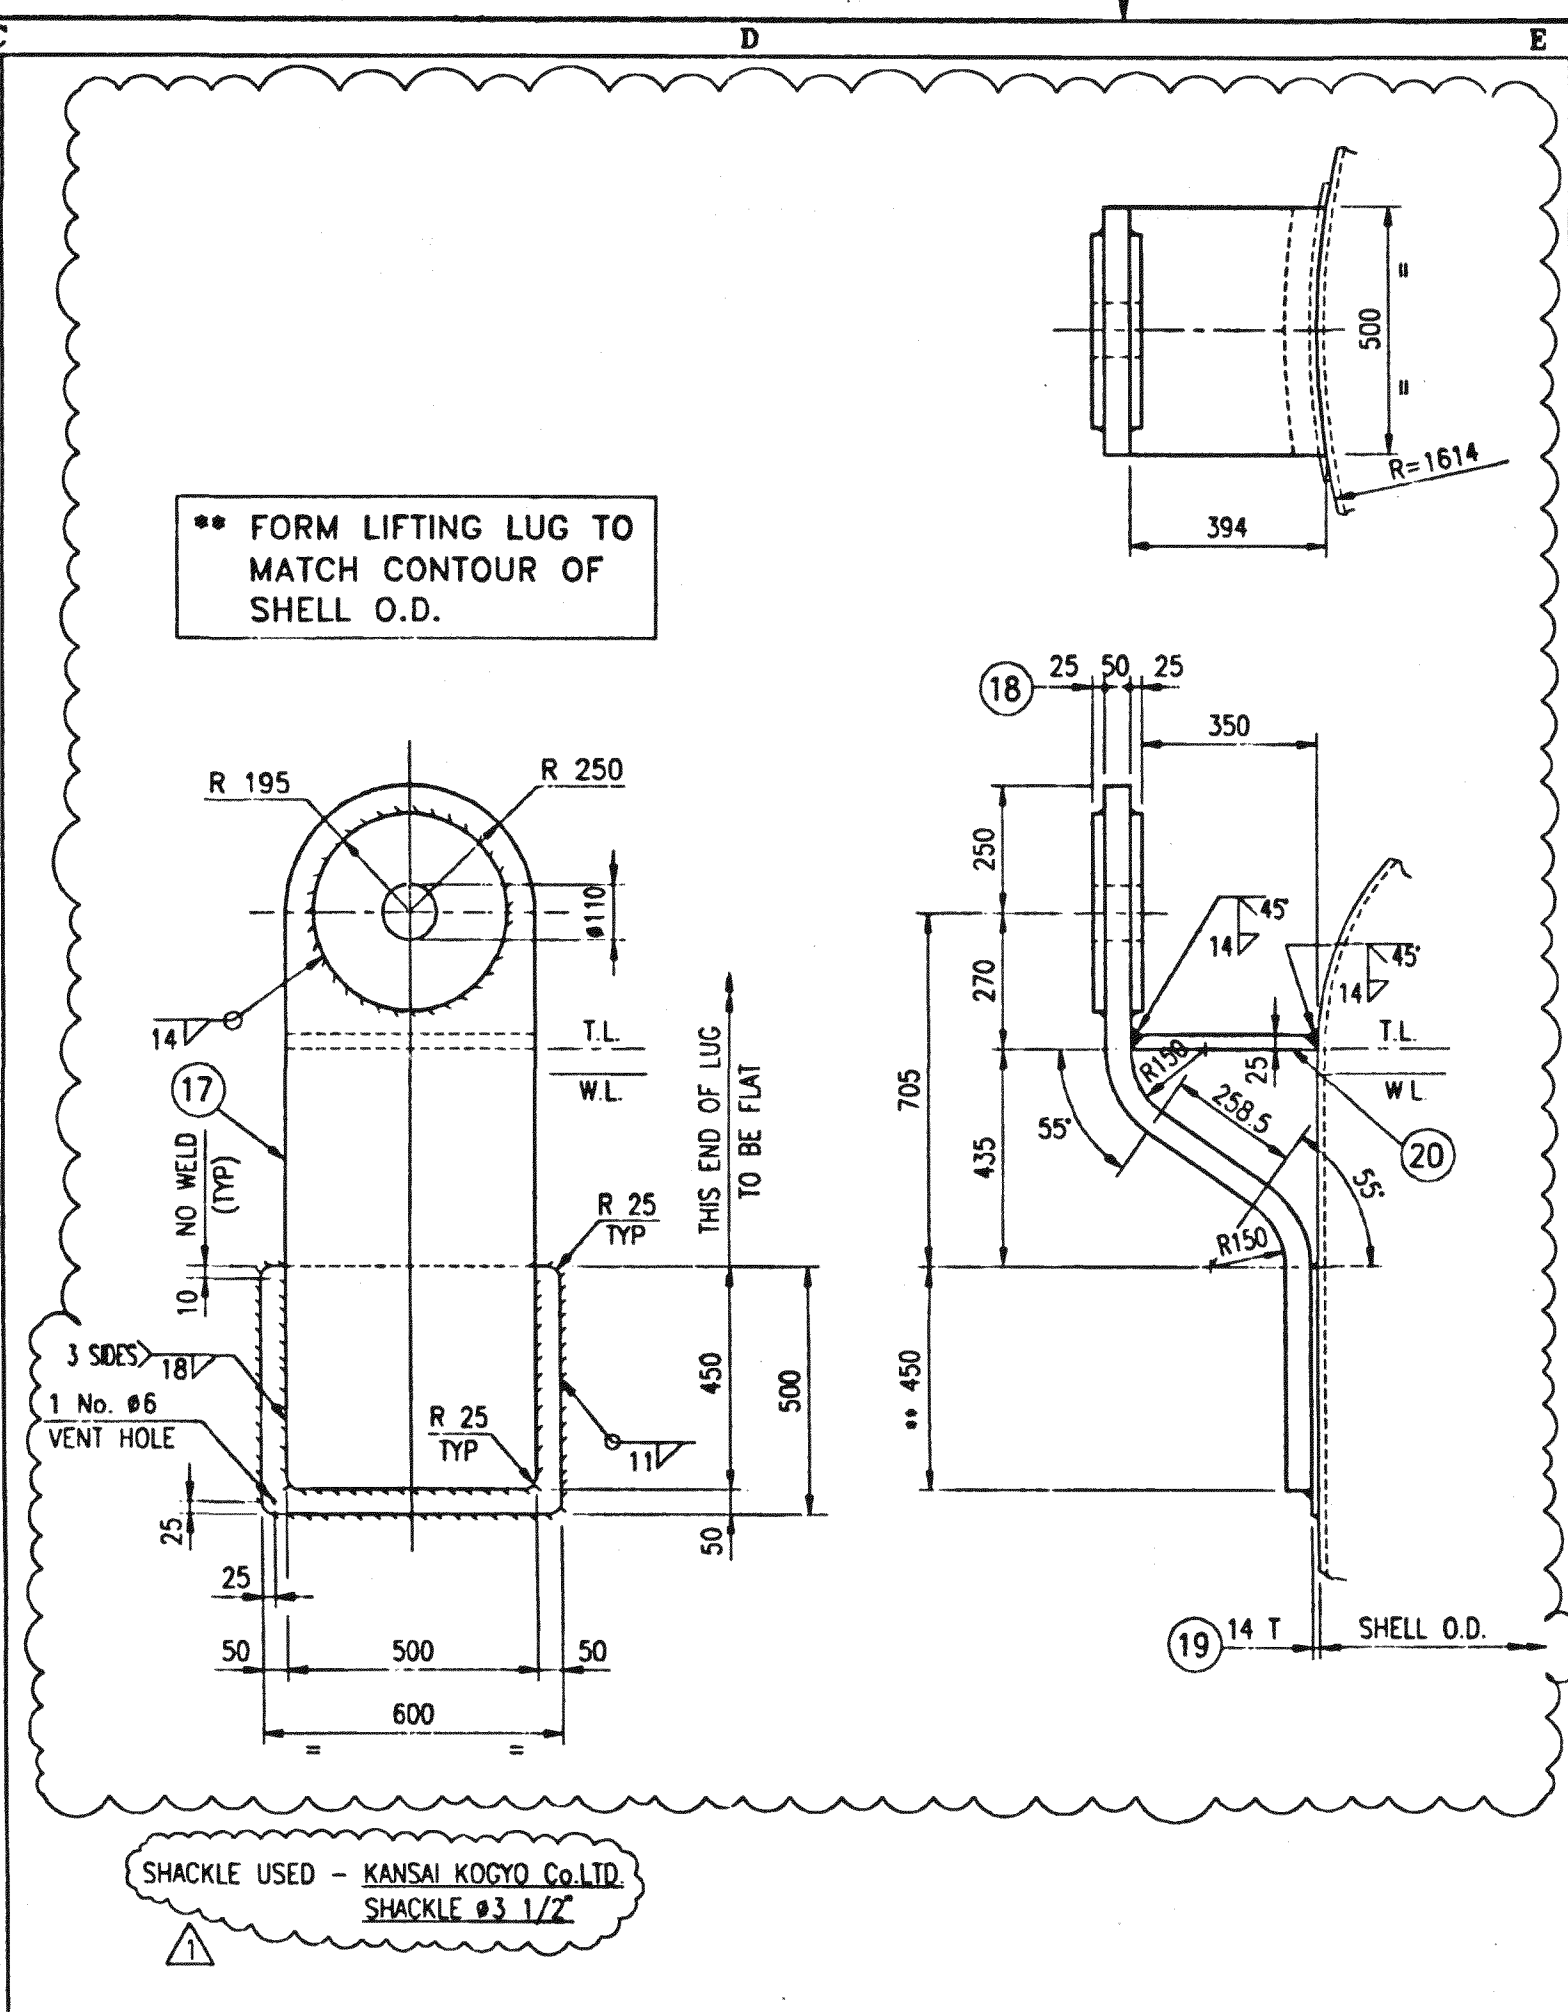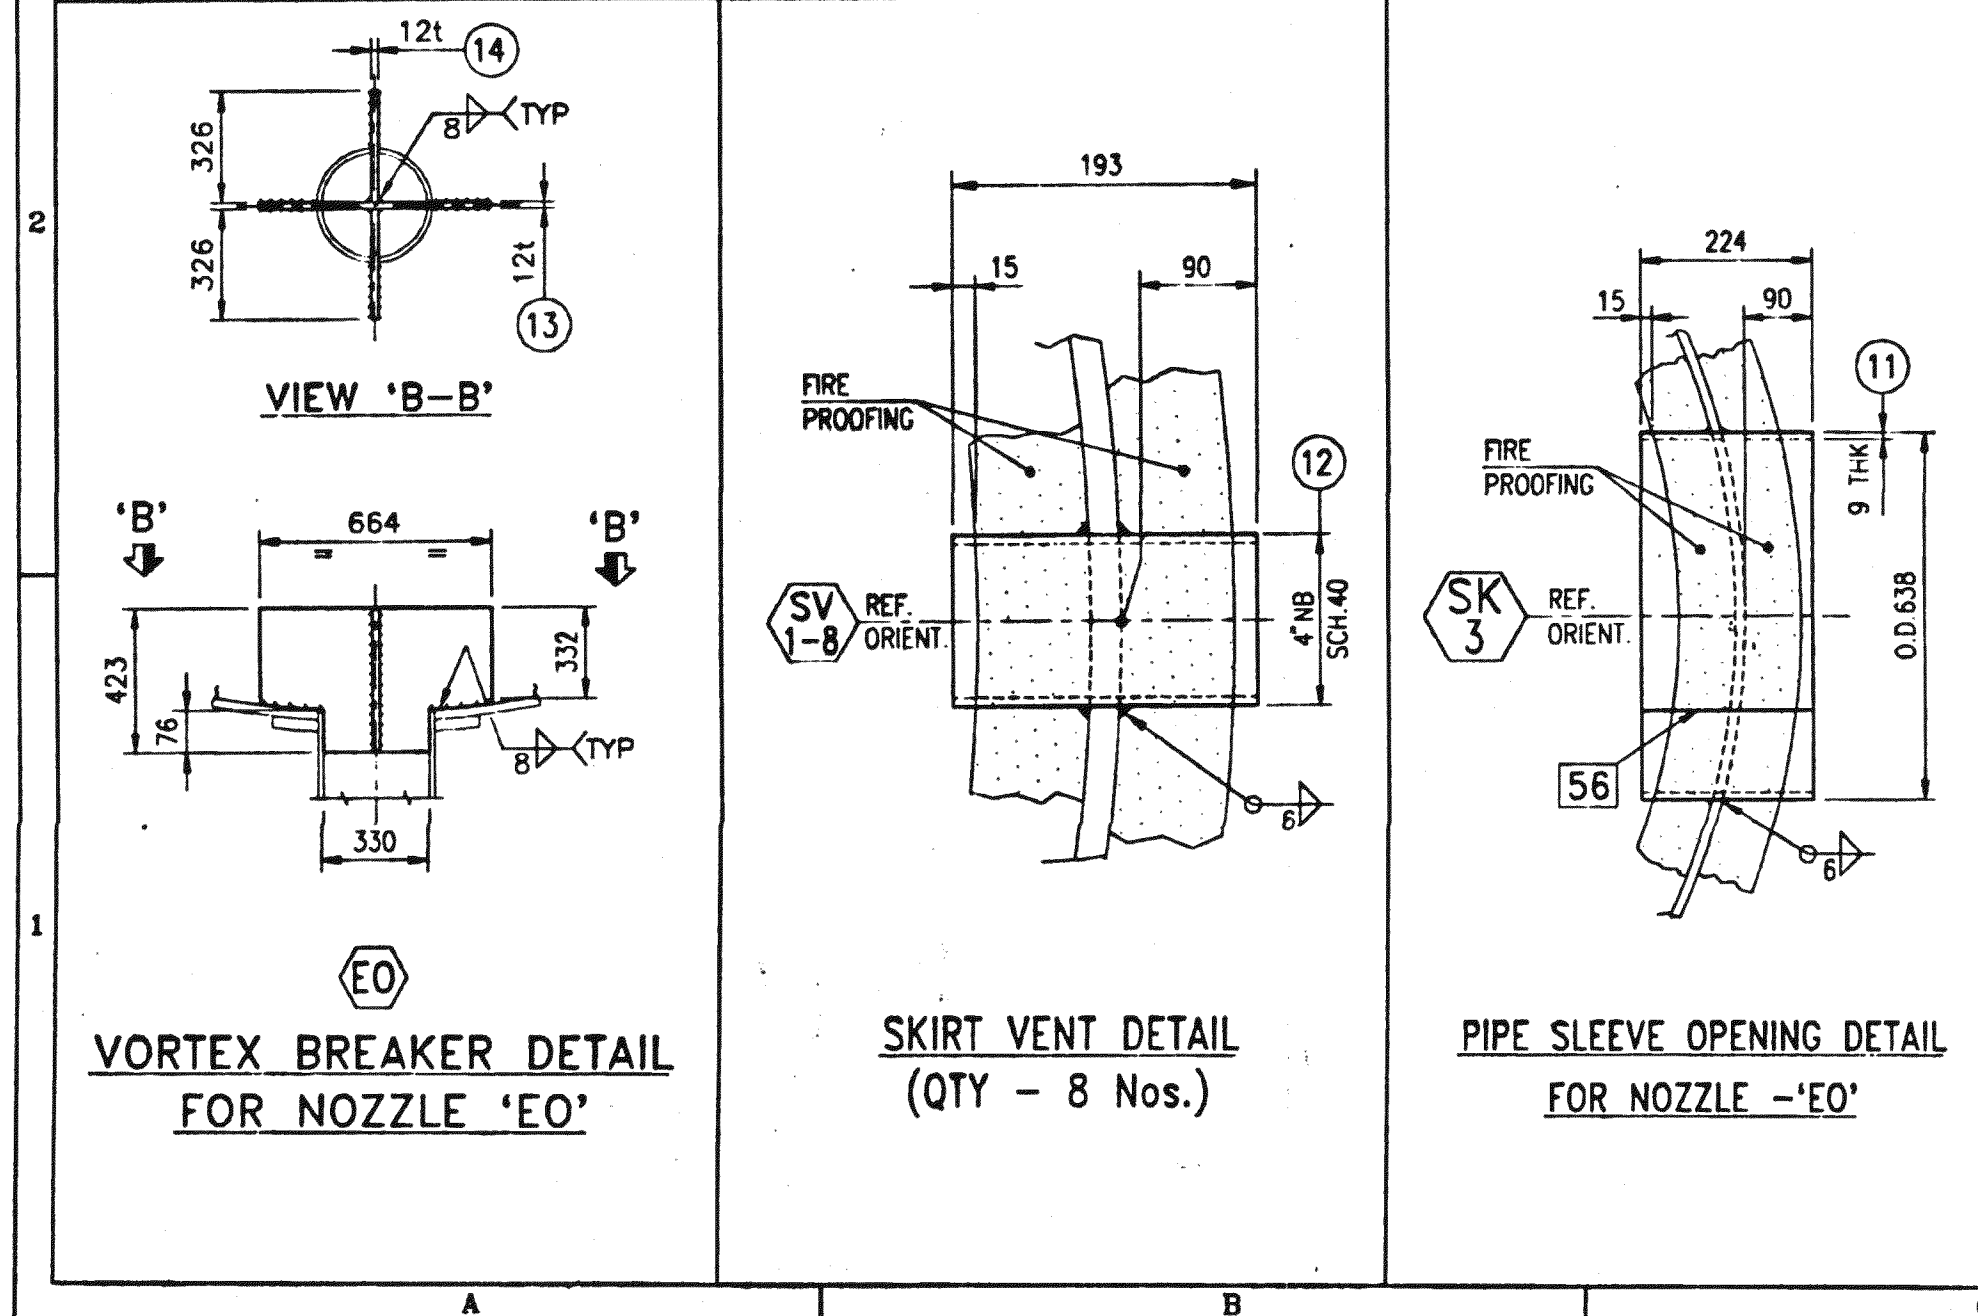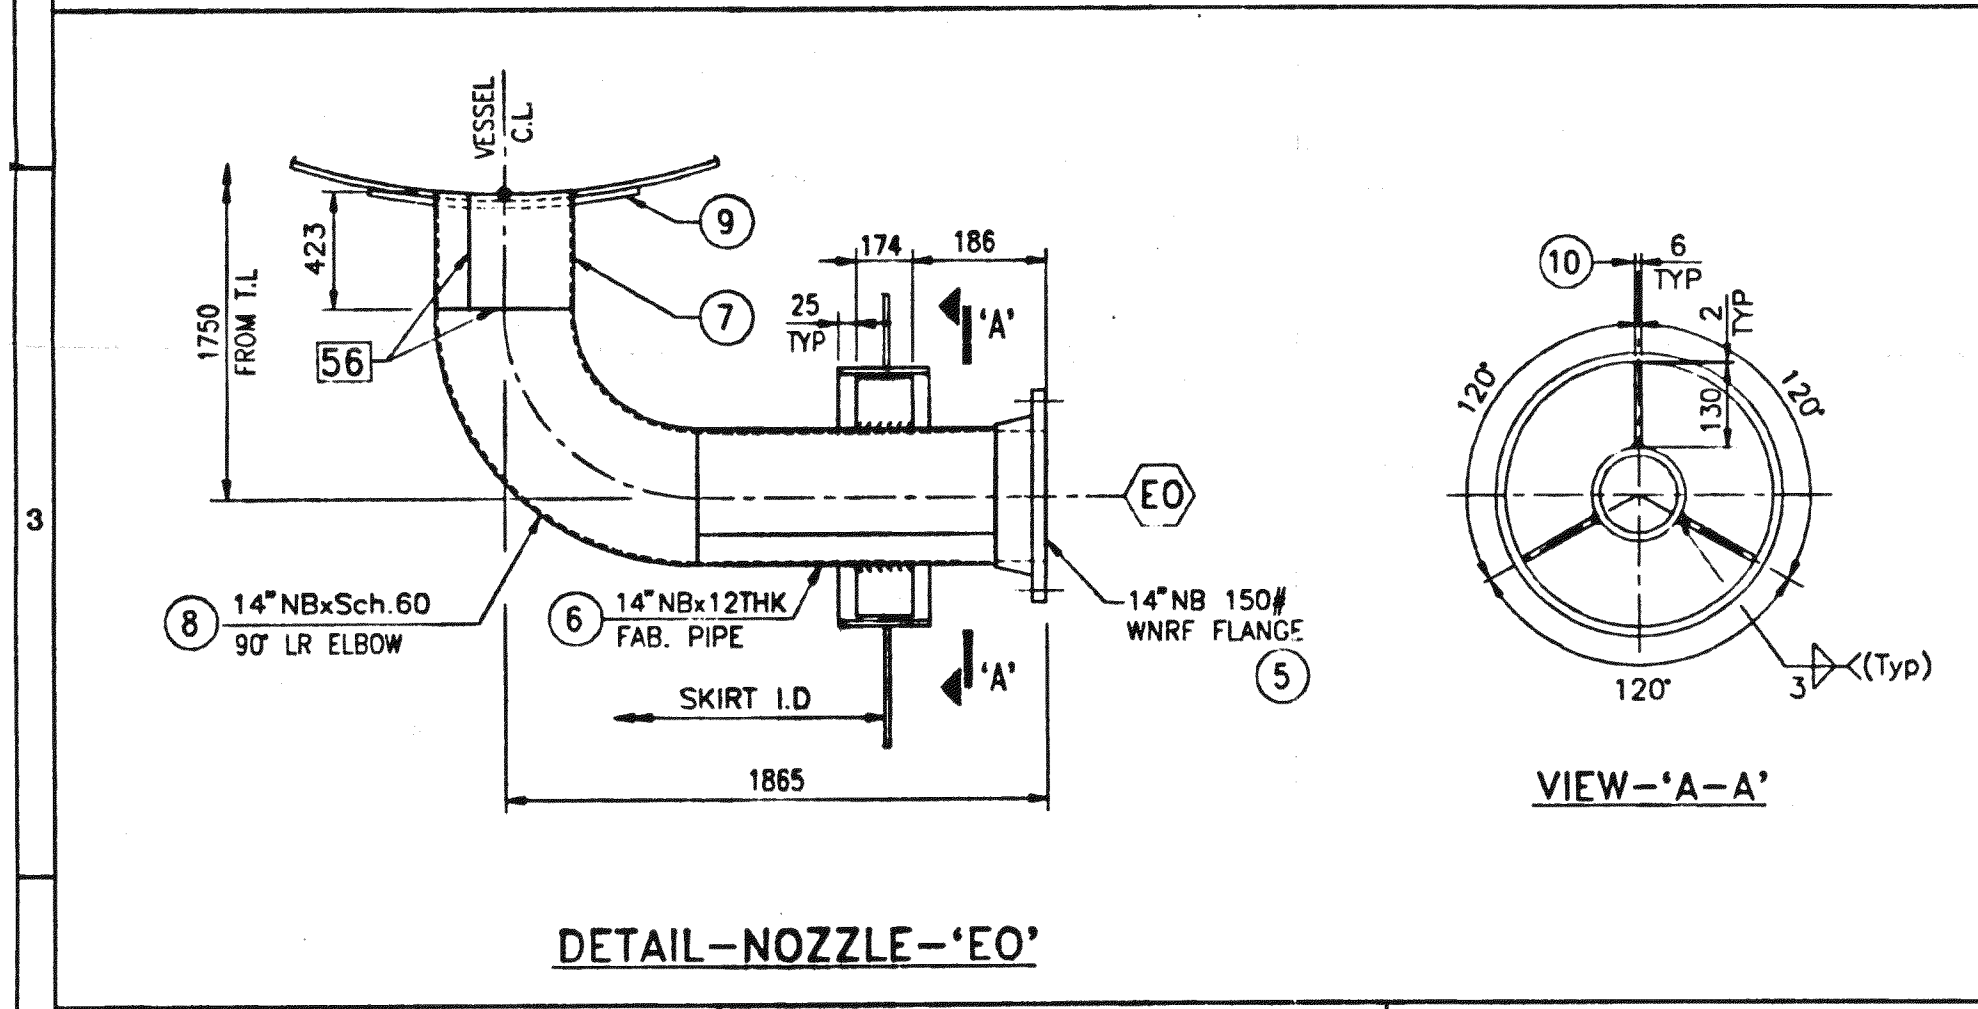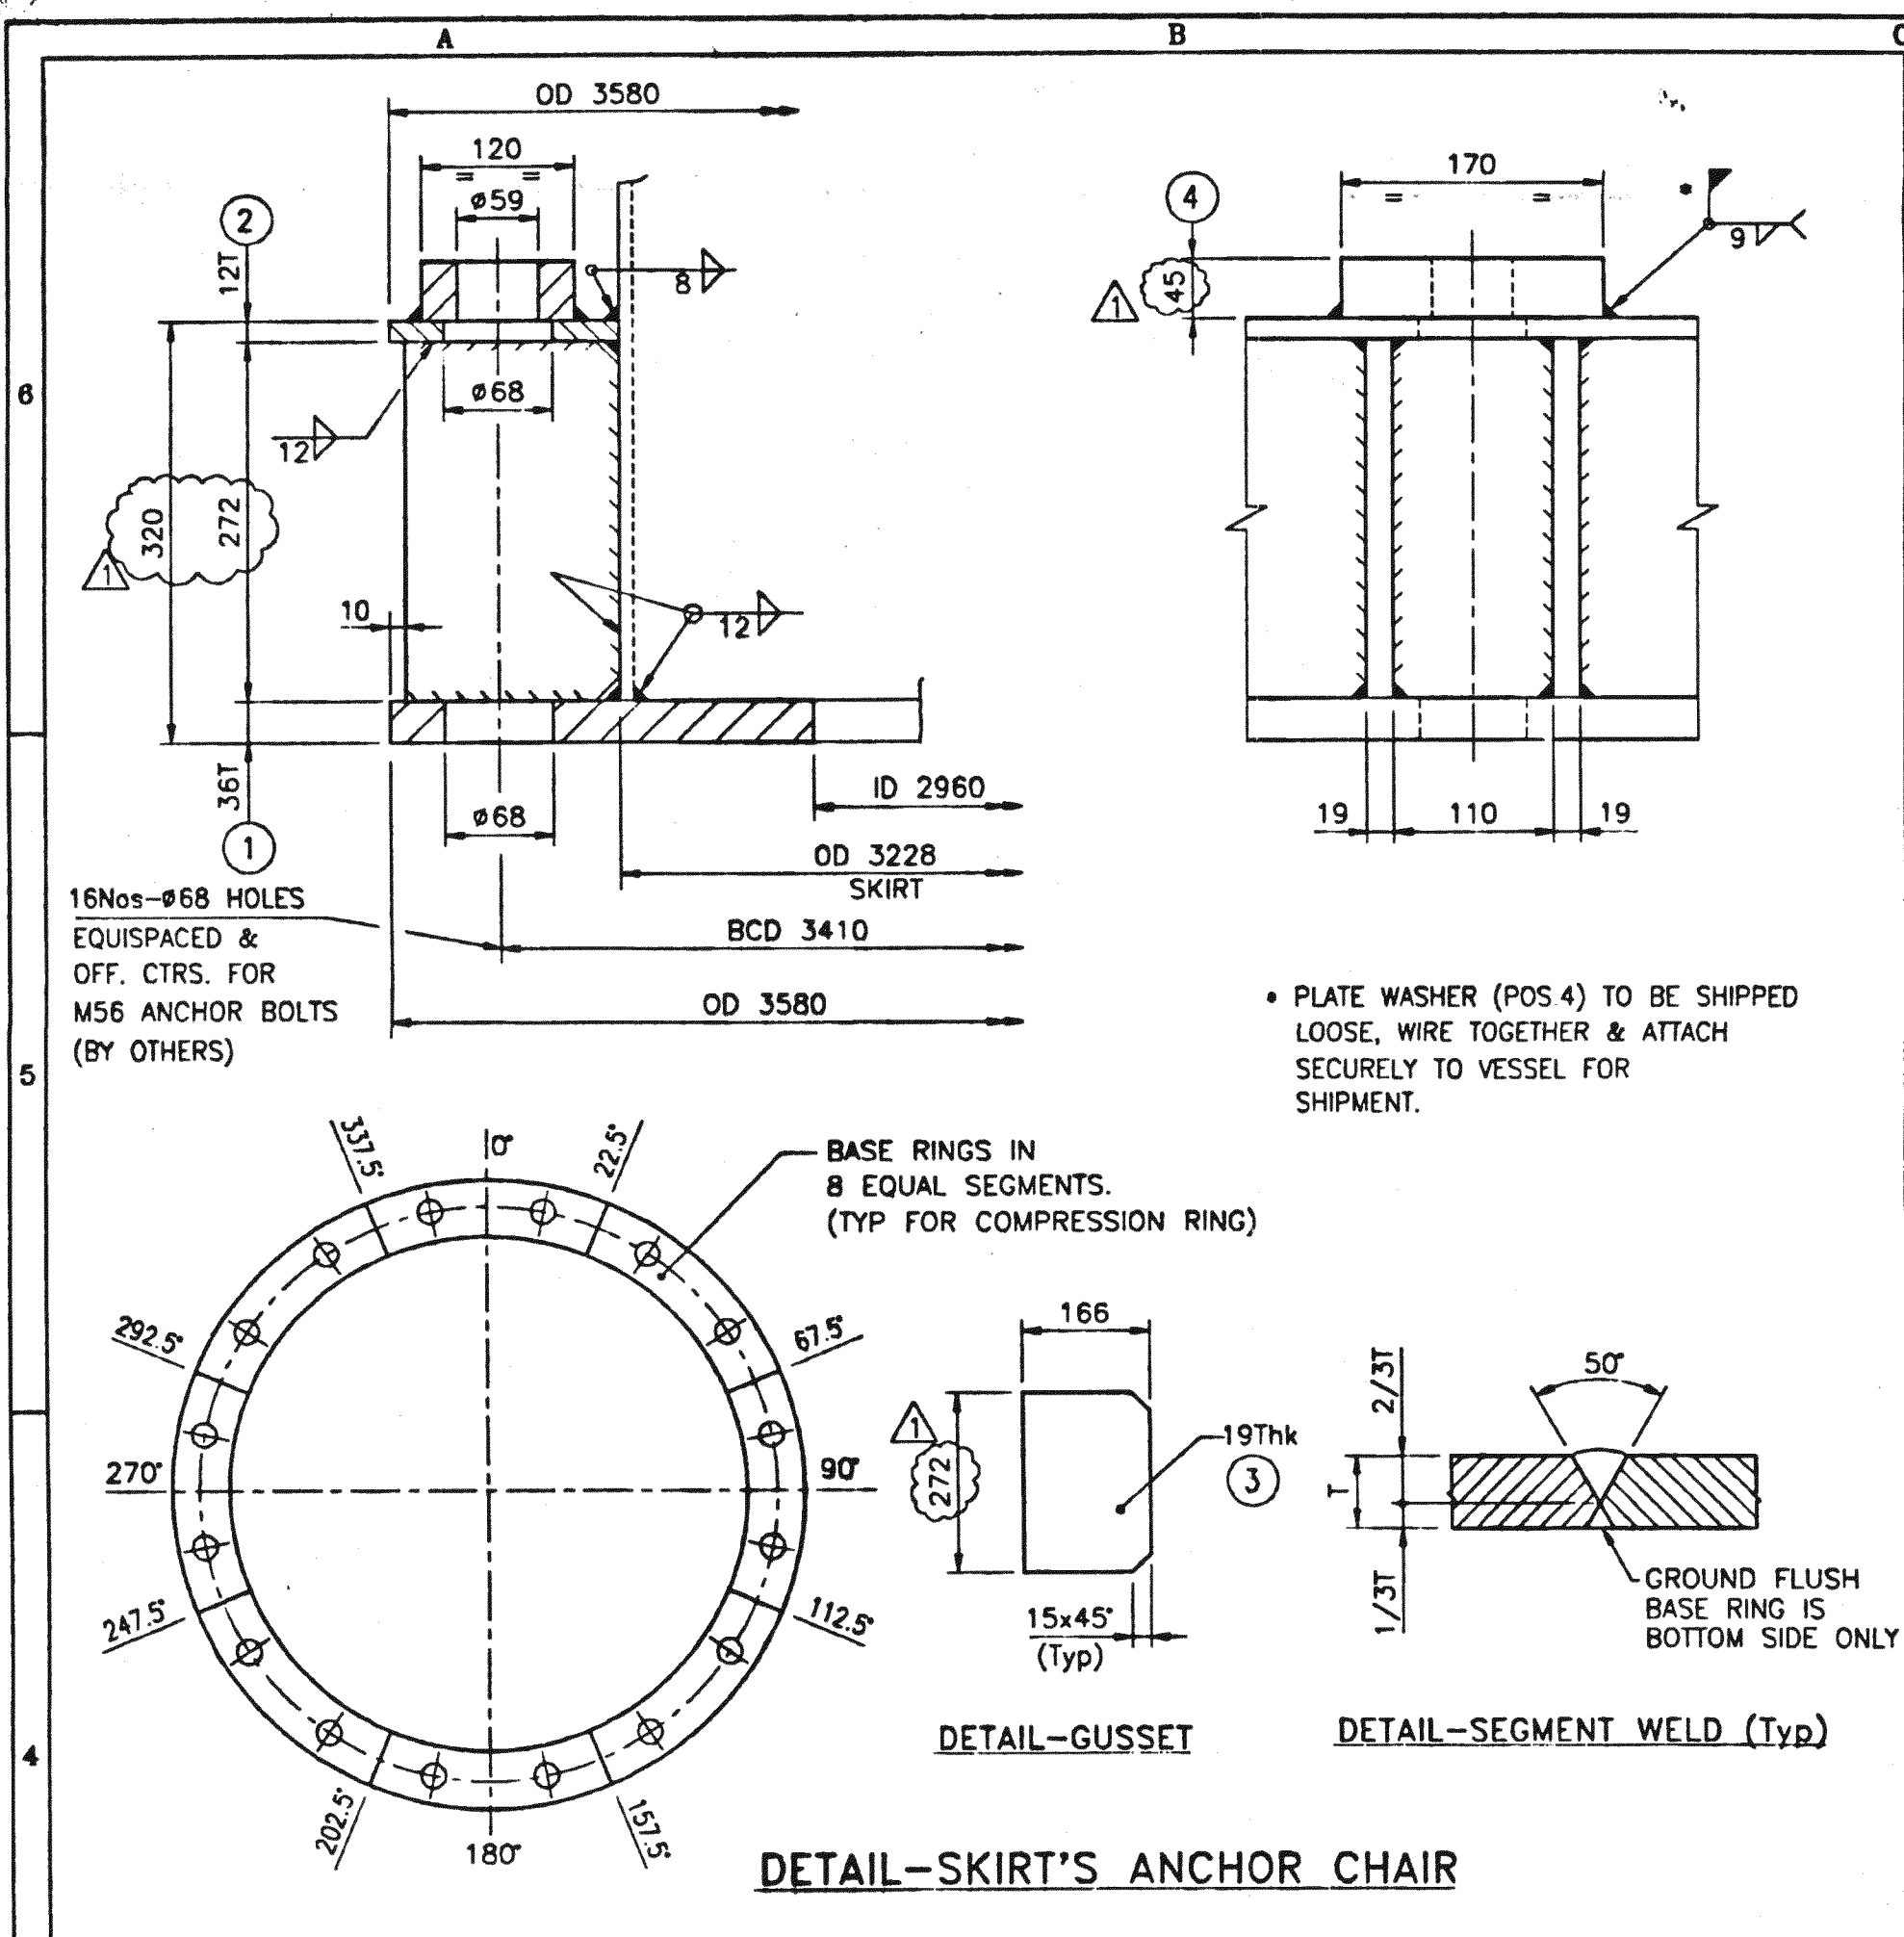


TOTAL WT. = 3105.6 Kgs.									
ITEM NO.	DESCRIPTION	LENGTH	WIDTH	THICK	WT. IN Kg.	WT. IN Kg.	MAT'L	MAT'L CODE	RDA. NO.
26	1 SUPPORT	400	130	36.0	14.7	14.7	A36	7033001166	703300-001
25	1 BEAM - HEA300	3204	0	0.0	282.9	282.9	A36	7033001163	703300-001
24	1 STIFFENER (SEE DWG)	100	100	20.0	1.6	1.6	A36	7033001163	703300-001
23	1 STIFFENER (SEE DWG)	222	179	20.0	6.2	6.2	A36	7033001164	703300-001
22	2 RING 0020/0110	0	0	25.0	5.6	11.2	A36	7033001164	703300-001
21	1 TAILING LUG	476	400	50.0	74.7	74.7	A36	7033001168	703300-001
20	2 STIFF. PLATE	500	394	25.0	38.7	77.4	A36	7033001152	703300-001
19	2 LIFTING LUG PAD	600	500	14.0	33.0	66.0	A36	7033001112	703300-001
18	4 WASHER 390/118/25T	0	0	0.0	21.6	86.4	A36	7033001164	703300-001
17	2 LIFTING LUG	1565	500	50.0	307.1	614.2	A36	7033001168	703300-001
16	2 HANDLE #19	816	0	0.0	1.8	3.6	A36	7033002001	703300-020
15	1 ACCESS OPENING	2207	213	9.0	33.2	33.2	A36	629505NT09P06	STOCK
14	2 PLATE	423	326	12.0	13.0	26.0	A36	7033001104	703300-001
13	1 PLATE	664	423	12.0	26.5	26.5	A36	7033001104	703300-001
12	8 PL 4" - 40	193	0	0.0	3.0	24.0	A36	7033006119	703300-006
11	1 PIPE WAY OPENING	1976	224	9.0	31.3	31.3	A36	629505NT09P06	STOCK
10	3 STIFFENER	174	130	6.0	1.1	3.3	A36	7033001104	703300-001
9	1 RP 680/366/16T-EO	0	0	0.0	32.4	32.4	A36	7033001116	703300-001
8	1 E 14" - 60 90LR-EO	0	0	0.0	71.6	71.6	A36	7033009004	703300-009
7	1 NOZZ. NECK-EO	1080	423	12.0	43.1	43.1	A36	7033001104	703300-001
6	1 NOZZLE NECK-EO	1080	1205	12.0	122.7	122.7	A36	7033001104	703300-001
5	1 F 14"150J WNR-12	0	0	0.0	46.3	46.3	A36	7033004113	703300-004
4	16 PLATE WASHER	170	120	45.0	7.2	115.2	A36	7033001157	703300-021
3	32 GUSSET	272	166	19.0	6.7	214.4	A36	7033001162	703300-001
2	1 RING 3580/3228/12T	0	0	0.0	177.2	177.2	A36	7033001158	703300-001
01-02	1 RING 3580/2960/36T	0	0	0.0	899.5	899.5	A36	7033001166	703300-001

REV.	DATE	DESCRIPTION	DRAWN	CHK'D	APP'D
1	10.02.97	REVISED AS PER CLIENT'S COMMENTS AND ISSUED FOR CONSTRUCTION	RJP		
0	08.10.96	ISSUED FOR APPROVAL	V SURESH KUMAR	JYOTIRAM DAKU	BANERJEE

SCALE: 1 : 30	BELLELI SAUDI بيليلي السعودية
CLIENT: CHIYODA/IBN RUSHD.	HEAVY INDUSTRIES LTD.
ORDER: SAY-POPO002	AL- JUBAIL, KINGDOM OF SAUDI ARABIA.
APPROVED FOR CONSTRUCTION BY: A.K. BANERJEE	ARABIAN INDUSTRIAL FIBRES COMPANY (IBN RUSHD.)
DATE: 10/02/97	PTA & AROMATICS PROJECT - AROMATICS
	FINISHING COLUMN (53-C-03)
	DETAIL DRAWING
QUESTO DISEGNO NON PUO' ESSERE COPIATO RIPRODOTTO MOSTRATO A TERZI SENZA NOSTRA AUTORIZZAZIONE	DRAWING NO. DA-7033-01-002
THIS DRAWING IS NOT TO BE REPRODUCED IN WHOLE OR PART NOR EMPLOYED FOR ANY PURPOSE OTHER THAN SPECIFICALLY PERMITTED IN WRITING BY BELLELI SAUDI HEAVY IND.LTD.	REV. 1

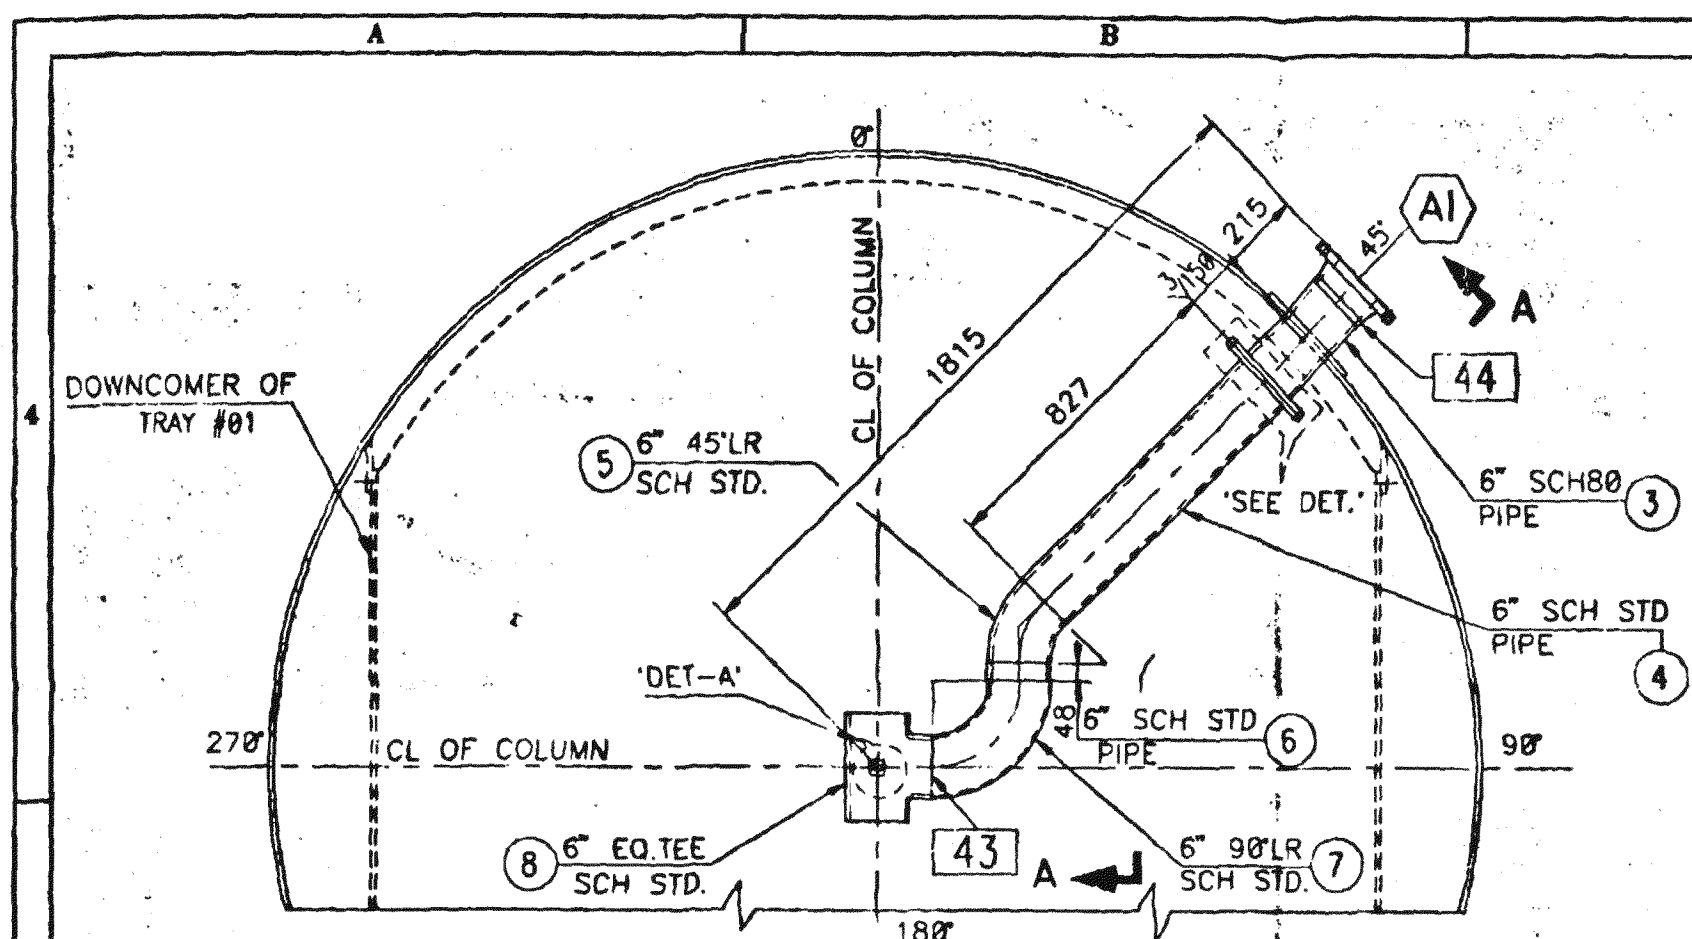


ORIENTATION-NOZZLE-AI

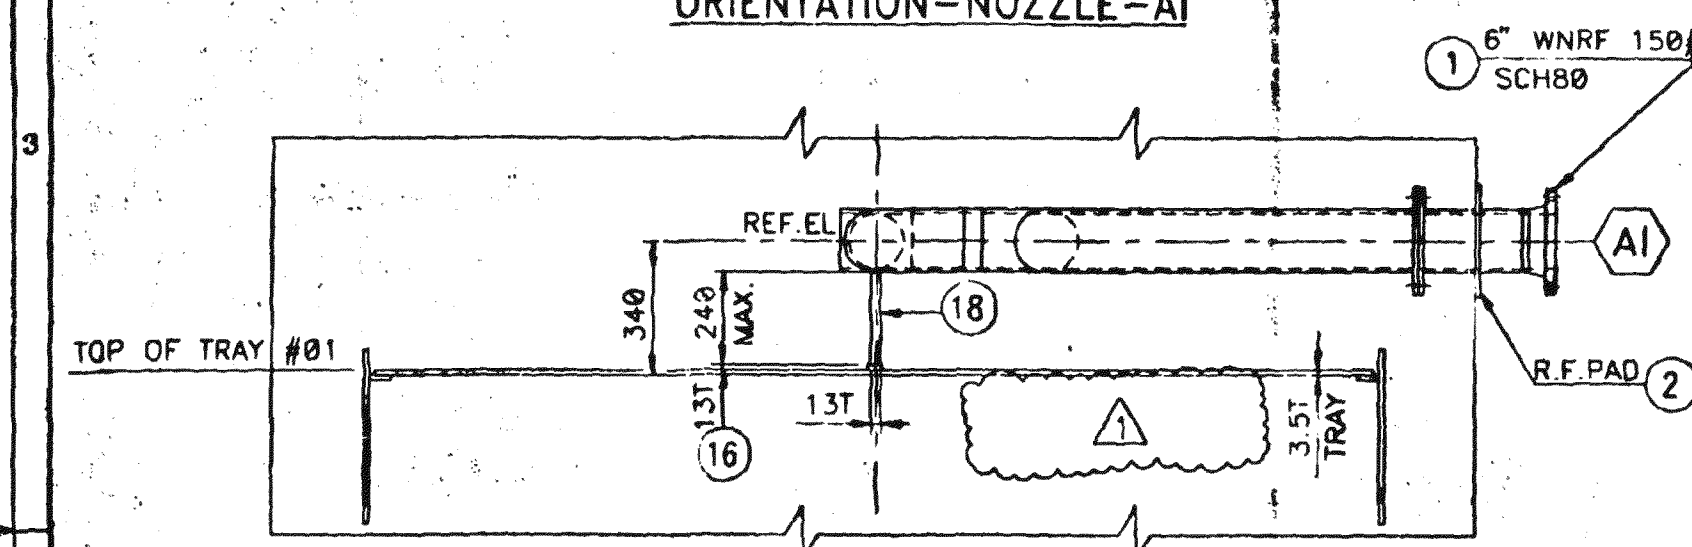



SECTION-A-A

INTERNAL DETAIL - NOZZLE-AI

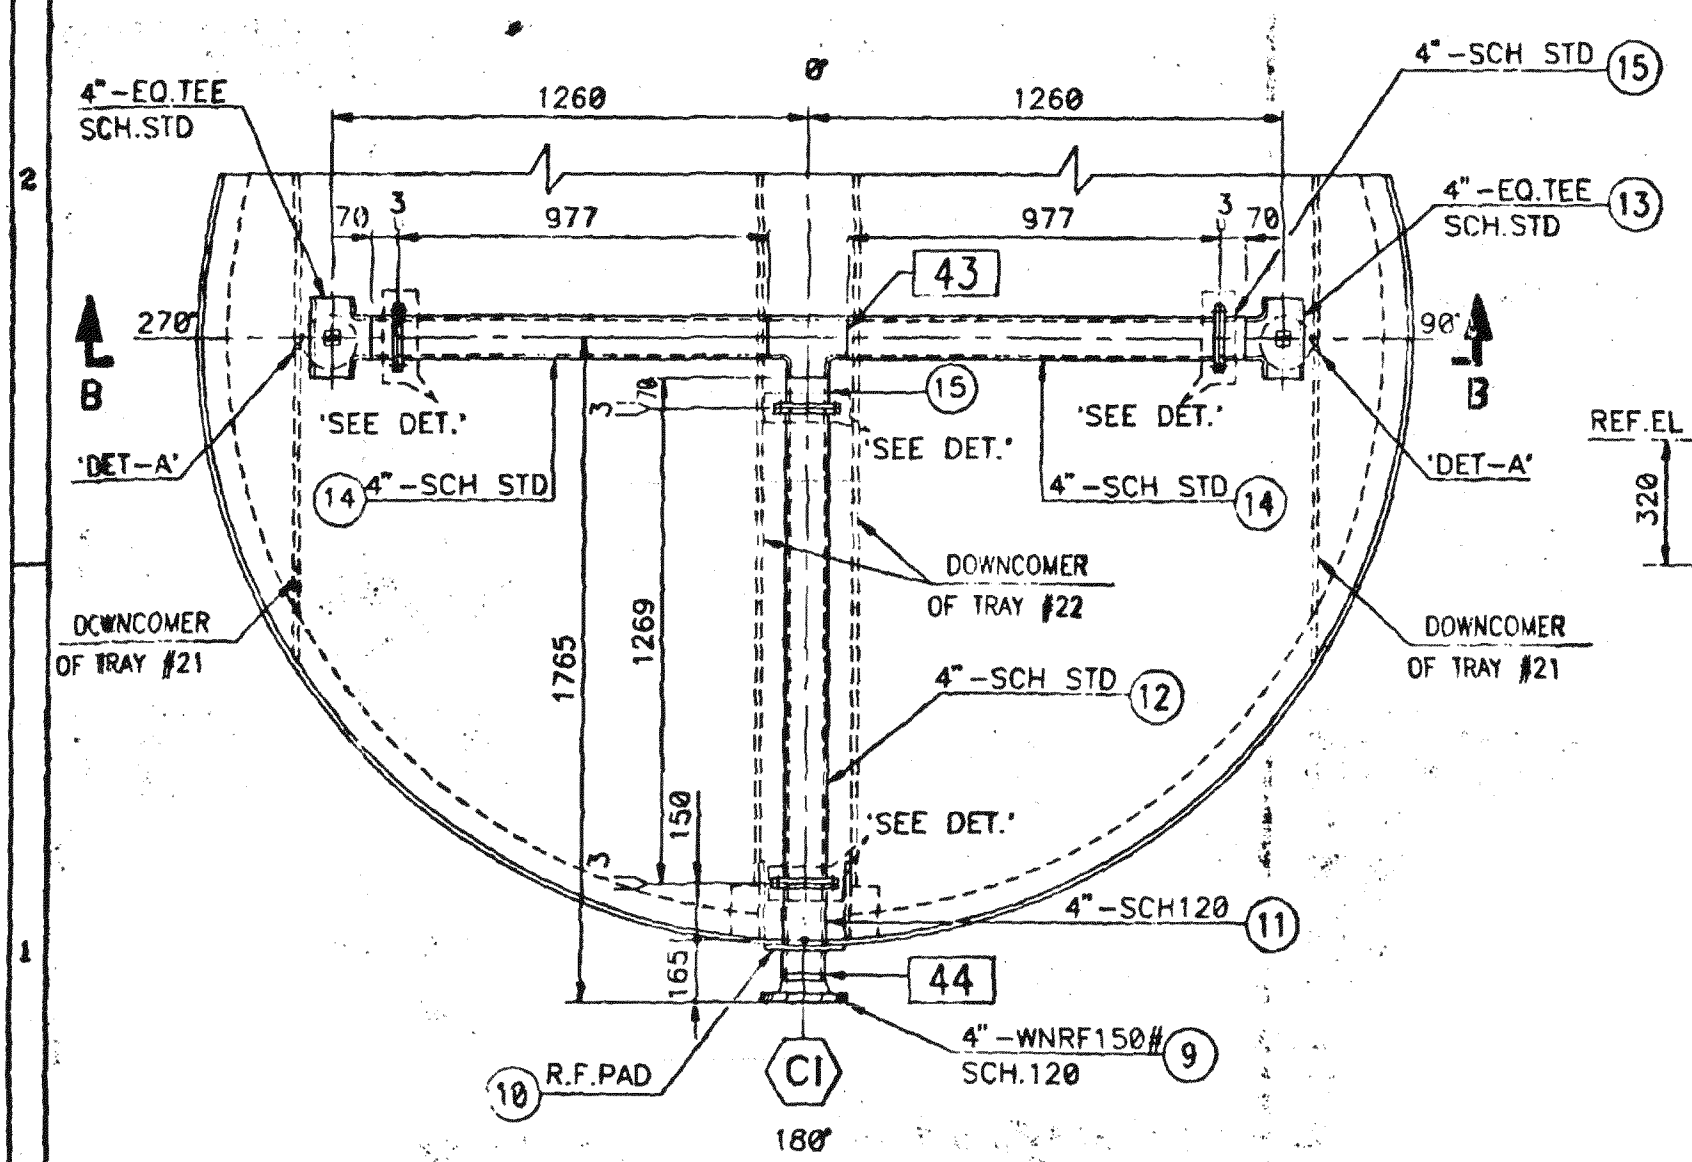


ORIENTATION-NOZZLE

INTERNAL DETAIL - NOZZLE-CI

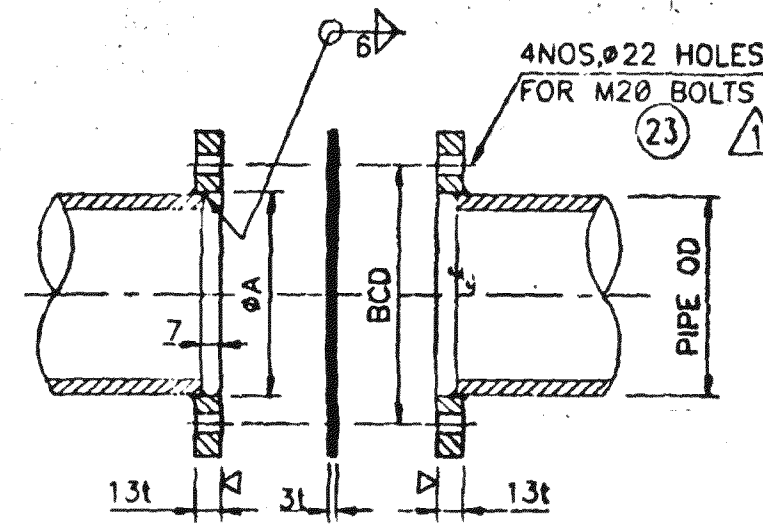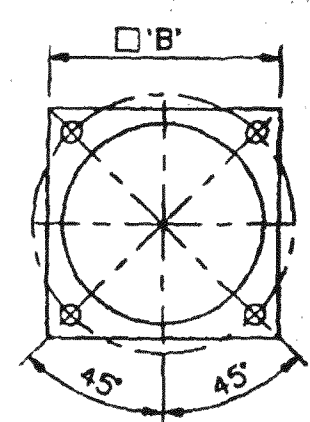


NOZ. MARK	ØA	□'B'	BCD	POS. No.
AI	170	215	233	(19) (20)
CI	116	177	179	(21) (22)

DETAIL - PLATE FLANGE

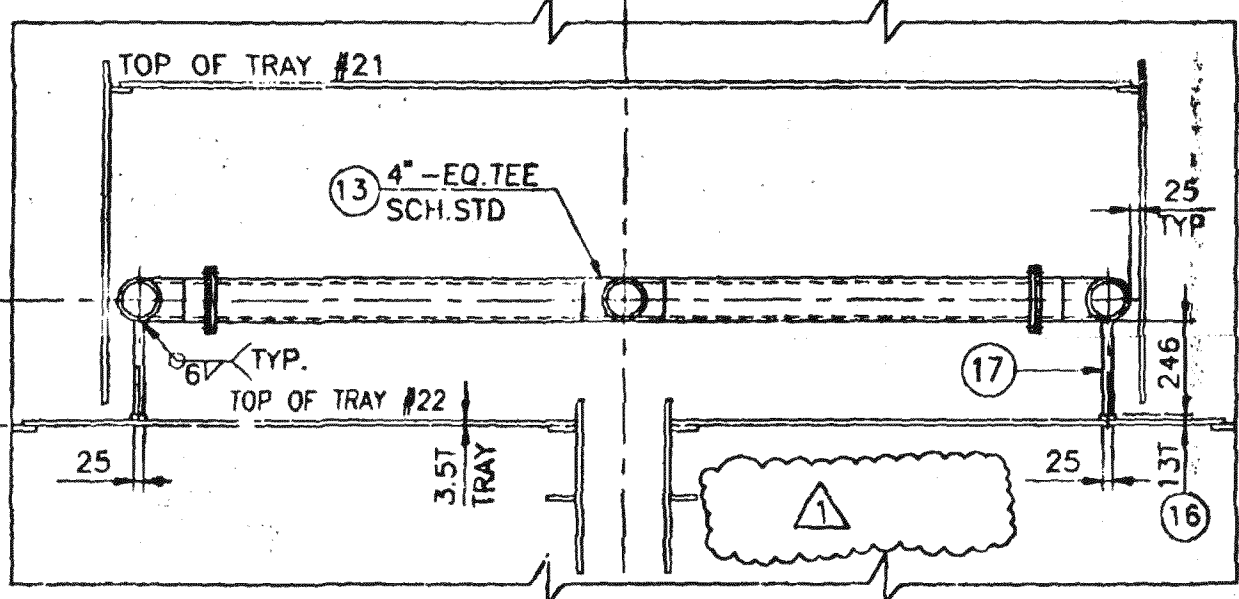

SECTION-B-B

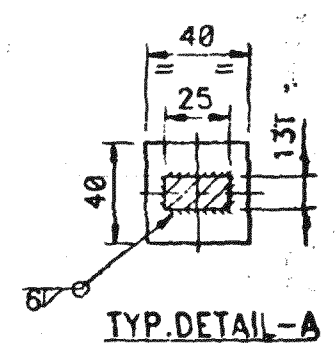

TYP. DETAIL-A

TOTAL WT. = 197.6 Kgs.

ITEM NO.	QTY FOR ONE FAM.	DESCRIPTION	LENGTH	WIDTH	THICK	WT. IN Kg. For ONE POS.	For ONE FAM.	MAT'L	MAT'L CODE	RDA. NO.
23	20	B+INT M20	160	0	0.0	0.1	2.0	SA193B7/SA1942H	00502020000	STOCK
22	4	GK (SEE DWG)-CI	0	0	3.0	0.0	0.0	GRAFOIL		
21	8	PLATE FLG.-CI	177	177	16.0	2.0	16.0	SA516G70	7033A01116	703300-001
20	1	GK (SEE DWG)-AI	0	0	3.0	0.0	0.0	GRAFOIL		
19	2	PLATE FLG.-AI	215	215	16.0	2.3	4.6	SA516G70	7033A01116	703300-001
18	1	SUPPORT BAR	240	25	13.0	0.6	0.6	SA516G70	7033A01106	703300-001
17	2	SUPPORT BAR	246	25	13.0	0.6	1.2	SA516G70	7033A01106	703300-001
16	3	WEAR PLATE	40	40	13.0	0.2	0.6	SA516G70	7033A01106	703300-001
15	3	PI 4\" STD-CI	63	0	0.0	1.0	3.0	SA106G70	6355A06703	STOCK
14	2	PI 4\" STD-CI	970	0	0.0	16.0	32.0	SA106G70	6355A06703	STOCK
13	3	4\" EQ.TEE STD-CI	0	0	0.0	5.0	18.0	SA234WPB	7033A09C08	703300-009
12	1	PI 4\" STD-CI	1255	0	0.0	20.2	20.2	SA106G70	6355A06703	STOCK
11	1	PI 4\" 120-CI	232	0	0.0	2.2	2.2	SA106G70	7033A06703	703300-006
10	1	RP 210/124/14T	0	0	0.0	2.5	2.5	SA516G70N	7033A01112	703300-001
9	1	F-4\" WNRF150/120-CI	0	0	0.0	10.0	10.0	SA195	7033A04F87	703300-004
8	1	6\" EQ.TEE STD-AI	0	0	0.0	15.0	15.0	SA234WPB	7033A09C09	703300-009
7	1	E 6\" 90\"LR STD-AI	0	0	0.0	11.0	11.0	SA234WPB	7033A09C06	703300-009
6	1	PI 6\" STD-AI	48	0	0.0	2.0	2.0	SA106G70		
5	1	E 6\" 45\"LR STD-AI	0	0	0.0	5.5	5.5	SA234WPB		
4	1	PI 6\" STD-AI	820	0	0.0	23.2	23.2	SA106G70		
3	1	PI 6\" 80-AI	269	0	0.0	11.4	11.4	SA106G70	7033A06705	703300-006
2	1	RP 300/178/14T	0	0	0.0	5.0	5.0	SA516G70N	7033A01112	703300-001
01-04	1	F-6\" WNRF150/180-AI	0	0	0.0	10.0	10.0	SA105	7033A04F08	703300-004

LIST OF MATERIAL

AS BUILT

CHIYODA PETROSTAR LTD.
 JOB NO. 54001 IBN RUSHD AROMATICS PROJECT
 PO NO. SAY-POP0002
 REQ NO. MR-50-C-003
 IDENT NO. 53C03-DW-0004
 DATE 11/11/97
 PURCHASER'S PERMISSION TO PROCEED OR REVIEW TAKEN ON VENDOR PRINTS SHALL NOT RELIEVE VENDOR FROM ITS RESPONSIBILITIES OR LIABILITIES UNDER PURCHASE ORDER.

REV.	DATE	DESCRIPTION	DRAWN	CHK'D	APP'L
1	7.3.97	REVISED AS PER CLIENTS COMMENTS & ISSUED FOR CONSTRUCTION	Rama rao	YOGESH MAIDER	AKB
0	11.2.97	ISSUED FOR APPROVAL.	Rama rao	YOGESH MAIDER	AKB

SCALE: 1 : 30

CLIENT: CHIYODA/IBN RUSHD.

ORDER: SAY-POP0002

APPROVED FOR CONSTRUCTION BY: AKB


DATE: 11/11/97

DETAIL OF INTERNALS

DRAWING NO. DA-7033-01-004

REV 1

811012

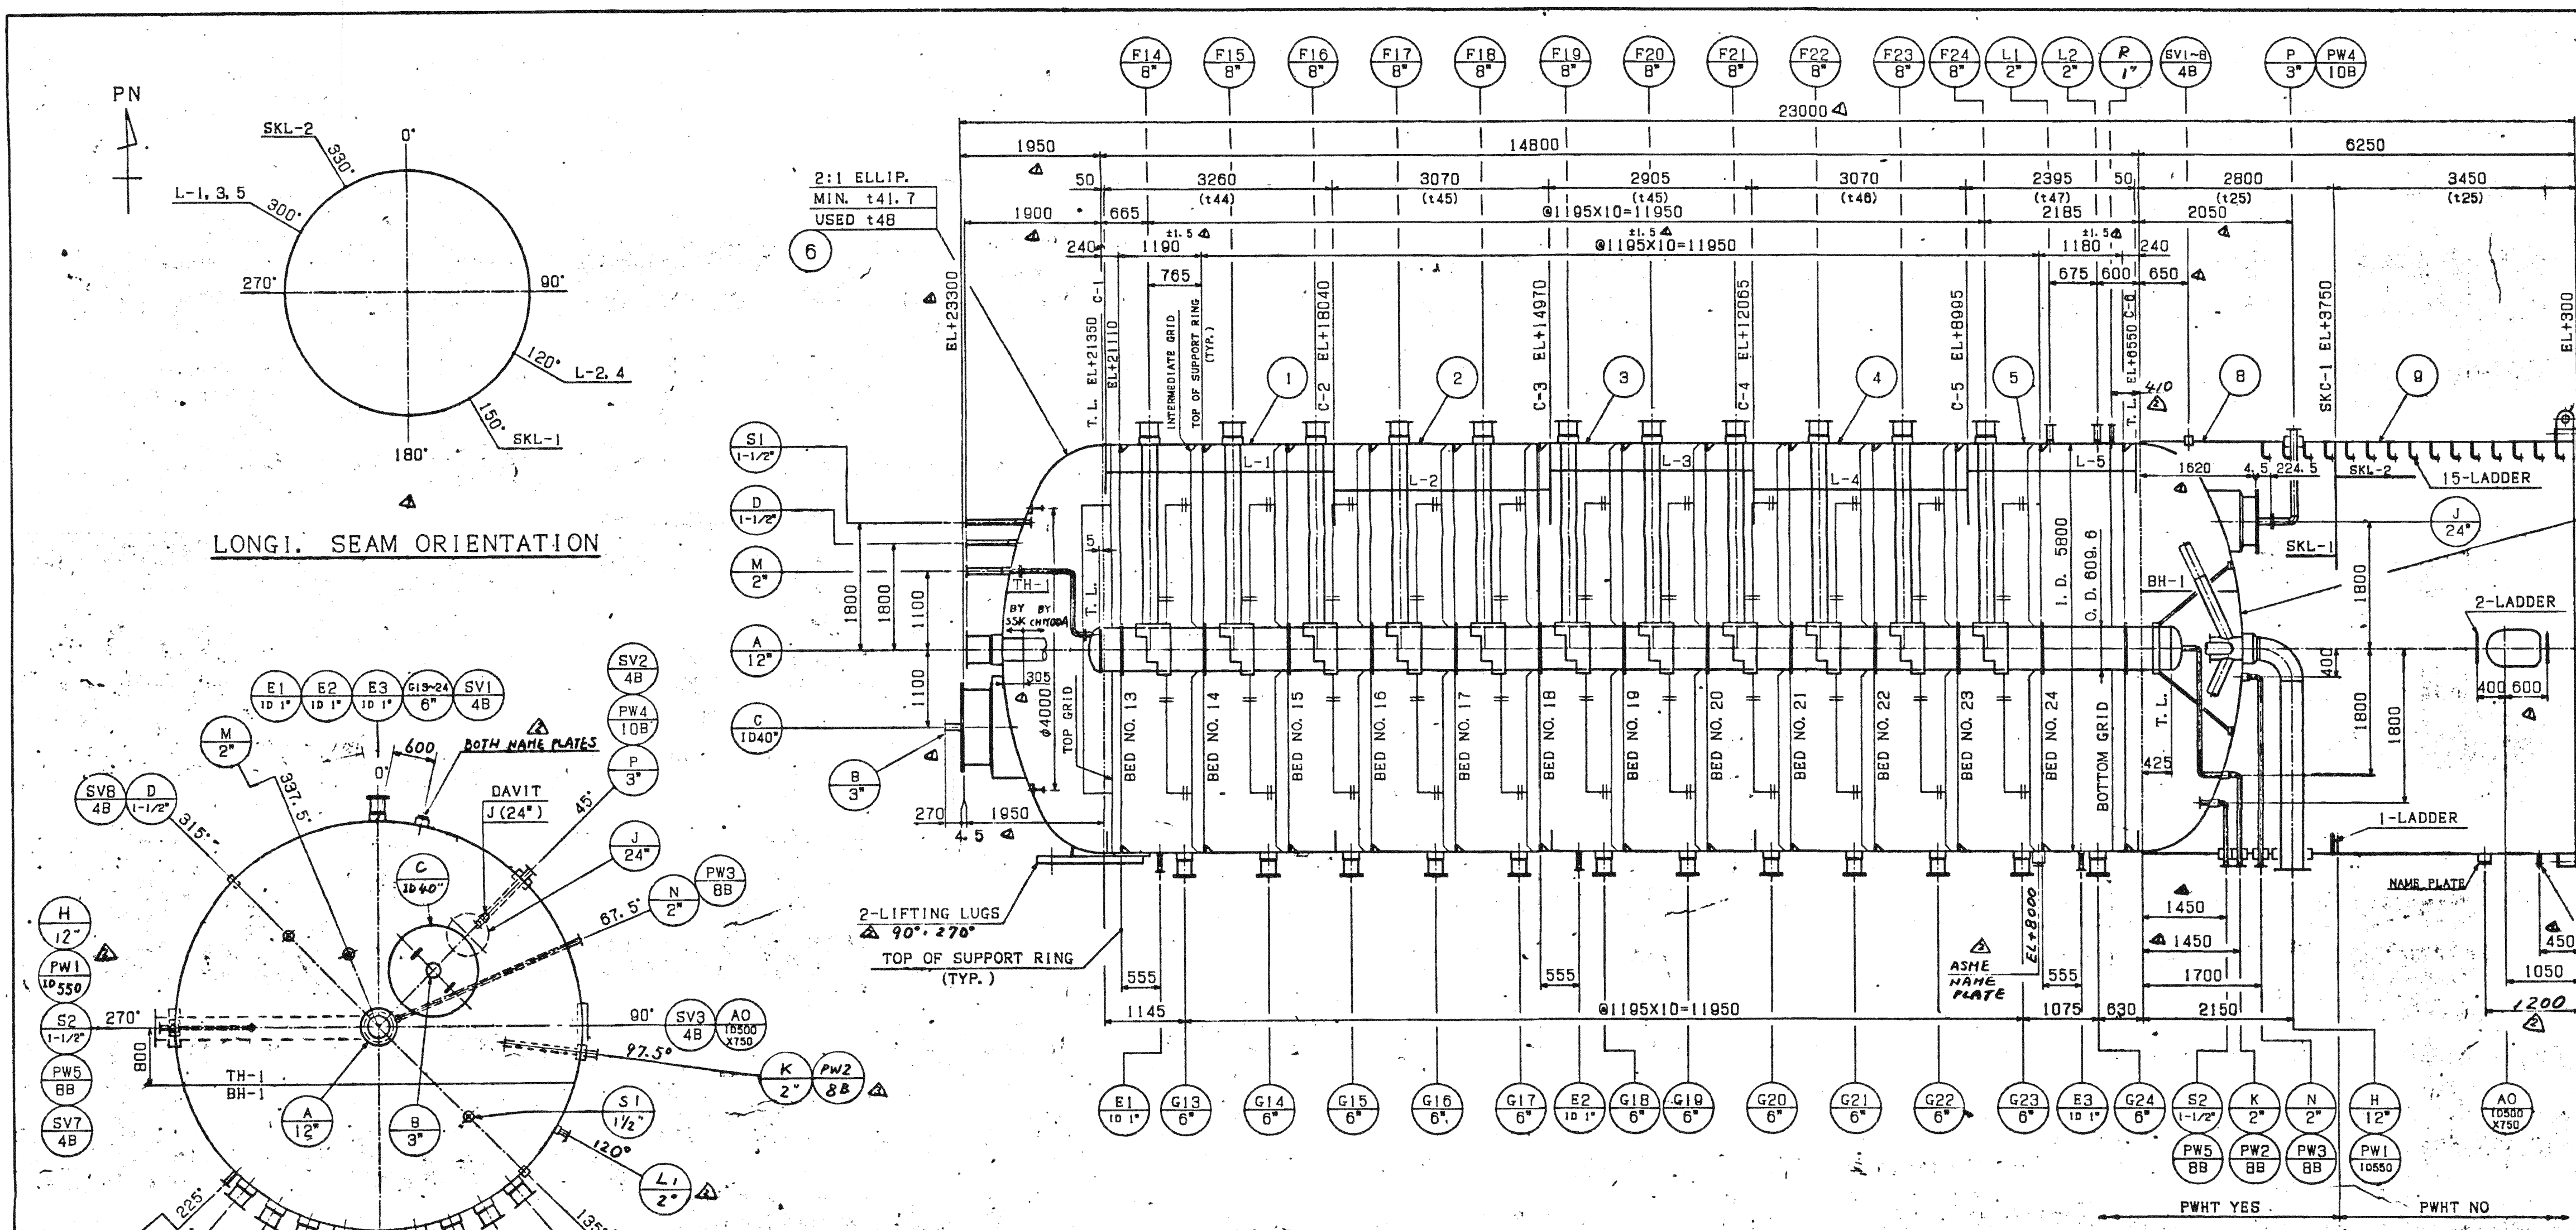

3RD ANGLE PROJ

REFERENCE

REV NO.	DATE	BY	DESCRIPTION	D.S.M. APP'D	Q.A.E. REV'D
A	AUG. 21.96	T.Y.	PURCHASER'S REQUEST FOR CONSTRUCTION	S.O. <i>Aug 22/96</i>	<i>7/24</i>
B	MAY. 96	T.Y.	REVISED 1/2" NPT. NOZZLE FITTING POSITION & E.T.C.	<i>20</i>	<i>Oct 21/96</i>
C	MAY. 96	T.Y.	REVISED 1/2" NPT. NOZZLE ORIENTATION	<i>20</i>	<i>Nov 1/96</i>
D	DEC. 18.96	T.Y.	REVISED WELDING PROCESS OF S.C.-1	<i>20</i>	<i>Dec 18/96</i>
E	FEB. 5.97	H.Y.	AS BUILT	S.O. <i>Feb 7/97</i>	<i>9/24</i>

2-TAILING LUGS

0° Δ

2:1 ELLIP.

MIN. $\angle 45.8$

USED +53

7

I.D. 5950

B.C.D. 9090

設計条件 DESIGN DATA

製作数量	No. REQUIRED	1	
法規・規格	REGULATION & CODE	ASME SECT VIII DIV. 1-1995 (1995 EDITION)	
ASME CODE STAMP		YES	
FLUID NAME		HYDROCARBON	
SPECIFIC GRAVITY		0.850	
NORMAL LIQUID LEVEL		LIQUID FULL	
(M. A. W. P.) DESIGN PRESS.	bar-G	14.8 (214.7PSI)/F.V.	
設計温度	DESIGN TEMP.	°C	204 (399°F)/177 (351°F)
MIN. DESIGN METAL TEMPERATURE		°C	2 (35.6°F)
運転圧力	OPER. PRESS.	bar-G	-
運転温度	OPER. TEMP.	°C	177 (351°F)
水圧試験圧力	HYDRO. TEST PRESS.	bar-G	23.4 Δ
水圧試験温度	HYDRO. TEST TEMP.	°C	MIN. 5 (41°F)
真空試験圧力	VACUUM TEST PRESS.	bar-G	-
応力除去	POST WELD HEAT TREATMENT	YES (PER DRAWING)	
放射線検査	RADIOGRAPH	FULL	
耐食代	CORR. ALLOWANCE	mm	3.0 (SKIRT 1.6)
溶接率	JOINT EFFICIENCY	1.0	
耐火試験	FIRE PROOF	mm	75 (BOTH SIDE)
保温	INSULATION	mm	50 (HOT)
容積	VOLUME	m ³	442.1 (15613FT ³)
吊上重量	LIFTING WEIGHT	Kg	188400
TEST WEIGHT		Kg	924500
運転重量	OPERATING WEIGHT	Kg	894000
CHARPY IMPACT TEST		NO [UCS-66 (a)]	
塗装	PAINTING	SYSTEM S2-5 PER CHIYODA SPEC. Δ SP-50-X-001	
正常化	N.T.	HEADS (AFTER NOT FORMING)	

NOTES

NOZZLE ORIENTATION (HEAD SEAM ORIENTATION)									
AO	ACCESS OPENING	10550	1	10					
SV1-SV8	SKIRT VENT	4B	8	14.5					
PW5	PIPEWAY	8B	1	SCH40					
PW4	PIPEWAY	10B	1	SCH40					
PW3	PIPEWAY	8B	1	SCH40					
PW2	PIPEWAY	8B	1	SCH40					
PW1	PIPEWAY	10550	1	10					
S2	FLUSH OUT	1-1/2"	1	17.1	ANSI 300 RFLWN	3130			
S1	FLUSH OUT	1-1/2"	1	17.1	ANSI 300 RFLWN	SEE DWG			
R	SEAL ANGLE VENT	1"	1	14.2	ANSI 300 RFLWN	3100			
P	DRAIN/FLUSH IN	3"	1	11.1	ANSI 300 RFLWN	3130			
N	BOTTOM HEAD DRAIN	2"	1	18.7	ANSI 300 RFLWN	3130			
M	VENT (CENTER PIPE)	2"	1	18.7	ANSI 300 RFLWN	SEE DWG			
L1-L2	ADSORBENT SAMPLE	2"	2	116.6	ANSI 300 RFLWN	3100			
K	DRAIN/VENT (CENTER PIPE)	2"	1	18.7	ANSI 300 RFLWN	3130			
J	MANWAY	24"	1	146	ANSI 300 RFLWN	SEE DWG	BLIND FL'G	DAVIT	
H	OUTLET	12"	1	17.5	ANSI 300 RFLWN	3180			
G1-G24	DUMP	6"	12	126.0	ANSI 300 RFLWN	3150	BLIND FL'G		
F1-F24	DISTRIBUTOR	8"	11	128.85	ANSI 300 RFLWN	3150			
E1-E3	T1 AND TR	1D 1"	3	14.2	ANSI 300 RFLWN	3100			
D	FLUSH IN	1-1/2"	1	17.1	ANSI 300 RFLWN	SEE DWG	BLIND FL'G		
C	MANWAY	1D 40"	1	125.4	ASME 300 RFLWN	SEE DWG	BLIND FL'G		
B	VENT	3"	1	120.5	ANSI 300 RFLWN	SEE DWG			
A	INLET	12"	1	142.0	ANSI 300 RFLWN	SEE DWG			
符号	名称	仕様	数量	寸法	規格	重量	備考		
MARKS	NAME	SIZE	QTY	INCH	F. RATING	PROJECTION (TO SKIRT CL)	REMARKS		

TYPE 1	TYPE 2	TYPE 3	TYPE 4	TYPE 5	TYPE 6
C-1, 2	C-3	C-4, 5	C-6	SKC-1	TH-1
INSIDE : SAW	INSIDE : SAW	INSIDE : SAW	INSIDE : SAW	INSIDE : SAW	INSIDE : SAW
OUTSIDE : SAW	OUTSIDE : SAW	OUTSIDE : SAW	OUTSIDE : SAW	OUTSIDE : SAW	OUTSIDE : SAW
70° ±5'	70° ±5'	70° ±5'	70° ±5'	70° ±5'	50°
MAX. 2	MAX. 2	MAX. 2	MAX. 2	MAX. 2	MAX. 3
60° ±5'	60° ±5'	60° ±5'	60° ±5'	60° ±5'	45°

ASME STAMP YES

DIV. 1 1995 BY ASME SECT VIII 1995 EDITION REVIEWED BY Q. A. ENGINEER DATE Jun. 20.96

CHUYODA CORPORATION

JOB NO. 51046 IBN RUSHD AROMATICS PROJECT

PO NO. SAYPOA0021

REQ NO. MR-50-D-007



IDENT NO. 53-D-02-DW 0001

DATE


PURCHASER'S PERMISSION TO PROCEED OR REVIEW TAKEN ON VENDOR PRINTS SHALL NOT RELIEVE VENDOR FROM ITS RESPONSIBILITIES OR LIABILITIES UNDER PURCHASE ORDER

		TOTAL		150845 kg					
1	ACCESS OPENING	18	SS400	41.10	0				
8	SKIRT VENT	17	SGP	2.5	20 48X4.5				
1	PIPEWAY	16	STPG370	19	108XSCH40				
3	PIPEWAY	15	STPG370	2.8	26 88XSCH40				
1	PIPEWAY	14	SS400	28	1D550Xt9				
48	GUSSET PLATE	13	SS400	2.4	115 t12				
24	PLATE WASHER	12	SS400	2.8	67 t32				
1	COMP. RING	11	SS400	588	t25				
1	BASE PLATE	10	SA36	2024	t55				
1	SKIRT	9	SA36	12310	t25				
1	SKIRT	8	SA-516-65	9446	t25				
1	HEAD	7		15831	t53				
1	HEAD	6		14919	t48				
1	SHELL	5		16232	t47				
1	SHELL	4		20960	t46				
1	SHELL	3		18844	t45				
1	SHELL	2		19014	t45				
1	SHELL	1	SA-516-05	20679	t44				
NO. REQUIRED	PARTICULARS		MARKS	MATERIAL	TEST MAKE	1-OPP	TOTAL	REMARKS	
						CALL WT(kg)			
NO. REQUIRED	SAGRO HEAVY INDUSTRIES Co., LTD			CHIYODA CORPORATION					
	MACHINERY DESIGN DEPT.								
	APPROVED BY JUN. 19, '96 <i>[Signature]</i>			CHECKED BY JUN. 19, 1996 <i>[Signature]</i>			IBN RUSHD PTA& AROMATICS PROJECT-AROMATICS		
	CERTIFICATED BY JUN. 19, 1996 <i>[Signature]</i>			DRAWN BY <i>[Signature]</i>			ADSORBENT CHAMBER NO. 2 53-D-02		
REQUIRED	DATE DRAWN JUN. 19, 1996		DATE ISSUED		GENERAL ASSEMBLY DRAWING				
1 SET	FORM No. 43755		CLASE /		SCALE 1/80 1/10		SAC No. B 81481-141-01		REV.
1 SET	SAGRO HEAVY INDUSTRIES Co., LTD								

FONDO ELL. 2:1 SP.30 MIN. DOPO FORM A FREDDO, NORM.
E RINV. IN 2 PEZZI DA LAMIERA SP.33
2:1 ELL. HEAD 30 THK MIN. AFTER COLD FORM. NORM. &
REND IN 2 PIECES FROM PLATE 33 THK

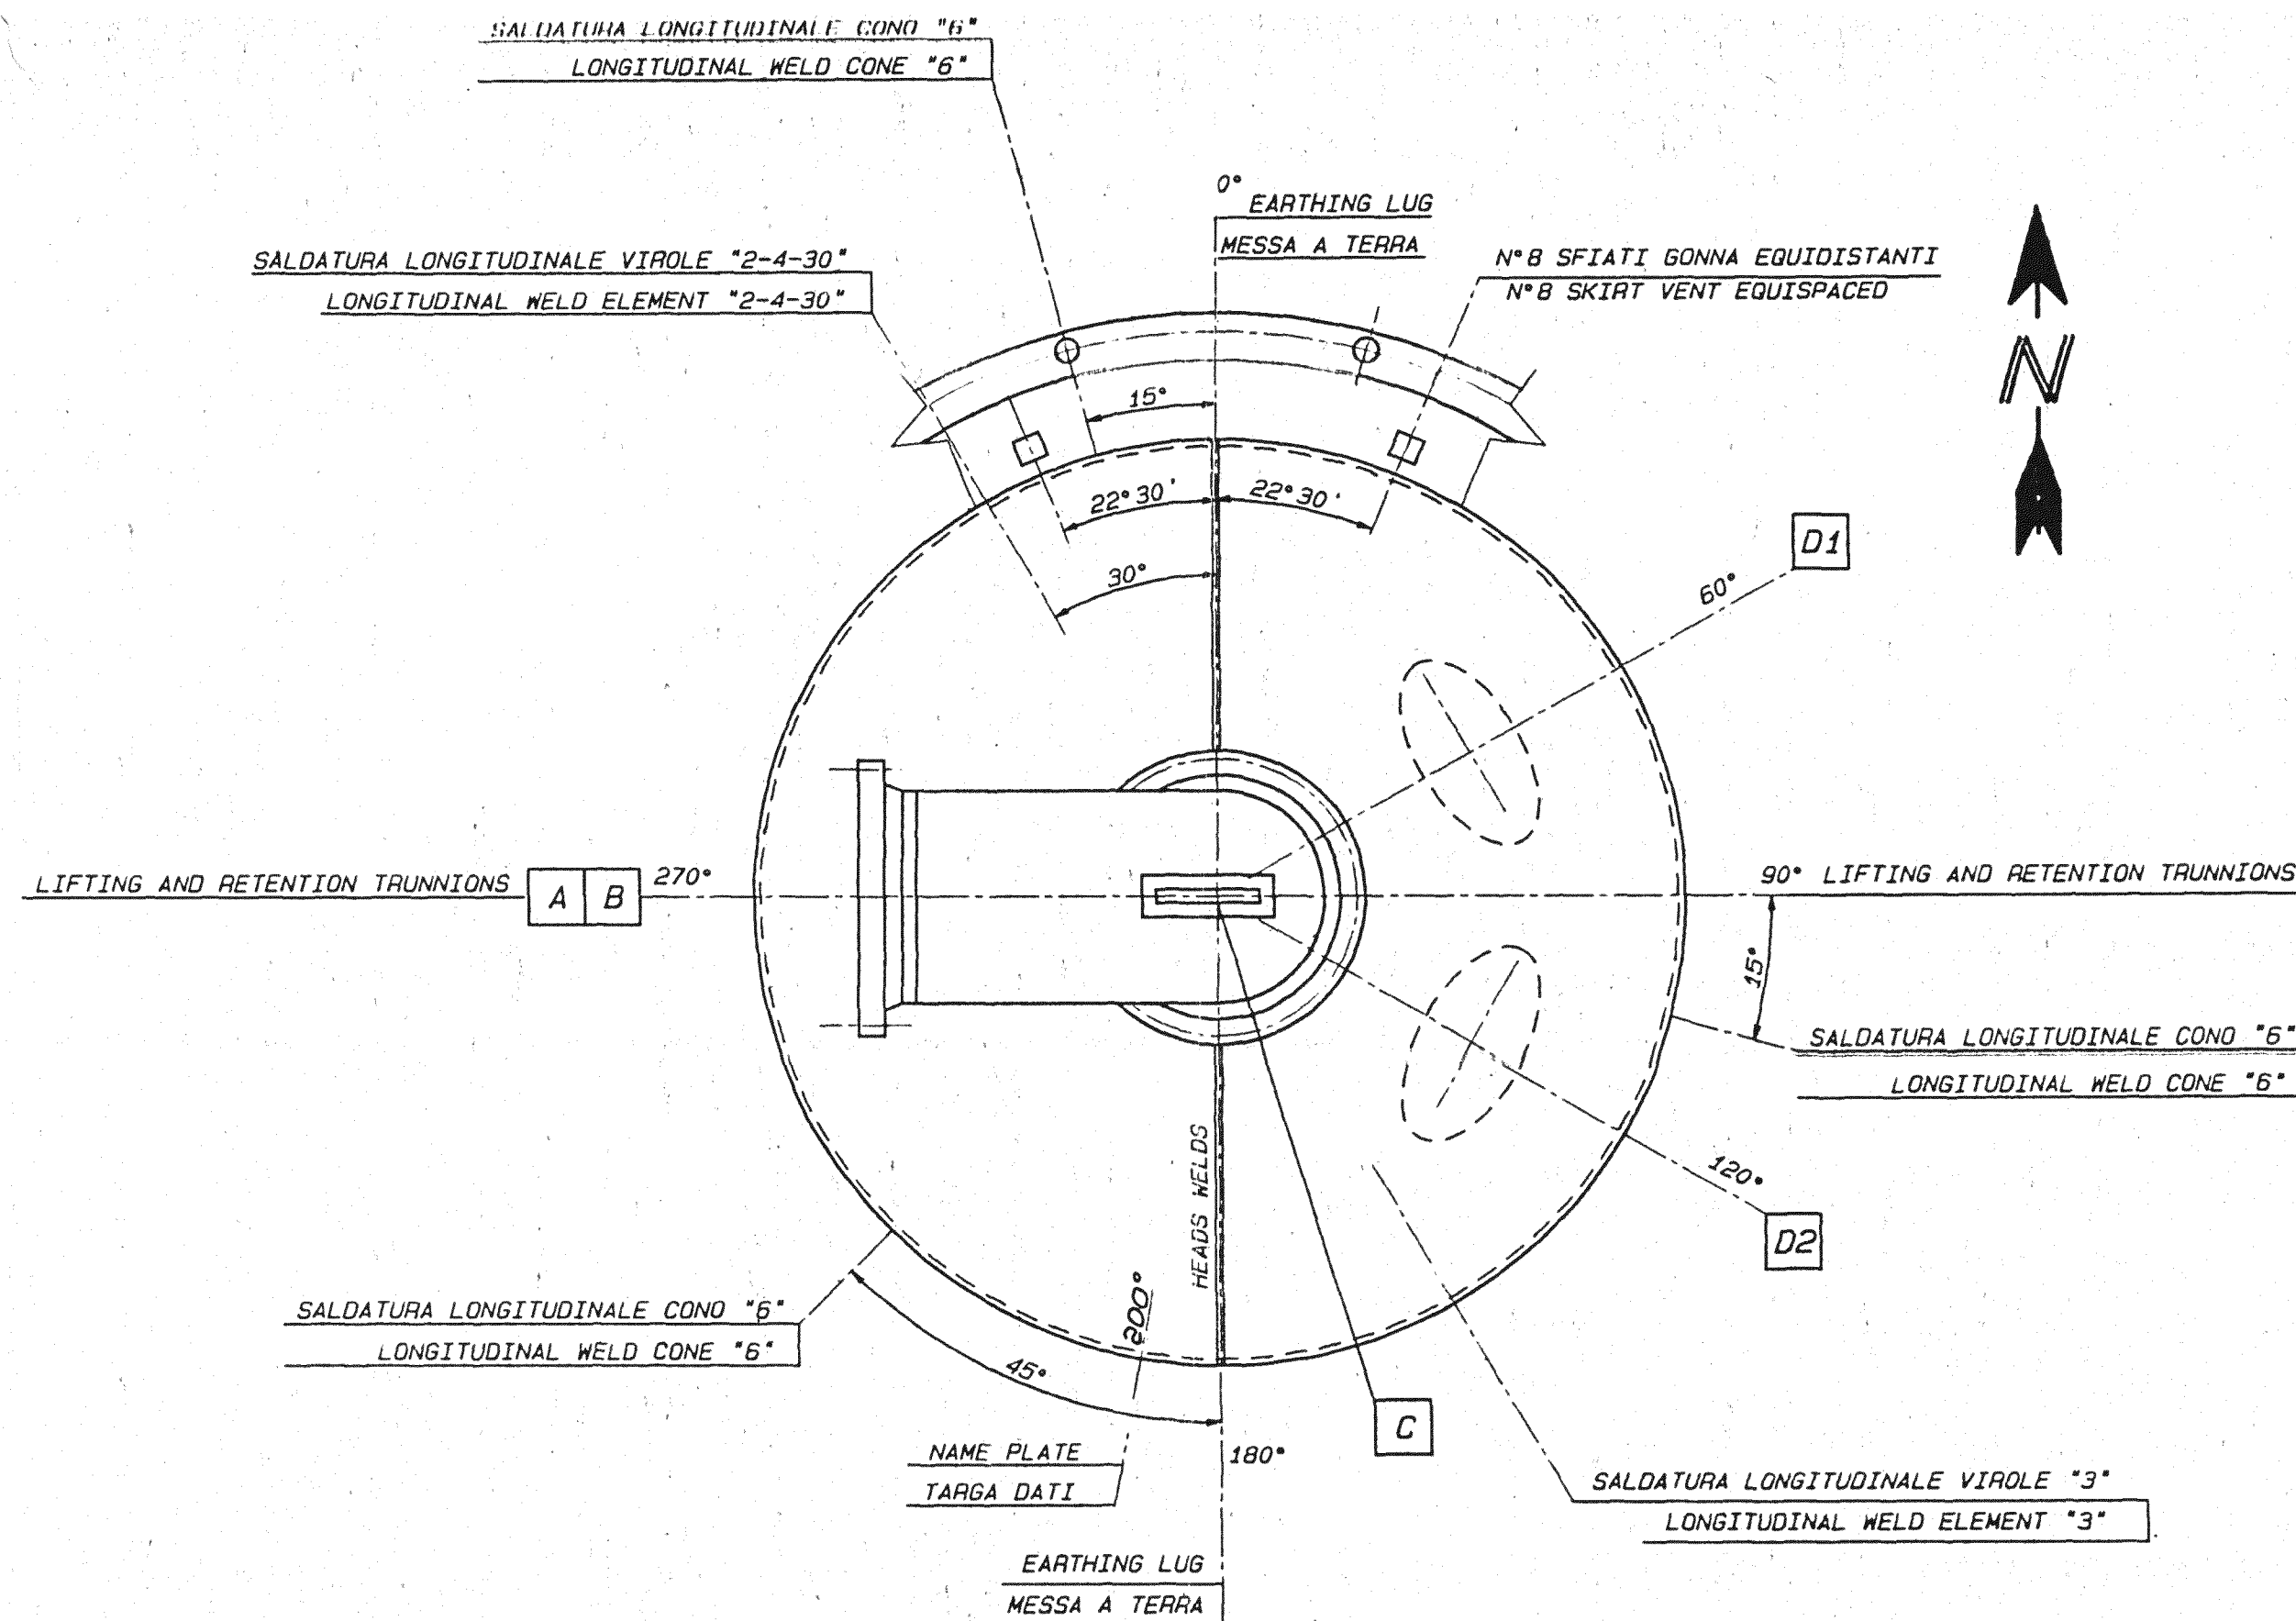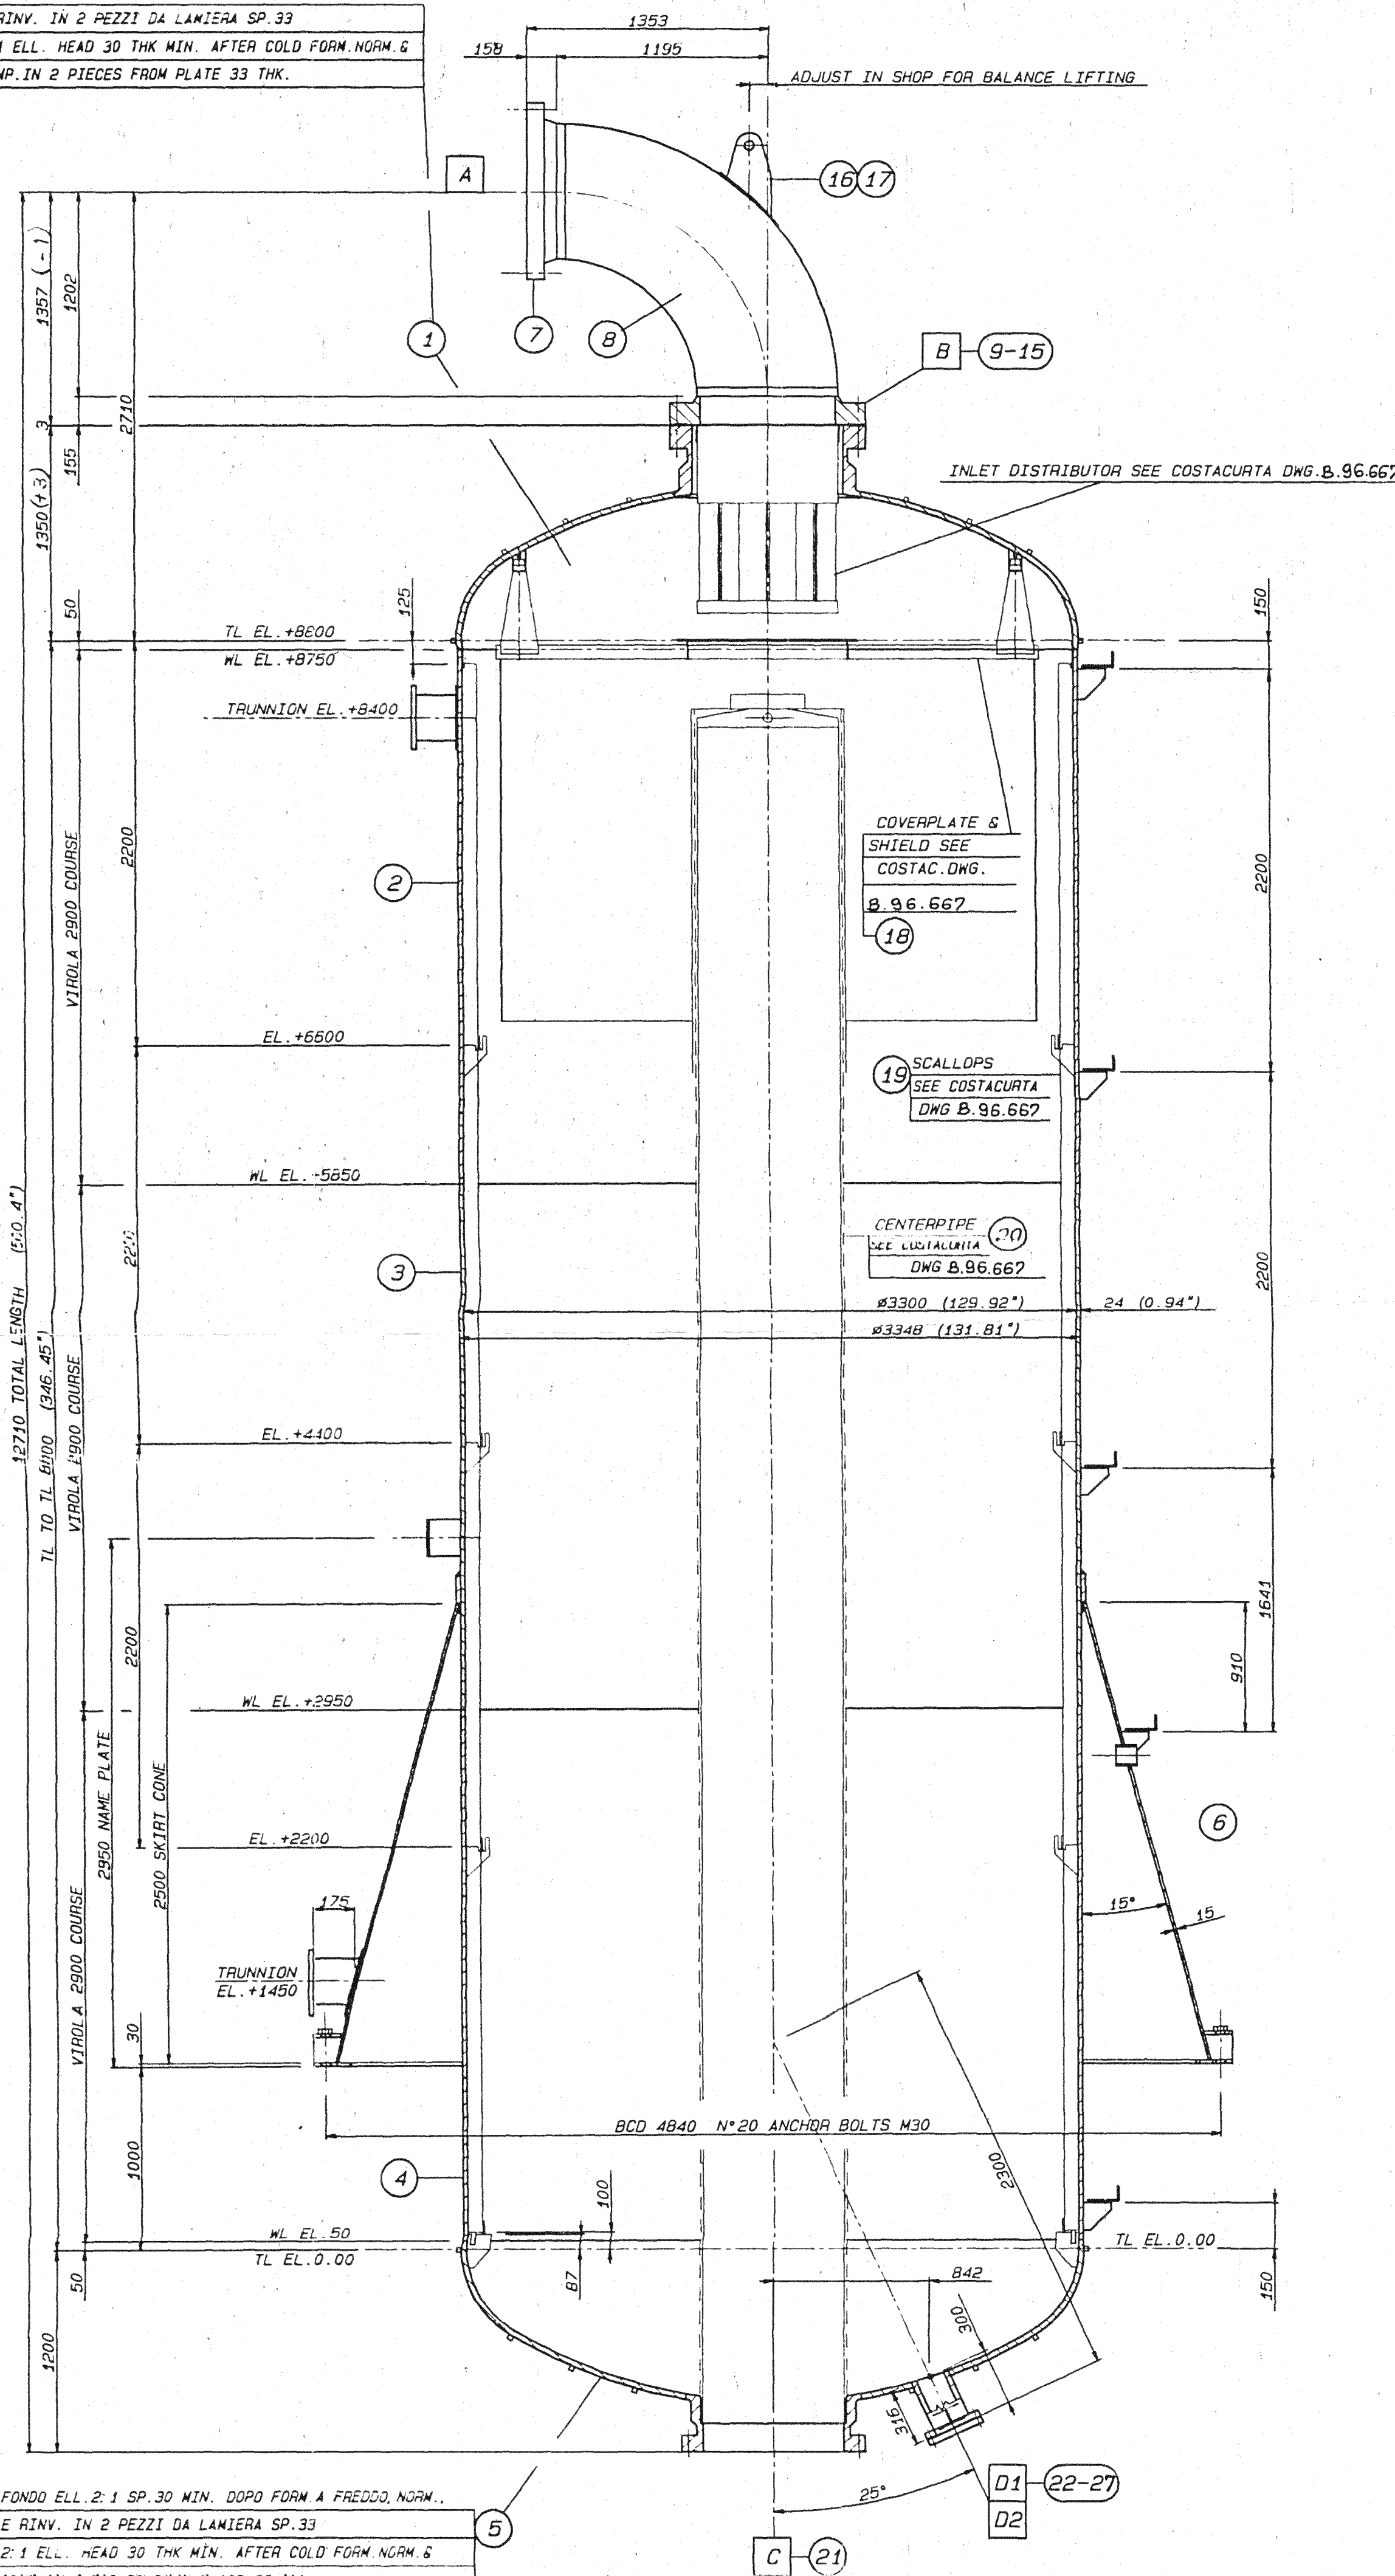

ORIENTATION VIEW FROM TOP / ORIENTAMENTO VISTO DALL'ALTO

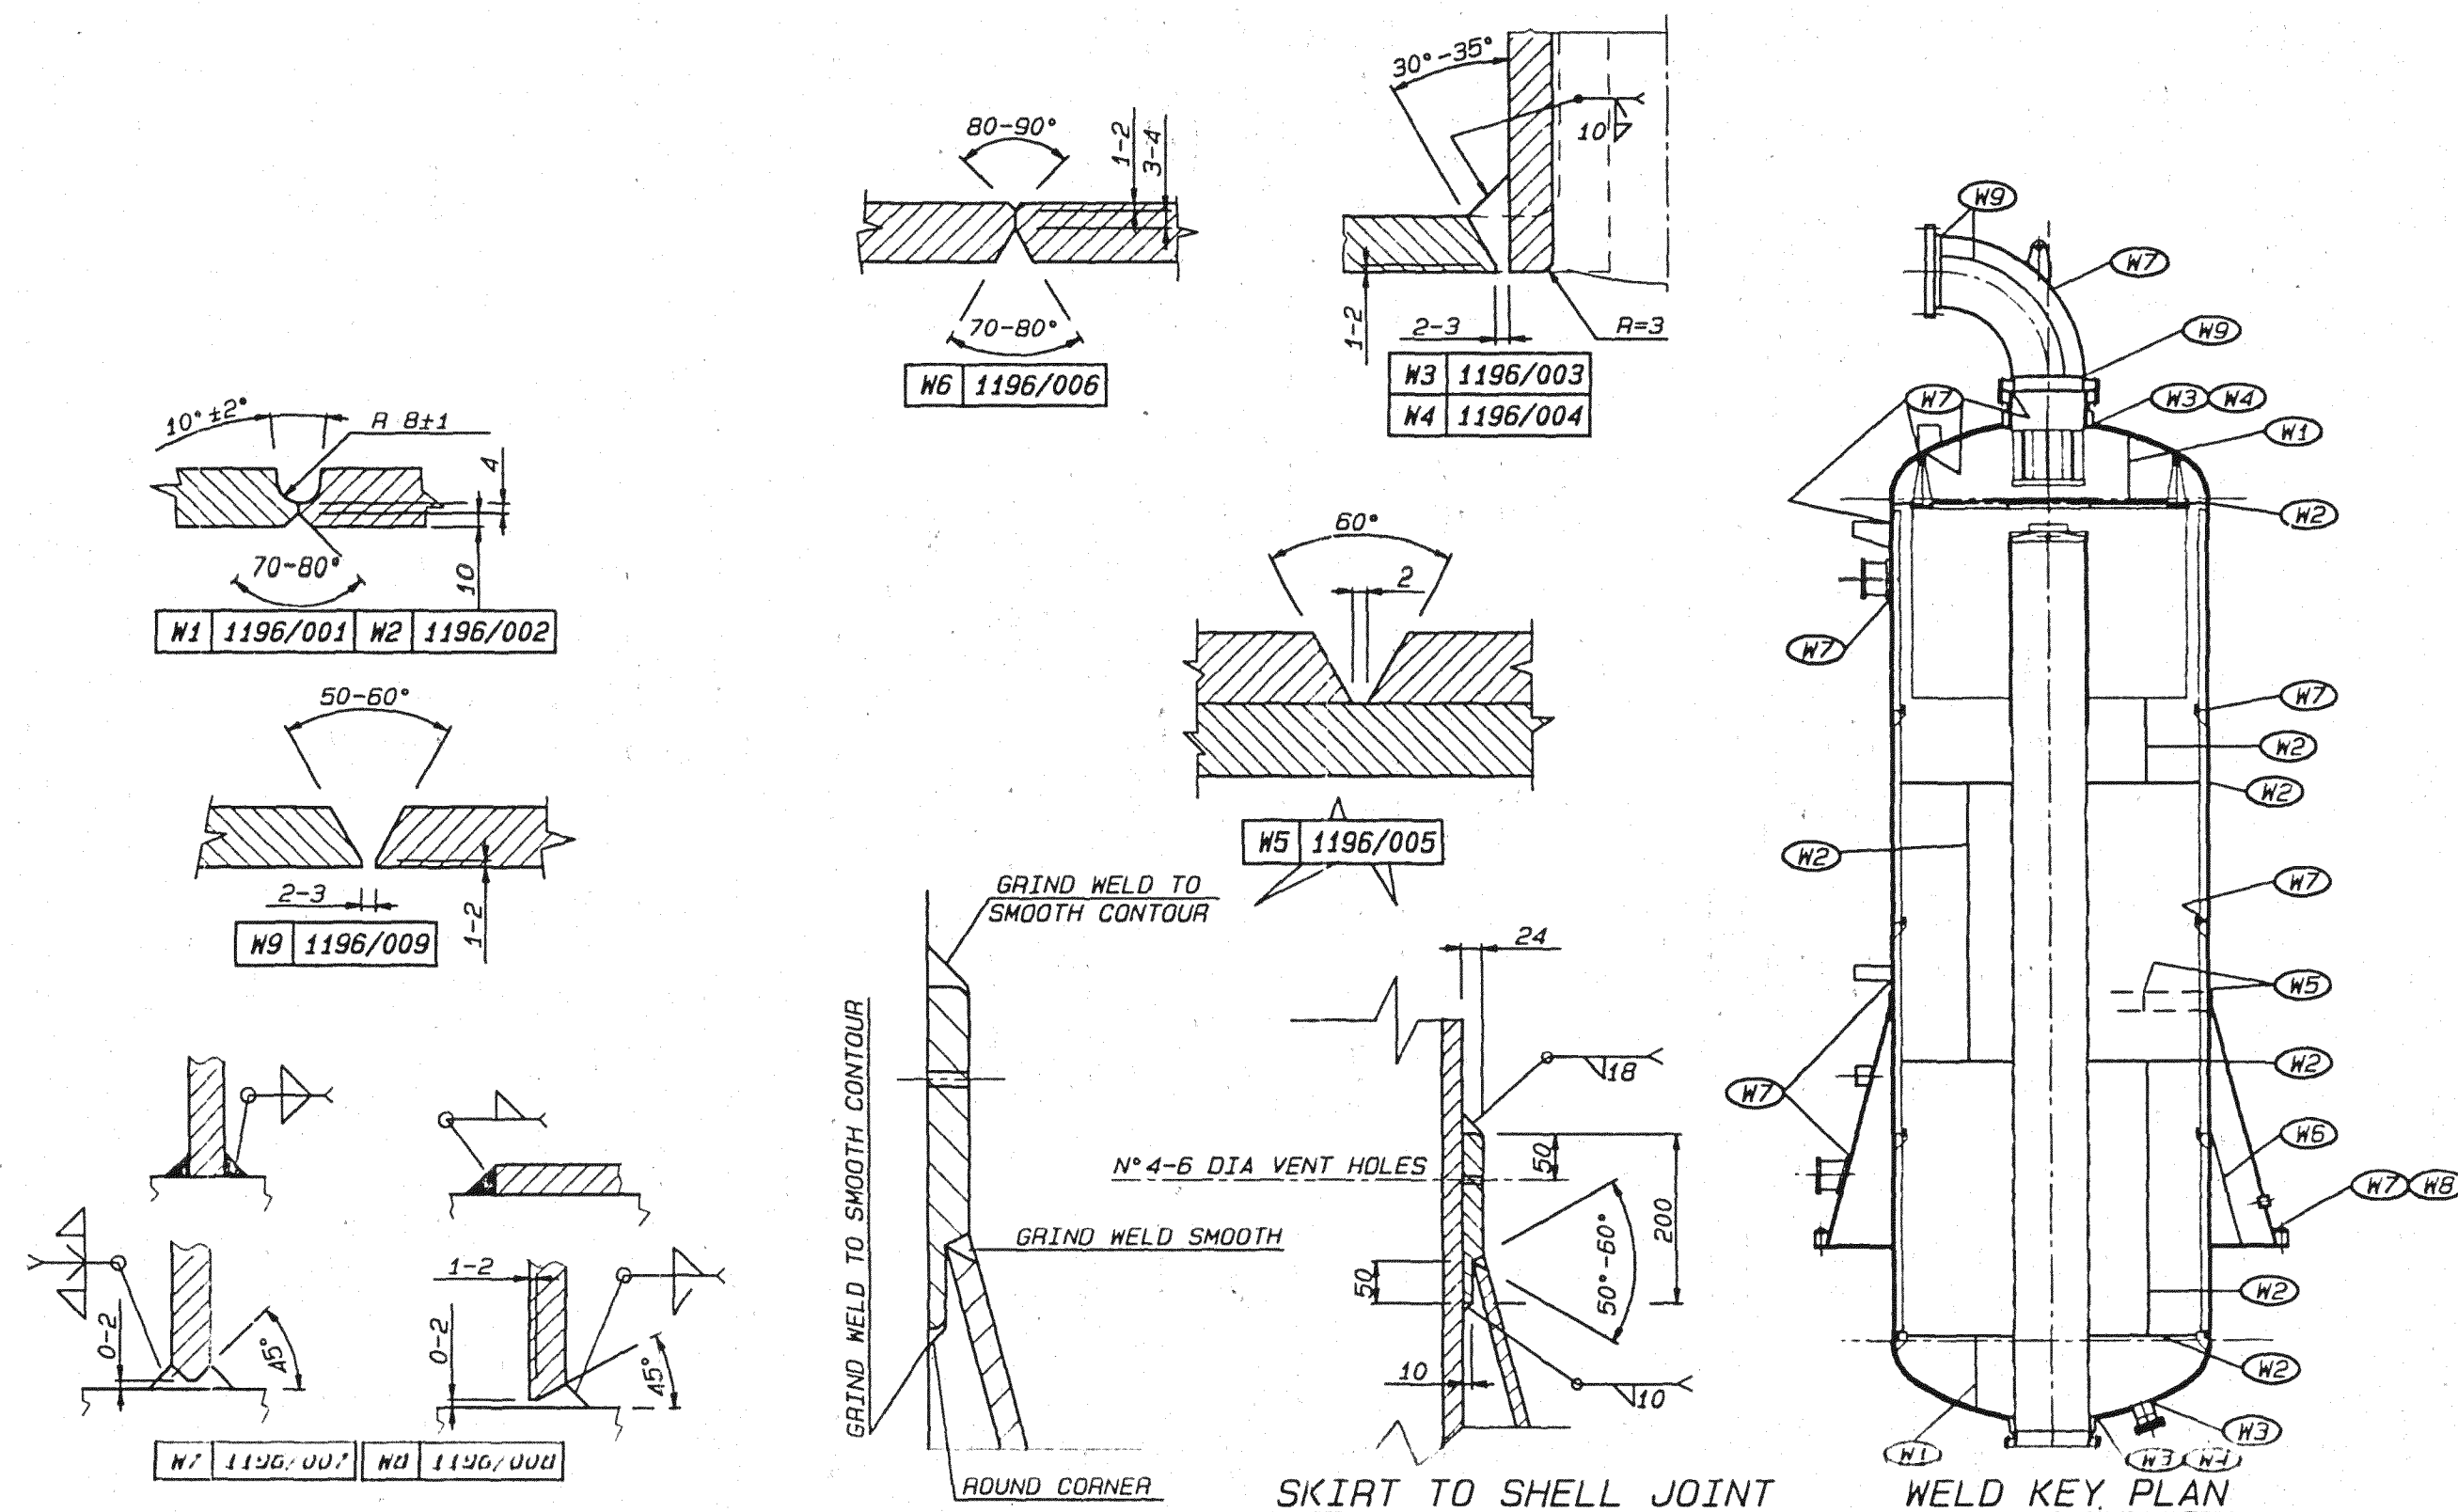

CONSTRUCTION NOTE:											
1) FLANGE CONTACT FACE SHALL BE FINISH WITH 125 - 250 Ra											
2) NOZZLE FLANGE STUD BOLT HOLES STRADDLE TO CENTER LINES											
3) THE INDICATE THK ARE THE MIN. AFTER CONSTR. & OR FORMING AND ALL DIMENSIONS ARE IN MM											
4) INSIDE EDGES OF NOZZLES SHALL BE ROUNDED OFF WITH R = 12.5 mm RADIUS											
5) WELDS ATTACHING NON-PRESSURE-RETAINING COMPONENTS TO PRESSURE-RETAINING COMPONENTS SHALL BE FULL PENETRATION. ALL FILLET WELDS ATTACHED TO PRESSURE-RETAINING COMPONENTS SHALL BE GROUNDED TO A SMOOTH CONCAVE CONTOUR											
Tutte le saldature di parti non a pressione e parti a pressione dovranno essere a piena penetrazione e con filletto raccordato concavo											
6) ALL INTERNALS TO BE FABRICATED TO PASS THRU A Ø12 x 1/8 IN MANWAY											
Tutti gli interni devono passare dal passo d'uomo Ø12 x 1/8											
7) ALL INTERNALS TO BE MOUNTING BEFORE SHIPPING EXCEPT CENTERPIECE											
Tutti gli interni dovranno essere montati prima della spedizione eccetto il centerpiece											
8) ALL INSIDE SHELL WELDS SHALL BE GROUNDED FLUSH IN SCALLOP AREA											
Tutte le saldature del mantello in corrispondenza delle scallops dovranno essere molate e filo											
D	2	5"	LWN RF	300#	27	/	/	/	SEE DWG.	CATALYST WITHDRAWAL	
C	1	30"	SR RF	300#	65	/	SELF REINFORC	/	SEE DWG.	OUTLET	
B	1	32" ID	SR RF	SPECIAL	70.5	/	SELF REINFORC	/	SEE DWG.	MANWAY	
A	1	30"	WNE Ø12 x 1/8	300#	15	PL	/	/	SEE DWG.	INLET	
ITEM	QTY	DN.	TYPE	RATING	THK	SDI	DIAMET	THK	PROJECT	SERVICE	
							REINFORC	PAD	FROM C		
YEAR OF CONSTR.		1997		DESIGN CODE:		ASME VIII div. I Ed. '95					
REACTOR				SPECIFICATION:		UP Standard Specification 3-12-2 & 9-11-1					
						UOP Project Specification 560692-304-0					
CONSTRUCTION DATA					DESIGN DATA						
FULL WATER WEIGHT	120400 kg.		DESIGN PRESS.		Bar. g/Psi.g		14.5 FV/ 210.3 FV				
EMPTY WEIGHT + ATTACHM.	/ kg.		FULL VACUUM at		*C/*F		430 / 806				
EMPTY WEIGHT	36000 kg.		OPER. PRESS.		Bar. A/Psi. A		/				
ATTACHM. WEIGHT	/ kg.		HYDROST. PRESS. SHOP		Bar. g/Psi.g		28 / 407				
OPER. WEIGHT	/ kg.		HYDROST. PRESS. FIELD		Bar. g/Psi.g		23.6 / 342				
EXT. SURFACE	180 m ²		M.A.N.P.		Bar. g/Psi.g		15.1 / 219.1				
INTERNAL PROTECT.	SILICA-GEL		DESIGN TEMPERAT		*C/*F		460 / 860				
			OPERAT. TEMPERAT		*C/*F		430 / 806				
SAND, BLAST. & PAINTINGS	SEE RESTA SPEC. 1196/PAINT		MIN. DESIGN METAL TEMP.		*C/*F		9 / 48.2				
			ALL DESIGN PRESSURE		Bar. g AT °C Psi. g AT °F		4.5 AT 238 65.2 AT 1000				
			REGENERAT. CONDITION								
			STEAM-OUT				/				
			RADIOGRAPHY				FULL				
			STRESS RELIEVING				YES				
REFERENCE DRAWINGS			WELDING EFFICIENCY							100%	
DETAILS DWG	4646/A		PRODUCT TEST COUPON				SEE NKF 4646/WP				
PART LIST DWG	4646/B		CORROSION ALLOWANCE		mm		3				
NONE PLATE DWG	4646/C		SPECIAL SERVICE				/				
LOADING DATA	4646/D		FLUID				/				
TRANSPORTATION DWG	4646/E		CAPACITY		m ³		84.4				
PRESS. CALCULATIONS	4646/F		GRAVITY OF PROCESS FLUID								
NOZZLES LOAD CALCUL.	4646/G		HYDROST. WATER TEMP.		*C/*F		16 / 61				
SUPPORTS CALCULATION	4646/H		HYDROSTATIC TIME		H		1				
WPS & PQR	4646/NP		INSULATION (BY OTHERS)		mm		125				
INLET DISTRIBUTOR	B.96.667		FIREPROOFING (BY OTHERS)		mm		75				
COVERPLATE	B.96.667		INSPECTION BY				ASME AUTHORITY				
CENTERPIECE	B.96.667		"U" STAMP REQUIRED				YES				

AS BUILT DWG Date <u>24-03-92</u>			
		JOB NO. 51046 IBN RUSHO AROMATICS PROJECT	
		PO NO. SAYPA0007	
		REQ NO. MR500002	
		IDENT NO. 54-D-01 DW 0001	
APPRO COMMENTS PROCESSED WITH FABRICATION INSPECTED WITH FABRICATION COMMENTS TO BE CORRECTED C/O DO NOT PROCEED WITH FABRICATION		3rd TIME	
		DATE	
PURCHASER'S PERMISSION TO PROCEED OR REVIEW TAKEN ON VENDOR PRINTS SHALL NOT RELIEVE VENDOR FROM ITS RESPONSIBILITIES OR LIABILITIES UNDER PURCHASE ORDER			
ASME STAMP REQUIRED			
APPROVED BY ENGINEER. MANAGER		DATE	
APPROVED BY QUAL. CONTR. MANAGER		DATE	
REVIEWED BY AUTHOR. INSPECTOR			
DATE			
NATIONAL BOARD NUMBER			
ITEM: 54-D-01		N°	
REVISIONS DESCRIPTION			
N.	SIGNATURE	CHECK	APPR.
1	GALLIZIA STEFANO	PULIT	19-04-1986
2	GALLIZIA STEFANO	PULIT	09-09-1986
3	GALLIZIA STEFANO	PULIT	12-10-1986
4	GALLIZIA STEFANO	PULIT	11-11-1986
OFFICINE LUIGI RESTA S.p.A.			
TELEF 300572-TELEFAX 665340 SCANZOROSCATE (Bg)-Corso Europa. 49-761. (035) 661 130			
CLIENT: CHIYODA Corporation		DATE 19-04-1996	
IBN RUSHO AROMATICS PROJECT		DWG. N.º GALLIZIA STEFANO	
SERVICE: REACTOR		CHECK PULIT	
		APPROV NONE	
		SCALE NONE	
		JOB. 11/96/1	
ITEM: 54-D-01		N.º SHIP N. 4839	
		DIS. 4646	
		DWG. 4646	
ASSEMBLY		BUILT	
B.O. N° SAYPA00007			

