



ARABIAN INDUSTRIAL FIBERS COMPANY

IR-II AROMATICS PROJECT

PROJECT NO. 10E0541A01

DOCUMENT TITLE:

REFORMATE SPLITTER RECEIVER DATA SHEET

DOCUMENT NO:

DS-56-DA-502

						ابن رشيد ibn rushid	ARABIAN INDUSTRIAL FIBERS COMPANY YANBU, KINGDOM OF SAUDI ARABIA	CTCI CORPORATION
3	Revised as Marked	LSH	SYL	YSL	11-Aug-11	CERTIFIED		
2	Revised as Marked	LSH	SYL	YSL	26-Apr-11	PROJ.		
1	Issued for Design	LSH	SYL	YSL	9-Mar-11	MGR	DATE	
0	Issue For Approval	LSH	SYL	YSL		CLIENT	DATE	
REV	DESCRIPTION	BY	CHK.	APPR.	DATE	PAGE 1 OF 2		XC32B-56-502

CONTENTS

<u>ITEM</u>	<u>EQUIPMENT NO.</u>	<u>SHEET NO.</u>	<u>REV. NO.</u>	<u>REV. DATE</u>
1.	56-D-02	1 THRU 2 OF 2	3	14-Nov-2011

Attachment total 1 page.

ابن رشد سابق
 سابق



REFORMATE SPLITTER RECEIVER
DATA SHEET

XC32B-56-502

2 OF 2

DATE
14-Nov-2011

REV.
3

ابن رشيد
ابن رشيد
FLUOR.

HORIZONTAL VESSEL DATA SHEET

Contract: 10E0541A01
Equip. No.: 56-D-02
Revision : 3 Date : 14-Nov-2011
Unit : 56 - Sulfolane
P.O. No.:
Document No. : DS-56-DA-502
Sheet 1 of 2

سابك
سابك




CTCI CORPORATION

REV

Client: Arabian Industrial Fibers Company Plant: Sulfolane
Service: Reformate Splitter Receiver Site: Yanbu, Kingdom of Saudi Arabia

DESIGN SKETCH

VESSEL DIMENSIONS: ID: 3000 T/T: 9000

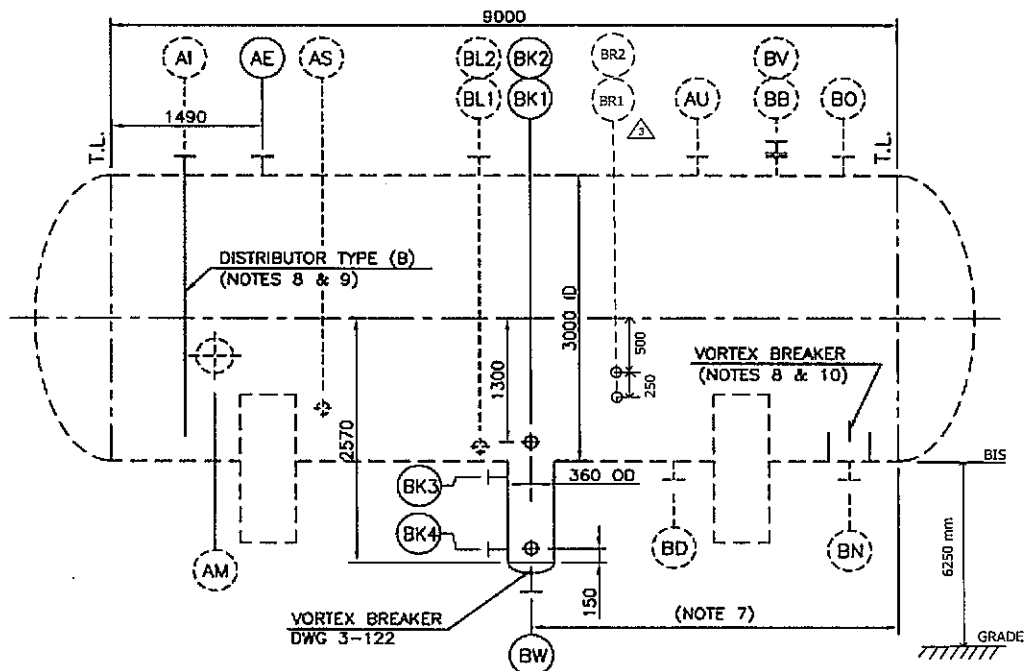

DESIGN CONDITIONS

Pressure:	4.5	bar(g)
At:	155	°C
Vacuum:	FV	bar(g)
At:	44	°C
Min. Design Metal Temp:	9 (Note 14)	°C
At:	MAWP	bar(g)
Maximum Liquid Level:	(Note 4&13)	mm
Specific Gravity of Liquid:	0.701	

OPERATING CONDITIONS

Pressure + :	1.1	bar(g)
At:	44	°C
Vacuum - :		bar(g)
At:		°C
Low Temperature:		°C
At:		bar(g)
Hydrogen Partial Pressure:		bar(a)
At:		°C

INSULATION

Type:	Hot
Req'd Thickness:	40 mm
Fireproofing:	Yes (75 mm)

CONSTRUCTION


MATERIALS		CORROSION ALLOWANCE	
Shell:	SA-516-70	3	mm
Internals:	C.S.	n/a	mm
Lining/Cladding:	n/a	n/a	mm
Head	SA-516-70	3	mm
Boot	SA-516-70 (K.C.S)	6	mm

INTERNALS

DESCRIPTION	BULK DENSITY kg/m³	LIQUID HOLDUP Vol. %	ΔP bar
Packing/Tray:	n/a	n/a	n/a
Catalyst:	n/a	n/a	n/a
Mist Eliminator:	n/a	n/a	n/a

NOTES & SPECIAL CONDITIONS

Stress Relieve (Process Reason Only):	NO
Vessel In Special Service:	
Steamout Required:	Yes

 

		REVISIONS			
MARK		①	②	③	④
APRD	4/2	4/2	THG	4/2	
CHKD	4/2	4/2	THG	4/2	
MADE	4/2	4/2	THG	4/2	
DATE	Mar. 05 '96	APR. 05 '96	Mar. 29 '96	Jun. 30 '97	

VESSELS

REV	DATE	BY	APP'D	REV	DATE	BY	APP'D
0	5-26-85						
1	9-5-85	MA	MA				

ITEM NO 2343-51-D-13

3-122-0	3-123-0	3-317-1
---------	---------	---------



ARABIAN INDUSTRIAL FIBERS COMPANY

IR-II AROMATICS PROJECT

PROJECT NO. 10E0541A01

DOCUMENT TITLE:

CLAY TREATERS DATA SHEET

DOCUMENT NO:

DS-56-DA-503

						ابن رشيد ibn.rushid	ARABIAN INDUSTRIAL FIBERS COMPANY YANBU, KINGDOM OF SAUDI ARABIA	CTCI CORPORATION
3	Revised as Marked	LSH	SYL	YSL	14-Nov-11	CERTIFIED		
2	Revised as Marked	LSH	SYL	YSL	11-Aug-11	PROJ.		
1	Issued for Design	LSH	SYL	YSL	26-Apr-11	MGR _____ DATE _____		
0	Issue For Approval	LSH	SYL	YSL	9-Mar-11	CLIENT _____ DATE _____		
REV	DESCRIPTION	BY	CHK.	APPR.	DATE	PAGE 1 OF 2		XC32B-56-503

CONTENTS

<u>ITEM</u>	<u>EQUIPMENT NO.</u>	<u>SHEET NO.</u>	<u>REV. NO.</u>	<u>REV. DATE</u>
1.	56-D-03A/B	1 THRU 2 OF 2	3	14-Nov-2011

Attachment total 2 pages.

ابن رشد سابک
 asbia ibn rushd



CLAY TREATERS DATA SHEET

XC32B-56-503

2 OF 2

DATE
14-Nov-2011

REV.

3

ابن رشيد
ibn rushd

VERTICAL VESSEL DATASHEET

Contract: 10E0541A01
Equip. No.: 56-D-03A/B
Revision: 3 Date: 14-Nov-2011
Unit: 56 - Sulfolane
PO No.:
Document No. DS-56-DA-503
Sheet: 1 of 2

سابك
sabik



CTCI CORPORATION

REV

CLIENT: Arabian Industrial Fibers Company (Ibn Rushd)
SERVICE: Clay Treaters

PLANT: Sulfolane
SITE: Yanbu, Kingdom of Saudi Arabia

DESIGN SKETCH

VESSEL DIMENSIONS: ID: 5900 mm T/T: 9900 mm

DESIGN CONDITIONS

Pressure: 20.6 bar(g) at 230 °C
Vacuum: FV bar(g) at 200 °C
Min Metal Temp: 9 (Note 8) °C at bar(g)
Maximum Liquid Level: NOTE 4 mm
Specific Gravity of Liquid: 0.688 at °C

OPERATING CONDITIONS

Pressure: 15.5 bar(g) at 160 °C
Vacuum: bar(g) at °C
Low Temperature: °C at °C
Hydrogen Partial Press.: bar(g) at °C

INTERNALS & INSULATION

DESCRIPTION	Bulk Density kg/m³	Liquid Holdup vol%	Pressure Drop bar
Packing:			
Catalyst:			
Mist Eliminator:			
Insulation	50 mm Hot ☐ Cold ☐		
Fire Proofing	75 mm Yes ☐ No ☐		


CONSTRUCTION

	Materials	Corrosion Allowance
Shell:	SA-516-70	3 mm
Heads:	SA-516-70	3 mm
Lining/Cladding:		mm
Internals:		mm

SPECIAL CONDITIONS

Stress Relieve (Process Reason Only): Yes ☐ No ☐
Vessel in Wet Sour Service: Yes ☐ No ☒
Steamout Required: Yes ☐ No ☒

See Notes on Page 2

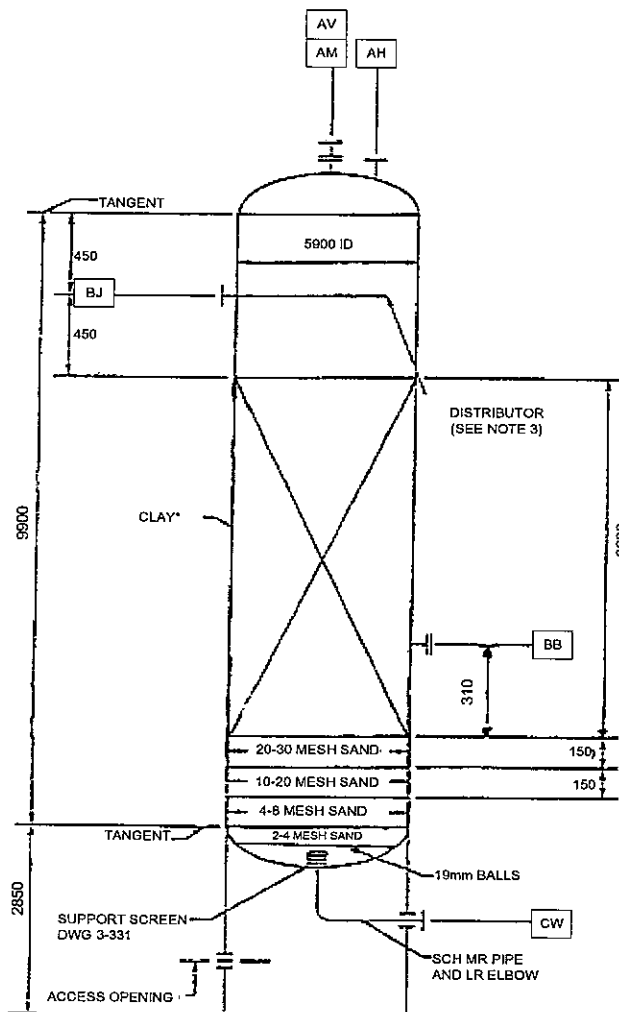

*BED MATERIAL, CERAMIC/ALUMINA BALLS AND SAND TO BE PROVIDED BY OTHERS.

THE ESTIMATED MECHANICAL WEIGHTS (kg)

FABRICATED	
EMPTY	
OPERATING	589,500
FULL OF WATER	

THE ESTIMATED WALL THICKNESS (mm)

TOP HEAD	
SHELL	
BTM HEAD	
SKIRT	

2

2

ابن رشد ibn rushd		VERTICAL VESSEL DATASHEET		Contract: 10E0541A01 Equip. No.: 56-D-03A/B Revision: 3 Date: 14-Nov-2011 Unit: 56 - Sulfolane PO No.: Document No.: DS-56-DA-503 Sheet: 2 of 2		سابك sabik  CTCI CORPORATION		REV
NOZZLE SCHEDULE								
	Tag	Qty.	Size in	Pressure Rating	Description			
1	AH	1	8	300#RFLWN	RELIEF			
2	AM	1	20	300#RFLWN	MANWAY			
3	AV	1	3	300#RFLWN	VENT			
4	BB	1	24	300#RFLWN	MANWAY			
5	BJ	1	8	300#RFLWN	INLET			
6	CW	1	8	300#RFLWN	OUTLET			
7								
8								
NOTES:								
1. Formerly Cyclar Clay Treater, 51-D-14A, B, no changes. Clay catalyst-It is intended that the initial inventory of catalyst/chemical be filled/replaced prior to startup.								
2. Clay treater (two required). 8" distributor per UOP STD DWG 3-314.								
3. Provide 2 (total) slots 8 mm wide at 45 DEG on either side of vertical centerline (pointing up).								
4. Normal liquid level (NLL) is liquid full.								
5. Ladder & Platform Clips : As required.								
6. Insulation Clips & Rings : Yes.								
7. Vessel Support : Yes. Vessel heads are 2:1 Elliptical.								
8. The Min. Design Ambient Temperature should be 6°C.								
9. The clay catalyst quantity is 235m³/ Treater.								



CHIYODA CORPORATION

FOR RECORD

CLIENT : IBN RUSHD
PROJECT : PTA & AROMATICS -
TITLE : AROMATICS
JOB NO. : 51046
DOC. NO. : DS-51-D-014 (1/1)

REVISIONS			
MARK			
APRD	2/28/96	3/2/96	3/2/96
CHKD	3/2/96	3/2/96	3/2/96
MADE	3/2/96	3/2/96	3/2/96
DATE	May 05 '96	APR 15 '96	Jan 30 '97

PROJECT SPECIFICATION			
560689 - 301 - 1 SHEET 16			
REV	DATE	BY	APP'D
0	5-26-95		
1	9-5-95	MAK	MDG

UOP
25 East Algonquin Road - PO Box 5017 - Des Plaines, Illinois 60017-5017 - U.S.A.

VESSELS

SERVICE CLAY TREATERS (TWO REQUIRED) (BY CONTRACTOR)

ITEM NO 51-D-14 A+B

Design Conditions: INT 22.6 BAR (g) 220°C, EXT FULL VACUUM 220°C, Metal Temperature (Min) 9°C, Operating Conditions 200°C

Radiograph: HR, Postweld Heat Treat: HR, Joint Efficiency: HR

Material Specifications: Heads: SA516-70, Shell: SA516-70

Shell: Thickness Required by Code: 3, Corrosion Allowance: 3

Heads: 3

Vessel Heads: Top Head: 2:1 ELLIPTICAL, Bottom Head: 2:1 ELLIPTICAL

Accessories Applied by Fabricator: Ladder & Platform Clips: AS REQUIRED, Insulation Clips & Rings: YES, Vessel Support: YES

Nozzles and Manways:

Mark	No	Size Inches	Service
AH	1	8	RELIEF
AH	1	20	MANWAY
AV	1	3	VENT
BB	1	24	MANWAY
BJ	1	8	INLET
CV	1	8	OUTLET

Class - ANSI CL300

Facing - RAISED FACE

Normal Liquid Level - LIQUID FULL

Specific Gravity - .688

SCHEMATIC ELEVATIONS OF BED SUPPORT MATERIALS. MAY NOT BE REPRESENTATIVE OF ACTUAL DIMENSIONS.

CLAY

20-30 MESH SAND 150

10-20 Mesh Sand 150

4-8 MESH SAND 100

2-4 MESH SAND

TANGENT

5000 10

450

450

9700

CLAY

DISTRIBUTOR (SEE NOTE 1)

310

20-30 MESH SAND 150

10-20 MESH SAND 150

4-8 MESH SAND

2-4 MESH SAND

19 MM BALLS

SUPPORT SCREEN DWS 3-301

ACCESS OPENING

SCH 40 PIPE AND LR ELBOW



SED MATERIAL, CERAMIC/ALUMINA BALLS AND SAND TO BE PROVIDED BY OTHERS.

NOTES: 1) 8" DISTRIBUTOR PER UOP STD DWS 3-314. PROVIDE 2 (TOTAL) SLOTS 8 MM WIDE AT 45 DEG ON EITHER SIDE OF VERTICAL CENTERLINE (POINTING UP).

Drawings Referred to in this Specification

3-314-2 3-331-3

509162

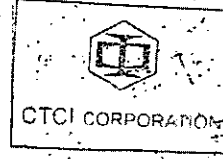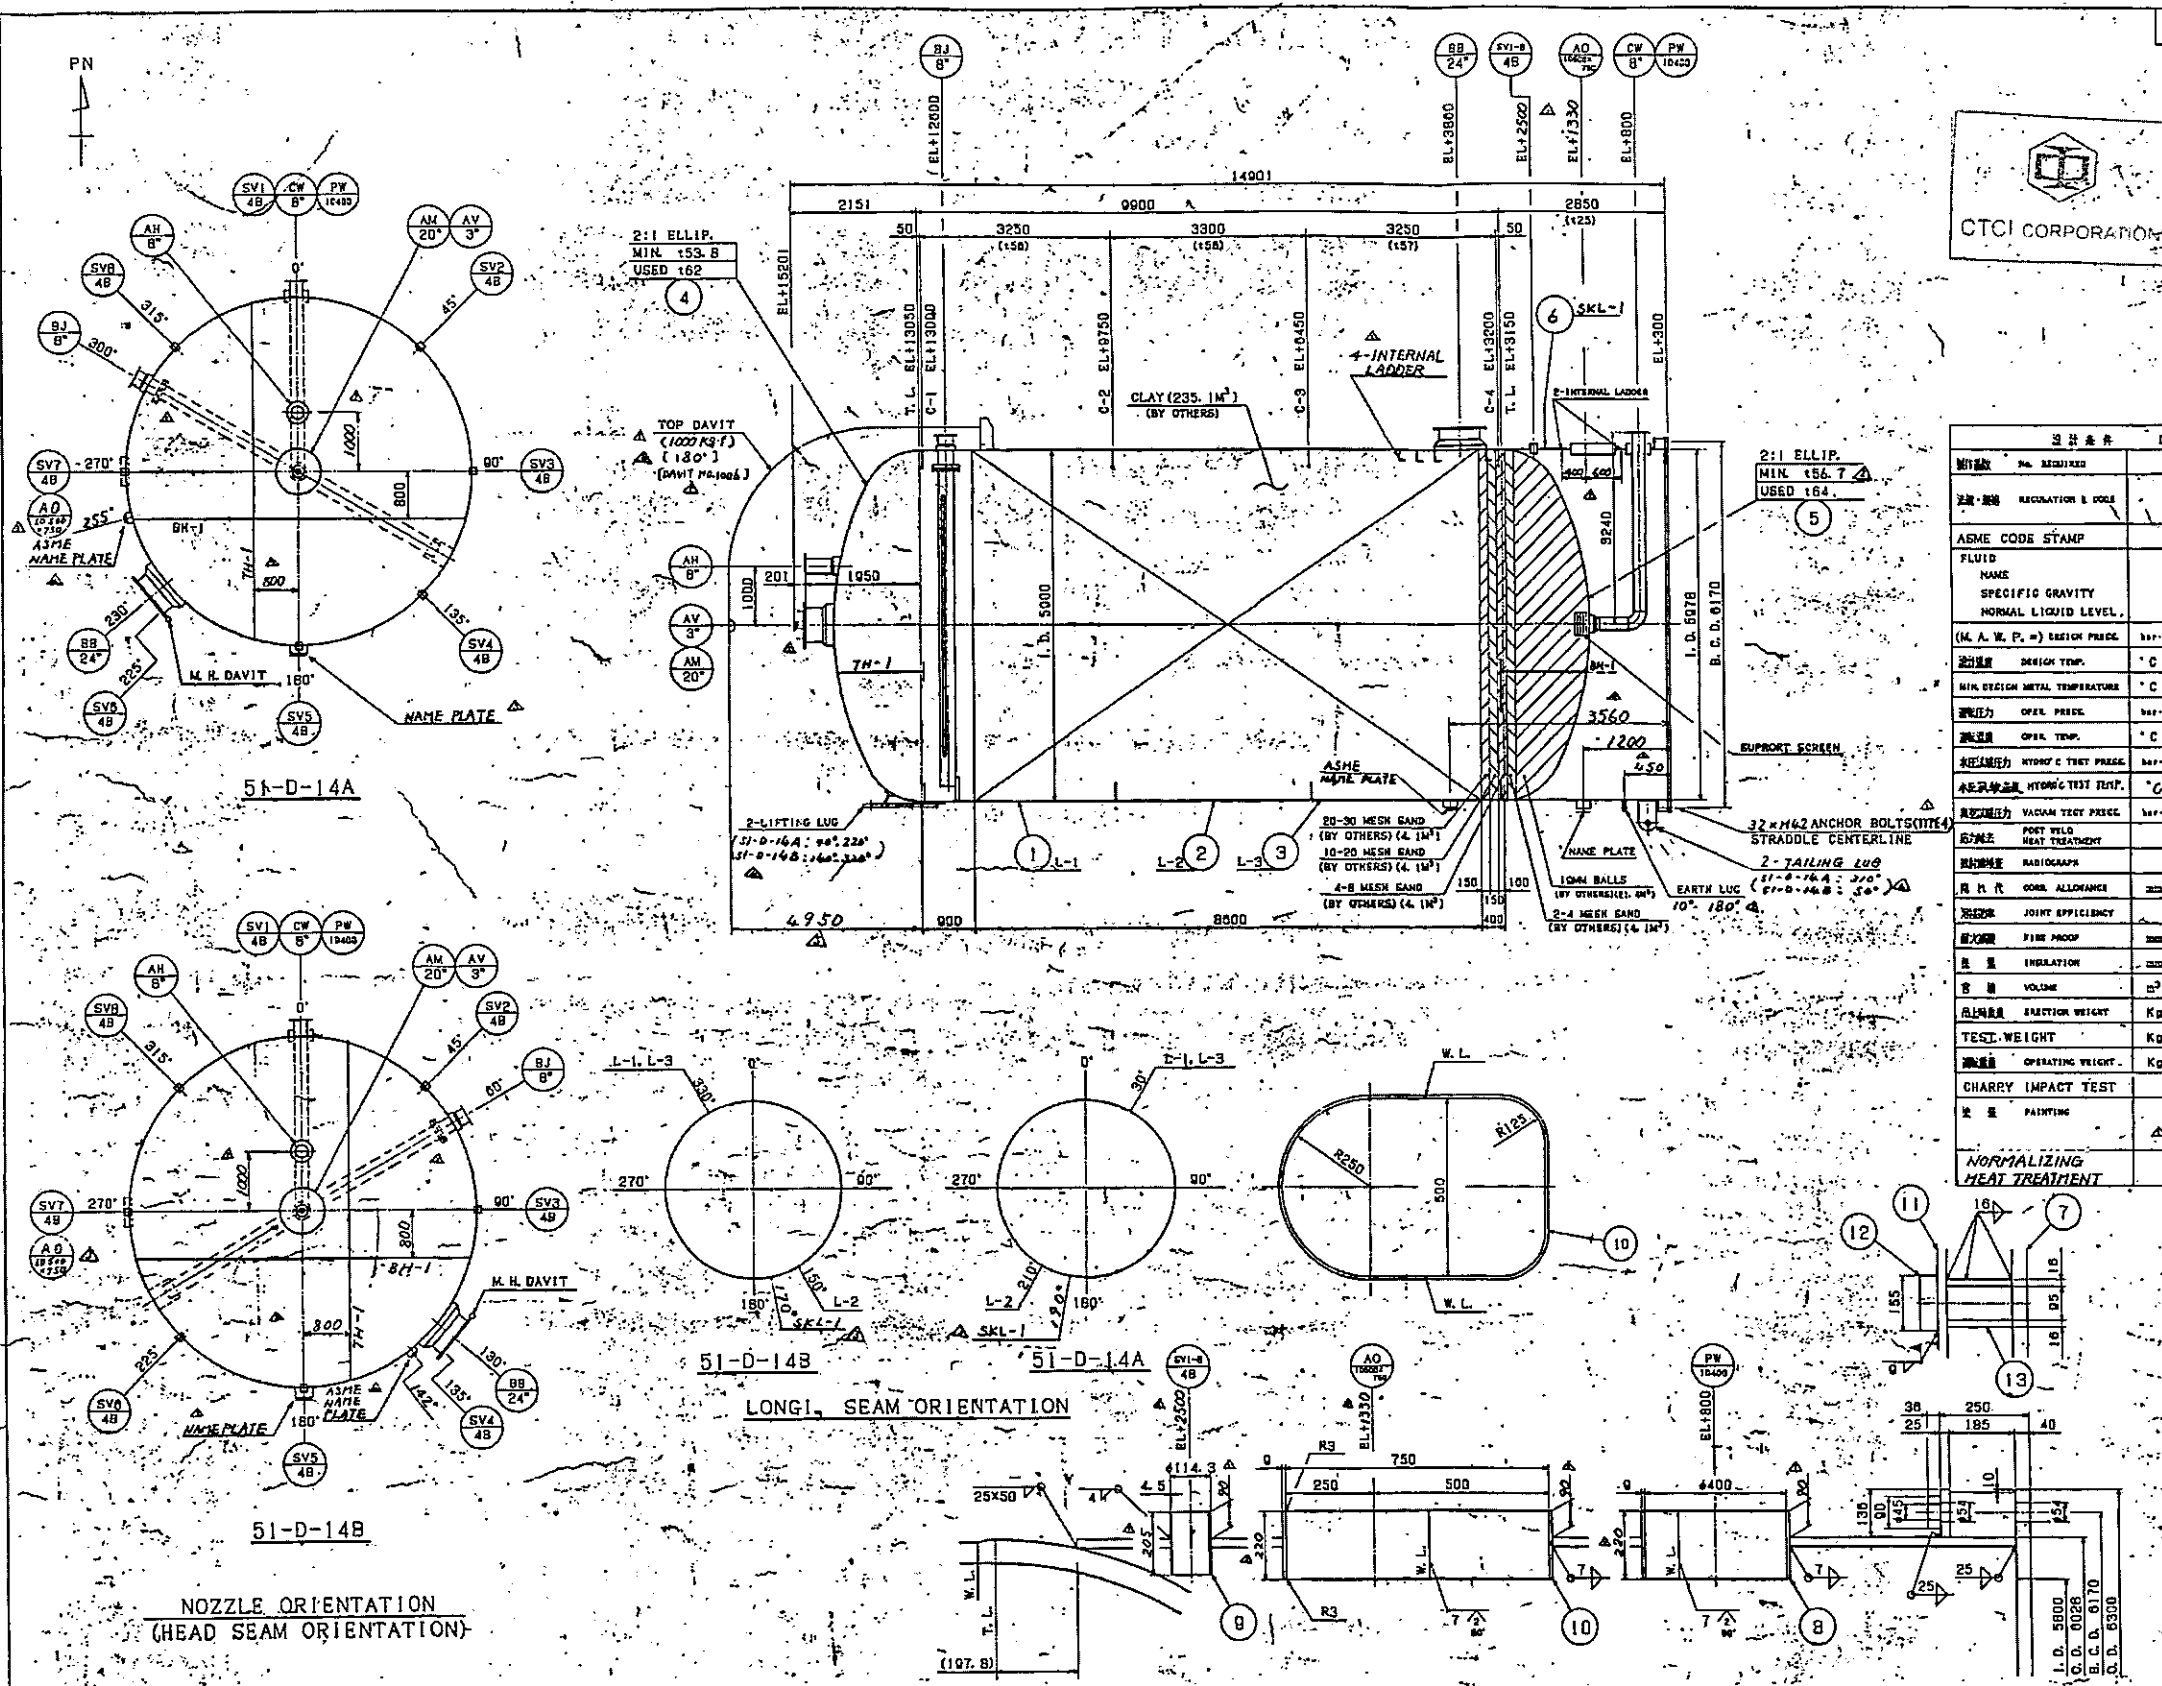

3RD. ANGLE PROJ.				REFERENCE			
REV. NO.	DATE	BY	DESCRIPTION	D.S.M.	G.A.E.	APP'D	REV. NO.
A	1976.12.17	T.Y.	PURCHASER'S REQUEST FOR CONSTRUCTION	1.0	1.0		1.0
B	1977.01.10	T.Y.	REVISED DIM. IN R OF 875 HEAD	2.0	2.0		2.0
C	1977.01.10	T.Y.	REVISED OF HEAD SEAM	3.0	3.0		3.0
D	1977.01.10	T.Y.	REVISED NAME PLATE	4.0	4.0		4.0
E	1977.01.10	T.Y.	REVISED HEIGHT	5.0	5.0		5.0
F	1977.01.10	H.Y.	AS BUILT	6.0	6.0		6.0

REFERENCE-DWG.	
TITLE	DWG. NO.
DETAIL OF NOZZLE	B81481-129-01
MANHOLE DAVIT	B81481-129-02
INTERNAL RING	B81481-124-01
OUTLET BASKET	B81481-124-02
EXTERNAL FITTING	B81481-125-01
EXTERNAL FITTING (11-D-14A PLATFORM CLIP)	B81481-125-02
TOP DAVIT	B81481-125-03
LIFTING LUG	B81481-125-04
EXTERNAL FITTING (11-D-14B PLATFORM CLIP)	B81481-125-05
NAME PLATE	B81481-001-80
NAME PLATE (ASME CODE)	B81481-001-85

DESIGN DATA	
DESIGN NO.	12
REVISION	ASME SECT VIII DIV. 1-1995 (1995 EDITION)
ASME CODE STAMP	YES
FLUID NAME	
SPECIFIC GRAVITY	0.888
NORMAL LIQUID LEVEL	LIQUID FULL
(M. A. W. P. =) DESIGN PRESS.	20.0 (200 PSIG) V. V.
DESIGN TEMP.	100.0 (400 F)
MIN. DESIGN METAL TEMPERATURE	2 (35.0 F)
OVER. PRESS.	0
OVER. TEMP.	0
HYDRO. TEST PRESS.	31.6 (458 PSIG)
VACUUM TEST PRESS.	0
POST WELD HEAT TREATMENT	YES
RADIOGRAPH	FULL
CONC. ALLOWANCE	3.0
JOINT EFFICIENCY	1.0
WIND PROOF	75 (BOTH SIDE)
INSULATION	50 (HOT)
VOLUME	324.4 (11456.1 FT ³)
SECTION WEIGHT	144900
TEST WEIGHT	659000
OPERATING WEIGHT	589500
CHARPY IMPACT TEST	NO (UCS-66 (a))
PAINTING	SYSTEM S2-S PER CHUYODA SPEC. JF-30-X-001
NORMALIZING HEAT TREATMENT	NO (FAD 5) (AFTER HOT PAINTING)

TOTAL		134819 Kg
64 GUSSET PLATE	13	54400
32 PLATE WASHER	12	54400
1 COMP. RING	11	54400
1 ACCESS OPENING	10	54400
8 SKIRT VENT	8	54400
1 PIPE WAY	8	54400
1 BASE PLATE	7	54400
1 SKIRT	6	54400
1 HEAD	5	54400
1 HEAD	4	54400
1 SHELL	3	54400
1 SHELL	2	54400
1 SHELL	1	54400

TYPE 1	TYPE 2	TYPE 3	TYPE 4	TYPE 5
C-1	C-3, 4	C-2	L-1, 2, 3	TH-1
INSIDE: SAW	INSIDE: SAW	INSIDE: SAW	INSIDE: SAW	INSIDE: SAW
OUTSIDE: SAW	OUTSIDE: SAW	OUTSIDE: SAW	OUTSIDE: SAW	OUTSIDE: SAW
70' ±5'	70' ±5'	70' ±5'	70' ±5'	50'
MAX. 2	MAX. 2	MAX. 2	MAX. 2	MAX. 3
80' ±5'	80' ±5'	80' ±5'	80' ±5'	45'

CHUYODA CORPORATION
 JOB NO. 51046 1BN RUSHD AROMATICS PROJECT
 PO NO. SAYPOA0021
 REQ NO. HR-50-D-007
 IDENT NO. 51-D-14A/B-DWG001
 PURCHASER'S PERMISSION TO PROCEED OR REJECT TAKEN OR VENDOR PRINTS SHALL NOT RELIEVE VENDOR FROM ITS RESPONSIBILITIES OR WARRANTIES UNDER PURCHASE ORDER

ASME STAMP YES
 DIV. 1-1995
 BY ASME SECT VIII
 1995 EDITION
 REVIEWED BY
 G. A. ENGINEER
 DATE JUN. 13/76

PARTICULARS		REMARKS
NO. REQUIRED	DATE	
1 SET	JUN. 13/76	
2 SETS		
CLASS	SCALE	DATE
43755	1/80	1/80
DATE	SCALE	DATE
43755	1/80	1/80

CHIYODA CORPORATION
 1BN RUSHD PTA8
 AROMATICS PROJECT-AROMATICS
 CLAY TREATERS
 51-D-14 A&B
 GENERAL ASSEMBLY DRAWING
 004136



ARABIAN INDUSTRIAL FIBERS COMPANY

IR-II AROMATICS PROJECT

PROJECT NO. 10E0541A01

DOCUMENT TITLE:

TATORAY REACTOR DATA SHEET

DOCUMENT NO:

DS-57-DA-503

						ابن رشد ibn rushd	ARABIAN INDUSTRIAL FIBERS COMPANY YANBU, KINGDOM OF SAUDI ARABIA	 CTCI CORPORATION
						CERTIFIED		
2	Revised As Marked	KCK	CBC	YSL	11-Aug-11	PROJ.		
1	Issued For Design	KCK	CBC	YSL	26-Apr-11	MGR _____ DATE _____		
0	Issue For Approval	KCK	CBC	YSL	9-Mar-11	CLIENT _____ DATE _____		
REV	DESCRIPTION	BY	CHK.	APPR.	DATE	PAGE 1 OF 2		XC32B-57-503

CONTENTS

<u>ITEM</u>	<u>EQUIPMENT NO.</u>	<u>SHEET NO.</u>	<u>REV. NO.</u>	<u>REV. DATE</u>
1.	57-D-03	1 THRU 3 OF 3	2	11-Aug.-2011

Attachment total 15 page.

ابن رشيد ibn rushd		VERTICAL VESSEL DATA SHEET		Contract: 10E0541A01 Equip. No.: 57-D-03 Revision: 2 Date: 11-Aug.-2011 Unit: 57 - Tatoray PO No.: Document No.: DS-57-DA-503 Sheet: 1 of 3		سابك sabik  CTCI CORPORATION		REV																								
Client: Arabian Industrial Fibers Company Service: Tatoray Reactor				Plant: Tatoray Site: Yanbu, Kingdom of Saudi Arabia																												
DESIGN SKETCH VESSEL DIMENSIONS: ID: 4000 mm T/T: 5500 mm				DESIGN CONDITIONS																												
				Pressure: 34 bar(g) at 518 °C Vacuum: FV bar(g) at 482 °C Min. Metal Temp: 9 (Note 14) °C at MAWP bar(g) Liquid Level: Full (Note 3) mm Specific Gravity of Liquid: at °C																												
				OPERATING CONDITIONS																												
				Pressure: 29.1 (Note 4) bar(g) at Max. 495 °C Vacuum: bar(g) at °C Low Temperature: °C at °C Hydrogen Partial Press. bar(a) at °C																												
				INTERNALS & INSULATION																												
				<table border="1"> <thead> <tr> <th>DESCRIPTION</th> <th>Bulk Density kg/m³</th> <th>Liquid Holdup vol%</th> <th>Pressure Drop bar</th> </tr> </thead> <tbody> <tr> <td>Packing:</td> <td></td> <td></td> <td></td> </tr> <tr> <td>Catalyst:</td> <td>715 (Note 6)</td> <td></td> <td></td> </tr> <tr> <td>Mist Eliminator:</td> <td></td> <td></td> <td></td> </tr> <tr> <td>Insulation</td> <td>125 mm Hot ☒ Cold ☐</td> <td></td> <td></td> </tr> <tr> <td>Fire Proofing</td> <td>75 mm Yes ☒ No ☐</td> <td></td> <td></td> </tr> </tbody> </table>				DESCRIPTION	Bulk Density kg/m³	Liquid Holdup vol%	Pressure Drop bar	Packing:				Catalyst:	715 (Note 6)			Mist Eliminator:				Insulation	125 mm Hot ☒ Cold ☐			Fire Proofing	75 mm Yes ☒ No ☐			
DESCRIPTION	Bulk Density kg/m³	Liquid Holdup vol%	Pressure Drop bar																													
Packing:																																
Catalyst:	715 (Note 6)																															
Mist Eliminator:																																
Insulation	125 mm Hot ☒ Cold ☐																															
Fire Proofing	75 mm Yes ☒ No ☐																															
				CONSTRUCTION																												
				<table border="1"> <thead> <tr> <th></th> <th>Materials</th> <th>Corrosion Allowance</th> </tr> </thead> <tbody> <tr> <td>Shell:</td> <td>A307 GR. H or GR. 12</td> <td>3 mm</td> </tr> <tr> <td>Heads</td> <td>A307 GR. H or GR. 12</td> <td>3 mm</td> </tr> <tr> <td>Support</td> <td></td> <td>mm</td> </tr> </tbody> </table>					Materials	Corrosion Allowance	Shell:	A307 GR. H or GR. 12	3 mm	Heads	A307 GR. H or GR. 12	3 mm	Support		mm													
	Materials	Corrosion Allowance																														
Shell:	A307 GR. H or GR. 12	3 mm																														
Heads	A307 GR. H or GR. 12	3 mm																														
Support		mm																														
				SPECIAL CONDITIONS																												
				Stress Relieve (Process Reason Only): Yes ☐ No ☒ Vessel in Wet Sour Service: Yes ☐ No ☒ Steamout Required: Yes ☐ No ☒																												
See Page 3 for Design Sketch				WEIGHTS ARE BASED ON THE VENDOR CERTIFIED DRAWING No. 57D03DW0001 Rev. 4 3/24/97				2																								
				EMPTY 115000																												
				OPERATING 222200																												
				FULL OF WATER 218100																												
				THICKNESS ARE BASED ON THE VENDOR CERTIFIED DRAWING No. (mm)																												
				TOP HEAD (Note 5)																												
				SHELL (Note 5)																												
				BTM HEAD (Note 5)																												
				SKIRT																												

Notice: This drawing has not been published and is the sole property of Fluor, and is lent to the borrower for his confidential use only, and in consideration of the loan of this drawing, the borrower agrees to return it upon request and agrees that it shall not be reproduced, copied, lent or otherwise disposed of directly or indirectly, nor used for any purpose other than that for which it is specifically furnished.

ابن رشد ibn rushd		VERTICAL VESSEL DATASHEET		Contract: 10E0541A01		  CTCI CORPORATION
				Equip. No.: 57-D-03		
				Revision: 2	Date: 11-Aug.-2011	
				Unit: 57 - Tatoray		
				PO No.:		
		Document No. DS-57-DA-503				
		Sheet: 2 of 3				
NOZZLE SCHEDULE						
1	Tag	Qty.	Size in	Pressure Rating	Description	
2	A	1	18	600# WNRF	Inlet	
3	B	1	30 I.D.	Special	Manway	
4	C	1	18	600# WNRF	Outlet	
5	D	2	6	600# WNRF	Catalyst Withdrawal	
6						
7						
27	NOTES:					
28	1) Existing. For reactor modifications see UOP Dwg. 951609-304-01-A1 Rev. 0. Reactor Sectional Elevation Item No. 57-D-03.					
29	2) All dimensions are in millimeter unless otherwise noted.					
30	3) For volume of ceramic/alumina balls (to be supplied by others), see UOP Project Specification 560695-312.					
31	4) Operating Pressure: 29.7/29.1 bar(g) (Top/Bottom). Operating Temperature: 482/495 °C (Top/Bottom).					
32	5) Manufacturer/Contractor is responsible to comply with all applicable codes and standards including any additional requirements specified in the Uop Specification.					
33	6) Design ceramic/alumina balls density: 2160 kg/m3					
34	7) All internals to be fabricated to pass thru a 30" manway.					
35	8) For existing UOP drawing see Project Specification:					
36	560695-304-1 Sheet 5					
37	560695-304-1 Sheet 6					
38	560695-304-0 Sheet 7					
39	560695-304-1 Sheet 8					
40	560695-304-1 Sheet 9					
41	9) ASME VIII div. 1 Ed. '95 code stamp is required.					
42	10) Following UOP Standard Specification: 3-12-2.					
43	11) Following UOP Project Specification: 560688-102.					
44	12) All inlet ceramic balls shall be type I and comply with the requirement of UOP Standard Specification 3-37.					
45	13) Material used shall be in accordance with the following specifications:					
46	Plate - SA387 Gr. 11 or 12					
47	Forgings - SA182 Gr. F 11 or F12					
48	SA336 Gr. F 11 or F12					
49	Pipe - SA335 Gr. P11 or P12					
50	14) The Min. Design Ambient Temperature should be 6 °C.					
51						
52						
Notice: This drawing has not been published and is the sole property of Fluor, and is lent to the borrower for his confidential use only, and in consideration of the loan of this drawing, the borrower agrees to return it upon request and agrees that it shall not be reproduced, copied, lent or otherwise disposed of directly or indirectly, nor used for any purpose other than that for which it is specifically furnished.

ابن رشد
ibn rushd

VERTICAL VESSEL DATASHEET

Contract: 10E0541A01
Equip. No.: 57-D-03
Revision: 2 Date: 11-Aug.-2011
Unit: 57 - Tatoray
PO No.:
Document No.: DS-57-DA-503
Sheet: 3 of 3


سابك
sabc



CTCI CORPORATION

REV

DESIGN SKETCH

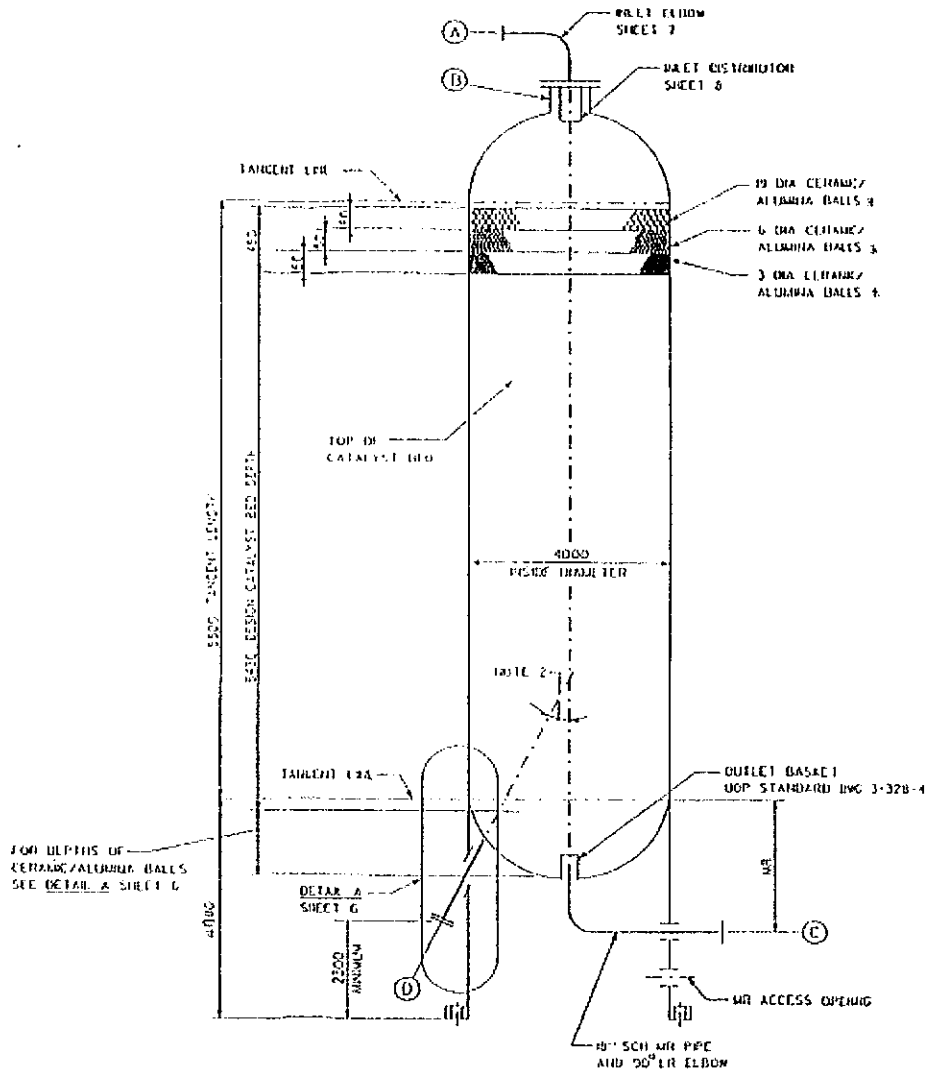



FOR RECORD

CLIENT : IBN RUSHD
PROJECT : PTA & AROMATICS -
TITLE : AROMATICS
JOB NO. : 51046
DOC. NO. : DS-57-D-003 (1/9)

MARK	REVISIONS			
	①	②	③	④
APRD	T. L. H.	K. L. H.		
CHKD	K. L. H.	K. L. H.		
MADE	K. L. H.	K. L. H.		
DATE	APR. 01 '96	June 11 '96	Feb 09 '97	

UOP

25 East Algonquin Road - Des Plaines, Illinois 60017-5017 - USA.

REACTORS

(Item No. 57-D-03)

PROJECT SPECIFICATION

560695 - 304 - O Sheet 1

REV	DATE	BY	APP'D	REV	DATE	BY	APP'D
0	4/1/96	BPP	TPD				

DESCRIPTION

SHEET

NOTES

2-4

REACTOR SKETCH

5

REACTOR DETAILS

6

INLET ELBOW

7

INLET DISTRIBUTOR

8

SKIRT DETAIL

9

NOTE: These data are confidential and the property of UOP and shall not be disclosed to others or reproduced in any manner or used for any purpose whatsoever except by written permission or as provided in a signed agreement with UOP relating to such data.



DS-57-D-003 (2/9)

UOP

25 East Algonquin Road • Des Plaines, Illinois 60017-5017 • USA.

PROJECT SPECIFICATION

560695 - 304- O

Sheet 2

REACTORS

REV	DATE	BY	APP'D	REV	DATE	BY	APP'D
0	4/19/91	BPP					

GENERAL NOTES

57-D-03

- A. The Tatoray Reactor (~~D-5703~~) shall be constructed in accordance with the following:

Code(s): ASME Boiler and Pressure Vessel Code, Section VIII, Division 1, Pressure Vessels (Latest Edition and Addenda).

Specifications: UOP Standard Specification 3-12-2
UOP Project Specification 560688-102

- B. Where "MR" is specified, it indicates that it is the manufacturer's and/or contractor's responsibility to comply with all applicable codes and standards including any additional requirements specified in the UOP Specifications.
- C. Skirt to shell attachment shall be constructed as shown on the reactor elevation in this specification. Attachment designs must accommodate full, external, on site Ultrasonic Angle Beam examination of the shell/head weld(s).
- D. All nozzle projections shall be MR unless noted otherwise.
- E. Reinforcement for nozzles and manways shall be integrally provided in nozzle neck. All nozzle and manway attachments shall be in accordance with figure UW-16.1, sketch f of section VIII, Division 1 of the ASME Code. Sketches f-1 and f-4 are recommended configurations.
- F. Flanges that are not within the scope of ASME/ANSI B16.5 shall comply with section VIII, Div. 1 of ASME code.
- G. All flanges intended for use with spiral-wound gaskets shall have a flange surface finish of 125 Ra minimum to 250 Ra maximum.
- H. Material used shall be in accordance with the following specifications:
1. Plate - SA387 Gr. 11 or 12
 2. Forgings - SA182 Gr. F11 or F12
 3. Pipe - SA336 Gr. F11 or F12
 - SA335 Gr. P11 or P12
- I. Gaskets for use with raised face flanges shall be spiral wound with non-asbestos filler. These gaskets shall be designed per API 601 and shall be suitable for service.

NOTE - These data are confidential and the property of UOP and shall not be disclosed to others or reproduced in any manner or used for any purpose whatsoever except by written permission or as provided in a signed agreement with UOP relating to such data.

509092



DS-57-D-003(3/4)

UOP

25 East Algonquin Road • Des Plaines, Illinois 60017-5017 • USA.

PROJECT SPECIFICATION

560695 -304- 0 Sheet 3

REACTORS

REV	DATE	BY	APP'D	REV	DATE	BY	APP'D
0	4/4/95	BPP					

FABRICATION

- A. Main reactor welds shall be full penetration double butt (or equivalent) welds free of undercuts and ground for radiographic inspection. They shall be designed to permit 100% radiographic inspection.
- B. Welds attaching non-pressure-retaining components to pressure-retaining components shall be full penetration. All fillet welds attached to pressure-retaining components shall be ground to a smooth, concave contour.
- C. All pressure retaining welds of the vessel, including any weld between an integral skirt to pressure vessel forging and the bottom head or shell of the pressure vessel, shall be located and fabricated to allow full, external, on-site Ultrasonic examination. For heavy wall pressure vessels (defined as a shell thickness in excess of 2 inches), or any pressure vessel utilizing an internal lining (clad or weld overlay) a calibration block for Ultrasonic examination shall be provided. The calibration block shall be in accordance with ASME Section V, Paragraph T-542.2.
- D. All components (regardless of size, thickness, or product form) shall be Postweld Heat Treated in accordance with ASME Section VIII, Division 1, except that the hold temperature shall be $1275^{\circ}\text{F} \pm 25^{\circ}\text{F}$ ($691^{\circ}\text{C} \pm 14^{\circ}\text{C}$).
- E. The maximum room temperature tensile strength of all pressure-retaining components, materials, and welds shall be 100,000 psi (690 MPa).
- E. The product analysis content of Tin and Phosphorus for all pressure-retaining components shall meet the following weight percent limits (welding consumables included):

$$\begin{aligned} \text{Sn} &\leq 0.015\% \\ \text{P} &\leq 0.012\% \end{aligned}$$

EXAMINATION/TESTING

- A. Ultrasonic:
All weld reinforcements shall be contoured to allow proper interpretation of Ultrasonic examination.

NOTE - These data are confidential and the property of UOP and shall not be disclosed to others or reproduced in any manner or used for any purpose whatsoever except by written permission or as provided in a signed agreement with UOP relating to such data.



DS-57-D-003 (4/9)



25 East Algonquin Road • PO Box 5017 • Des Plaines, Illinois 60017-5017 • USA

PROJECT SPECIFICATION

560695 -304 1 SHEET 4

REACTORS

REV	DATE	BY	APPD	REV	DATE	BY	APPD
0	4/19/85	BPP					
1	5/17/85	TLW	TRD				

B.

Impact Text:

Charpy V-notch impact testing is required for all pressure-retaining components and welds. Impact tests shall be conducted in accordance with ASME Section VIII, Division 1, Paragraph UG-84, except that there shall be no exemptions from impact testing, and the test temperature shall not exceed 0°F (-18°C). When the tested component or weld will receive heat treatment, the test specimens shall be supplied in a completely heat-treated condition.

C.

Magnetic Particle Examination:

- ① 1. Examination shall be in accordance with Appendix VI of Section VIII, Division 1, of the ASME code. If prods are used, tips shall be carbon steel, not lead or copper.
2. All plate edges shall be examined after trimming, but prior to welding, to reveal laminations and injurious segregations. Laminations and injurious segregations shall be removed by chipping or grinding and shall be re-examined to assure that all defects have been removed.
3. Double-butt welds shall have the initial root passes, including root tack welds, chipped, ground and gouged to sound metal, and the back chipped welds, welding groove and plate edges examined to assure that all cracks, pin holes, porosity or other weld defects are removed before commencing welding on the second side.
4. All weld root areas shall be examined before and after removal of defects.

D.

Chemical Analysis:

1. Certified chemical analysis of all automatic weld wire is required. A check analysis of every 15th reel of wire or heat for alloy content is required.
2. Sample of each complete shell, head and nozzle weld shall be analyzed to confirm required alloy content. Samples to be taken from the inside weld surface prior to weld overlay.

NOTE - These data are confidential and the property of UOP and shall not be disclosed to others or reproduced in any manner or used for any purpose whatsoever except by written permission or as provided in a signed agreement with UOP relating to such data.

509084

31-4

PROJECT SPECIFICATION

560695 - 304 -1

SHEET 5

REV	DATE	BY	APVD	REV	DATE	BY	APVD
0	4/19/95	OPP					
1	5/11/95	TLW	TLD				

Uop

25 East Argonne Road • PO Box 5017 • Oes Plains, Illinois 60417-5017 • 11/1/94

NAME TATORAY REACTOR

ITEM ~~12-1703~~ 57-D-03

Design Conditions	INT 34 Bars (g) @ 518°C	(2)
	EXT FULL VACUUM @ 484°C	
	Min Metal Temperature 5°C	
Operating Conditions	484°C	(4)

Radlograph	FULL
Postweld Heat Treat	YES
Joint Efficiency	100%

Material Specifications	
Shell	A307 GR. 11 OR GR. 12
Heads	SAME AS SHELL

Linings			
	Thickness Reqd By Code-man	Corrosion Allowance mm (MIL)	
Shell	Nil	3	

Books	LBI	3
--------------	------------	----------

Reactor Heads	Hemispherical
---------------	---------------

Accessories Applied by Fabricator	
Ladder And Platform Clips	YES
Insulation Clips And Rings	YES
Vessel Support	YES

Nozzles and Manways			
Mark	No	Size inches	Service
A	1	18	INLET
B	1	30 I.D.	MANWAY
C	1	18	OUTLET
D	2	6	CATALYST WITHDRAWAL

[illegible]


Rating- ANSI CL 600**

Facing-Raised Facing

**EXCEPT NOZZLE (B) WHICH SHALL BE SPECIALLY DESIGNED PER ASME SECTION VIII, DIV. I

NOTES:

1. ALL MATERIALS TO BE FABRICATED TO PASS
THRU A 30" ID HAWTHAY.
2. CONTRACTOR TO ORIENT UNLOADING NOZZLE
FOR MAXIMUM CATALYST REMOVAL. PROVIDE
PROPER WORKING CLEARANCES BETWEEN
TARGES "C", "D", REACTOR SUPPORT, OUTLET
ELBOW AND AIR SPACE.
3. FOR VOLUME OF CERAMIC/ALUMINA BALLS
(10 IN. SUPPLIED BY OTHERS), SEE DOP
PROJECT SPECIFICATION 506095-SI2.
4. DESIGN CATALYST DENSITY: 657 KG/M³.
DESIGN CERAMIC/ALUMINA BALLS
DENSITY: 2020 KG/M³.
5. WORK THIS SHEET WITH SHEET G. (1)
6. ALL DIMENSIONS ARE IN MILLIMETERS UNLESS NOTED.

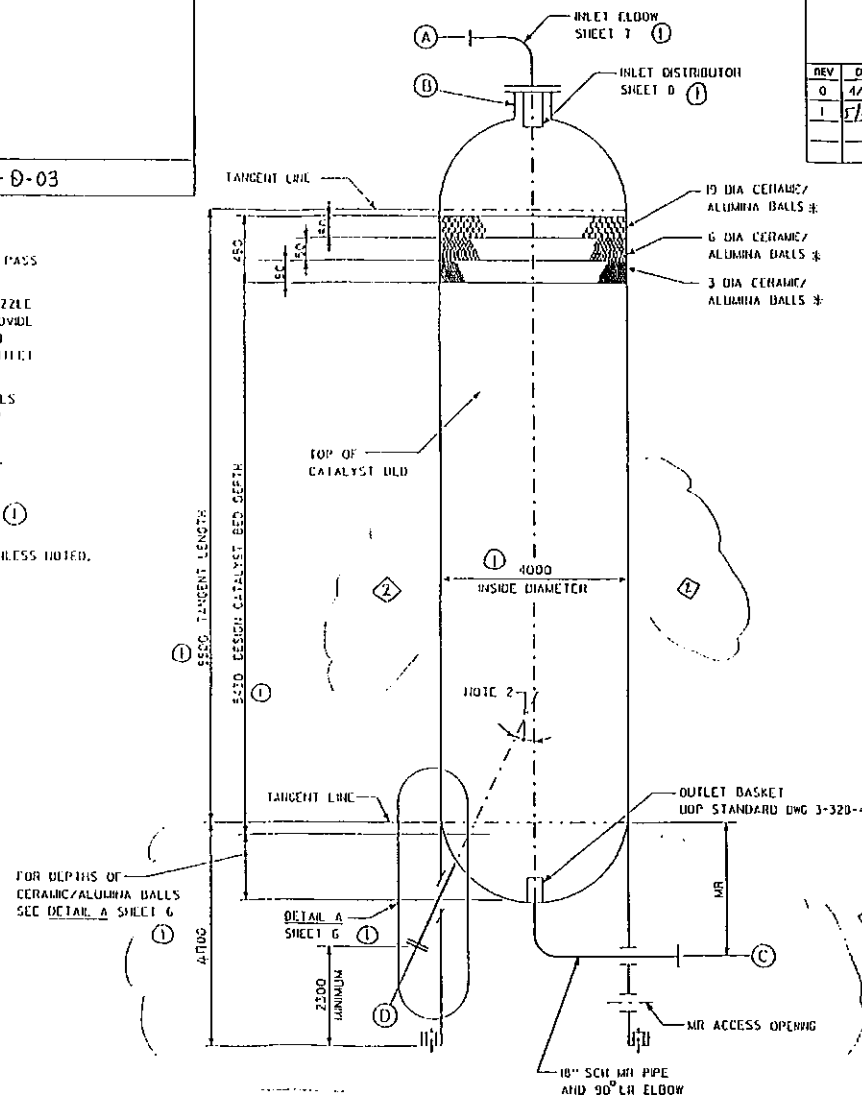

ELEVATION

* NOTE 3

Drawings Related to in this Specification

3-320-1

C 47325-6

C47325-B

34

509090



UOP
25 East Algonquin Street • P.O. Box 5017 • Des Plaines, Illinois 60017-5017 • USA

REACTORS

NAME TATORAY REACTOR ITEM D-5703 57-D-03



DS-57-D-003 (4/9)

PROJECT SPECIFICATION
560695 - 304 - 1 SHEET 6

REV	DATE	BY	APVD	REV	DATE	BY	APVD
0	3/12/95	BNP					
1	5/27/95	TLW	TPD				

NOTES:

WORK THIS SHEET WITH SHEET 5. ①

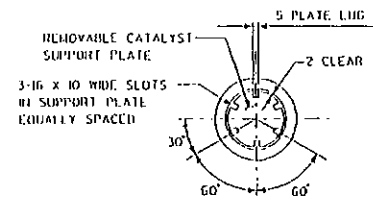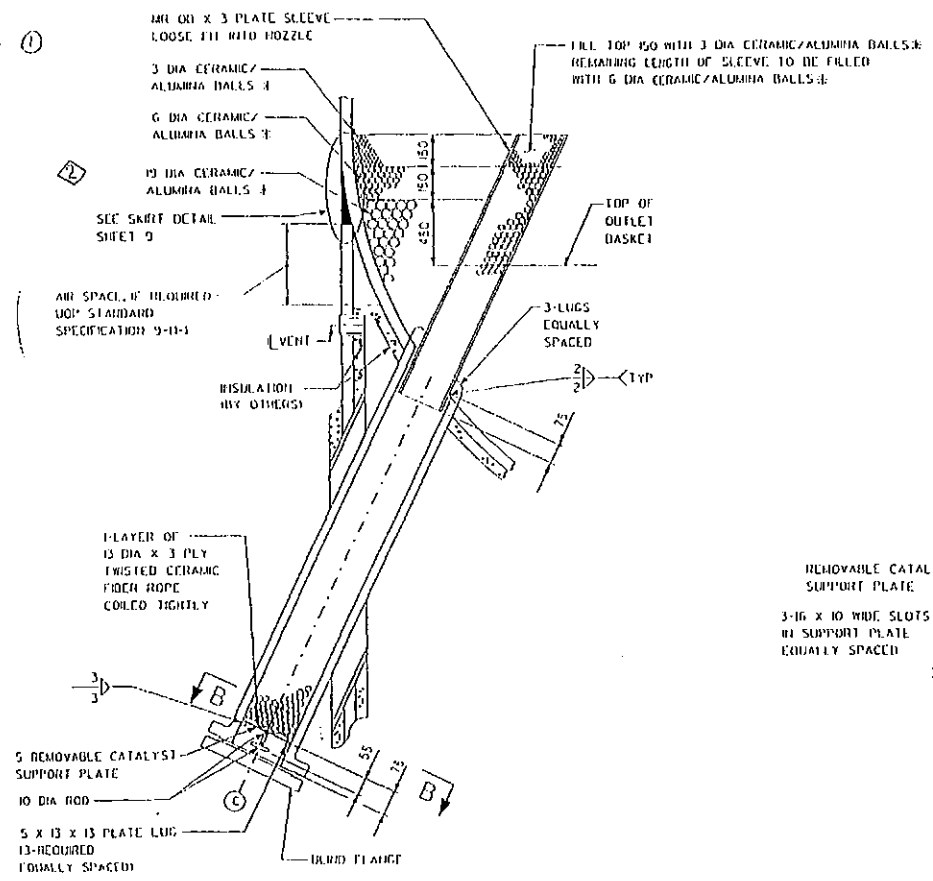

SECTION B-B

DETAIL A
* NOTE 3, SHEET 5 ①

C47326-
NOTE: Data are confidential and the property of UOP. They shall not be disclosed to others or reproduced in any form or used for any purpose whatsoever except by written permission or as provided in a signed agreement with UOP relating to such data.



DS-57-D-003 (7/9)

Uop

25 East Algonquin Road • PO Box 5017 • Des Plaines, Illinois 60017-5017 • USA

PROJECT SPECIFICATION


560695- 304 - 0 SHEET 7

REACTORS

REV	DATE	BY	APVD	REV	DATE	BY	APVD
0	4/19/95	BPP					

NAME INLET ELBOW DETAIL

ITEM ~~D-5703~~ 57-D-03

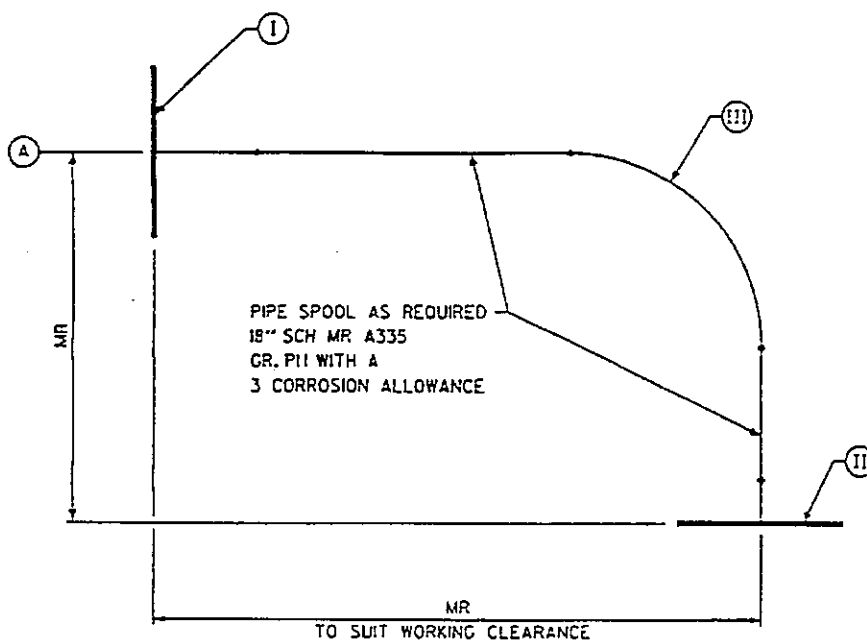

- (I) 18" WELDING NECK FLANGE, A182 GR. F11 OR F12
- (II) 30" ID BLIND OR WELDING NECK REDUCING FLANGE, A182 GR. F11 OR F12
- (III) 18" SCH MR LONG RADIUS ELBOW A234 GR. WP11 OR WP12 WITH A 3 CORROSION ALLOWANCE

NOTES:

1. ALL FLANGE RATINGS TO BE ANSI CLASS 600. SEE GENERAL NOTES FOR ADDITIONAL INFORMATION.
2. PIPING SHALL BE FABRICATED IN ACCORDANCE WITH UOP STANDARD SPECIFICATION 8-12-3
3. FLANGE (II) SHALL BE SPECIALLY DESIGNED PER ASME SEC. VIII, DIV. 1 TO MATE AND MATCH WITH NOZZLE (B) ON SHEET 5.

NOTE - These data are confidential and the property of UOP and shall not be disclosed to others or reproduced in any manner or used for any purpose whatsoever except by written permission or as provided in a signed agreement with UOP relating to such data.

C47327-A

509097

31-7



DS-57-D-003 (8/9)

UOP

25 East Algonquin Road • PO Box 5017 • Des Plaines, Illinois 60017-5017 • USA

PROJECT SPECIFICATION

560695- 304 - : (SHEET 8


REACTORS

REV	DATE	BY	APVD	REV	DATE	BY	APVD
0	4/19/95	BPP					
1	5/17/95	TLW	TJD				


NAME INLET DISTRIBUTOR DETAIL

ITEM ~~D-5703~~ 57-D-03

NOTE - These data are confidential and the property of UOP and shall not be disclosed to others or reproduced in any manner or used for any purpose whatsoever except by written permission or as provided in a signed agreement with UOP relating to such data.

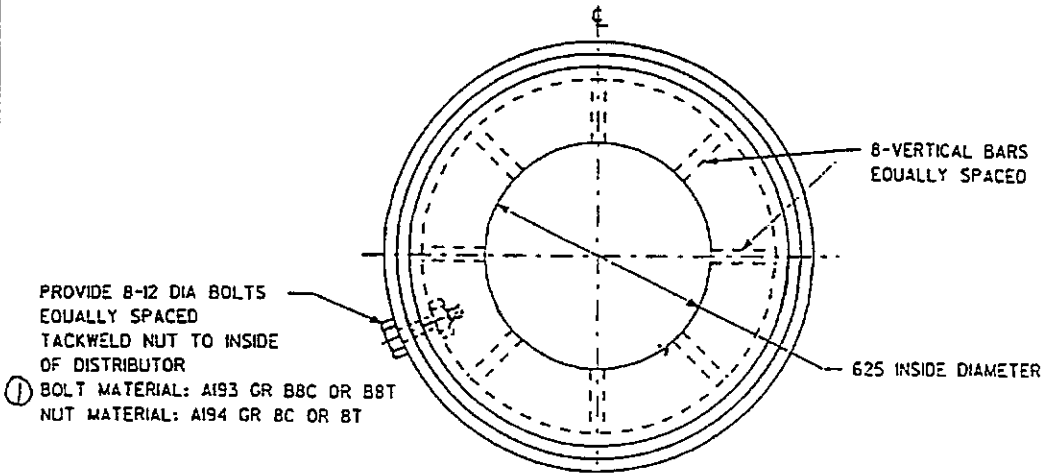

PLAN

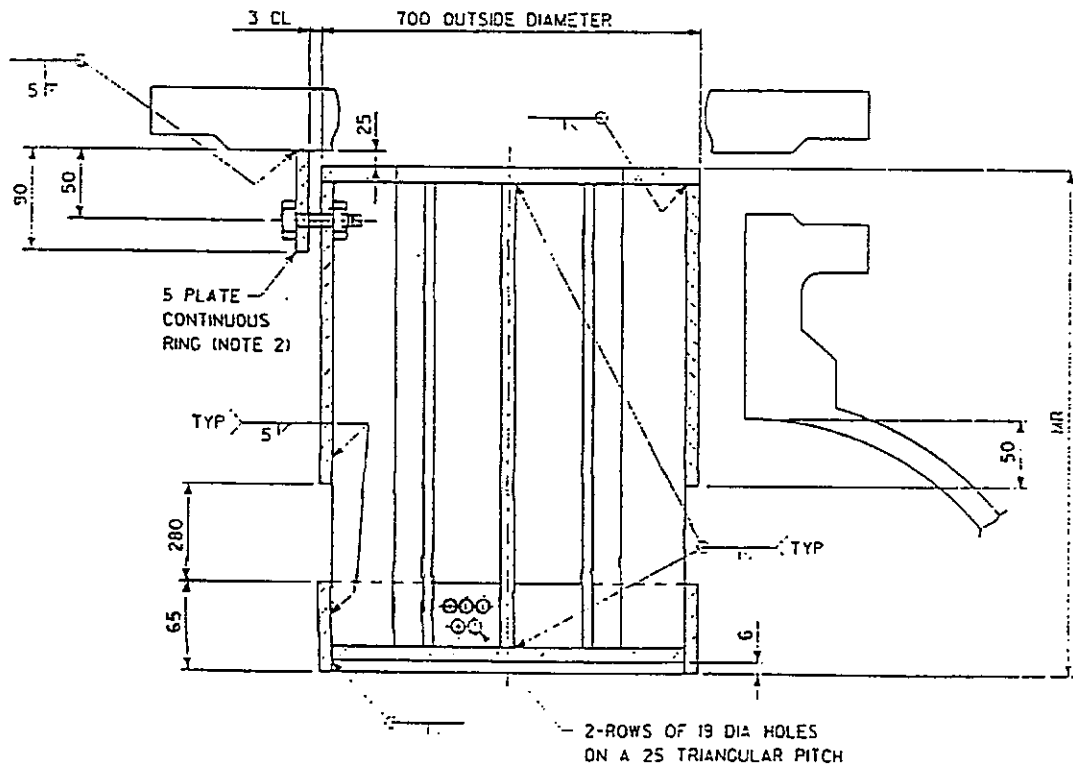

ELEVATION

NOTES:

1. ALL PLATE MATERIAL SHALL BE 5 THICK A240 GR. 347 OR GR. 321 UNLESS NOTED.
2. 5 PLATE CONTINUOUS RING MATERIAL TO MATCH FLANGE MATERIAL.
3. ALL DIMENSIONS ARE IN MILLIMETERS UNLESS NOTED.

C47328-A



DS-57-D-003 (9/9)

Uop

25 East Algonquin Road • PO Box 5017 • Des Plaines, Illinois 60017-5017 • USA

PROJECT SPECIFICATION

560695 - 304 - 1 SHEET 9

REACTORS


REV	DATE	BY	APVD	REV	DATE	BY	APVD
0	4/19/95	BPP					
1	5/12/95	TLW	TFD				

SERVICE

TATORAY REACTOR

ITEM NO ~~5-5703~~ 57-D-03

SKIRT DETAIL

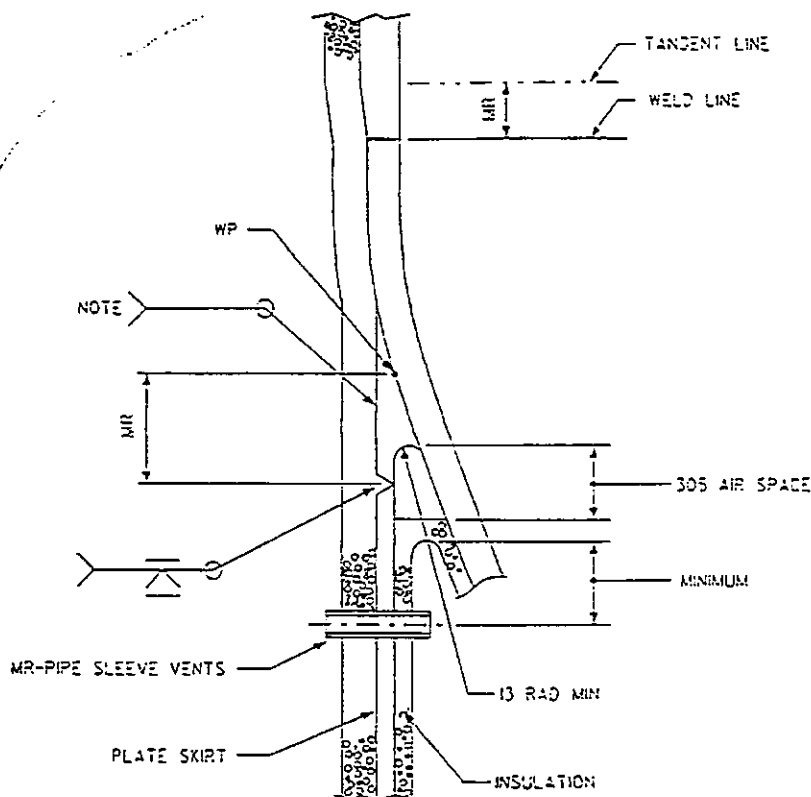

DETAIL C

NOTES:



1. THE JOINT BETWEEN THE SUPPORT SKIRT AND BOTTOM HEAD SHALL HAVE THE SMOOTH STREAMLINE GEOMETRY AS SHOWN. THE JOINT DETAIL MAY BE MADE BY FORGING A SINGLE BUTT WELDING COMPONENT INTEGRAL WITH THE VESSEL. WELD METAL BUILD UP OR BUILT UP CONSTRUCTION USING PLATE AND WELD METAL, BACKING STRIPS, IF USED, SHALL BE REMOVED AFTER WELDING. WELDS SHALL BE GROUND OR MACHINED TO A SMOOTH, FLUSH CONTOUR. 100% MAGNETIC PARTICLE OR DYE PENETRANT EXAMINATION OF ALL WELD SURFACES SHALL BE PERFORMED AFTER FINAL POSTWELD HEAT TREATMENT.
2. ALL DIMENSIONS ARE IN MILLIMETERS UNLESS NOTED.


NOTE: - These data are confidential and the property of UOP and shall not be disclosed to others or reproduced in any manner or used for any purpose whatsoever except by written permission or as provided in a signed agreement with UOP relating to such data.

C47329-A

509099

(1-9)

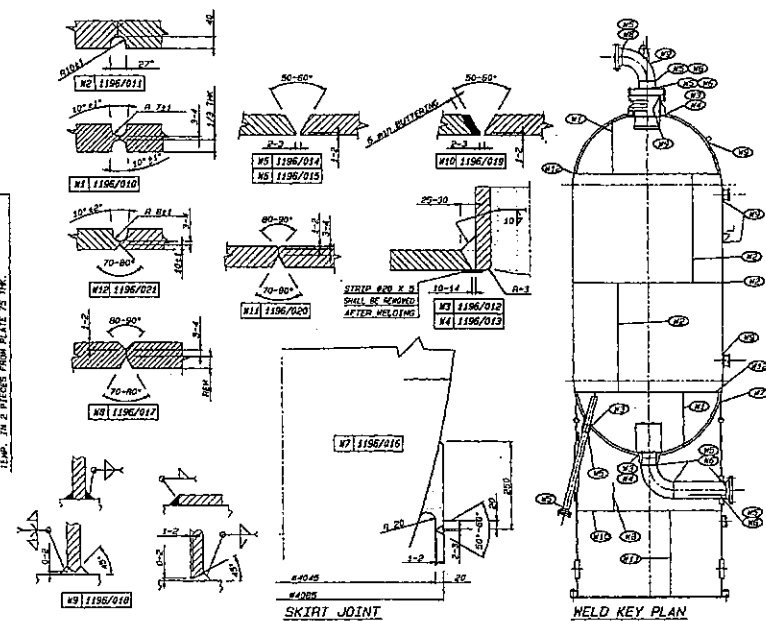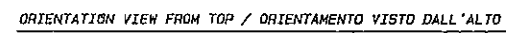[illegible]

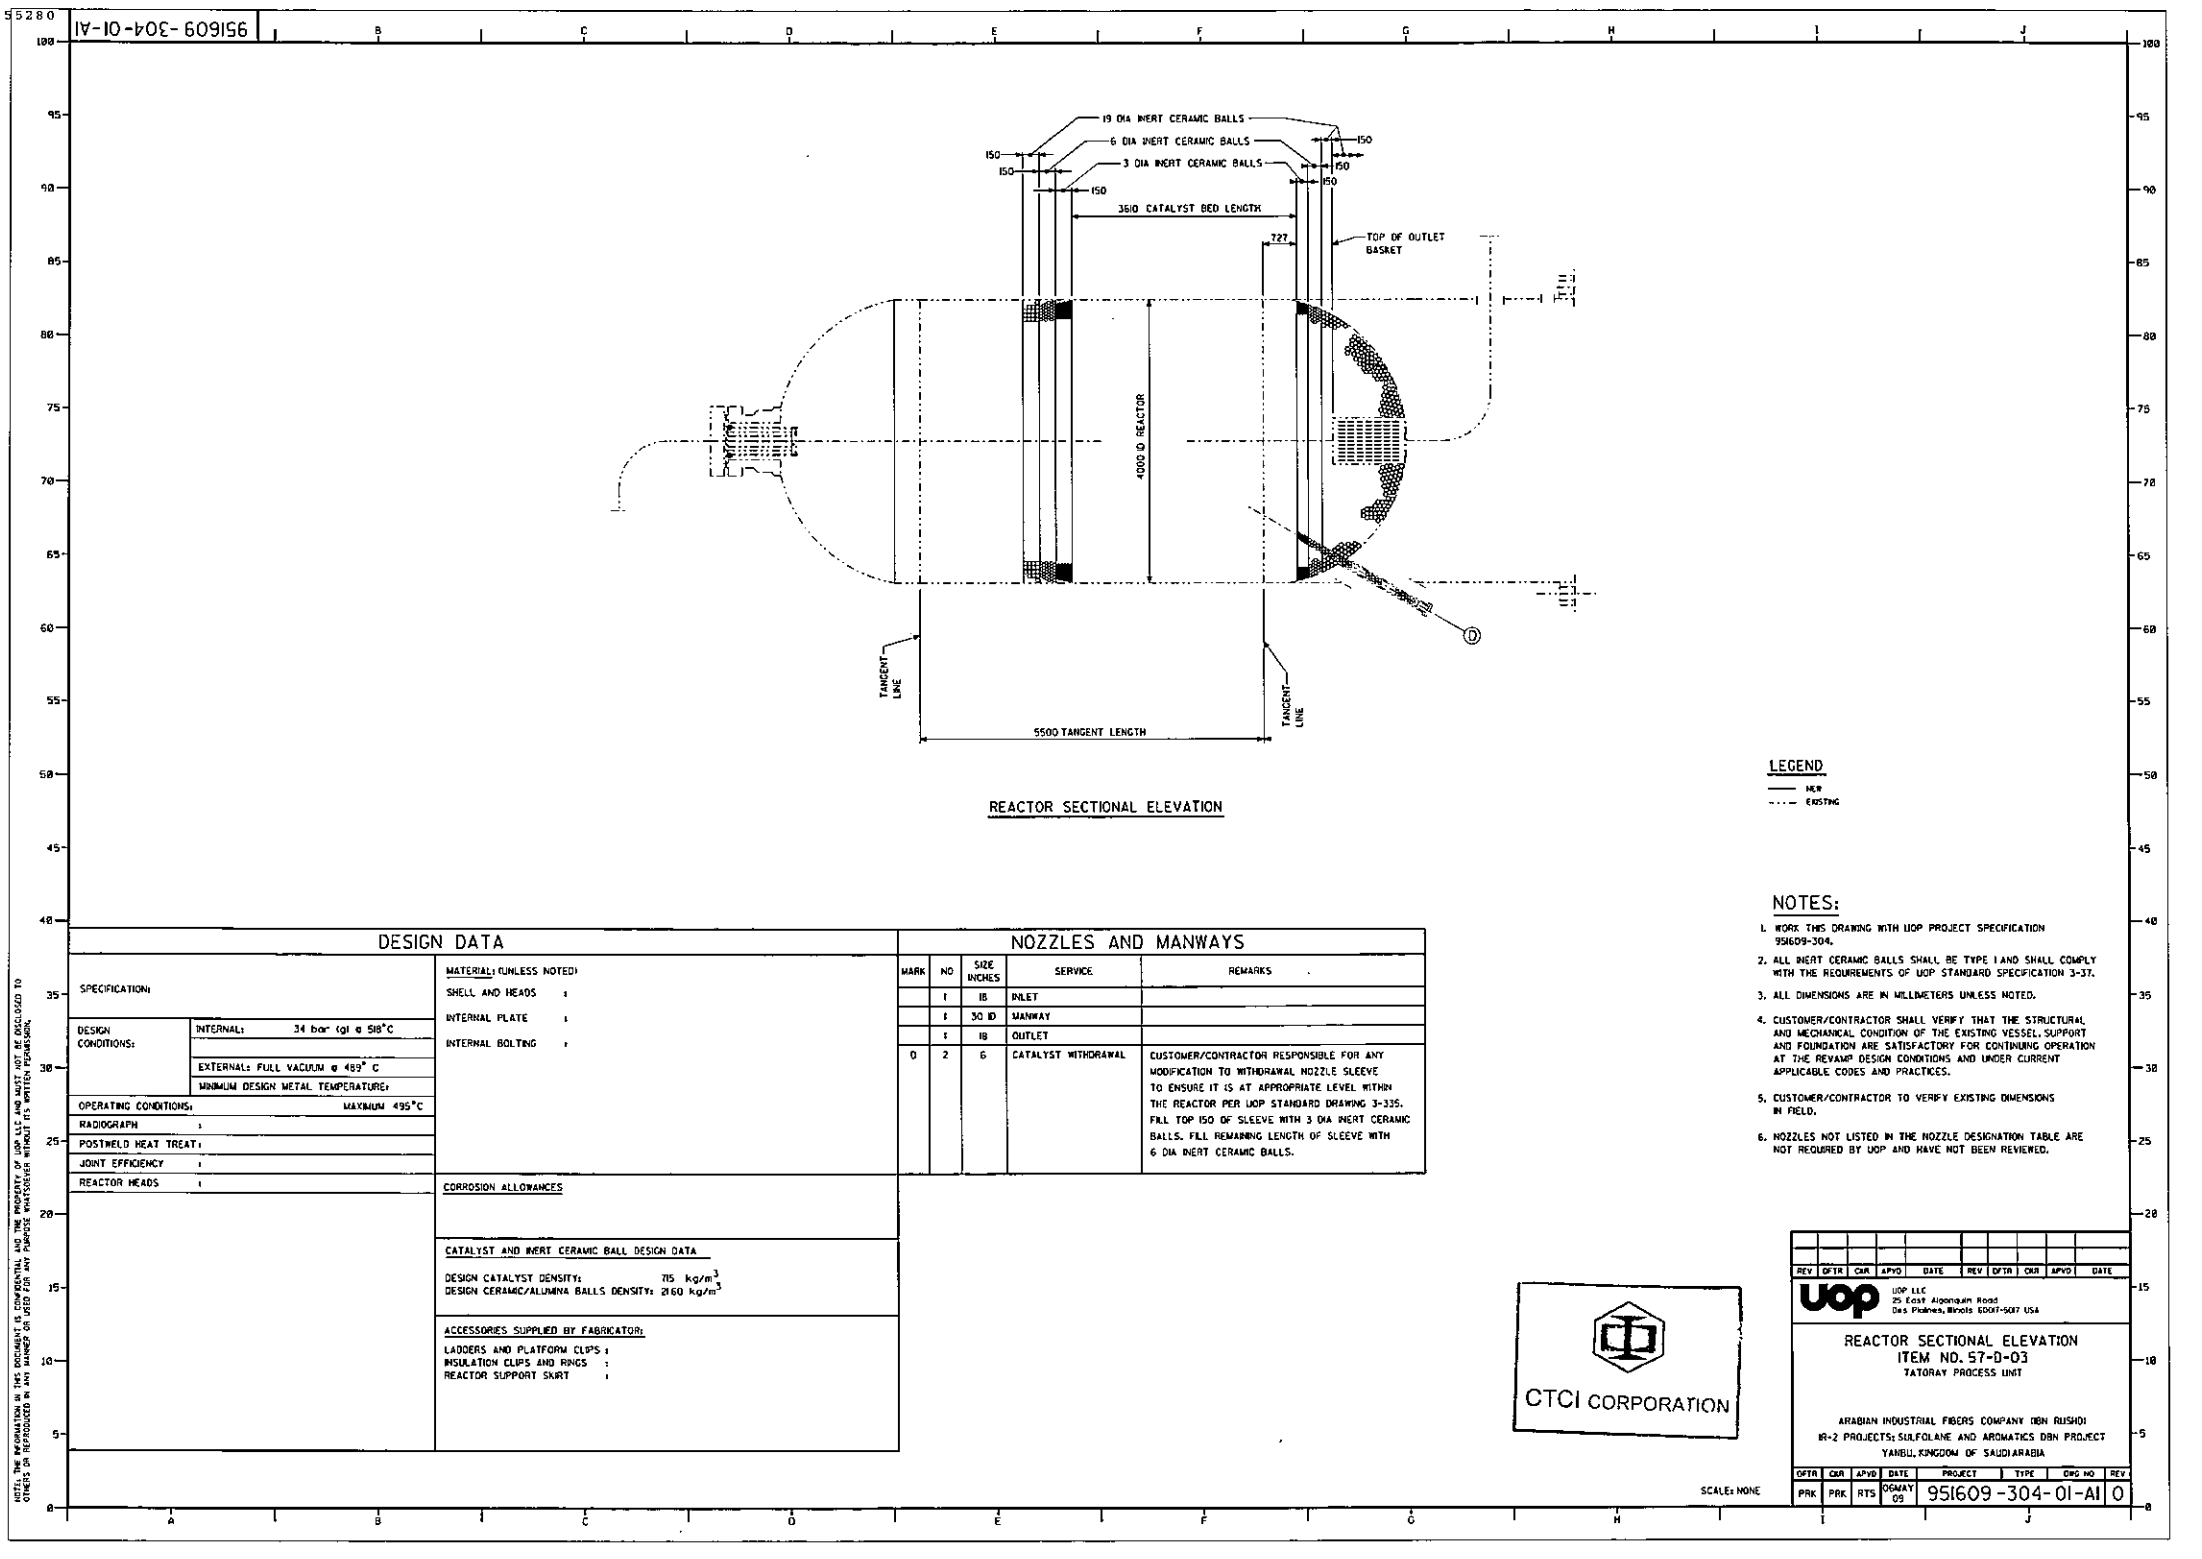

REACTOR SECTIONAL ELEVATION

LEGEND
— NEW
--- EXISTING

- NOTES:
1. WORK THIS DRAWING WITH UOP PROJECT SPECIFICATION 951609-304.
 2. ALL INERT CERAMIC BALLS SHALL BE TYPE I AND SHALL COMPLY WITH THE REQUIREMENTS OF UOP STANDARD SPECIFICATION 3-37.
 3. ALL DIMENSIONS ARE IN MILLIMETERS UNLESS NOTED.
 4. CUSTOMER/CONTRACTOR SHALL VERIFY THAT THE STRUCTURAL AND MECHANICAL CONDITION OF THE EXISTING VESSEL, SUPPORT AND FOUNDATION ARE SATISFACTORY FOR CONTINUING OPERATION AT THE REVAMP DESIGN CONDITIONS AND UNDER CURRENT APPLICABLE CODES AND PRACTICES.
 5. CUSTOMER/CONTRACTOR TO VERIFY EXISTING DIMENSIONS IN FIELD.
 6. NOZZLES NOT LISTED IN THE NOZZLE DESIGNATION TABLE ARE NOT REQUIRED BY UOP AND HAVE NOT BEEN REVIEWED.

DESIGN DATA

SPECIFICATION		MATERIAL (UNLESS NOTED)	
DESIGN CONDITIONS:		SHELL AND HEADS	
INTERNAL: 34 bar (g) @ 518°C		INTERNAL PLATE	
EXTERNAL: FULL VACUUM @ 489°C		INTERNAL BOLTING	
MINIMUM DESIGN METAL TEMPERATURE:			
OPERATING CONDITIONS: MAXIMUM 495°C			
RADIOGRAPH			
POSTWELD HEAT TREAT:			
JOINT EFFICIENCY			
REACTOR HEADS			
		CORROSION ALLOWANCES	
		CATALYST AND INERT CERAMIC BALL DESIGN DATA	
		DESIGN CATALYST DENSITY: 705 kg/m ³	
		DESIGN CERAMIC/ALUMINA BALLS DENSITY: 2160 kg/m ³	
		ACCESSORIES SUPPLIED BY FABRICATOR:	
		LADDERS AND PLATFORM CLIPS	
		INSULATION CLIPS AND RINGS	
		REACTOR SUPPORT SKIRT	


NOZZLES AND MANWAYS

MARK	NO	SIZE INCHES	SERVICE	REMARKS
	1	18	INLET	
	1	30 ID	MANWAY	
	1	18	OUTLET	
0	2	6	CATALYST WITHDRAWAL	CUSTOMER/CONTRACTOR RESPONSIBLE FOR ANY MODIFICATION TO WITHDRAWAL NOZZLE SLEEVE TO ENSURE IT IS AT APPROPRIATE LEVEL WITHIN THE REACTOR PER UOP STANDARD DRAWING 3-335. FILL TOP 150 OF SLEEVE WITH 3 DIA INERT CERAMIC BALLS. FILL REMAINING LENGTH OF SLEEVE WITH 6 DIA INERT CERAMIC BALLS.



REV	DATE	CHK	APVD	DATE	REV	DATE	CHK	APVD	DATE
UOP LLC 25 East Algonquin Road Des Plaines, Illinois 60018-5007 USA									
REACTOR SECTIONAL ELEVATION ITEM NO. 57-0-03 TATORAY PROCESS UNIT									
ARABIAN INDUSTRIAL FIBERS COMPANY (BEN RUSHO) IR-2 PROJECTS: SULFOLANE AND AROMATICS DBN PROJECT YANBU, KINGDOM OF SAUDI ARABIA									
DATE	CHK	APVD	DATE	PROJECT	TYPE	CHG NO	REV		
PRK	PRK	RTS	OGMAY 05	951609-304-01-AI	0				

SCALE: NONE

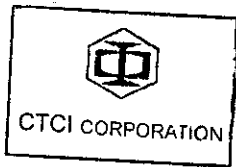

Revision
Indication



UOP LLC • 25 East Algonquin Road • Des Plaines, Illinois 60017-5017 • USA

REACTORS

PROJECT SPECIFICATION

932685 — 304

SHEET 1

REV	DATE	BY	APVD	REV	DATE	BY	APVD
0	03NOV06	SJS	JRG				

Tatoray Process Unit (Revamp)

Sheet

General Notes

2

List of Reactor Drawings

2

AS-BUILT

The information in this document is confidential and the property of UOP LLC and must not be disclosed to others or reproduced in any manner or used for any purpose whatsoever without its written permission.



Revision
Indication



UOP LLC • 25 East Algonquin Road • Des Plaines, Illinois 60017-5017 • USA

PROJECT SPECIFICATION

932685 — 304

SHEET 2

REACTORS

REV	DATE	BY	APVD	REV	DATE	BY	APVD
0	03NOV06	SJS	JRG				

General Notes

- Notes Applicable For Existing Reactor
- A. Customer/Contractor shall verify that the structural and mechanical condition of the existing reactor, support and foundation are satisfactory for continuing operation at the revamp design conditions and under current applicable codes and practices.
- B. Customer/Contractor to verify existing dimensions in field.
- C. Vacuum design is specified for reactor that can undergo a vacuum condition for the following scenarios:
1. Process fluid is allowed to cool.
 2. Vacuum condition during start-up or shutdown.

List of Reactor Drawings

For reactor details see the following UOP Drawings:

<u>Drawing Number</u>	<u>Revision</u>	<u>Title</u>
932685-304-01-A1	0	Reactor Sectional Elevation
932685-304-02-A1	0	Catalyst Withdrawal

List of Fabricator Drawings


The following drawings were used as reference material for UOP drawings 932685-304-01-A1 and 932685-304-02-A1:

<u>Fabricator</u>	<u>Drawing Number</u>	<u>Revision</u>	<u>Title</u>
OFFICINE LUIGI RESTA	4647	4	Tatoray Reactor Assembly
OFFICINE LUIGI RESTA	4647/A	0	Reactor Details
COSTACURTA	B.96.669	3	Removable Internals Tatoray Reactor

AS-BUILT

The information in this document is confidential and the property of UOP LLC and must not be disclosed to others or reproduced in any manner or used for any purpose whatsoever without its written permission.

New.

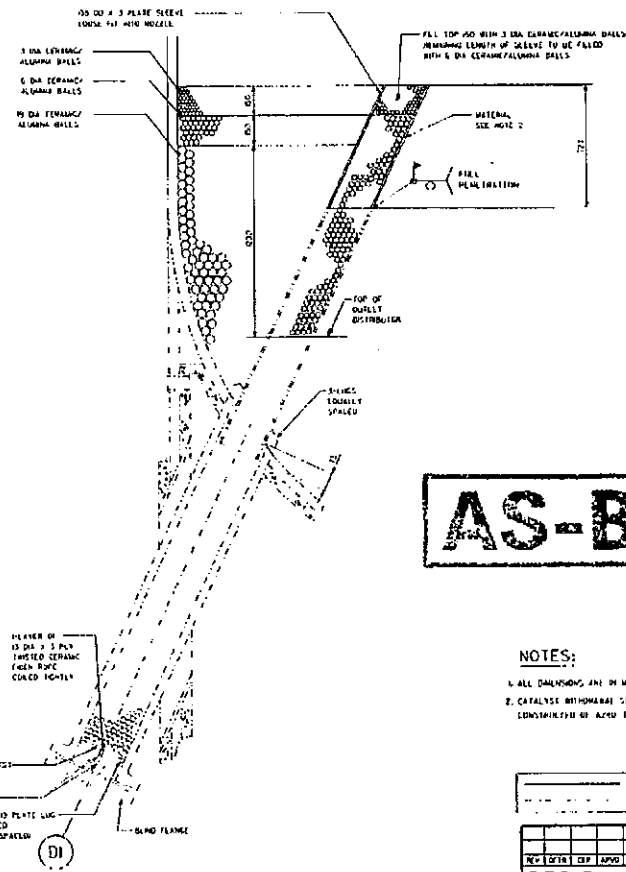


DETAIL B02
ALTERNATE 2

AS-BUILT

2. CATALYST WITH HOMOGENEOUS SYSTEM SHALL BE
CONSIDERED AS AERO TYPE 20.



NEW									
ENGINEING									
NEW	OTDR	CEP	APPO	DATE	NEW	OTDR	CEP	APPO	DATE
 UOP LLC 2500 West 40th Avenue, Suite 200 Fort Collins, Colorado 80521 USA									
CATALYST WITHDRAWAL									
ITEM NO. 57-0-03									
TATORY PROCESS UNIT									
BRANIFF INDUSTRIAL FIRING COMPANY, 4000 BRANIFF									
FABRIC, WICHITA, KS 67201									
DATE	CEP	APPO	DATE	PROJECT	TYPE	DATE	CEP	APPO	DATE
5-23	JAC	JAC	JAC	MOVING		9-26-85	-304-02	ALC	

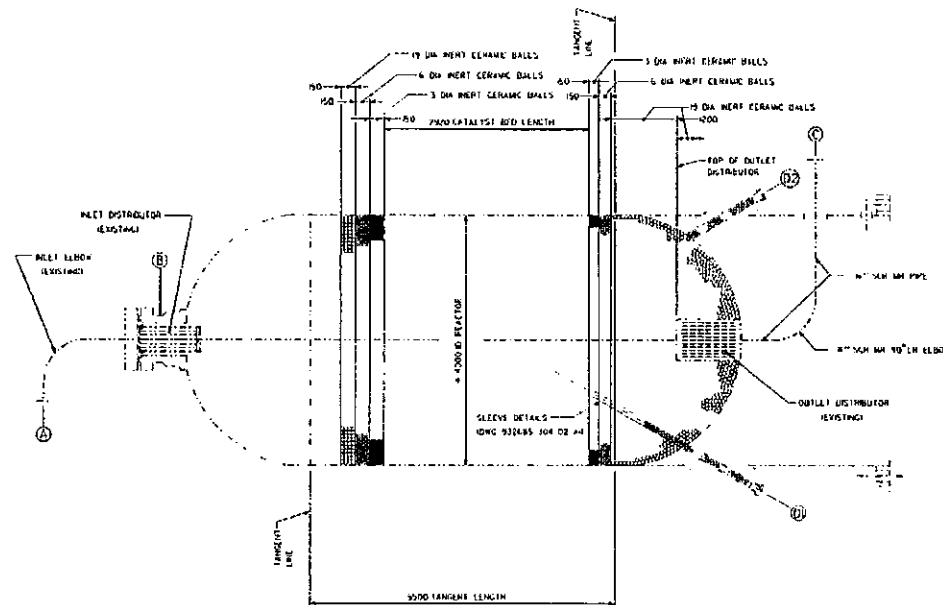

REACTOR SECTIONAL ELEVATION

AS-BUILT

DESIGN DATA

CODE: ASME SECTION VIII DIVISION 1

SPECIFICATION: UOP PROJECT SPECIFICATION 932685-304
UOP STANDARD SPECIFICATION 3-37, 3-11, 3-11

DESIGN CONDITIONS:

INTERNAL:	32.8 bar(g) @ 52°C (SEE NOTE 2)
EXTERNAL:	FULL VACUUM @ 142°C (SEE NOTE 2 AND 4)
MINIMUM DESIGN METAL TEMPERATURE:	9°C (SEE NOTE 2)

THICKNESS:

WELDED HEAT TREAT:	0
JOINT EFFICIENCY:	0
WELDING HEADS:	0

* SEE UOP PROJECT SPECIFICATION 932685-304 SHEET 2 FOR LIST OF FABRICATOR SUPPLIERS. VALUES ARE TAKEN FROM FABRICATOR UNIFORMS.

MATERIALS, UNLESS NOTED:

SHELL AND HEADS: 1.0

INTERNAL PLATE: 1.0

INTERNAL BOLTING: 1.0

CORROSION ALLOWANCE:

0

CATALYST AND INERT CERAMIC BALL GRIND DATA:

DESIGN CATALYST DENSITY: 700 kg/m³

DESIGN CERAMIC/ALUMINA BALLS DENSITY: 2500 kg/m³

ACCESSORIES SUPPLIED BY FABRICATOR:

LADDERS AND PLATFORM CLIPS: 1.0

WELDING CLIPS AND RINGS: 1.0

REACTION SUPPORT (SAMI): 1.0

NOZZLES AND MANWAYS

NAME	NO	SIZE	WELDES	SUPPLIER
A	1	0	WET	
B	1	0	WET	
C	1	0	WET	
D	1	0	CATALYST WITHDRAWAL	
E	1	0	WET CERAMIC BALL WITHDRAWAL	

ALL EXTERNAL CONNECTIONS SHALL BE ANSI CLASS 1500 FLANGES.

INERT CERAMIC BALL VOLUMES:

RAW ICE VOLUME:	3.8 m ³
WATER ICE VOLUME:	3.8 m ³
PLANT ICE VOLUME:	425.3 m ³

NOTES:

- ALL DIMENSIONS ARE IN MILLIMETERS UNLESS NOTED.
- SEE UOP PROJECT SPECIFICATION 932685-304 SHEET 2 NOTE A.
- ALL INERT CERAMIC BALLS SHALL COMPLY WITH THE REQUIREMENTS OF UOP STANDARD SPECIFICATION 3-37 AND TYPE L.
- SEE UOP PROJECT SPECIFICATION 932685-304 SHEET 2 NOTE B.

NEW
EXISTING



REV	DATE	BY	CHKD	DATE	BY	CHKD	DATE
1	10/10/00	1	1	10/10/00	1	1	10/10/00

UOP LLC
25 East Broadway Road
New Rochelle, NY 10801-4001 USA

REACTOR SECTIONAL ELEVATION
ITEM NO. 57-0-03
TATONAY PROCESS UNIT (TATONAY)

ARABIAN INDUSTRIAL FIBER COMPANY (AIFCO)
FABRIK KUDUMUD OF SAUDI ARABIA

DATE: 10/10/00
BY: 1
CHKD: 1
DATE: 10/10/00
BY: 1
CHKD: 1

SCALE: NONE



ARABIAN INDUSTRIAL FIBERS COMPANY

IR-II AROMATICS PROJECT

PROJECT NO. 10E0541A01

DOCUMENT TITLE:

REGENERATION GAS DRIER DATA SHEET

DOCUMENT NO:

DS-57-DA-512

THIS DOCUMENT CONTAINS CTCI CORPORATION CONFIDENTIAL INFORMATION OF A PROPRIETARY NATURE. THIS INFORMATION MUST NOT BE COPIED OR DISCLOSED IN WHOLE OR IN PART TO OUTSIDE PARTIES NOR USED FOR OTHER THAN THE PURPOSE FOR WHICH PROVIDED WITHOUT PERMISSION OF MANAGEMENT.
本文件所述及資料及文件皆為中鼎工程股份有限公司（中鼎）版權所有，未經得中鼎同意不得將其全部或部份翻印或轉授與第三者。

						ابن رشد ibn rushd	ARABIAN INDUSTRIAL FIBERS COMPANY YANBU, KINGDOM OF SAUDI ARABIA	CTCI CORPORATION
						CERTIFIED		
2	Revised As Marked	CAG	CMW	YSL	14-11-11	PROJ.		
1	Issued For Design	CAG	CBC	YSL	26-Apr-11	MGR _____ DATE _____		
0	Issue For Approval	CAG	CMW	YSL	9-Mar-11	CLIENT _____ DATE _____		
REV	DESCRIPTION	BY	CHK.	APPR.	DATE	PAGE 1 OF 2		XC32B-57-512

CONTENTS

<u>ITEM</u>	<u>EQUIPMENT NO.</u>	<u>SHEET NO.</u>	<u>REV. NO.</u>	<u>REV. DATE</u>
1.	57-D-12 A-C	1 THRU 2 OF 2	2	14-Nov.-2011

Attachment total 2 pages.

ابن رشيد
ibn rushd


VERTICAL VESSEL DATASHEET

Contract: 10E0541A01
Equip. No.: 57-D-12 A-C
Revision: 2 Date: 14-Nov.-2011
Unit: 57 - Tatoray
PO No.:
Document No. DS-57-DA-512
Sheet: 1 of 2



CLIENT: Arabian Industrial Fibers Company (Ibn Rushd)
SERVICE: Regeneration Gas Drier

PLANT: Tatoray
SITE: Yanbu, Kingdom of Saudi Arabia

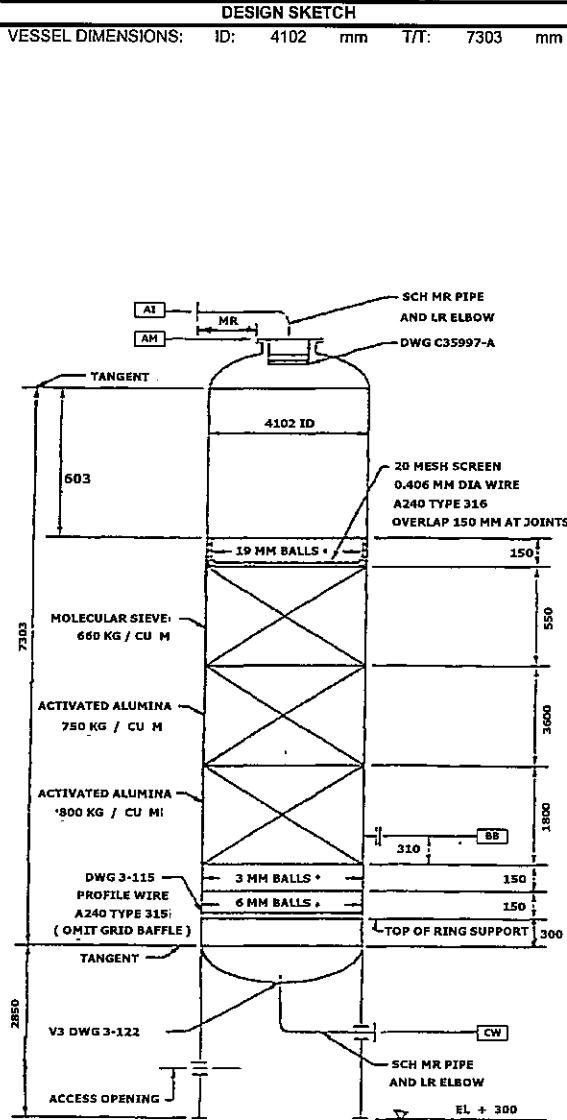

DESIGN CONDITIONS			
Pressure:	(Note 2)	bar(g)	at (Note 2) °C
Vacuum:	FV	bar(g)	at 260 °C
Min. Metal Temperature:	9 (Note 13)	°C	at MAWP bar(g)
Liquid Level:	EMPTY		
Specific Gravity of Liquid:	N/A	at	°C

OPERATING CONDITIONS			
Pressure:	(Note 3)	bar(g)	at (Note 3) °C
Vacuum:		bar(g)	at °C
Low Temperature:		°C	at °C
Hydrogen Partial Press.		bar(g)	at °C

INTERNALS & INSULATION			
DESCRIPTION	Bulk Density kg/cm3	Liquid Holdup vol%	Pressure Drop bar
Packing:			
Catalyst:			
Mist Eliminator:			
Insulation	Hot ☒ Cold ☐		
Fire Proofing	Yes ☐ No ☐		

CONSTRUCTION		
	Materials	Corrosion Allowance
Shell:	SA-516-70	3 mm
Head	SA-516-70	3 mm
Body flange		mm

SPECIAL CONDITIONS			
Stress Relieve (Process Reason Only):	Yes ☐ No ☐		
Vessel in Wet Sour Service:	Yes ☐ No ☐		
Steamout Required:	Yes ☐ No ☒		

See Notes on Page 2

FLUOR'S OPINION OF THE ESTIMATED MECHANICAL WEIGHTS (kg)	
FABRICATED	
EMPTY	
OPERATING	
FULL OF WATER	
FLUOR'S OPINION OF THE ESTIMATED WALL THICKNESS (mm)	
TOP HEAD	
SHELL	
BTM HEAD	
LEG	



CHIYODA CORPORATION

FOR RECORD

CLIENT : IBN RUSHD
PROJECT : PTA & AROMATICS -
TITLE : AROMATICS
JOB NO. : 51046
DOC. NO. : 05-51-D-212. (1/1)

REVISIONS			
MARK	DATE	BY	APP'D
APRD	15-11-95	MAG	MA6
CHKD	15-11-95	MAG	MA6
MADE	15-11-95	MAG	MA6
DATE	15-11-95	DATE	15-11-95

PROJECT SPECIFICATION			
550689 - 301 - 2 SHEET 14			
REV	DATE	BY	APP'D
0	15-11-95	MAG	MA6
1	15-11-95	MAG	MA6
2	15-11-95	MAG	MA6

SERVICE	RECYCLE GAS DRIERS (THREE REQUIRED)	ITEM NO	51-D-12AB 51-D-12AB
---------	-------------------------------------	---------	--------------------------------

Design Conditions at Top	INT NOTE-C	* °C (°F) BY CONTRACTOR
Operating Conditions	EXT FULL VACUUM #210°C (2)	
	Normal	35°C
	Regeneration	250°C

Radiograph	HR
Postweld Heat Treat	HR
Joint Efficiency	HR %
Material Specifications	
Heads	SA516-70
Shell	SA516-70


Shell	Thickness	Corrosion Allowed by Code-mm. (Min)
		3
Heads		3

Vessel Heads	
Top Head	2:1 ELLIPTICAL
Bottom Head	2:1 ELLIPTICAL
Accessories Applied by Fabricator	
Ladder & Platform Clips	AS REQUIRED (M)
Insulation Clips & Rings	YES
Vessel Support	YES

Nozzles and Manways			
Mark	No	Size Inches	Service
AI	1	20	INLET
AM	1	30	MANWAY (*)
BB	1	24	MANWAY
CV	1	20	OUTLET

Class - ANSI CL150	(*) SHEET 2-NOTE A
Facing - RAISED FACE	
Normal Liquid Level - EMPTY	
Specific Gravity - N/A	

SCHEMATIC ELEVATIONS OF BED SUPPORT MATERIALS MAY NOT BE REPRESENTATIVE OF ACTUAL DIMENSIONS.



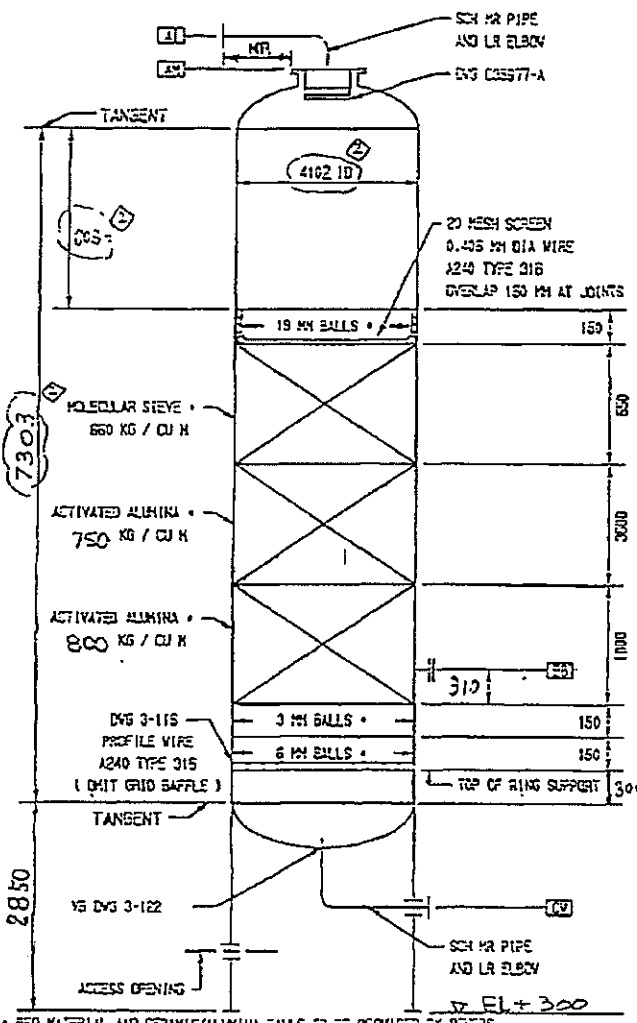


NOTES: 1) DESIGN CONDITIONS: NORMAL * 11.1 BAR (G) * 123 DEGREE C.
REGENERATION * 8.0 BAR (G) * 230 DEGREE C.






Drawings Referred to in this Specification

3-116-4 3-122-0 K25377-A-0

509160 41

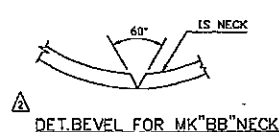
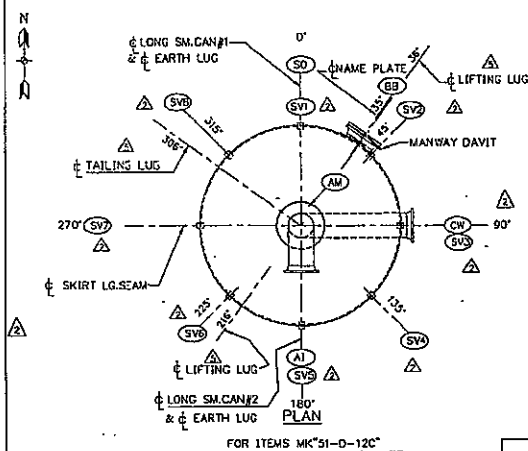
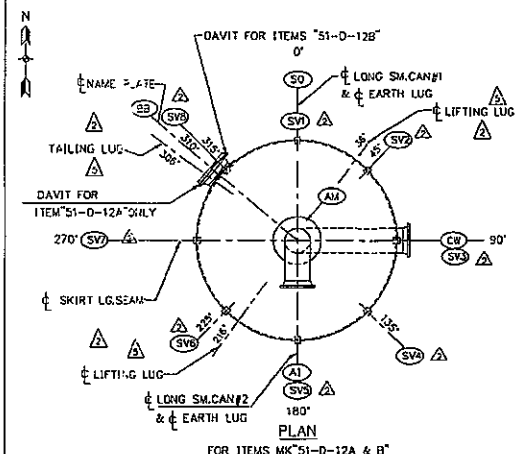


SYL-B	8	4"	SKIRT VENT	SOH4	1 1/2"	1"	3/4"	1/2"	3/8"	1/4"	3/16"	1/8"	1/16"	DETAIL SH1F4	4 1/2"	SYL
SO	1	2 1/2"	SKIRT OPNG	PL 15	1"	3/4"	1/2"	3/8"	1/4"	3/16"	1/8"	1/16"	DETAIL SH1F4	2 1/2"	SO	
SL	1	2 1/2"	SLEEVE AT CW	PL 16	1"	3/4"	1/2"	3/8"	1/4"	3/16"	1/8"	1/16"	DETAIL SH1F4	3 3/4"	SL	
CW	1	20"	OUTLET	PL 16	SEE ELEV.	1"	3/4"	1/2"	3/8"	1/4"	3/16"	1/8"	DETAIL SH1F2	20 1/2"	CW	
BB	1	24"	150RWFN	PL 127	7"-9 1/4"	1 1/2"	1"	3/4"	1/2"	3/8"	1/4"	3/16"	5.6,7,8,9,10	W/BLIND F.L.C.	BB	
AM	1	30"	150RWFN	PL 127	SEE ELEV.	1"	3/4"	1/2"	3/8"	1/4"	3/16"	1/8"	DETAIL SH1F2	W/BL 6547 SRES	AM	
AI	1	20"	150RWFN	INLET	SOH4	SEE ELEV.	1"	3/4"	1/2"	3/8"	1/4"	3/16"	DETAIL SH1F2	30"	AI	
MARK	REQD.	SIZE	RATING	SERVICE	Q. MARK ON BOX	Q. MARK	Q. MARK	Q. MARK	Q. MARK	Q. MARK	Q. MARK	Q. MARK	Q. MARK	REMARKS	Q.D. NECK	
NOZZLE SCHEDULE																
[DETAILS PRODUCTION IS FROM THE LOWER PORT.]																
[BILL OF MATERIAL ITEM NUMBERS]																

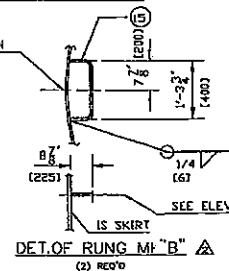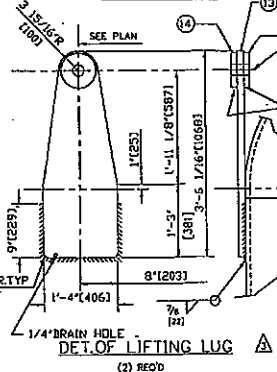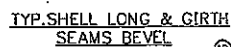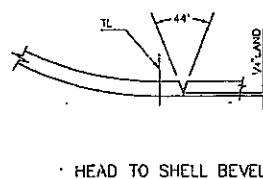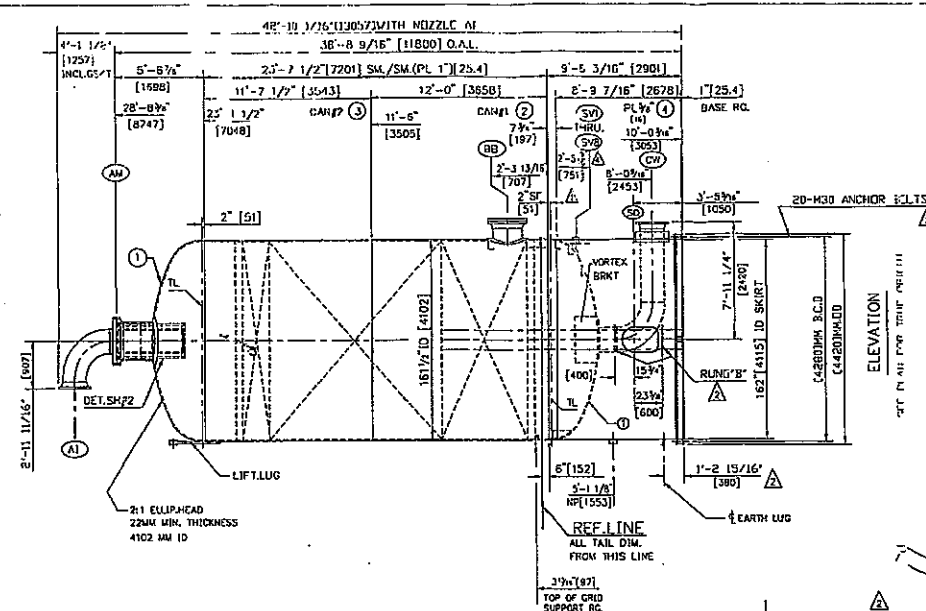

BILL OF MATERIAL							(FOR THREE UNITS)	
ITEM NO.	UNIT QTY	LOT QTY	DESCRIPTION	MATERIAL	REMARKS	PART NAME		
XXXXXXXXXXXXXXXXXXXXXXXXXXXX								
1	2	6	2 1/2" METAL HIK. X 1 1/4" 1/2" ID COOF 2-1 LIP RENTAL HEAD W/ 2" SP.	SA-516-70		HEADS		
2	1	3	2 1/2" X 1 1/4" X 5/16" 1/2" LG.	SA-516-70	SEE LIST FOR SHIP DESIGN DATA			
3	1	3	2 1/2" X 1 1/4" X 5/16" 1/2" LG.	SA-516-70		CAN/SFZ		
4	1	3	2 1/2" X 1 1/4" X 5/16" 1/2" LG.	SA-516-70		CAN/SFZ		
5	1	3	2 1/2" X 1 1/4" X 5/16" 1/2" LG.	SA-516-70		SCCAN		
6	1	3	2 1/2" X 1 1/4" X 5/16" 1/2" LG.	SA-105		BB FLG.		
7	1	3	2 1/2" X 1 1/4" X 5/16" 1/2" LG.	SA-105		BB BLD		
8	1	3	2 1/2" X 1 1/4" X 5/16" 1/2" LG.	SA-516-70		BB NCOB		
9	1	3	2 1/2" X 1 1/4" X 5/16" 1/2" LG.	SA-516-70		BB PAD		
10	22	66	1 1/4" X 1 1/4" X 5/16" 1/2" LG. STUDS W/ (2) HYV. HKS. NUT EACH	SA-193-B7 SA-194-24	(6) SHIPLOOSE	STUDS NUTS		
11			DELETED					
12	2	6	P. 1/2" X 1 1/2" X 5 3/4" LG.	SA-240-304		EARTH W		
13	2	6	P. 1/2" X 1 1/2" X 4 1/2" LG.	SA-316-70 R.		LIFT. LUG		
14	4	12	PL 1/8" X 7 1/8" 00 X 3 5/8" ID	SA-516-70		LIFT. WELD		
15	2	6	BAR 3/4" X 2-9 1/2" LG.	SA-516-70		50 RING		

** 125-250 RMS (3.2-6.3MICRON) FLANGE FINISH
MAX.CARBON CONTENT OF CARBON STEELS SHALL BE LIMITED TO 0.25%
ALL DIMENSIONS SHOWN IN BRACKETS ARE IN MILLIMETERS

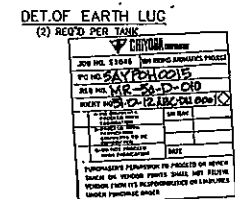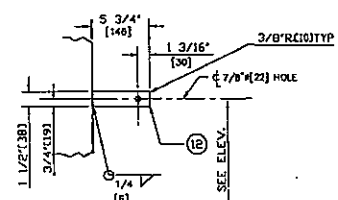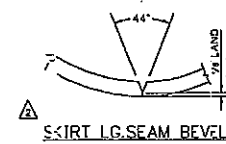

CERTIFIED
BY: D. Hesse
DATE: 6-9-97

[illegible]

010072



ARABIAN INDUSTRIAL FIBERS COMPANY

IR-II AROMATICS PROJECT

PROJECT NO. 10E0541A01

DOCUMENT TITLE:

BENZENE COLUMN DATA SHEET

DOCUMENT NO:


DS-58-CA-501

						ابن رشد ibn rushd	ARABIAN INDUSTRIAL FIBERS COMPANY YANBU, KINGDOM OF SAUDI ARABIA	CTCI CORPORATION
						CERTIFIED		
1	Issued For Design	CAG	CMW	YSL	31-Mar-11	PROJ. MGR	S P L for	DATE 3/31/11
0	Issue For Approval	CAG	CMW	YSL	9-Mar-11	CLIENT		DATE
REV	DESCRIPTION	BY	CHK.	APPR.	DATE	PAGE 1 OF 2		XC32A-58-501

CONTENTS

<u>ITEM</u>	<u>EQUIPMENT NO.</u>	<u>SHEET NO.</u>	<u>REV. NO.</u>	<u>REV. DATE</u>
1.	58-C-01	1 THRU 2 OF 2	1	31-Mar.-2011

Attachment total 1 page.

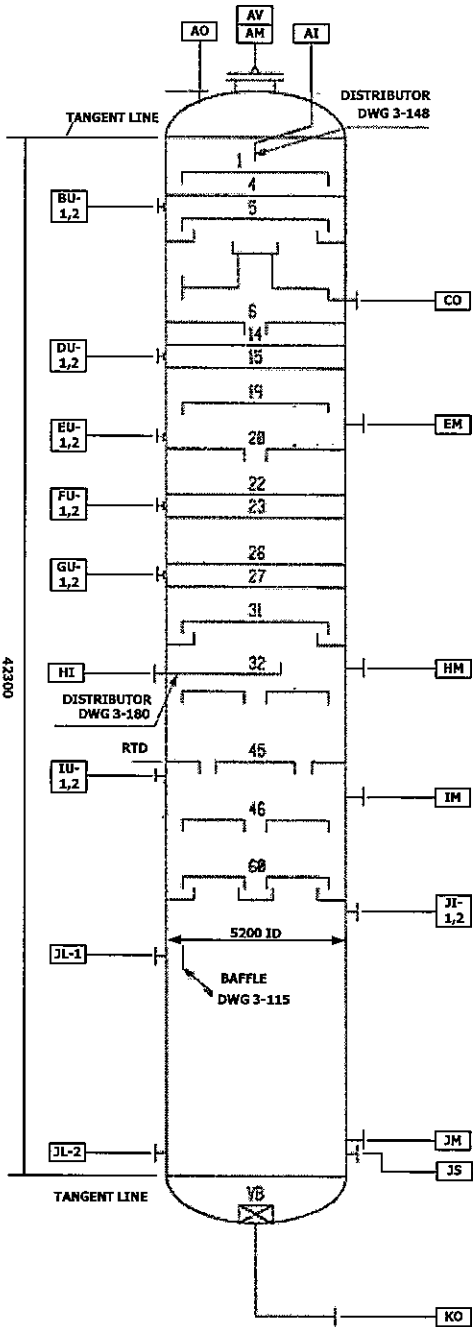ابن رشيد ibn rushd	COLUMN DATASHEET	Contract: 10E0541A01 Equip. No.: 58-C-01 Revision: 1 Date: 31-Mar.-2011 Unit: 58 - BT Fractionation PO No.: Document No.: DS-58-CA-501 Sheet: 1 of 2	سابك sabik  CTCI CORPORATION																								
Client: Arabian Industrial Fibers Company Service: Benzene Column		Plant: BT Fractionation Site: Yanbu, Kingdom of Saudi Arabia																									
DESIGN SKETCH		DESIGN CONDITIONS																									
VESSEL DIMENSIONS ID: 5200 mm T/T: 42300 mm		Pressure: 3.5 bar(g) at 179 °C Vacuum: FV bar(g) at 151 °C Min. Metal Temp: 9 °C at MAWP bar(g) Liquid Level: Note1 mm Specific Gravity of Liquid: 0.751 at °C																									
		OPERATING CONDITIONS																									
		Pressure: Note 2 bar(g) at Note 2 °C Vacuum: - bar(g) at - °C Low Temperature: - °C at - °C Hydrogen Partial Press. - bar(a) at - °C																									
		INTERNALS & INSULATION																									
		<table border="1" style="width: 100%; border-collapse: collapse;"> <thead> <tr> <th>DESCRIPTION</th> <th>Bulk Density kg/m³</th> <th>Liquid Holdup vol%</th> <th>Pressure Drop bar</th> </tr> </thead> <tbody> <tr> <td>Packing:</td> <td></td> <td></td> <td></td> </tr> <tr> <td>Catalyst:</td> <td></td> <td></td> <td></td> </tr> <tr> <td>Mist Eliminator:</td> <td></td> <td></td> <td></td> </tr> <tr> <td>Insulation</td> <td>40/50 mm</td> <td>Hot ☒ Cold ☐</td> <td></td> </tr> <tr> <td>Fire Proofing</td> <td>76 mm</td> <td>Yes ☒ No ☐</td> <td></td> </tr> </tbody> </table>		DESCRIPTION	Bulk Density kg/m³	Liquid Holdup vol%	Pressure Drop bar	Packing:				Catalyst:				Mist Eliminator:				Insulation	40/50 mm	Hot ☒ Cold ☐		Fire Proofing	76 mm	Yes ☒ No ☐	
		DESCRIPTION	Bulk Density kg/m³	Liquid Holdup vol%	Pressure Drop bar																						
Packing:																											
Catalyst:																											
Mist Eliminator:																											
Insulation	40/50 mm	Hot ☒ Cold ☐																									
Fire Proofing	76 mm	Yes ☒ No ☐																									
CONSTRUCTION																											
<table border="1" style="width: 100%; border-collapse: collapse;"> <thead> <tr> <th></th> <th>Materials</th> <th>Corrosion Allowance</th> </tr> </thead> <tbody> <tr> <td>Shell:</td> <td>SA-516-60</td> <td>3 mm</td> </tr> <tr> <td>Heads</td> <td>SA-516-60</td> <td>3 mm</td> </tr> <tr> <td>Support</td> <td></td> <td>mm</td> </tr> </tbody> </table>			Materials	Corrosion Allowance	Shell:	SA-516-60	3 mm	Heads	SA-516-60	3 mm	Support		mm														
	Materials	Corrosion Allowance																									
Shell:	SA-516-60	3 mm																									
Heads	SA-516-60	3 mm																									
Support		mm																									
SPECIAL CONDITIONS																											
Stress Relieve (Process Reason Only): Yes ☐ No ☐ Vessel in Wet Sour Service: Yes ☐ No ☐ Steamout Required: Yes ☒ No ☐																											
(kg)																											
EMPTY OPERATING FULL OF WATER																											
(mm)																											
TOP HEAD SHELL / TRANSITION BTM HEAD SKIRT																											

CTCI CORPORATION

[illegible]



ARABIAN INDUSTRIAL FIBERS COMPANY

IR-II AROMATICS PROJECT

PROJECT NO. 10E0541A01

DOCUMENT TITLE:

CLAY TREATERS

DOCUMENT NO:

DS-58-DA-504

						ابن رشد ibn rushd	ARABIAN INDUSTRIAL FIBERS COMPANY YANBU, KINGDOM OF SAUDI ARABIA	CTCI CORPORATION
3	Revised as Marked	WCC	CMW.	YSL	14-Feb-11	CERTIFIED		
2	Revised as Marked	WCC	CMW	YSL	11-Aug-11	PROJ.		
1	Issued for Design	WCC	CMW	YSL	26-Apr-11	MGR _____ DATE _____		
0	Issue For Approval	WCC	CMW	YSL	9-Mar-11	CLIENT _____ DATE _____		
REV	DESCRIPTION	BY	CHK.	APPR.	DATE	PAGE 1 OF 2		XC32B-58-504

 ابن رشد سابق ابن رشد سابق CTCI CORPORATION	CLAY TREATERS DATA SHEET		XC32B-58-504	
			2 OF 2	DATE 14-Nov.-2011
				REV. 3

CONTENTS

<u>ITEM</u>	<u>EQUIPMENT NO.</u>	<u>SHEET NO.</u>	<u>REV. NO.</u>	<u>REV. DATE</u>
1.	58-D-04A/B	1 THRU 2 OF 2	3	14-Nov.-2011

ابن رشيد
ibn rushd

FLUOR

VERTICAL VESSEL
DATASHEET

Contract: 10E0541A01

Equip. No.: 58-D-04 A/B

Revision: 3

Date: 14-Nov.-2011

Unit: 58 - Benzene Toulene Fract

PO No.:

Document No. DS-58-DA-504

Sheet: 1 of 2

سابك
sabik



CTCI CORPORATION

REV

Client: Arabian Industrial Fibers Company (Ibn Rushd)


Service: Clay Treaters

Plant: Benzene Toulene Fract

Site: Yanbu, Kingdom of Saudi Arabia

DESIGN SKETCH

VESSEL DIMENSIONS: ID: 2400 mm T/T: 10100 mm

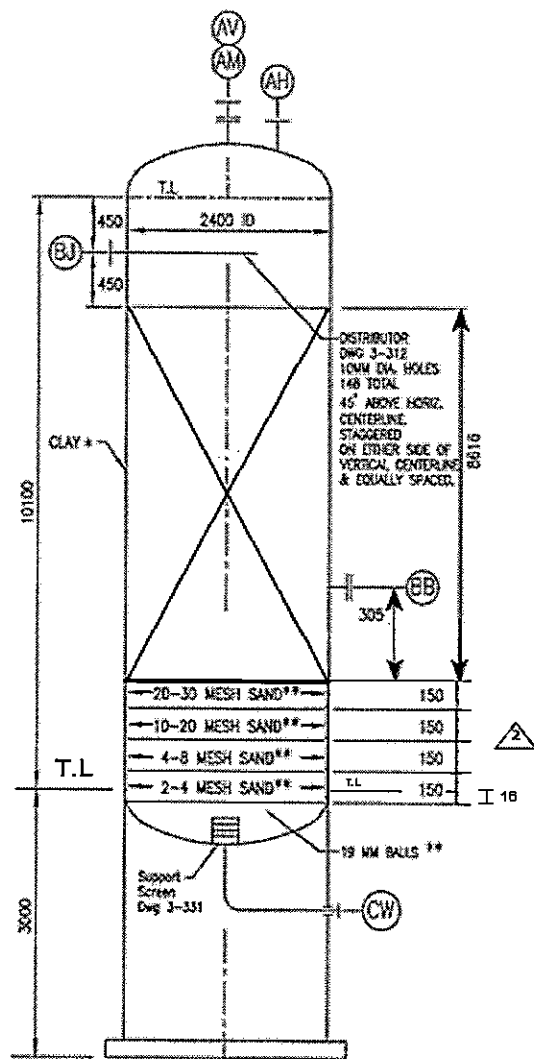

* BED MATERIAL, SEE PROJECT SPEC 106.

** MESH CERAMIC BALLS
TYPE 1, SEE STD SPEC 3-37
SAND, SEE STD SPEC 3-38

DESIGN CONDITIONS

Pressure:	30.0	bar(g)	at	230	°C
Vacuum:	FV	bar(g)	at	199	°C
Low Temperature:	6	°C	at	MAWP	bar(g)
Liquid Level:	Note 4				
Specific Gravity of Liquid:	0.731		at	199	°C

OPERATING CONDITIONS

Pressure: Top	16.7	bar(g)	at	199	°C
Bottom		bar(g)	at	193	°C
Vacuum:		bar(g)	at		°C
Low Temperature:		°C	at		°C
Hydrogen Partial Press.		bar(g)	at		°C

INTERNALS & INSULATION

DESCRIPTION	Bulk Density kg/m³	Liquid Holdup vol%	Pressure Drop bar
Packing:			
Catalyst:			
Mist Eliminator:			
Insulation	50 mm	Hot ☒ Cold ☐	
Fire Proofing		Yes ☐ No ☐	

CONSTRUCTION

	Materials	Corrosion Allowance
Shell:	SA-516-70N(K.C.S)	3 mm
Heads	SA-516-70N(K.C.S)	3 mm
Lining/Cladding:		mm

SPECIAL CONDITIONS

Stress Relieve (Process Reason Only):	Yes ☐ No ☒
Vessel in Wet Sour Service:	Yes ☐ No ☒
Steamout Required:	Yes ☐ No ☒

See Notes on Page 2

THE ESTIMATED MECHANICAL WEIGHTS (kg)

FABRICATED	30900
EMPTY	42900
OPERATING	154000
FULL OF WATER	89600

THE ESTIMATED WALL THICKNESS (mm)

TOP HEAD	30
SHELL	31
BTM HEAD	31
SKIRT	12

ابن رشد ibn rushd FLUOR.		VERTICAL VESSEL DATASHEET		Contract: 10E0541A01 Equip. No.: 58-D-04 A/B Revision: 3 Date: 14-Nov-2011 Unit: 58 - Benzene Toulene Fract PO No.: Document No. DS-58-DA-504 Sheet: 2 of 2		سابك sabik  CTCI CORPORATION		REV
NOZZLE SCHEDULE								
1	Tag	Qty.	Size in	Pressure Rating	Description			
2								
3								
4	AH	1	4	300# RFWN	Relief	3		
5	AM	1	24	300# RFWN	Manway w/ davit			
6	AV	1	2	300# RFLWN	Vent			
7	BB	1	24	300# RFWN	Manway w/ davit			
8	BJ	1	4	300# RFWN	Inlet			
9	CW	1	4	300# RFWN	Outlet			
10								
11								
38	NOTES:							
39	1 Two vessels required, mk. no. 58-D-04A & 58-D-04B and are designed to ASME Section VIII, Div. 1.						0	
40	2 Estimated thickness listed in sheet 1 are estimate based on the ASME code requirements and are meant to be used for quotation purposes only.						2	
41	3 Vessel heads are 2:1 Elliptical.							
42	4 Vessel shall have Normal Liquid Level (NLL) of full capacity.							
43	5 Schematic elevations of bed support materials may not be representative of actual dimensions. The layer/s of bed support material may be below the bottom tangent line for large diameter vessels.							
44	6 Paint coating shall be in accordance with SES-PCS-15 (Insulated part) and SES-PCS-4 (Non-insulated protruding part).							
45	7 Applicable specifications: SP-000-AA-5002, 22854-SP-000-A-003, 22854-SP-000-A-004, 22854-SP-000-D-001, 22854-SP-000-W-001, 22854-SP-000-W-002, 22854-SP-000-W-003, P01-E07, T01-S01, 3-11.							
46	8 Insulation support rings are required.							
47	9 Following UOP specifications / standards apply: 3-11, 3-37, 3-38, 3-312 and 3-331.							
48	10 ASME Code stamp is required.							
49	11 New, Skirt 3000 mm. Catalyst-Initial inventory is adequate for the initial fill of the two clay treaters plus an additional equal amount to be kept available for spent clay replacement. It is intended that the initial inventory of catalyst/chemical be filled/replaced prior to startup.						0	
50	12 The clay quantity is 39 m ³ / Treater.						2	
51								
52								
ARABIAN INDUSTRIAL FIBERS COMPANY

IR-II AROMATICS PROJECT

PROJECT NO.10E0541A01

DOCUMENT TITLE:

REFORMATE SPLITTER REBOILER DATA SHEET

DOCUMENT NO:

DS-56-BA-501

						ابن رشد ibn rushd	ARABIAN INDUSTRIAL FIBERS COMPANY YANBU, KINGDOM OF SAUDI ARABIA	CTCI CORPORATION
						CERTIFIED		
2	Revised As Marked	CAG	SYL	YSL	11-Aug-11	PROJ.		
1	Issued For Design	CAG	SYL	YSL	27-May-11	MGR	DATE	
0	Issue For Approval	CAG	SYL	YSL	23-Mar-11	CLIENT	DATE	
REV	DESCRIPTION	BY	CHK.	APPR.	DATE	PAGE 1 OF 2	XC33D-56-501	

CONTENTS

<u>ITEM</u>	<u>EQUIPMENT NO.</u>	<u>SHEET NO.</u>	<u>REV. NO.</u>	<u>REV. DATE</u>
1.	56-B-01	1 THRU 5 OF 5	2	11-Aug.-2011

Attachment total 13 pages.

ابن رشد سابك
 asbia ibn rushd



REFORMATE SPLITTER REBOILER
DATA SHEET

XC33D-56-501

2 OF 2

DATE	11-Aug.-2011
REV.	2

1	Client: Arabian Industrial Fibers Company (Ibn Rushd)	Vendor: Existing Born Heater - Revamped for New Service	
2	Service: Reformate Splitter Reboiler	Plant: Sulfolane	Site: Yanbu, Saudi Arabia
3	Type of Heater: Vertical Cylindrical	Vendor: Existing Born Heater	
4	Total Heater Absorbed Duty: 18.04 MW	Assembly:	
5	PROCESS DESIGN CONDITIONS		
6	* OPERATION CASE	REVAMP	
7	HEATER SECTION	Radiant/Convec	
8	SERVICE	See Line 2	
9	HEAT ABSORPTION MW	18.04	
10	FLUID NAME	Hydrocarbon	
11	FLOW RATE kg/hr	1,133,981	
12	FLOW RATE B.P.D.		
13	PRESSURE DROP - ALLOWABLE (CLEAN / FOULED) bar	1.9	
14	PRESSURE DROP - CALCULATED (CLEAN / FOULED) bar		
15	FOULING ALLOWANCE m ² .°C/W		
16	THERMAL CONDUCTIVITY OF COKE/SCALE W/m.°C		
17	COKING ALLOWANCE mm		
18	AVG. RADIANT SECTION FLUX DENSITY - ALLOWABLE W/m ²		
19	AVG. RADIANT SECTION FLUX DENSITY - CALCULATED W/m ²		
20	MAX. RADIANT SECTION FLUX DENSITY W/m ²		
21	CONVECTION SECTION FLUX DENSITY, (BARE TUBE) W/m ²		
22	VELOCITY LIMITATION m/s		
23	PROCESS FLUID MASS VELOCITY kg/s.m ²		
24	MAX. ALLOWABLE / CALCULATED INSIDE FILM TEMPERATURE °C		
25	INLET CONDITIONS:		
26	TEMPERATURE °C	204	
27	PRESSURE ☒ bar (g) ☐ bar (g)	4.67	
28	LIQUID FLOW kg/hr	1,133,981	
29	VAPOR FLOW kg/hr	0	
30	DENSITY - LIQUID kg/m ³	697.9	
31	VAPOR MOLECULAR WEIGHT		
32	VISCOSITY - (LIQUID / VAPOR) mPa-s	0.217	
33	SPECIFIC HEAT - (LIQUID / VAPOR) kJ/kg.°C	2.451	
34	THERMAL CONDUCTIVITY - (LIQUID / VAPOR) W/m.°C	0.102	
35	OUTLET CONDITIONS:		
36	TEMPERATURE °C	215	
37	PRESSURE ☒ bar (g) ☐ bar (g)	2.77	
38	LIQUID FLOW kg/hr	1,015,480	
39	VAPOR FLOW kg/hr	118,501	
40	DENSITY - LIQUID kg/m ³	684.8	
41	VAPOR MOLECULAR WEIGHT	114.2	
42	VISCOSITY - (LIQUID / VAPOR) mPa-s	0.207 0.010	
43	SPECIFIC HEAT - (LIQUID / VAPOR) kJ/kg.°C	2.498 1.985	
44	THERMAL CONDUCTIVITY - (LIQUID / VAPOR) W/m.°C	0.101 0.025	
45	REMARKS AND SPECIAL REQUIREMENTS:		
46	DISTILLATION DATA OR FEED COMPOSITION:		See Fluid Properties on Sheets 3 and 4
47	SHORT TERM OPERATING CONDITIONS:		
48	OTHER:		
49	NOTES:		
50	See Notes on Sheet 5		
51			
52			
53			
54			
55			
56			
57			
58			
59			
60			
61			
62			

55401

**FIRED HEATER
DATA SHEET**

Contract: 10E0541A01
Equipment No.: 56-B-01
Revision: 2 Date: 11-Aug.-2011
Unit: 56 - Sulfolane
P.O. No.:
Document No.: DS-56-BA-501
Sheet: 3 of 5

FLUID PROPERTIES:														REV	
PROCESS															
Thermodynamic condition			Vapor					Liquid							
Pressure bar(a)	Temp °C	Weight fraction vapor	Enthalpy kJ/kg	Density kg/m³	Specific heat kJ/kg·°C	Viscosity cP	Thermal cond. W/m·°C	Enthalpy kJ/kg	Density kg/m³	Specific heat kJ/kg·°C	Viscosity cP	Thermal cond. W/m·°C	Surface tension dyne/cm		
3.771	203.89	0.0000	0.00	0.00	0.0000	0.0000	0.0000	385.99	696.64	2.4505	0.2167	0.1023	11.58		
3.771	207.27	0.0000	0.00	0.00	0.0000	0.0000	0.0000	394.29	692.96	2.4652	0.2133	0.1018	11.28		
3.771	210.64	0.0000	0.00	0.00	0.0000	0.0000	0.0000	402.64	689.11	2.4794	0.2101	0.1014	10.98		
3.771	214.01	0.0000	700.35	11.70	1.9816	0.0100	0.0249	411.01	685.43	2.4941	0.2069	0.1009	10.68		
3.771	214.08	0.0105	700.48	11.70	1.9820	0.0100	0.0249	411.17	685.27	2.4945	0.2069	0.1009	10.68		
3.771	214.15	0.0209	700.60	11.70	1.9825	0.0100	0.0249	411.34	685.27	2.4949	0.2069	0.1009	10.67		
3.771	214.22	0.0314	700.72	11.70	1.9825	0.0100	0.0249	411.50	685.27	2.4949	0.2069	0.1009	10.67		
3.771	214.29	0.0419	700.84	11.71	1.9829	0.0100	0.0249	411.67	685.27	2.4953	0.2069	0.1009	10.67		
3.771	214.36	0.0524	700.96	11.71	1.9833	0.0100	0.0249	411.83	685.27	2.4953	0.2069	0.1007	10.67		
3.771	214.43	0.0629	701.09	11.71	1.9833	0.0100	0.0249	412.00	685.11	2.4958	0.2069	0.1007	10.67		
3.771	214.50	0.0734	701.21	11.71	1.9837	0.0100	0.0249	412.17	685.11	2.4962	0.2070	0.1007	10.66		
3.771	214.57	0.0839	701.34	11.71	1.9841	0.0100	0.0249	412.33	685.11	2.4962	0.2070	0.1007	10.66		
3.771	214.64	0.0944	701.46	11.71	1.9845	0.0100	0.0249	412.50	685.11	2.4966	0.2070	0.1007	10.66		
3.771	214.72	0.1049	701.58	11.72	1.9845	0.0100	0.0249	412.67	684.95	2.4966	0.2070	0.1007	10.66		
4.170	203.89	0.0000	0.00	0.00	0.0000	0.0000	0.0000	385.99	696.64	2.4505	0.2168	0.1023	11.58		
4.170	209.05	0.0000	0.00	0.00	0.0000	0.0000	0.0000	398.70	691.04	2.4727	0.2116	0.1016	11.12		
4.170	214.21	0.0000	0.00	0.00	0.0000	0.0000	0.0000	411.52	685.27	2.4949	0.2067	0.1009	10.66		
4.170	219.37	0.0000	709.74	12.91	2.0034	0.0100	0.0254	424.43	679.50	2.5175	0.2020	0.1000	10.21		
4.170	219.43	0.0105	709.87	12.91	2.0038	0.0100	0.0254	424.60	679.34	2.5179	0.2020	0.1000	10.21		
4.170	219.50	0.0209	709.99	12.91	2.0038	0.0100	0.0254	424.76	679.34	2.5184	0.2020	0.1000	10.20		
4.170	219.57	0.0314	710.11	12.91	2.0042	0.0100	0.0254	424.92	679.34	2.5184	0.2021	0.1000	10.20		
4.170	219.64	0.0419	710.23	12.91	2.0046	0.0100	0.0254	425.09	679.34	2.5188	0.2021	0.1000	10.20		
4.170	219.71	0.0524	710.35	12.92	2.0051	0.0100	0.0254	425.25	679.34	2.5188	0.2021	0.1000	10.20		
4.170	219.78	0.0629	710.48	12.92	2.0051	0.0100	0.0254	425.42	679.18	2.5192	0.2021	0.1000	10.20		
4.170	219.85	0.0734	710.60	12.92	2.0055	0.0100	0.0254	425.58	679.18	2.5196	0.2021	0.1000	10.19		
4.170	219.92	0.0839	710.73	12.92	2.0059	0.0100	0.0254	425.75	679.18	2.5196	0.2021	0.1000	10.19		
4.170	219.99	0.0945	710.85	12.92	2.0059	0.0100	0.0254	425.92	679.18	2.5200	0.2021	0.1000	10.19		
4.170	220.06	0.1050	710.98	12.92	2.0063	0.0100	0.0254	426.08	679.02	2.5200	0.2021	0.1000	10.19		
4.568	203.89	0.0000	0.00	0.00	0.0000	0.0000	0.0000	385.99	696.80	2.4505	0.2168	0.1023	11.58		
4.568	210.71	0.0000	0.00	0.00	0.0000	0.0000	0.0000	402.81	689.43	2.4798	0.2101	0.1012	10.97		
4.568	217.53	0.0000	0.00	0.00	0.0000	0.0000	0.0000	419.83	681.75	2.5096	0.2037	0.1004	10.37		
4.568	224.34	0.0000	718.50	14.12	2.0239	0.0101	0.0258	437.02	673.90	2.5397	0.1977	0.0993	9.78		
4.568	224.41	0.0105	718.62	14.12	2.0239	0.0101	0.0258	437.19	673.74	2.5401	0.1977	0.0993	9.77		
4.568	224.48	0.0210	718.74	14.12	2.0243	0.0101	0.0258	437.35	673.74	2.5401	0.1977	0.0993	9.77		
4.568	224.54	0.0315	718.87	14.12	2.0247	0.0101	0.0258	437.51	673.74	2.5406	0.1977	0.0993	9.77		
4.568	224.62	0.0419	718.99	14.13	2.0247	0.0101	0.0258	437.67	673.74	2.5410	0.1977	0.0993	9.77		
4.568	224.68	0.0525	719.11	14.13	2.0252	0.0101	0.0258	437.84	673.58	2.5410	0.1977	0.0993	9.76		
4.568	224.75	0.0630	719.23	14.13	2.0256	0.0101	0.0258	438.00	673.58	2.5414	0.1977	0.0993	9.76		
4.568	224.82	0.0735	719.36	14.13	2.0260	0.0101	0.0258	438.17	673.58	2.5418	0.1978	0.0993	9.76		
4.568	224.89	0.0840	719.48	14.13	2.0260	0.0101	0.0258	438.33	673.58	2.5418	0.1978	0.0993	9.76		
4.568	224.96	0.0945	719.61	14.13	2.0264	0.0101	0.0258	438.50	673.58	2.5422	0.1978	0.0993	9.76		
4.568	225.03	0.1050	719.73	14.14	2.0268	0.0101	0.0258	438.67	673.42	2.5422	0.1978	0.0993	9.75		
4.967	203.89	0.0000	0.00	0.00	0.0000	0.0000	0.0000	385.99	696.96	2.4505	0.2168	0.1023	11.58		
4.967	212.26	0.0000	0.00	0.00	0.0000	0.0000	0.0000	406.66	687.83	2.4865	0.2087	0.1011	10.83		
4.967	220.63	0.0000	0.00	0.00	0.0000	0.0000	0.0000	427.63	678.38	2.5234	0.2010	0.0999	10.10		
4.967	229.00	0.0000	726.72	15.33	2.0432	0.0102	0.0261	448.90	668.45	2.5611	0.1938	0.0987	9.37		
4.967	229.07	0.0105	726.84	15.33	2.0432	0.0102	0.0261	449.06	668.45	2.5611	0.1938	0.0987	9.37		
4.967	229.13	0.0210	726.96	15.34	2.0436	0.0102	0.0261	449.23	668.45	2.5615	0.1938	0.0987	9.37		
4.967	229.20	0.0315	727.08	15.34	2.0440	0.0102	0.0261	449.39	668.45	2.5619	0.1938	0.0987	9.37		
4.967	229.27	0.0420	727.21	15.34	2.0440	0.0102	0.0261	449.55	668.29	2.5619	0.1938	0.0987	9.37		
4.967	229.33	0.0525	727.33	15.34	2.0444	0.0102	0.0261	449.71	668.29	2.5623	0.1938	0.0987	9.36		
4.967	229.41	0.0630	727.45	15.35	2.0448	0.0102	0.0261	449.88	668.29	2.5623	0.1938	0.0987	9.36		
4.967	229.47	0.0735	727.58	15.35	2.0448	0.0102	0.0261	450.04	668.29	2.5627	0.1938	0.0987	9.36		
4.967	229.54	0.0840	727.70	15.35	2.0453	0.0102	0.0261	450.21	668.13	2.5632	0.1938	0.0987	9.36		
4.967	229.61	0.0946	727.82	15.35	2.0457	0.0102	0.0261	450.37	668.13	2.5632	0.1938	0.0987	9.35		
4.967	229.68	0.1051	727.95	15.35	2.0461	0.0102	0.0261	450.54	668.13	2.5636	0.1939	0.0987	9.35		
5.365	203.89	0.0000	0.00	0.00	0.0000	0.0000	0.0000	385.99	697.12	2.4505	0.2169	0.1023	11.58		
5.365	213.72	0.0000	0.00	0.00	0.0000	0.0000	0.0000	410.30	686.39	2.4928	0.2073	0.1009	10.70		
5.365	223.56	0.0000	0.00	0.00	0.0000	0.0000	0.0000	435.03	675.18	2.5364	0.1985	0.0995	9.84		
5.365	233.38	0.0000	734.47	16.55	2.0612	0.0103	0.0265	460.17	663.32	2.5812	0.1902	0.0981	9.00		
5.365	233.44	0.0105	734.59	16.56	2.0616	0.0103	0.0265	460.33	663.32	2.5816	0.1902	0.0981	9.00		
5.365	233.51	0.0210	734.71	16.56	2.0620	0.0103	0.0265	460.49	663.32	2.5816	0.1902	0.0981	8.99		
5.365	233.58	0.0315	734.83	16.56	2.0620	0.0103	0.0265	460.65	663.32	2.5820	0.1902	0.0981	8.99		
5.365	233.64	0.0420	734.95	16.56	2.0624	0.0103	0.0265	460.81	663.16	2.5820	0.1902	0.0981	8.99		
5.365	233.71	0.0525	735.07	16.56	2.0628	0.0103	0.0265	460.97	663.16	2.5824	0.1902	0.0981	8.99		
5.365	233.78	0.0630	735.20	16.57	2.0628	0.0103	0.0265	461.14	663.16	2.5828	0.1902	0.0981	8.99		
5.365	233.85	0.0736	735.32	16.57	2.0633	0.0103	0.0265	461.30	663.16	2.5828	0.1902	0.0980	8.98		
5.365	233.92	0.0841	735.44	16.57	2.0637	0.0103	0.0265	461.46	663.16	2.5833	0.1903	0.0980	8.98		
5.365	233.98	0.0946	735.57	16.57	2.0641	0.0103	0.0265	461.63	663.00	2.5837	0.1903	0.0980	8.98		
5.365	234.05	0.1052	735.69	16.58	2.0641	0.0103	0.0267	4616							

**FIRED HEATER
DATA SHEET**

Contract: 10E0541A01
Equipment No.: 56-B-01
Revision: 2 Date: 11-Aug.-2011
Unit: 56 - Sulfolane
P.O. No.:
Document No.: DS-56-BA-501
Sheet: 4 of 5

FLUID PROPERTIES:															REV
PROCESS															
Thermodynamic condition			Vapor					Liquid							
Pressure bar(a)	Temp °C	Weight fraction vapor	Enthalpy kJ/kg	Density kg/m³	Specific heat kJ/kg·°C	Viscosity cP	Thermal cond. W/m·°C	Enthalpy kJ/kg	Density kg/m³	Specific heat kJ/kg·°C	Viscosity cP	Thermal cond. W/m·°C	Surface tension dyne/cm		
5.764	203.89	0.0000	0.00	0.00	0.0000	0.0000	0.0000	385.99	697.28	2.4505	0.2169	0.1023	11.58		
5.764	215.10	0.0000	0.00	0.00	0.0000	0.0000	0.0000	413.74	684.95	2.4991	0.2061	0.1007	10.58		
5.764	226.31	0.0000	0.00	0.00	0.0000	0.0000	0.0000	442.03	672.13	2.5485	0.1962	0.0992	9.61		
5.764	237.52	0.0000	741.80	17.78	2.0787	0.0103	0.0268	470.89	658.52	2.6004	0.1869	0.0974	8.65		
5.764	237.58	0.0105	741.92	17.78	2.0792	0.0103	0.0268	471.05	658.36	2.6008	0.1869	0.0974	8.64		
5.764	237.65	0.0210	742.04	17.79	2.0796	0.0103	0.0268	471.21	658.36	2.6013	0.1869	0.0974	8.64		
5.764	237.72	0.0315	742.16	17.79	2.0796	0.0103	0.0268	471.37	658.36	2.6013	0.1869	0.0974	8.64		
5.764	237.78	0.0420	742.28	17.79	2.0800	0.0103	0.0268	471.53	658.36	2.6017	0.1869	0.0974	8.64		
5.764	237.85	0.0525	742.41	17.79	2.0804	0.0103	0.0268	471.69	658.36	2.6021	0.1869	0.0974	8.64		
5.764	237.92	0.0631	742.53	17.80	2.0804	0.0103	0.0268	471.86	658.20	2.6021	0.1869	0.0974	8.63		
5.764	237.98	0.0736	742.65	17.80	2.0808	0.0103	0.0268	472.02	658.20	2.6025	0.1870	0.0974	8.63		
5.764	238.05	0.0841	742.78	17.80	2.0813	0.0103	0.0268	472.19	658.20	2.6025	0.1870	0.0974	8.63		
5.764	238.12	0.0947	742.90	17.80	2.0813	0.0103	0.0268	472.35	658.20	2.6029	0.1870	0.0974	8.63		
5.764	238.18	0.1052	743.02	17.81	2.0817	0.0103	0.0270	472.51	658.04	2.6034	0.1870	0.0974	8.63		
6.163	203.89	0.0000	0.00	0.00	0.0000	0.0000	0.0000	385.99	697.44	2.4505	0.2170	0.1023	11.58		
6.163	216.41	0.0000	0.00	0.00	0.0000	0.0000	0.0000	417.02	683.67	2.5045	0.2050	0.1006	10.47		
6.163	228.93	0.0000	0.00	0.00	0.0000	0.0000	0.0000	448.73	669.09	2.5606	0.1940	0.0987	9.38		
6.163	241.44	0.0000	748.77	19.02	2.0955	0.0104	0.0272	481.14	653.71	2.6197	0.1839	0.0969	8.31		
6.163	241.51	0.0105	748.89	19.02	2.0959	0.0104	0.0272	481.30	653.71	2.6197	0.1839	0.0969	8.31		
6.163	241.57	0.0210	749.01	19.02	2.0963	0.0104	0.0272	481.46	653.71	2.6201	0.1839	0.0969	8.31		
6.163	241.64	0.0315	749.13	19.02	2.0963	0.0104	0.0272	481.62	653.55	2.6201	0.1839	0.0969	8.31		
6.163	241.71	0.0420	749.25	19.03	2.0968	0.0104	0.0272	481.78	653.55	2.6205	0.1839	0.0969	8.31		
6.163	241.77	0.0526	749.37	19.03	2.0972	0.0104	0.0272	481.94	653.55	2.6209	0.1839	0.0969	8.31		
6.163	241.83	0.0631	749.49	19.03	2.0972	0.0104	0.0272	482.10	653.55	2.6209	0.1839	0.0969	8.30		
6.163	241.90	0.0736	749.62	19.03	2.0976	0.0104	0.0272	482.26	653.39	2.6214	0.1839	0.0969	8.30		
6.163	241.97	0.0842	749.74	19.04	2.0980	0.0104	0.0272	482.43	653.39	2.6214	0.1839	0.0969	8.30		
6.163	242.03	0.0947	749.86	19.04	2.0980	0.0104	0.0272	482.59	653.39	2.6218	0.1839	0.0969	8.30		
6.163	242.10	0.1053	749.99	19.04	2.0984	0.0104	0.0272	482.75	653.39	2.6222	0.1839	0.0969	8.30		
6.561	203.89	0.0000	0.00	0.00	0.0000	0.0000	0.0000	385.99	697.60	2.4505	0.2170	0.1023	11.58		
6.561	217.66	0.0000	0.00	0.00	0.0000	0.0000	0.0000	420.14	682.39	2.5100	0.2039	0.1004	10.36		
6.561	231.42	0.0000	0.00	0.00	0.0000	0.0000	0.0000	455.12	666.37	2.5720	0.1920	0.0983	9.17		
6.561	245.18	0.0000	755.41	20.26	2.1118	0.0104	0.0275	490.97	649.07	2.6377	0.1810	0.0964	8.00		
6.561	245.24	0.0105	755.52	20.26	2.1122	0.0104	0.0275	491.12	649.07	2.6381	0.1810	0.0964	8.00		
6.561	245.31	0.0210	755.65	20.26	2.1122	0.0104	0.0275	491.28	649.07	2.6385	0.1810	0.0964	8.00		
6.561	245.37	0.0315	755.77	20.27	2.1127	0.0104	0.0275	491.44	649.07	2.6385	0.1810	0.0964	8.00		
6.561	245.44	0.0421	755.89	20.27	2.1131	0.0104	0.0275	491.60	649.07	2.6389	0.1811	0.0964	7.99		
6.561	245.51	0.0526	756.01	20.27	2.1131	0.0104	0.0275	491.76	648.91	2.6389	0.1811	0.0964	7.99		
6.561	245.57	0.0631	756.13	20.27	2.1135	0.0104	0.0275	491.92	648.91	2.6394	0.1811	0.0964	7.99		
6.561	245.63	0.0737	756.25	20.28	2.1139	0.0104	0.0275	492.08	648.91	2.6398	0.1811	0.0964	7.99		
6.561	245.70	0.0842	756.38	20.28	2.1139	0.0104	0.0275	492.24	648.91	2.6398	0.1811	0.0964	7.99		
6.561	245.77	0.0948	756.50	20.28	2.1143	0.0104	0.0275	492.41	648.75	2.6402	0.1811	0.0964	7.98		
6.561	245.83	0.1053	756.62	20.29	2.1143	0.0104	0.0275	492.57	648.75	2.6406	0.1811	0.0964	7.98		
6.960	203.89	0.0000	0.00	0.00	0.0000	0.0000	0.0000	385.99	697.76	2.4505	0.2171	0.1023	11.58		
6.960	218.84	0.0000	0.00	0.00	0.0000	0.0000	0.0000	423.13	681.27	2.5154	0.2028	0.1002	10.25		
6.960	233.80	0.0000	0.00	0.00	0.0000	0.0000	0.0000	461.25	663.64	2.5833	0.1901	0.0981	8.96		
6.960	248.75	0.0000	761.75	21.51	2.1277	0.0105	0.0279	500.41	644.74	2.6557	0.1784	0.0959	7.70		
6.960	248.81	0.0105	761.87	21.51	2.1277	0.0105	0.0279	500.56	644.58	2.6561	0.1784	0.0959	7.70		
6.960	248.87	0.0210	761.99	21.51	2.1282	0.0105	0.0279	500.72	644.58	2.6561	0.1784	0.0959	7.70		
6.960	248.94	0.0316	762.11	21.52	2.1282	0.0105	0.0279	500.88	644.58	2.6565	0.1784	0.0959	7.70		
6.960	249.00	0.0421	762.23	21.52	2.1286	0.0105	0.0279	501.04	644.58	2.6569	0.1784	0.0959	7.70		
6.960	249.07	0.0526	762.35	21.52	2.1290	0.0105	0.0279	501.20	644.58	2.6569	0.1784	0.0959	7.70		
6.960	249.13	0.0632	762.47	21.53	2.1290	0.0105	0.0279	501.36	644.42	2.6574	0.1784	0.0959	7.69		
6.960	249.19	0.0737	762.59	21.53	2.1294	0.0105	0.0279	501.52	644.42	2.6574	0.1784	0.0959	7.69		
6.960	249.26	0.0843	762.71	21.53	2.1298	0.0105	0.0279	501.68	644.42	2.6578	0.1784	0.0959	7.69		
6.960	249.32	0.0948	762.84	21.54	2.1298	0.0105	0.0279	501.84	644.42	2.6582	0.1784	0.0959	7.69		
6.960	249.39	0.1054	762.96	21.54	2.1302	0.0105	0.0279	502.00	644.26	2.6582	0.1784	0.0959	7.69		
7.358	203.89	0.0000	0.00	0.00	0.0000	0.0000	0.0000	385.99	697.92	2.4505	0.2171	0.1023	11.58		
7.358	219.98	0.0000	0.00	0.00	0.0000	0.0000	0.0000	425.99	680.14	2.5205	0.2019	0.1000	10.15		
7.358	236.08	0.0000	0.00	0.00	0.0000	0.0000	0.0000	467.15	661.08	2.5937	0.1883	0.0978	8.77		
7.358	252.16	0.0000	767.82	22.77	2.1428	0.0105	0.0280	509.51	640.42	2.6733	0.1759	0.0954	7.42		
7.358	252.22	0.0105	767.94	22.77	2.1428	0.0105	0.0280	509.66	640.26	2.6733	0.1759	0.0954	7.42		
7.358	252.29	0.0210	768.06	22.78	2.1432	0.0105	0.0280	509.82	640.26	2.6737	0.1759	0.0954	7.42		
7.358	252.35	0.0316	768.18	22.78	2.1436	0.0105	0.0280	509.98	640.26	2.6741	0.1759	0.0954	7.42		
7.358	252.41	0.0421	768.30	22.78	2.1436	0.0105	0.0282	510.13	640.26	2.6741	0.1759	0.0954	7.42		
7.358	252.48	0.0526	768.42	22.78	2.1441	0.0105	0.0282	510.29	640.10	2.6745	0.1759	0.0954	7.41		
7.358	252.54	0.0632	768.54	22.79	2.1445	0.0105	0.0282	510.45	640.10	2.6749	0.1759	0.0954	7.41		
7.358	252.61	0.0737	768.66	22.79	2.1445	0.0105	0.0282	510.61	640.10	2.6749	0.1759	0.0954	7.41		
7.358	252.67	0.0843	768.78	22.79	2.1449	0.0105	0.0282	510.77	640.10	2.6754	0.1759	0.0954	7.41		
7.358	252.73	0.0949	768.91	22.80	2.1449</										

**FIRE HEATER
DATA SHEET**

Contract: 10E0541A01
Equipment No.: 56-B-01
Revision: 2 Date: 11-Aug-2011
Unit: 56 - Sulfolane
P.O. No.:
Document No.: DS-56-BA-501
Sheet: 5 of 5

NOTES

MODIFICATIONS

1. The existing Stripper Reboiler Heater, Equipment No. 51-B-06A, is suitable for the revamp conditions with a change in service (now Equipment No. 56-B-01 Reformate Splitter Reboiler).
2. No other modifications, except those given below are required for the existing heater as long as it is "fit for service", which shall be determined by CTCI: (Also, see "Revamp Notes" below).
 - a. Existing parallel heater, Equipment No. 51-B-06B, shall be IDLED for the revamp operation. Isolate the idled heater (process and fuel) as required.
 - b. UOP combustion conditions shown on Sheet 2 of this data sheet are based on 'Sales Gas' composition given in UOP document number 951606 - A.4 "Basic Engineering Design Questionnaire, Rev. 3. CTCI/Heater Vendor shall confirm the adequacy of the existing burners and fuel gas supply system for the full range of fuel gas compositions anticipated for the revamp operation as shown in latest revision of Fluor document SP-000-AA-5002 "Basic Engineering Design Data".
 - c. Heater vendor shall verify the adequacy of the process coils and manifolds for full vacuum at 215°C.
 - d. UOP estimates that the forced draft fan inlet box dampers will be almost fully closed. Heater vendor shall confirm the suitability of the forced draft combustion air system for revamp operation. If system turndown is an issue, consider operating with even higher excess air rates, bleed air through the idled heater, modify burners for natural draft operation (i.e., forced draft air system idled).
 - e. Provide NPS 3 Sch 80 ASTM A 312 Gr TP310 open ended waste gas nozzle located within the burner circle for disposal of 136 kg/h of waste stream with a composition of 9.40 mol% H₂O, 17.0 mol% Benzene, 4.0 mol% Toluene, 56.2 mol% Nitrogen and 13.4 mol% Oxygen at an estimated pressure of 0.035 bar (g) and estimated temperature of 45°C. The molecular weight of the mixture is 38.69.

REFERENCE DATA

1. Born API Fired Heater Data Sheet Rev. 4 dated 2-Apr-96.
2. Born Burner Data Sheet Spec. No. 2881/0400/127/AB Rev. 0 dated 7-Mar-96.
3. Born Overall Layout & Plot Drawing No. 2881-51B06-01A Rev. 0 dated 7-Mar-96.
4. Born General Arrangement (Elevations) Drawing No. 2881-51B06-02A Rev. 0 dated 7-Mar-96.
5. Born FD Fan Data Sheet (Equipment No. 51-K-03 A & B) (4 Pages) [Title block illegible].



REVAMP NOTES

1. The revamp conclusions are based on the assumption that all existing coil components that are to be re-used for the revamp are identical to the vendor's data sheets referenced above, and:
 - a. The tubes/fittings have normal original wall thickness.
 - b. No significant corrosion or metallurgical damage has occurred.
 - c. The tubes/fittings are not severely warped, bulged, nor oxidized.
 - d. The tubes/fittings are free of internal and external deposits.Changes to this information will require further review of this specification by UOP.
2. CTCI/heater vendor is responsible for the following:
 - a. Providing confirmation and guarantee that the existing heater will meet UOP's predicted thermal and hydraulic performance while complying with specified noise and emissions limits.
 - b. Conducting a detailed field inspection based upon consultation with the component vendors.
 - c. Ensuring that the heaters and ancillary equipment are refurbished, as required, to provide for safe operation at the revamp conditions.
 - d. Verifying that the structural and mechanical integrity of the heater and ancillary equipment is satisfactory for the revamp conditions.
 - e. Ensuring compliance with existing codes and practices, including environmental regulations.
 - f. Ensuring that any replacement parts or modifications shall comply with the same standards as the original equipment.
 - g. Vendor shall verify capacity of 56-K-03 A/B (Existing 51-K-03 A/B) and duty of 56-E-22 (Existing 51-E-32).

CLIENT : CHIYODA / ARABIAN INDUSTRIAL FIBERS CO LTD
 CHIYODA PO : SAY POE 0002
 LOCATION : IBN RUSHD PTA & AROMATICS PLANT PROJECT

EQUIPMENT : 51-B-06 STRIPPER REBOILER

REQUISITION NO : 22854-MR-000-B-501

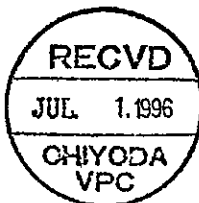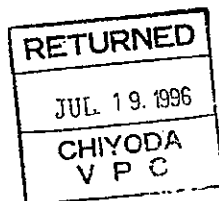

CHIYODA CORPORATION	
JOB NO. 51046	IBN RUSHD AROMATICS PROJECT
PONO. SAY POE 0002	
REQ NO. 22854000B501	
IDENT NO. 22854000B501 <u>000125</u>	
A-NO COMMENTS PROCEED WITH FABRICATION	SAY TEAM
B-PROCEED WITH FABRICATION COMMENTS TO BE CONSIDERED	<u>PYD</u> <u>8/11</u>
C-DO NOT PROCEED WITH FABRICATION	DATE <u>7/21/96</u>
PURCHASER'S PERMISSION TO PROCEED OR REVIEW TAKEN ON VENDOR PRINTS SHALL NOT RELIEVE VENDOR FROM ITS RESPONSIBILITIES OR LIABILITIES UNDER PURCHASE ORDER	

								CAT CODE: D1
								UNIT: 51-B-06
4	BP	10/5/96	PER CLIENT COMMENTS	FLW	21/5/96	@1	26/6/96	
3	BP	7/3/96	AS NOTED	RW	7/3/96	@1	11/3/96	
REV	INITL	DATE	REVISIONS	CHKD	DATE	APP	DATE	
								TITLE: FRED HEATER DATA SHEET
								SPEC NO: 2881-51B06-ETD 002 /A
NOTE: THIS DRAWING IS THE PROPERTY OF BORN INTERNATIONAL. IT IS TO BE USED ONLY FOR THE PROJECT AND LOCATION SPECIFIED HEREIN. NO PART OF THIS DRAWING IS TO BE REPRODUCED OR TRANSMITTED IN ANY FORM OR BY ANY MEANS, ELECTRONIC OR MECHANICAL, WITHOUT THE WRITTEN PERMISSION OF BORN INTERNATIONAL.								SHEET 1 OF 9
								REV 4
MANUFACTURE AND CONSTRUCTION TO BE CARRIED OUT STRICTLY IN ACCORDANCE WITH THE REQUIREMENTS OF THIS DRAWING SPECIFICATION. NO CHANGES ARE TO BE MADE WITHOUT THE PRIOR AGREEMENT OF THE CHIEF ENGINEER OR THE ORGANISING SECTION WITHIN ENGINEERING DEPARTMENT.								



CTCI CORPORATION

ALTERNATE DESIGN

BORN

WORLD-WIDE MANUFACTURERS OF
DIRECT FIRED HEATERS
SI UNITS

PROCESS DESIGN CONDITIONS

1. Total duty heater, MW
2. Heater section
3. Service per heater
4. Heat Absorption per heater, MW
5. Fluid Name
6. Flow rate, kg/hr
7. Flow rate, dm(cube)/s
8. Press drop (allow, clean/fouled), bar
9. Press drop (calc, clean/fouled), bar
10. Fouling allowance, m(sq)-C(deg)/W
11. Therm conductivity of coke/scale, W/mC(deg)
12. Avg. radiant flux density (allowable), W/m(sq)
13. Avg. radiant flux density (calculated), W/m(sq)
14. Avg. convection flux density (allowable), W/m(sq)
15. Avg. convection flux density (calculated), W/m(sq)
16. Max radiant flux density, W/m(sq)
17. Max convection flux density, W/m(sq)
18. Velocity limitation, m/sec
19. Max. Allowable Inside film temperature, C(deg)

INLET CONDITIONS:

20. Temperature, C(deg)
21. Pressure, barg
22. Liquid flow, kg/hr
23. Vapor flow, kg/hr
24. Density of Liquid @ T. P. , S.G
25. Vapor, molecular weight
26. Viscosity, liquid, mPa.s
27. Viscosity, vapor, mPa.s
28. Specific heat, liquid, KJ/kgC(deg)
29. Specific heat, vapor, KJ/kgC(deg)
30. Thermal conductivity, liquid, W/mC(deg)
31. Thermal conductivity, vapor, W/mC(deg)

OUTLET CONDITIONS:

32. Temperature, Degree C
33. Pressure, barg
34. Liquid flow, kg/hr
35. Vapor flow, kg/hr
36. Density of Liquid @ T. P. , Kg/cuM
37. Vapor, molecular weight
38. Viscosity, liquid, mPa*s
39. Viscosity, vapor, mPa*s
40. Specific heat, liquid, KJ/kgC(deg)
41. Specific heat, vapor, KJ/kgC(deg)
42. Thermal conductivity, liquid, W/mC(deg)
43. Thermal conductivity, vapor, W/mC(deg)

REMARKS

44. Distillation data should be attached
for vaporization service
45. Other

Service /Item Stripper Reboiler 51B06
Type rad con V-C Plant Location
Quantity 2
Owner Ref. No.
Purchaser Chiyoda Ref. No.
Date 07/03/96 Born Ref No. BJ 2881
By: BDP Page 1 of 8

94.04		
Radiant	Conv.	
Stripper Reboiler 51B06		
32.28	14.74	
HC		
746364		
3.8		
2.3		
31546		
30622		
	3341	
55120		
	60329	
	212	
	12.80	
	746364	
	0	
	0.671	
	0.166	
	2.477	
	0.101	
224		
9.00		
223909.2		
522454.8		
0.664		
91.9		
0.166		
0.011		
2.535		
1.975		
0.099		
0.027		



BORN

WORLD-WIDE MANUFACTURERS OF
DIRECT FIRED HEATERS
SI UNITS

Service/Item	Stripper Reboiler 51B06	
Unit	rad con V-C	Plant Location
Type		Quantity 2
Owner		Ref. No.
Purchaser	Chiyoda	Ref. No.
Date:	07/03/96	Born Ref No. BJ 2881
By:	BDP	Page 3 of 8

Coil Design: (RADIANT)

4. Design basis of tube wall thk. (code or specs)
5. Design basis for rupture strength, (min or avg)
6. Design life, hr
7. Elastic design pressure, bar
8. Rupture design pressure, bar
9. Temperature allowance, C(deg)
10. Corrosion allowance, mm
11. Stress relieve (YES or NO)
12. Weld inspection requirements radiography, %
13. Hydrostatic test pressure, BARG
14. Max tube metal temperature (clean) C(deg)
15. Design tube metal temperature C(deg)
16. Inside film coefficient, W/m C(deg)

Coil Configuration: (RADIANT)

17. Tubes (vertical or horizontal)
18. No. of flow passes
19. Effective tube length, m
20. Bare tubes, number
21. Bare tubes, exposed surface, m(sq)
22. Bare tubes, total exposed surface, m(sq)
23. Tubes, inline or staggered
24. Tube spacing, C to C, mm

Tubes: (RADIANT)

25. Material (ASTM spec. or grade)
26. Outside diameter, mm
27. wall thickness, mm or Sch
28. Overall tube length, m
29. No. of intermediate welds
30. Distance from Center Line of tube to wall, mm

Heater Section

Plug-Type Headers:

31. Location (one end or both ends)
32. Manufacture and type
33. Nominal rating
34. Welded or rolled joint

Return Bends:

35. Location (header box or firebox)
36. Material (ASTM spec and grade)

		Radiant Shock
API 530		API 530
100000		100000
15.80		15.80
28		28
3		3
NO		NO
100		100
27.4		27.4
289		
317		317
1124		1120
VERT		HORIZ
8		8
17.91		8.077
80		16
985.97		68.28
1054.25		
IN LINE		STAGGERED
406.4		304.8
A106 GRB		A 106 GRB
219.1		168.3
sch 40aw		sch 40 aw
80		None
305		152
Radiant		
None		None
Firebox		Header box
A234 WPB		A 234 WPB

064006

BORN

WORLD-WIDE MANUFACTURERS OF
DIRECT FIRED HEATERS
SI UNITS

Service/Item Stripper Reboiler 51B06
Unit rad con V-C Plant Location
Type Quantity 2
Owner Ref. No.
Purchaser Chiyoda Ref. No.
Date: 07/03/96 Born Ref No. BJ 2881
By: BDP Page 4 of 8

Coil Design: (CONVECTION)

4. Design basis of tube wall thk. (code)
5. Design basis for rupture strength
6. Design life, hr.
7. Elastic design pressure, BAR
8. Rupture design pressure, BAR
9. Temperature allowance, C(deg)
10. Corrosion allowance, mm
11. Stress relieve (yes or no)
12. Weld inspection requirements radiography, %
13. Hydrostatic test pressure, Barg
14. Max tube metal temperature (clean), C(deg)
15. Design tube metal temperature, C(deg)
16. Inside film coefficient, W/m(sq) C(deg)

Coil Configuration: (CONV.)

17. Tubes (vertical or horizontal)
18. No. of flow passes/tubes per row
19. Effective tube length, m
20. Bare tubes, number
21. Bare tubes, exposed surface, m(sq)
22. Ext tubes, number
23. Ext surface tubes, exp. surface, m(sq)
24. Ext surface tubes, total exp. surface, m(sq)
25. Tubes, staggered/inline
26. Tube spacing, C to C, mm

Tubes: (CONVECTION)

27. Material (ASTM spec. or grade)
28. Outside diameter, mm
29. wall thickness, m m or Sch
30. Overall tube length, m
31. No. of intermediate welds
32. Distance from tube center line to wall, mm

Description of Extended Surface:

33. Type (studs, serrated fins or solid fins)
34. Material
35. Fin Height, mm
36. Fin Thickness, mm
37. Fins Per m
38. Max tip temperature, C(deg)
39. Extension ratio

Heater Section

Plug-Type Headers:

40. Location (one end or both ends)
41. Manufacture and type
42. Nominal rating
43. Welded or rolled joint

Return Bends:

44. Location (header box or firebox)
45. Material (ASTM spec and grade)

BARE	EXT.	EXT.	EXT.
API 530	API 530	API 530	API 530
100,000	100,000	100,000	100,000
15.8	15.8	15.8	15.8
28	28	28	28
3	3	3	3
NO	NO	NO	NO
100	100	100	100
27.4	27.4	27.4	27.4
255	281	276	266
283	309	304	294
1823	1828	1834	1840
HORI.	HORI.	HORI.	HORI.
8 16	8 16	8 16	8 16
8.077	8.077	8.077	8.077
32	0	0	0
136.66			
0	16	16	64
	290.50	543.57	3441.66
	4275.73		0
STAGGERED	STAGGERED	STAGGERED	STAGGERED
305	305	305	305
A106 GRB	A106 GRB	A106 GRB	A106 GRB
168.3	168.3	168.3	168.3
sch 40aw	sch 40 aw	sch 40 aw	sch 40 aw
None	None	None	None
152	152	152	152
	SOLID FIN	SOLID FIN	SOLID FIN
	Car/Stl	Car/Stl	Car/Stl
	12.70	25.40	25.40
	1.30	1.30	1.30
	118	118	197
	331	389	334
	4.252	7.956	12.594
Convection			
		NONE	
Header box	Header box	Header box	Header box
A-234-WPB	A-234-WPB	A-234-WPB	A-234-WPB

BORN

WORLD-WIDE MANUFACTURERS OF
 DIRECT FIRED HEATERS
 SI UNITS

Service/Item	Stripper Reboiler 51B06		
Unit	rad con V-C	Plant Location	
Type		Quantity	2
Owner		Ref. No.	
Purchaser	Chiyoda	Ref. No.	
Date:	07/03/96	Bom Ref No.	BJ 2881
By:	BDP	Page 5 of	8

Heater Section Continued:

Terminals:

1. Type (welded or flanged)

Inlet:

2. Material (ASTM spec and grade)
3. Size/rating, schedule or thickness
4. Number of terminals

Outlet:

5. Material (ASTM spec and grade)
6. Size/rating, schedule or thickness
7. Number of terminals

Manifolds:

8. Connection to tubes (weld or flanged)
9. Location (internal or external)

Inlet:

10. Material (ASTM spec and grade)
11. Size/schedule or thickness
12. Flange/material (ASTM spec and grade)
13. Flange size and rating

Outlet:

14. Material (ASTM spec and grade)
15. Size schedule or thickness
16. Flange/material (ASTM spec and grade)
17. Terminal size and rating

Crossovers:

18. Location (internal or external)
19. Pipe mat'l (ASTM spec and grade)
20. Pipe size/schedule or thickness
21. Flange mat'l (ASTM spec and grade)
22. Flange size and rating

Tube Supports:

23. Location (top, bottom, intermediate)
24. Material (ASTM spec and grade)
25. Spacing
26. Coating (type and thickness)

Tube Guides:

27. Location and spacing (Top/Bottom)
28. Material (ASTM spec and grade)

Settings:

Floor:

29. Lining: Thickness - Hot face temp. - calc - design 200 819 C
30. Mat'l/thk/service temperature 200 MM LW CASTABLE
31. Anchor (type & mat'l)
32. Casing: Thickness - Material - Temperature 6mm C.S. plate

Exposed Vertical Walls:

33. Lining: Thickness - Hot face temp. - calc - design
34. Mat'l/thk/service temperature
35. Anchor (type & mat'l)
36. Casing: Thickness - Material - Temperature

Radiant

Convection

Flanged

Flanged

A105

6" SCH 40 AW 300#

8 PER HEATER

A105

8" SCH40AW 300#

8 PER HEATER

Flanged

External

None

A106 GrB

26" x STD WT

None (Connections to Heater terminals only)

26" x STD WT Bevelled

External

A106 GRB

6" SCH40AW

None

TOP

INTER

ENDS

25/20 CR NI

25/20CR NI

C.S. PLATE

4150 mm

100 mm LW cast

BOTTOM

310 SS



CTCI CORPORATION
ALTERNATE DESIGN

BORN

WORLD-WIDE MANUFACTURERS OF
DIRECT FIRED HEATERS
SI UNITS

Service/Item	Stripper Reboiler 51B06		
Unit	rad con V-C	Plant Location	
Type		Quantity	2
Owner		Ref. No.	
Purchaser	Chiyoda	Ref. No.	
Date:	07/03/96	Born Ref No.	BJ 2881
By:	BDP	Page 6 of	8

Mechanical Design Conditions (continued)

Heater Section (continued):

Shielded Vertical Walls:

1. Lining: Thickness - Hot face temp. - calc - design	125	554 C	1260 C
2. Thk/Mat'l/service temperature	50 -128 kg/ cu m CFNB + 75 -96 kg/ cu m CFNB+3mm stlastic		
3. Anchor (type & matl)	TP 310 SS Studs and Washers		
4. Casing: Thickness - Material - Temperature	6mm	C.S. plate	

Arch:

5. Lining: Thickness - Hot face temp. - calc - design	150	819 C	1260 C
6. Thk/Mat'l/service temperature	50mm128kg/cumCFNB+100mm96 kg/cum CFNB+3mm stlastic		
7. Anchor (type & matl)	TP 310 SS Studs and Washers		
8. Casing: Thickness - Material - Temperature	6mm	C.S. plate	

Convection Walls:

9. Lining: Thickness - Hot face temp. - calc - design	125	534 C	1100 C
10. Thk/Mat'l/service temperature	125 mm LW castable		
11. Anchor (type & matl)	v' type	304 SS	
12. Casing: Thickness - Material - Temperature	6mm	C.S. plate	

Breeching:

13. Lining: Thickness - Hot face temp. - calc - design	75	249 C	1093 C
14. Thk/Mat'l/service temperature	LW CASTABLE		
15. Anchor (type & matl)	v' type	CS	
16. Casing: Thickness - Material - Temperature	5		

Flue Gas Ducts:

17. Location	top of convection section		
18. Lining (internal or external)	internal		
19. Thickness & Material	50 mm LW castable		
20. Anchor, type and material	CS 'v' anchors		
21. Hot face design temperature			
22. Cold face design temperature			

Combustion Air Ducts:

23. Location	FD fan to burner plenums		
24. Lining (internal or external)			
25. Thickness and Material			
26. Anchor, type and material			
27. Hot face / cold face design temperature, C(deg)			

Header Boxes:

28. Location	Conv. ends	Hinged doors/bolted	Bolted
29. Lining (Thickness & Material)	50 mm LW castable		
30. Anchor (type and material)	v' type	CS	
31. Door/panel (matl and thickness)	6mm	C.S. plate	

Burner Windboxes

32. Lining (internal or external)	internal	Matl & thk.	mineral wool
33. Anchor (type and matl)	CS 'v'		
34. Casing: Materials and thk.	CS 5		
35. Hot face design temp., C(deg)	Cold face design temp.,C		



CTCI CORPORATION
ALTERNATE DESIGN

BORN

WORLD-WIDE MANUFACTURERS OF
DIRECT FIRED HEATERS
SI UNITS

Mechanical Design Conditions (continued)

Heater Section (continued):

Stack:

1. Location
Inside met. dia., mm
2. Stack design metal temperature.
3. Plate, min. thickness, mm
4. Lining : (Internal or External)
5. Thickness and Material, mm
6. Anchor, type and material:

Bridgewall:

7. Height, mm
- Matl and thickness:

Dampers:

8. Location
9. Material of blade
10. Material of shaft
11. Bearing type
12. Multiple or single blade
13. Desc of provision for operation
14. Location and type of operator

Miscellaneous:

Platforms:

- | | Location/No. |
|-----------------------------|--------------|
| 15. Hearth / One | |
| 16. Convection Side(s) /One | |
| 17. Convection End(s) /Two | |
| 18. Rad Intermediate /One | |
| 19. Stack Damper / One | |
| 20. Stack Sample Port | |
| 21. Type of flooring | |
| Doors: | |
| 22. Access Doors | |
| 23 | |
| 24. Observation Doors | |
| 25 | |
| 26 | |
| 27. Steam Lance Doors | |
| 28 | |
| 29 Explosion Door | |
| 30 | |
| 31 | |

Instruments and Aux. connections

32. Process fluid temperature
33. Flue gas / combustion air temp.
34. Flue gas / combustion air pressure
35. Flue gas composition (sample)
36. Snuffing steam
37. Purge
38. Vents and drains
39. Tubeskip thermocouples

Service /Item	Stripper Reboiler 51B06	
Unit	rad con V-C	Plant Location
Type		Quantity 2
Owner		Ref. No.
Purchaser	Chiyoda	Ref. No.
Date:	07/03/96	Born Ref No. BJ 2881
By:	BDP	Page 7 of 8

top of heater	Corr Allow
2713	Ht. above grade: mm
	Stack length, mm 24689
6	Material: Carbon steel
Internal	Extent of lining To top
50	LW Castable
v' type	CS

none	Location
------	----------

Stack
TP304SS
TP304SS
PILLOW BLOCK
Multiple blade
actuated

Width	Length/Arc	Access	
		Stairs/Ladder	
1100 mm	360 DEGREE	1stair/1ladder	Grade
1100 mm		1 LADDER	
1100 mm		2 WALKWAYS	
1100 mm		1 Ladder	
1100 mm	270 DEGREE	1 LADDER	
Number	Location	Size	Hinged/Bolted
2	FLOOR	450 x 600	Hinged
12	RAD SIDE	127 x 406	HINGED(20-std-03)
4	CONV SIDE	600 x 150 bolted	(BLS-D-106)
1	RAD SIDE	473 x 432	HINGED

Number	Size	Type
SEE DRAWING No. 2281/403/126CA		
& 2281-51B06-02A & 02B		
4	2" NPS	3000# CRG with Plug

4-9

BORN

WORLD-WIDE MANUFACTURERS OF
DIRECT FIRED HEATERS
SI UNITS

Service /Item	Stripper Reboiler 51B06	
Unit	rad con V-C	Plant Location
Type		Quantity 2
Owner		Ref. No.
Purchaser	Chiyoda	Ref. No.
Date	07/03/96	Born Ref No. BJ 2881
By:	BDP	Page 8 of 8

Mechanical Design Conditions (continued)

Heater Section (continued):

1. Painting requirements:	22854-SP-000-X-002
	System 2 to Prime coat only
	final coat at site
2. Galvanizing requirements:	Ladders and Platforms to ASTM A123
3. Internal coatings (casing, ducts, stack)	Stalastic behind ceramic fibre blanket
4. Fireproofing requirements:	None

Burner and Auxiliary Equipment:

Burners:

5. Manufacture/type	J.Z. Type PSFG	FD gas only	Location	rad floor
6. Designation/size	16	Number:	12	Fuel: gas
7. Heat rel. (MW per burner) at design excess air (Max\Norm\Min)			4.95 (110%)	4.50
8. Design press drop across burner	50mm	@ max heat release		
9. BCD		5100 mm		
Distance burner centerline to unshielded refractory:		17907 mm		
10. Burner pilot:				
Capacity (KW)	20	Fuel: Gas	Fuel press	
Fuel Pressure/ Fuel:		Type of Ignition:	AUTO	
11. Special requirements: (flame detection devices, safety interlocks etc.)			UV SCANNERS	

Sootblowers:



12. Location	SPACE FOR FUTURE INSTALLATION
13. Manufacture and type	
14. Number	
15. Maximum cleaning radius, mm	
16. Lane dimensions (min. clearance)	
17. Orientation (horizontal or vertical)	
18. Cleaning medium	
19. Supply pressure/temperature	
20. Flow rate per blower, kg/s	
21. Materials of construction	
22. Driver type (manual, air, or elec.)	
23. Control systems type (auto or manual, sequential, local, or remote panel)	

064011

Rev. 4 For 2/4/96

DSHTB.XLS

9-9

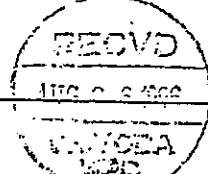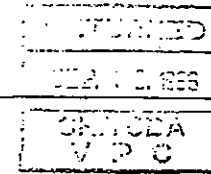

1 : CUSTOMER : BORN HEATERS INTERNATIONAL		
1A: P.O. NO.: 010990-2881		
1B: USER : ARABIAN INDUSTRIAL FIBERS		
1C: JOBSITE : YANBU CITY, SAUDI ARABIA		
1D: ELEVATION : < 305m		
1E: QUAN. REQ'D.: 24		
1F: JOHN ZINK SERIAL NO.: AO-17229-2		
2 : TAG NO'S.: B-602-1 BURNER ASSEMBLY, B-602-2 MORTAR		
ABOVE TAGS PRECEDED BY: UNIT 51-B-06 A/B		
STABILIZER REBOILER		
2A: REF. DWG'G.: B-BU-A17229-602 PSFG-16R BURNER ASSEMBLY		
B-BU-17229-608 PILOT ASSEMBLY		
3 : FUEL GAS:	REFINERY GAS PROPANE	
3A: LHV (KCAL/NM ³):	6,000 21,498	
3B: M.W:	9.83 43.53	
3C: TEMP.: (°C)	60 38	
4 : FUEL OIL:	A B C D E	
4A: LHV (BTU/LB):		
4B: API GR.:		
4C: TEMP.: (°F)		
4D: RECOMMENDED OPERATING VISCOSITY: 250 SSU (MAX)		
5 : PILOT ORIFICE DRILLED: 1/16" DIA		
5A: PILOT GAS PRESSURE: .48 - 1.03 Barg. (NATURAL GAS)		
6 : DRAFT LOSS : 50mm W.C. @ 4.95 MW/HR. W/ 15% X-S AIR @ 15.6 °C.		
7 : HEAT RELEASE PER BURNER (NET):		
7A: MAX.:	4.95 M.W	
7B: NORM.:	4.50 M.W	
7C: MIN.:	1.65 M.W	
TIP DRILLINGS : PRIMARY: (4) #2 MTD F.P. STAGED: (6) 1/16" DIA. IP (2) LTR "B" F.P. (2) #48 MTD. IP.		
DR.: JL	DATE: 1-22-96	CERTIFIED S.N. 6-14-96
CK.:	DATE:	
APP: TMY	DATE: 1-26-96	

DDD:B-A17229-802


DATA SHEET NO.: D-BU-A17229-802

S.O. NO.: AO-17229

BURNER DATA SHEET FOR: PSFG-16R STAGED GAS BURNER ASSEMBLY

HEATER NO.: 51-B-06 A/B STABILIZER REBOILER

CAPACITY - PRESSURE CURVE

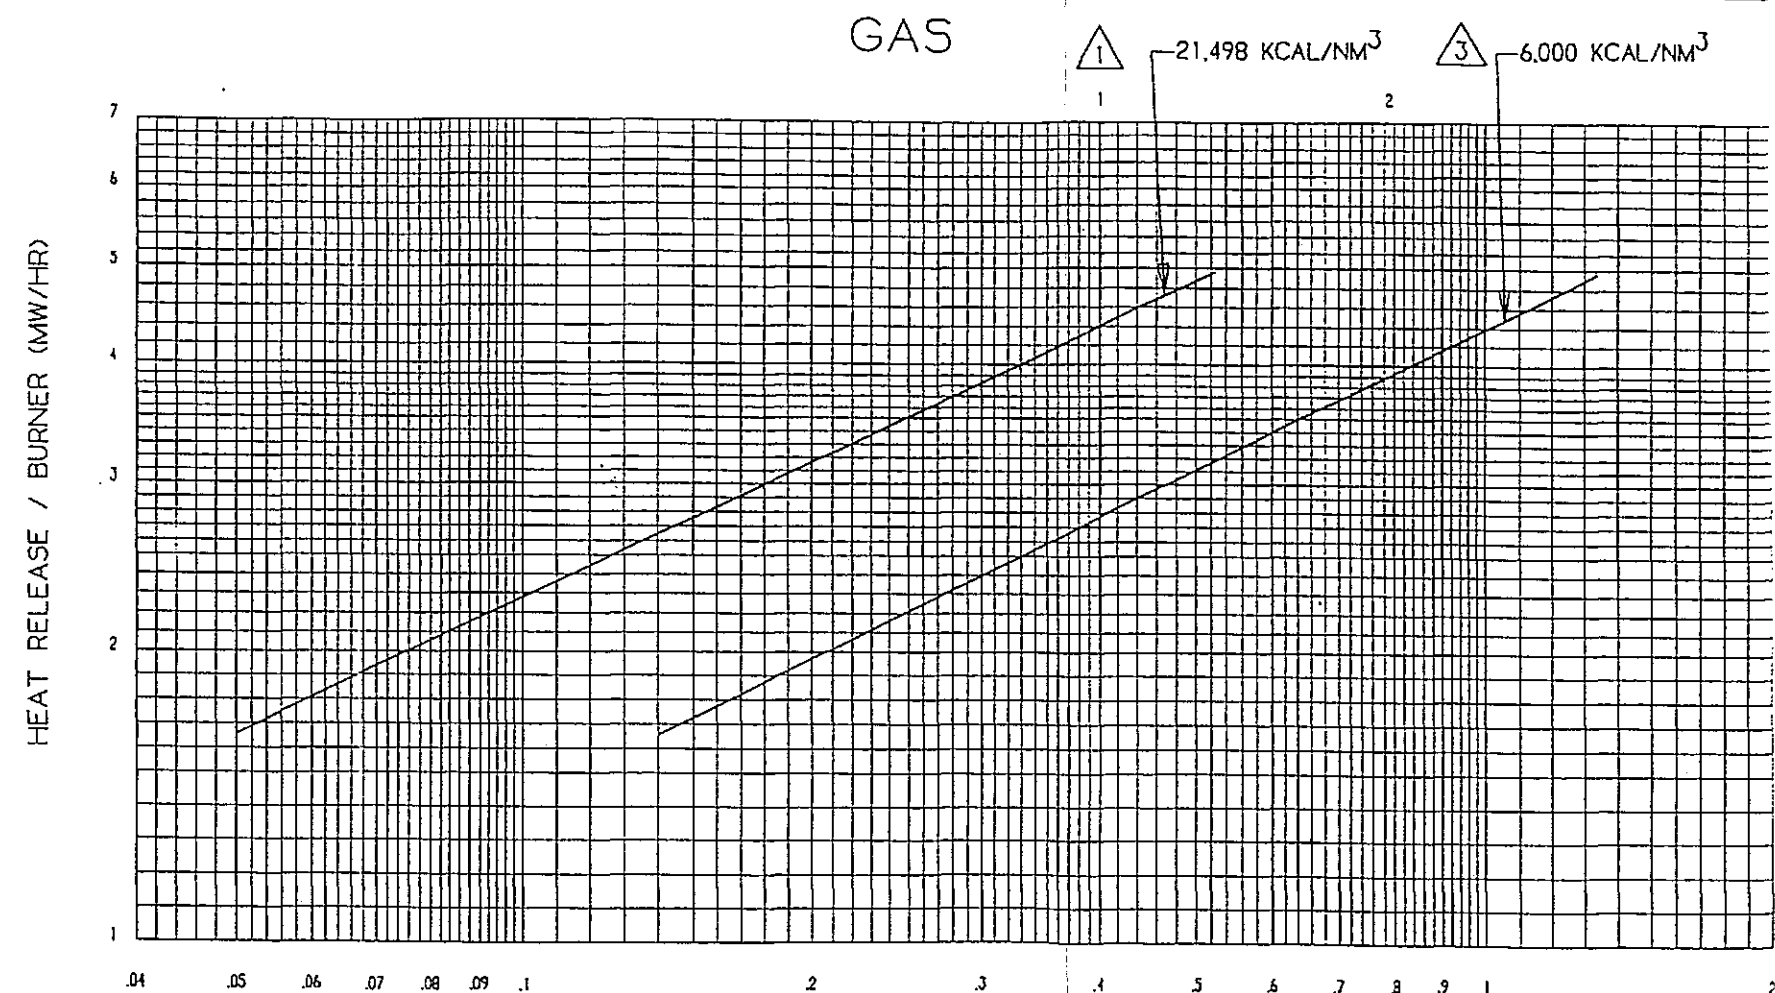

BORN DOCUMENT NO.

JOB NO.	REQN. NO.	ITEM NO.	SUFFIX	REV.
2881	0400	127	AB	03



JOB NO. 51046 IBN RUSHD AROMATICS PROJECT
PO NO. SAYPOE0002
REQ NO. 22854008501
IDENT NO. 22854008501-AC0039


A-NO COMMENTS PROCEED WITH FABRICATION	SAY TEAM
B-PROCEED WITH FABRICATION COMMENTS TO BE CONSIDERED	10/2/96
C-DO NOT PROCEED WITH FABRICATION	DATE 4/2/96
PURCHASER'S PERMISSION TO PROCEED OR REVIEW TAKEN ON VENDOR PRINTS SHALL NOT RELIEVE VENDOR FROM ITS RESPONSIBILITIES OR LIABILITIES UNDER PURCHASE ORDER	

064025


NO.	REVISION DESCRIPTION	BY	CK	APP	DATE
3	REVISED AS NOTED PER CUSTOMER COMMENTS/ VDR 50319	JL	TOM	TMY	8-14-9
2	REV'D TIP DRILLING PER VDR 50414/TEST 6-13-96	JL	TMY	TMY	6-14-9
1	REVISED AS NOTED PER CUSTOMER COMMENTS/ VDR 50270	JL	TOM	TMY	5/16/9
		BY	CK	APP	DATE




CTCI CORPORATION

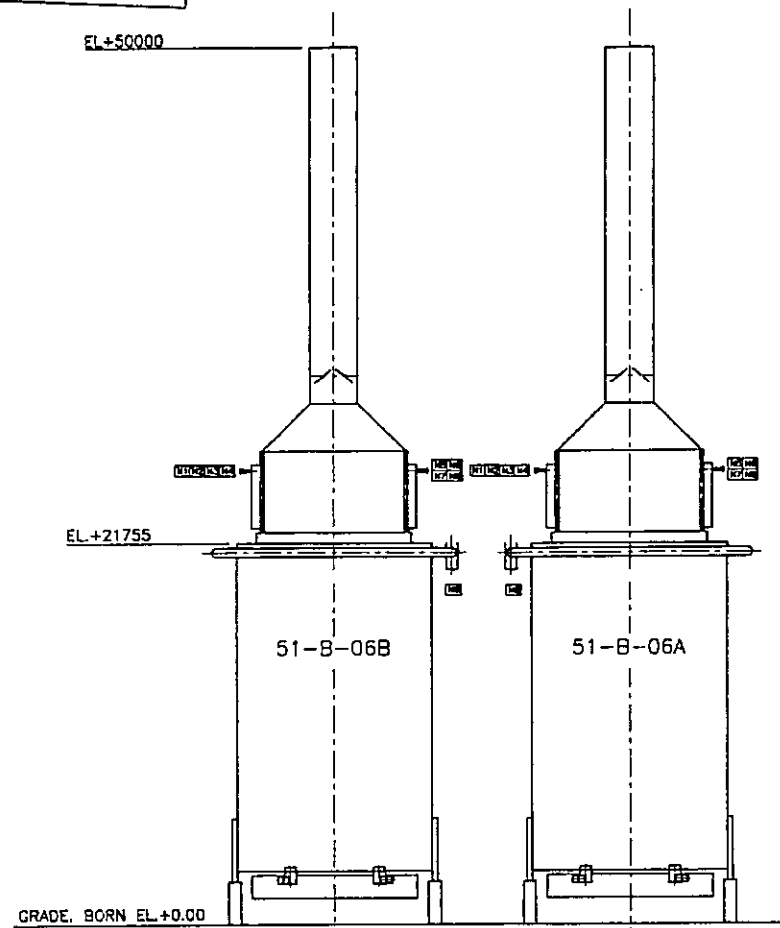

VIEW ON A-A

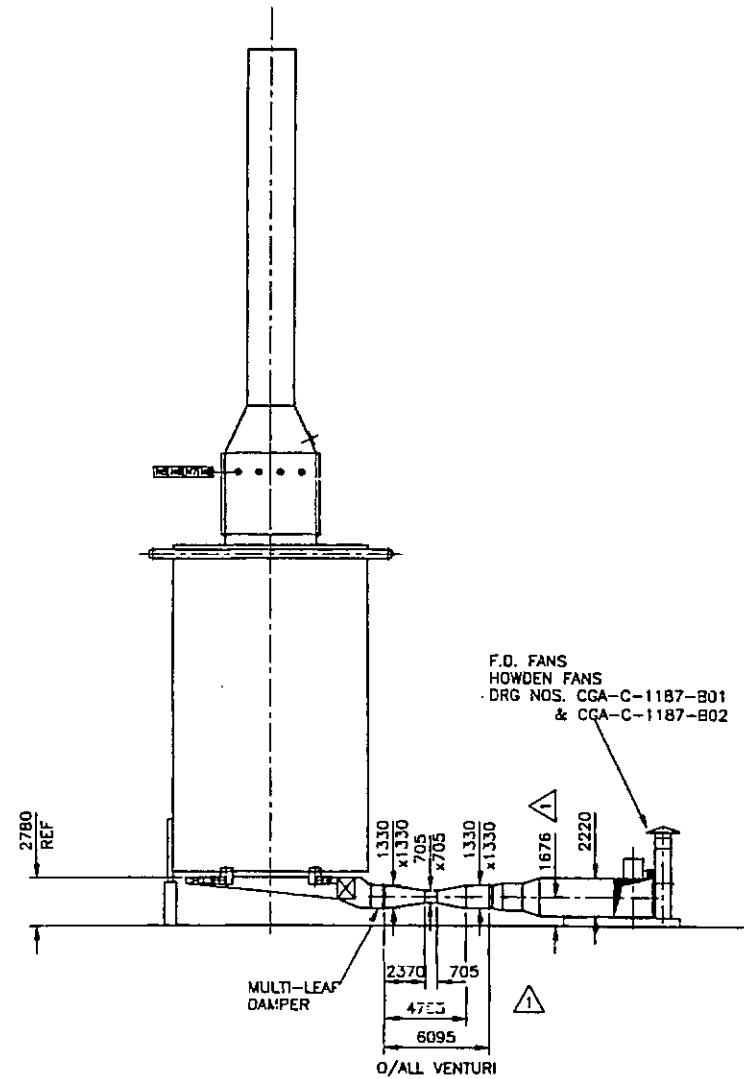

VIEW ON B-B

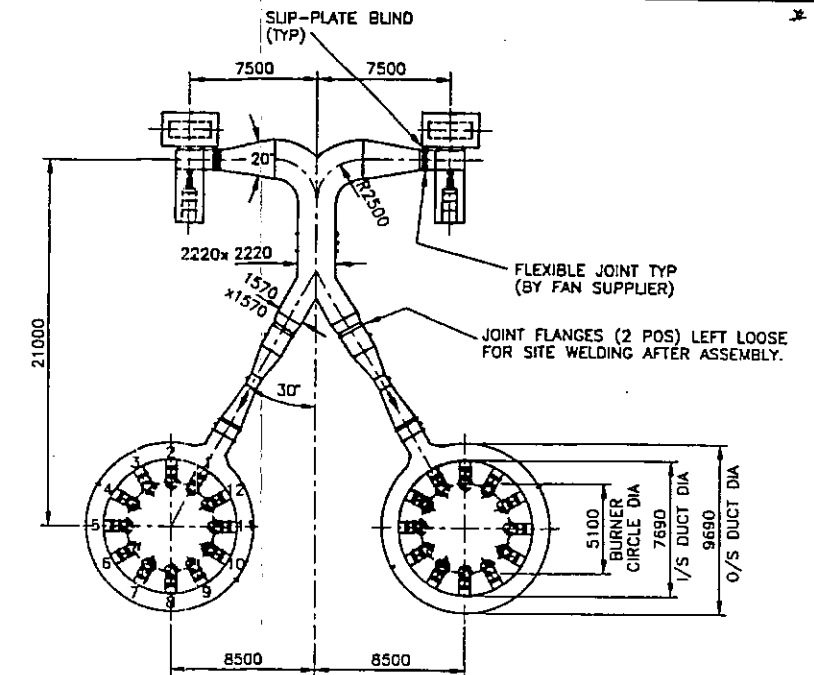


PLENUM DUCT FREE FLOW AREAS


AT BURNER 1,2,12 : 1.23 m²
AT BURNER 3,11 : 1.03 m²
AT BURNER 4,10 : 0.83 m²
AT BURNER 5,9 : 0.60 m²
AT BURNER 6,8 : 0.40 m²
AT BURNER 7 : 0.375 m²

PLAN ON BURNER DUCT

NOTE. ALL DUCT SIZES 1/SIDE STEEL
(DUCT UNLINED)

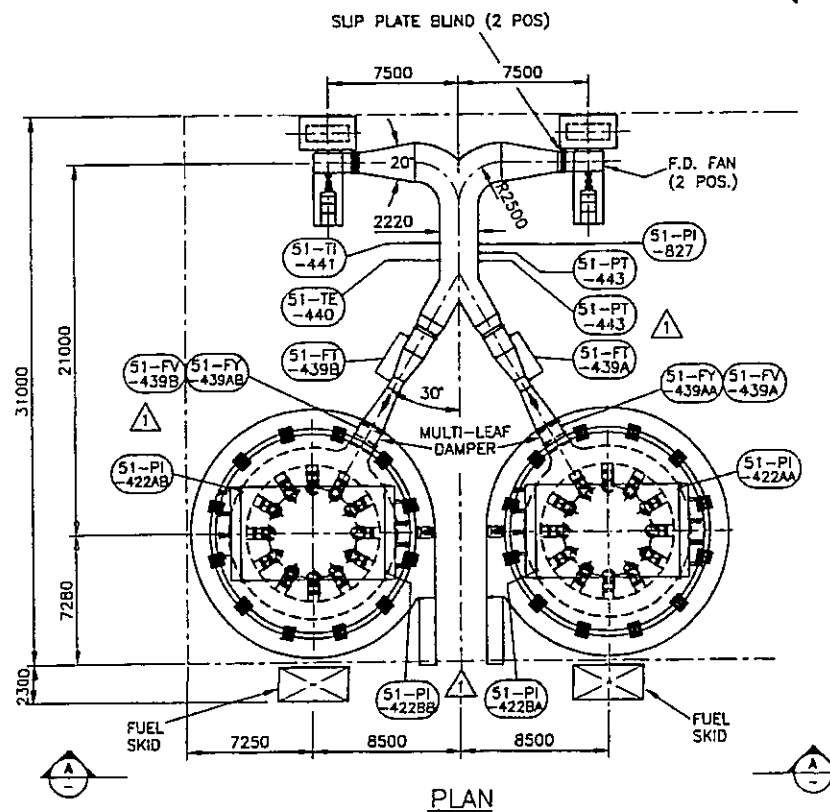


PLAN

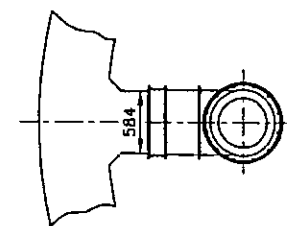

BURNER/DUCT DETAIL

JOHN ZINC BURNER
ORG NO. B-BU-A17229-602

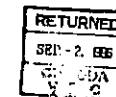

CHYODA	
JOB NO. 51048 IBN RUSHD AROMATICS PROJECT	
PO NO.	SATPOED002
REQ NO.	228540008501
IDENT NO.	228540008501DW0025
A-NO COMMENTS PROCEED WITH FABRICATION	SAT TEAM
B-PROCEED WITH FABRICATION COMMENTS TO BE CONSIDERED	DATE 22/10/96
C-DO NOT PROCEED WITH FABRICATION	DATE 22/10/96
PURCHASER'S PERMISSION TO PROCEED OR REVIEW TAKEN ON VENDOR PRINTS SHALL NOT RELIEVE VENDOR FROM ITS RESPONSIBILITIES OR LIMITS UNDER PURCHASE ORDER	

BORN

DRAWING TITLE			
OVERALL LAYOUT & PLOT			
SERVICE 51-B-06 STRIPPER REBOILER			
FOR IBN RUSHD 064021			
DRAWN	DATE	CHECKED	DATE
STEPHENS	JAN '96	G.T	29.2.96
APPROVED		DATE	
RG		7.3.96	
JOB No. 2881		DRAWING NO. 2881-51B06-01A	
		REV. 1	

FILENAME: X:\DWGS\2881-5106-01A
SCALE: 1:200
ORIGINAL SIZE:


REVISIONS
REV. 1 BY DATE 17.7.96
REV. 2 BY DATE 28.7.96
REV. 3 BY DATE 6/8/96
BURNER PLENUM DETAILS ADDED. FANS RE-POSITIONED.
OTHER REVISIONS PER CLIENT RETURN PRINT DATED 21.5.96.
BURNER PLENUM CENTRE-LINE DIM OF 1676 WAS 1326.

NOTE: THIS DRAWING IS THE PROPERTY OF BORN, BRIGHTON, SUSSEX, U.K. AND SHALL NOT BE TRACED, PHOTOGRAPHED, PHOTOSTATED OR REPRODUCED IN ANY MANNER, NOR USED FOR ANY PURPOSE WHATSOEVER EXCEPT BY WRITTEN PERMISSION OF BORN.



CTCI CORPORATION

FOR TRUE ORIENTATION OF INSTRUMENTS, PLATFORMS ETC. SEE DRGS 2881-51B06-02B & -14A

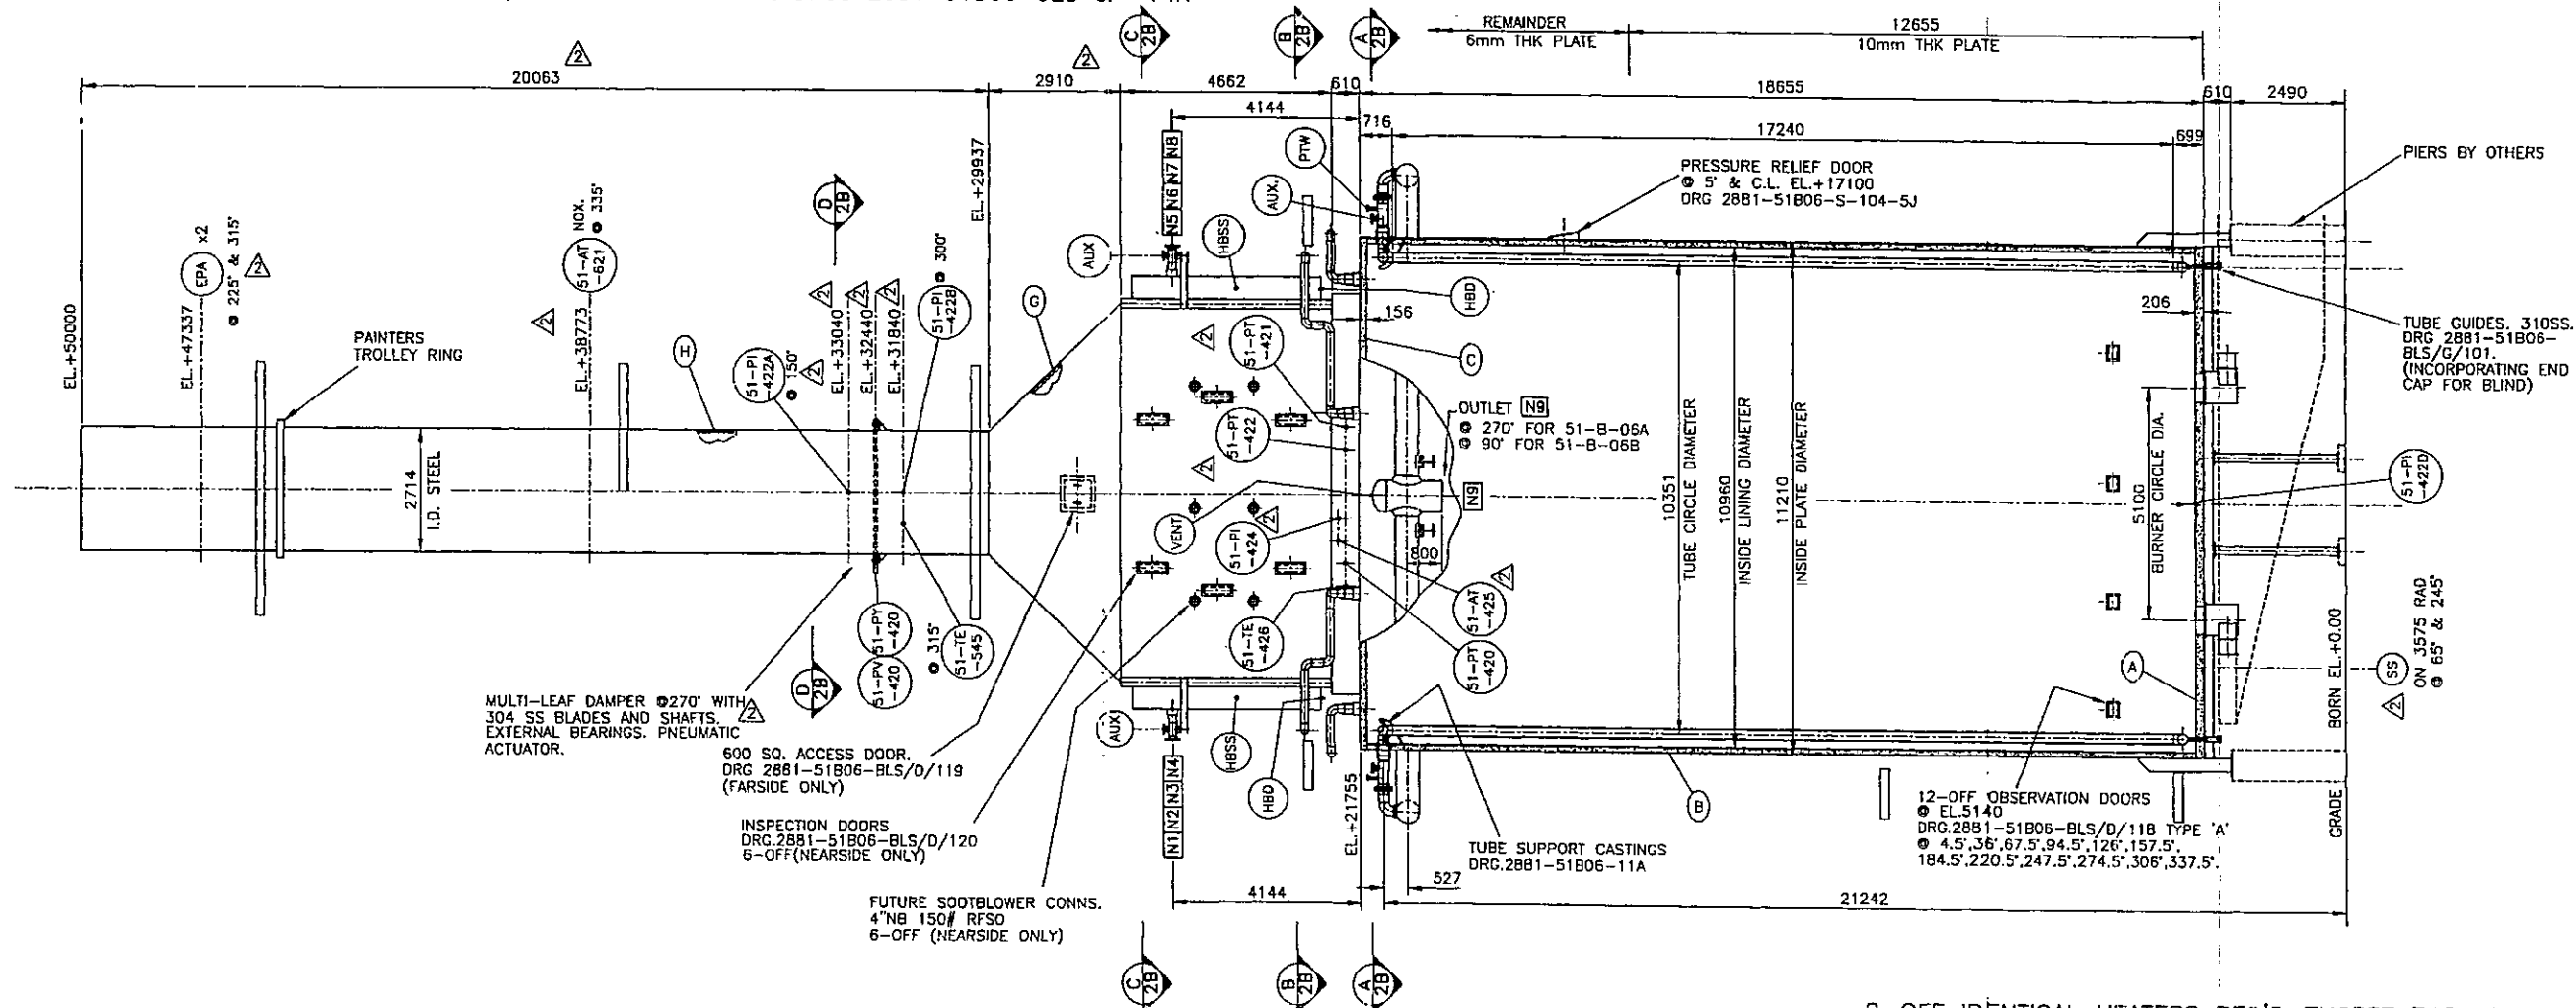

INSTRUMENT TAG NOS SUFFIX A OR B
DEPENDENT ON HEATER E.G.
51-PT-421A HEATER 51-B-06A 51-PT-421B HEATER 51-B-06B

2-OFF IDENTICAL HEATERS REQ'D EXCEPT FOR OUTLET POS'N [N9]
(@ 270° FOR 51-B-06A & @ 90° FOR 51-B-06B) AND
HANDED WALKWAYS - SEE DRG 14A.

NOZZLE SCHEDULE (PER HEATER)			INSULATION SCHEDULE		INSTRUMENT SCHEDULE (PER HEATER)			PROCESS OPERATING DATA			COIL DATA (PER HEATER)		NOTES
TAG	ITEM	DESCRIPTION	TAG	DESCRIPTION	TAG	DESCRIPTION	REMARKS	PROCESS-INLET			RADIANT		1. ALL ELEVATIONS SHOWN ARE FROM GRADE, BORN EL.+0.00.
[N1] TO [N8]	PROCESS INLETS	6"-300# RFWN FLANGE x SCH 40 AW	(A)	RADIANT FLOOR 200mm THK LW CASTABLE	(51-PT-422A) TO	DRAFT GAUGES		TEMPERATURE: 212-°C PRESSURE: 12.8- Barg				80 - 219.1 mm O.D.A. (6" N.B.) X SCH. 40 A.W. TUBES PER A.S.T.M. A106 GRADE B.	
[N9]	PROCESS OUTLET	26"NB x 10mm AW TUBE MAT'L : ASTM A106B BUTT WELD (END BEVELLED)	(B)	RADIANT SIDE WALLS 125 mm THICK. 50mm-128 kg/m ³ + 75mm-98 kg/m ³ CFNB. ANCHORS-STUDS & WASHERS (TP310SS)	(51-PT-4220) INCL.			TEMPERATURE: 224-°C PRESSURE: 9- Barg				CONVECTION	SURFACE PREPARATION & PAINTING DETAILS
			(C)	RADIANT ARCH 150 mm THICK. 50mm-128 kg/m ³ + 100mm-98 kg/m ³ CFNB. ANCHORS-STUDS & WASHERS (TP310SS)	(51-PT-420) PRESS. XMTR			AUXILLARY SCHEDULE (PER HEATER)			144 - 168.3 mm O.D.A. (6" N.B.) X SCH. 40 A.W. TUBES PER A.S.T.M. A106 GRADE B. 9 ROWS WITH 16 TUBES PER ROW (8 PASSES) 3 ROWS BARE 6 ROWS FINNED OVER A LENGTH OF 8305 mm WITH		
MANIFOLD DATA			(D)	CONVECTION SIDE WALLS 125mm THK LW CASTABLE ANCHORS - BULLHORN (304SS)	(51-PT-421) PRESS. XMTR FOR BMS			TAG	QTY.	ITEM	DESCRIPTION	1 ROW @ 12.7 HIGH X 1.3 THK X 118 PER METRE 1 ROWS @ 25.4 HIGH X 1.3 THK X 118 PER METRE 4 ROWS @ 25.4 HIGH X 1.3 THK X 197 PER METRE	HEATER & STACK SECTIONS a) PREPARATION : SHOTBLAST TO SA 2 1/2 b) PRIMER : - PER SPEC. 22854-SP-000-X-000 REV. 1 SYSTEM S2 (PRIME COAT ONLY)
OUTLET MANIFOLD	20"NB x STD WT TUBE MAT'L : ASTM A106B		(E)	CONVECTION END SHEETS 100mm THK LW CASTABLE ANCHORS - BULLHORN (304SS)	(51-TE-426) THERMOCOUPLE AND WELL			AUX	16	AUX. CONN.	3" 300# RFWN FLANGE WITH BLIND	CROSSOVERS	
MAXIMUM ALLOWABLE FORCE & MOMENTS FOR NOZZLE INTERFACES.			(F)	HEADER BOXES 50mm THK LW CASTABLE ANCHORS - BULLHORN (CS)	(51-AT-424) OXYGEN ANALYZER	MOUNTING PLATE ATTACHMENT		HBD	2	HEADER BOX DRAIN	1 1/2" NPT 3000# COUPLING WITH PLUG	168.3 mm O.D.A. (6" N.B.) X SCH. 40 A.W. TUBES PER A.S.T.M. A106 GRADE B.	LADDERS & PLATFORMS a) HOT DIPPED GALVANIZED :- PER ASTM A123
MAXIMUM ALLOWABLE FORCES & MOMENTS ARE 3 TIMES THE VALUE STATED IN API 560			(G)	TRANSITION 75mm THK LW CASTABLE ANCHORS - BULLHORN (CS)	(51-AT-425) COMBUSTIBLE ANALYZER	MOUNTING PLATE ATTACHMENT		HBSS	2	HEADER BOX STEAM SNUFFING	1 1/2" NPT 3000# COUPLING WITH PLUG	COIL WELDS GENERAL 100% OF 100% OF WELDS TO BE RADIOGRAPHED	
			(H)	STACK 50mm THK LW CASTABLE ANCHORS - BULLHORN (CS)	(51-AT-621) NOX. ANALYZER	2"-150# RF FLANGE (304 SS)		PTW	8	PROCESS THERMO.	1" 300# RFLWN FLANGE	BURNERS (PER HEATER)	REFERENCE DRAWINGS
					(51-TE-545) THERMOCOUPLE AND WELL			SS	2	STEAM SNUFFING	2" NPT 3000# COUPLING WITH PLUG		
					(51-AT-420) DAMPER TO STACK			EPA	2	FLUE GAS ANALISER	4" 150# RFSO FLANGE c/w BLIND	12 OFF FORCED DRAUGHT STAGED GAS ONLY BURNERS JOHN ZINC TYPE PSFG-16R	-01A OVERALL LAYOUT & PLOT -02B HEATER GENERAL ARRANGEMENT (ELEV -03A FOUNDATION LOADING PLAN. -11A TUBE SUPPORT CASTINGS. -11B TUBE SUPPORT CASTINGS. -12A CONVECTION COIL DETAILS -12B RADIANT COIL DETAILS. -12C CROSSOVERS/MANIFOLDS -14A LADDER & PLATFORM GENERAL ARRGT
					(51-PT-420) I/P CONVERTER FOR DAMPER			VENT	1	MANIFOLD VENT	1" NPT 3000# COUPLING WITH PLUG		
NOTE: INTERIOR SURFACES OF RADIANT SIDE WALLS AND ARCH TO BE COATED WITH 3mm (WET THICKNESS) OF STALASTIC HIGH TEMPERATURE GRADE PROTECTIVE COATING.													

REV. 4 BY DATE CHECKED DATE APPROVED DATE
REV. 3 BY DATE CHECKED DATE APPROVED DATE
REV. 2 BY DATE CHECKED DATE APPROVED DATE
REV. 1 BY DATE CHECKED DATE APPROVED DATE
NOX. & OXYGEN ANALISERS REPOSITIONED
S.S. CONNS. REPOSITIONED
REVISIONS AS INDICATED
REVISED PER CLIENT RETURN PRINT DATED 12.3.96

NOTE: THIS DRAWING IS THE PROPERTY OF BORN, BRIGHTON, SUSSEX, U.K. AND SHALL NOT BE TRACED, PHOTOGRAPHED, REPRODUCED OR REPRODUCED IN ANY MANNER, NOR USED FOR ANY PURPOSE WHATSOEVER EXCEPT BY WRITTEN PERMISSION OF BORN.

CHUYODA	
JOB NO. 51048	IBN RUSHD AROMATICS PROJECT
PO NO.	SATPDE0002
RLQ NO.	228540008501
IDENT NO.	228540008501DW0026
RETURNED	
OCT. 21. 1996	
CHUYODA V P C	
RECVD	
OCT. 11. 1996	
CHUYODA V P C	
PURCHASER'S PERMISSION TO PROCEED OR REVIEW DRAWING ON VENDOR PRINTS SHALL NOT RELIEVE VENDOR FROM ITS RESPONSIBILITIES OR LIABILITIES UNDER PURCHASE ORDER	

BORN	
DRAWING TITLE	
GENERAL ARRANGEMENT (ELEVATIONS)	
SERVICE	
51-B-06 STRIPPER REBOILER	
FOR	
IBN RUSHD	
DRAWN BY	
DATE	
CHECKED BY	
DATE	
APPROVED BY	
DATE	
JOB No. 2881	
2881-51B06-02A	
REV. 2	

FILENAME: X:\DWGS\2881\5106\02BA
SCALE: 1:75
ORIGINAL SIZE: A1



ARABIAN INDUSTRIAL FIBERS COMPANY

IR-II AROMATICS PROJECT

PROJECT NO. 10E0541A01

DOCUMENT TITLE:

REFORMATE SPLITTER DATA SHEET

DOCUMENT NO:

DS-56-CA-502




						ابن رشد ibn rushd	ARABIAN INDUSTRIAL FIBERS COMPANY YANBU, KINGDOM OF SAUDI ARABIA	CTCI CORPORATION
						CERTIFIED		
2	Issued for Design	LSH	SYL	YSL	31-Mar-11	PROJ.		
1	Revised as Marked	LSH	SYL	YSL	11-Mar-11	MGR	S P L for	DATE 3/31/11
0	Issue For Approval	LSH	SYL	YSL	1-Feb-11	CLIENT	DATE	
REV	DESCRIPTION	BY	CHK.	APPR.	DATE	PAGE 1 OF 2		XC32A-56-502

CONTENTS

<u>ITEM</u>	<u>EQUIPMENT NO.</u>	<u>SHEET NO.</u>	<u>REV. NO.</u>	<u>REV. DATE</u>
1.	56-C-02	1 THRU 2 OF 2	2	31-Mar.-2011

Attachment total 1 page.


 ابن رشد سابك ibn رشد سابك CTCI CORPORATION	REFORMAT SPLITTER DATA SHEET	XC32A-56-502	
		2 OF 2	DATE 31-Mar.-2011 REV. 2

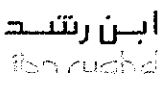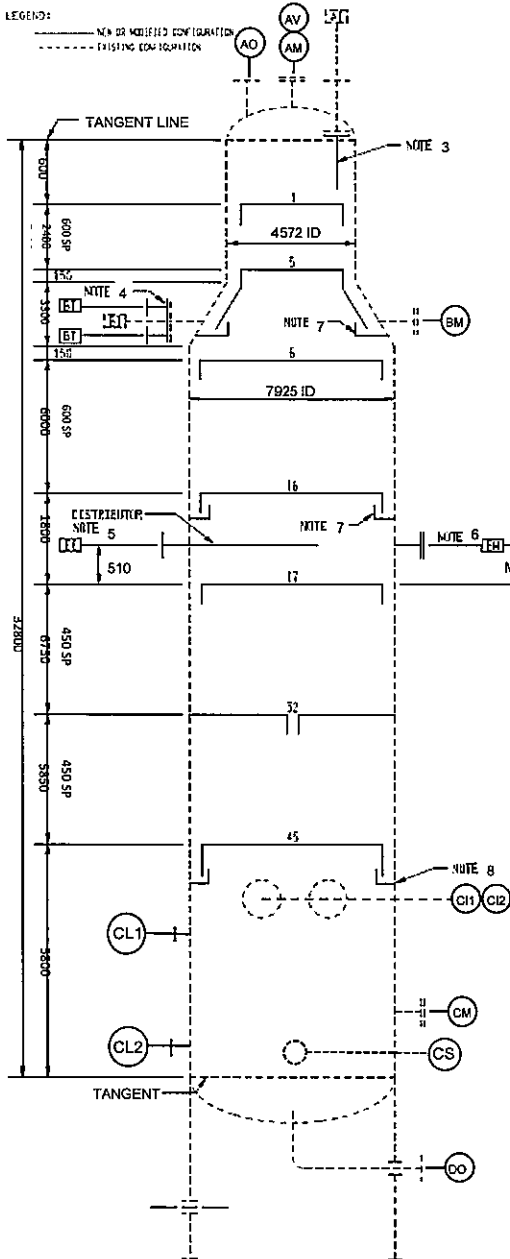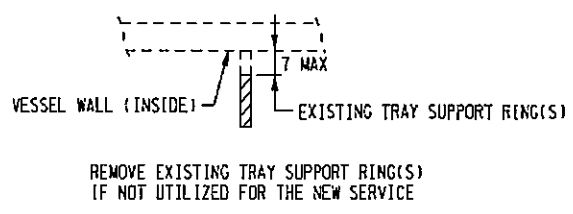 FLUOR		VERTICAL VESSEL DATASHEET		Contract: 10E0541A01 Equip. No.: 56-C-02 Revision: 2 Date: 31-Mar.-2011 Unit: 56 - Sulfolane PO No.: Document No.: DS-56-CA-502 Sheet: 1 of 2		  CTCI CORPORATION		REV																								
1 Client: Arabian Industrial Fibers Company				Plant: Sulfolane																												
2 Service: Reformate Splitter				Site: Yanbu, Kingdom of Saudi Arabia																												
DESIGN SKETCH																																
4 VESSEL DIMENSIONS: ID: 4572 / 7925 mm T/T: 32800 mm																																
5 LEGEND: - NEW OR MODIFIED CONFIGURATION - EXISTING CONFIGURATION																																
																																
DESIGN CONDITIONS																																
Pressure: 3.5 (Note 1) bar(g) at 245 °C Vacuum: FV (Note 15) bar(g) at 215 °C Min. Metal Temp: 9 (Note 25) °C at MAWP bar(g) Liquid Level: Note 16 mm Specific Gravity of Liquid: 0.700 at 204 °C																																
OPERATING CONDITIONS																																
Pressure: Note 23 bar(g) at Note 17 °C Vacuum: bar(g) at °C Low Temperature: °C at °C Hydrogen Partial Press. 0 bar(a) at °C																																
INTERNALS & INSULATION																																
<table border="1"> <thead> <tr> <th>DESCRIPTION</th> <th>Bulk Density kg/m³</th> <th>Liquid Holdup vol%</th> <th>Pressure Drop bar</th> </tr> </thead> <tbody> <tr> <td>Packing:</td> <td></td> <td></td> <td></td> </tr> <tr> <td>Catalyst:</td> <td></td> <td></td> <td></td> </tr> <tr> <td>Mist Eliminator:</td> <td></td> <td></td> <td></td> </tr> <tr> <td>Insulation</td> <td>40 / 50 mmr</td> <td>Hot ☐ Cold ☐</td> <td></td> </tr> <tr> <td>Fire Proofing</td> <td>76 mm</td> <td>Yes ☐ No ☐</td> <td></td> </tr> </tbody> </table>								DESCRIPTION	Bulk Density kg/m³	Liquid Holdup vol%	Pressure Drop bar	Packing:				Catalyst:				Mist Eliminator:				Insulation	40 / 50 mmr	Hot ☐ Cold ☐		Fire Proofing	76 mm	Yes ☐ No ☐		
DESCRIPTION	Bulk Density kg/m³	Liquid Holdup vol%	Pressure Drop bar																													
Packing:																																
Catalyst:																																
Mist Eliminator:																																
Insulation	40 / 50 mmr	Hot ☐ Cold ☐																														
Fire Proofing	76 mm	Yes ☐ No ☐																														
CONSTRUCTION																																
<table border="1"> <thead> <tr> <th></th> <th>Materials</th> <th>Corrosion Allowance</th> </tr> </thead> <tbody> <tr> <td>Shell:</td> <td>SA-516-65</td> <td>3 mm</td> </tr> <tr> <td>Heads</td> <td>SA-516-65</td> <td>3 mm</td> </tr> <tr> <td>Support</td> <td>SA-516-65 / SA-283-C</td> <td>1.6 mm</td> </tr> </tbody> </table>									Materials	Corrosion Allowance	Shell:	SA-516-65	3 mm	Heads	SA-516-65	3 mm	Support	SA-516-65 / SA-283-C	1.6 mm													
	Materials	Corrosion Allowance																														
Shell:	SA-516-65	3 mm																														
Heads	SA-516-65	3 mm																														
Support	SA-516-65 / SA-283-C	1.6 mm																														
SPECIAL CONDITIONS																																
Stress Relieve (Process Reason Only): Yes ☐ No ☒ Vessel in Wet Sour Service: Yes ☐ No ☒ Steamout Required: Yes ☒ No ☐																																
DESIGN SKETCH (CONTINUED)																																
																																
WEIGHTS ARE BASED ON THE VENDOR CERTIFIED DRAWING No. 6T067-0501 REV 4 (1999) (kg)																																
EMPTY 531 900 OPERATING 799 200 FULL OF WATER 2 067 800																																
THICKNESS ARE BASED ON THE VENDOR CERTIFIED DRAWING No. 6T067-0501 REV 4 (1999) (mm)																																
TOP HEAD 25.1 min. SHELL 26-47 BTM HEAD 43.3 min. SKIRT 18																																

سابك
sabik

CTCI CORPORATION

	TAG	QTY	SIZE in	PRESSURE RATING	DESCRIPTION
3	AI	1	10	300# RFWN	REFLUX
4	AM	1	24	300# RFWN	MANWAY
5	AO	1	30	300# RFWN	VAPOR OUTLET
6	AV	1	4	300# RFFN	VENT
7	BI	1	30	300# RFWN	BLANKOFF (NOTES 4, 22)
8	BM	1	48	300# RFWN	MANWAY W / DAVIT
9	CI1/2	2	36	300# RFWN	REB RETURN
10	CL1/2	2	2	300# RFWN	LEVEL
11	CM	1	24	300# RFWN	MANWAY W / DAVIT
12	CS	1	4	300# RFWN	STEAMOUT (Note 26)
13	DO	1	36	300# RFWN	BTMS OUTLET
14					
15	BT1/2	2	1	300# RFLWN	TI-TIC (NEW, NOTE 4)
16	EI	1	10	150# RFWN	INLET FEED (NEW, NOTES 5, 21)
17	EM	1	24	150# RFWN	MANWAY W / DAVIT (NEW, NOTES 6, 21)
18					
19					
33	NOTES:				
34	1) This vessel tag number 56-C-02 is an existing vessel (formerly Cyclar Splitter Item No. 51-C-02), to be re-rated based on new design conditions. Modifications required for the new service are as follows:				
35	2) Remove all existing trays and internals. Install new trays #1-5 and #6-45 as shown. See data sheet DS-56-CA-502T.				
36	3) For existing 10-inch Nozzle "AI" replace existing distributor with new 8-inch distributor per U.O.P. Std. DWG. 3-148.				
37	4) For existing 30-inch nozzle "BI" remove existing internal distributor. CTCI to provide blank-off flange with two (2) installed 1-inch TI-TIC nozzles "BT", as shown, above tray #6.				
38	5) Install new Feed Nozzle "EI" above tray #17 with new distributor per U.O.P. STD DWG 3-150, as shown.				
39	6) Install new Manway Nozzle "EM" above tray #17, as shown.				
40	7) Install new traps below new trays #5 and #16. Traps to be provided by tray supplier.				
41	8) Install new traps below new tray #45, as shown, per U.O.P. STD DWG 3-280.				
42	9) Dimensions are in millimeter unless otherwise noted.				
43	10) Vessel heads are 2:1 Elliptical.				
44	11) For existing vessel details and nozzle elevation and orientation refer to vendor (Hyundai Heavy Industries Co. Ltd.) certified drawing No. 6T067-0501 REV 4 (1996).				
45	12) CTCI to verify the available thickness after evaluating maintenance records and performing UT testing and confirm.				
46	CTCI to provide necessary ASME code documentation for the repair "R" stamp and new nameplate.				
47	13) CTCI to verify that the structural and mechanical condition of the existing vessel, support, and foundation are satisfactory for continuing operation at the revamp design conditions and under current applicable codes and specifications.				
48	14) CTCI to verify existing dimensions in the field.				
49	15) Existing vessel is not designed for external pressure. CTCI to determine the need to add vacuum stiffening rings, and design them as required to meet the new Full Vacuum design condition.				
50	16) Normal liquid level (NLL) is 1750 mm above bottom tangent line. HLL = 2664 mm LLL = 836 mm.				
51	17) Operating Temperature. Top: 125°C. Bottom: 215°C.				
52	18) Total vessel pressure differential = 0.42 bar.				
53	19) Applicable specifications: SP-000-AA-5002, 22854-SP-000-A-003, 22854-SP-000-A-004, 22854-SP-000-D-001, 22854-SP-000-W-001, 22854-SP-000-W-002, 22854-SP-000-W-003, P01-E07, T01-S01, 3-11.				
54	20) The following UOP standard drawings are applicable: 3-148, 3-150, and 3-280.				
55	21) CTCI to design and furnish new ladder(s) and platform(s) for access to new nozzle "EI" and manway "EM".				
56	22) CTCI to restore handrail on platform below nozzle "BI" after demolition of existing piping.				
57	23) Operating pressure : Top : 1.71 bar(g) Bottom : 2.17 bar(g).				
58	24) Nozzles must not be located in downcomers.				
59	25) The Min. Design Ambient Temperature should be 6°C.				
60	26) Steamout at 150 (232 max.) °C and 3.5 (4.1 max.) bar (g)				
61					
62					
63					
64					
65					
66					
67					

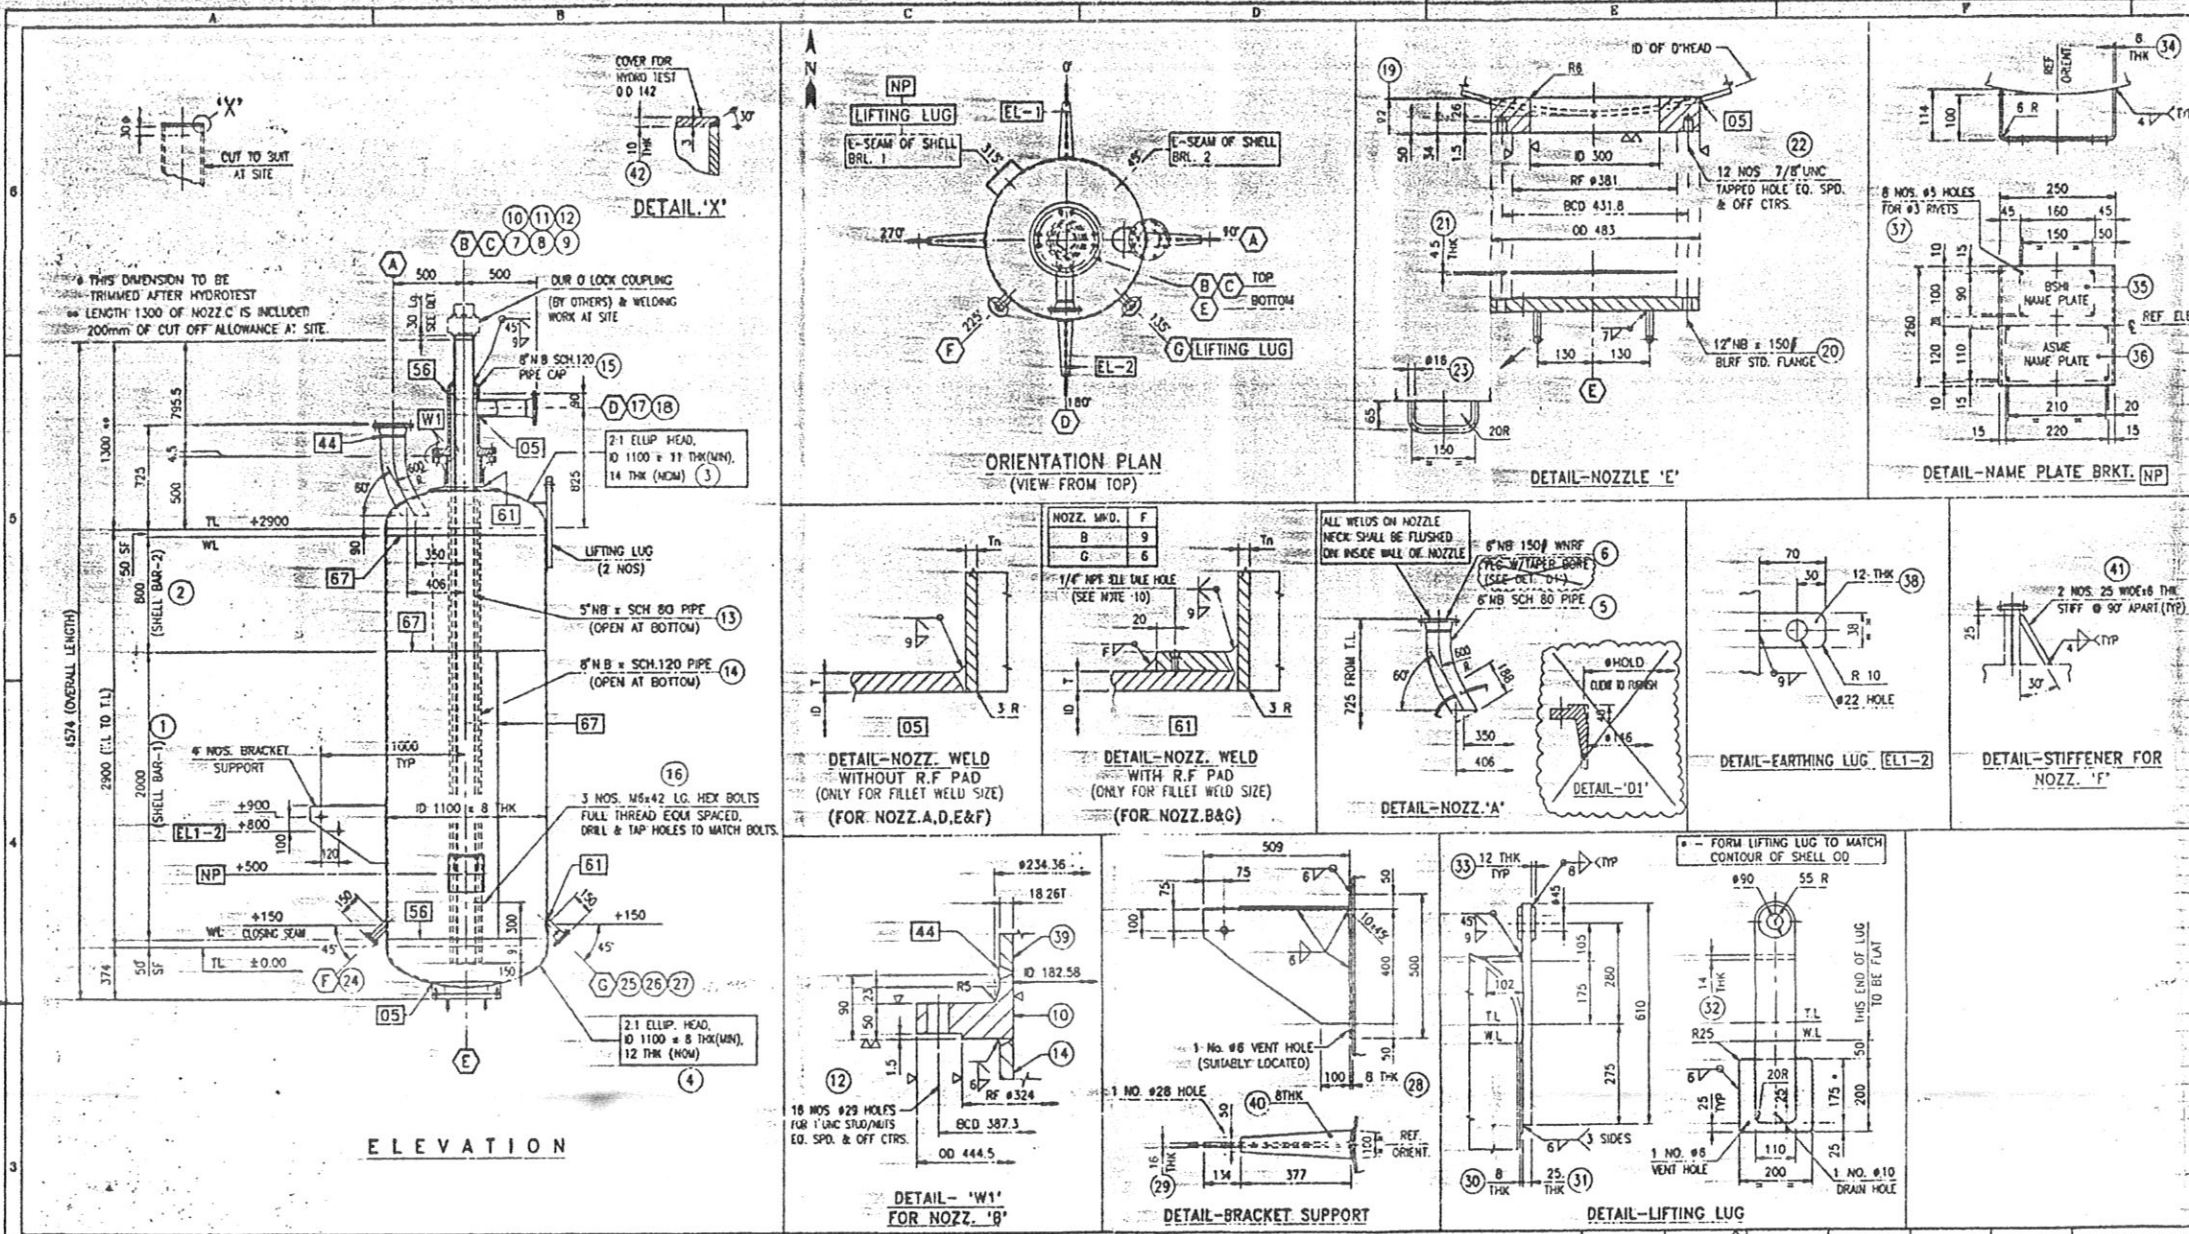

LIST OF MATERIAL									
ITEM NO.	DESCRIPTION	LENGTH	WIDTH	THICK	WT. IN KG.	MAT'L	MAT'L CODE	QTY.	NO.
1	COVER PL. #142	0	0	10.0	1.3	ASME	SA106G70	1	1
2	STIFF (CUT TO SIZE)	0	0	8.0	0.2	0.4	SA106G70	1	2
3	SUPP. PLATE	377	100	8.0	2.4	8.8	SA106G70	1	3
4	PI 8" 120-C	321	0	0.0	20.8	20.8	SA106G70	1	4
5	2" EARTHING LUG	70	38	12.0	0.3	0.8	SA106G70	1	5
6	8" RIVET #5	15	0	0.0	0.0	0.0	COPPER	1	6
7	ASME NAME PLATE	220	120	3.0	0.6	0.6	SA106G70	1	7
8	BSH NAME PLATE	160	100	3.0	0.4	0.4	SA106G70	1	8
9	NAME PLATE BRKT.	470	260	6.0	5.8	5.8	SA106G70	1	9
10	PLATE 90/45/120	0	0	0.0	0.5	2.0	SA106G70	1	10
11	PLATE	110	102	14.0	1.2	2.4	SA106G70	1	11
12	LIFTING LUG PLATE	610	110	25.0	15.2	20.4	SA106G70	1	12
13	2" PAD	200	200	8.0	2.5	5.0	SA106G70	1	13
14	PLATE	500	400	18.0	28.1	102.4	SA106G70	1	14
15	PAD PLATE	500	100	8.0	3.1	12.4	SA106G70	1	15
16	PI 150/100/80-B	0	0	0.0	2.8	2.8	SA106G70	1	16
17	PI 2" 150-C	127	0	0.0	1.4	1.4	SA106G70	1	17
18	RF 150/70/80-B	0	0	0.0	0.8	0.8	SA106G70	1	18
19	PI 150/70/80-B	176	0	0.0	2.6	2.6	SA106G70	1	19
20	HANDLE #16-E	263	0	0.0	0.4	0.8	SA106G70	1	20
21	ST/INT 7/8 UNC-E	100	0	0.0	0.6	9.8	SA106G70	1	21
22	OK 12/150/80-E	0	0	0.0	0.0	0.0	SA106G70	1	22
23	OK 12/150/80-E	0	0	0.0	0.0	0.0	SA106G70	1	23
24	FORCING (SEE DWG)-E	0	0	0.0	8.1	8.1	SA106G70	1	24
25	FF 150/100/80-B	0	0	0.0	6.8	6.8	SA106G70	1	25
26	PI 4" 120-D	353	0	0.0	7.8	7.8	SA106G70	1	26
27	BT WE (FULL THREAD)	42	0	0.0	0.0	0.0	SA106G70	1	27
28	CHP 8" 120-C	0	0	0.0	7.6	7.6	SA106G70	1	28
29	PI 8" 120-C	3521	0	0.0	318.4	318.4	SA106G70	1	29
30	PI 5" 80-C	4355	0	0.0	154.9	154.9	SA106G70	1	30
31	ST/INT 7" UNC-B	150	0	0.0	1.0	20.0	SA106G70	1	31
32	OK 12/150/80-B	0	0	0.0	0.0	0.0	SA106G70	1	32
33	FF 150/100/80-B	0	0	0.0	40.9	40.9	SA106G70	1	33
34	PI 10" 80-B	118	0	0.0	11.3	11.3	SA106G70	1	34
35	RF 150/283/131-B	0	0	0.0	14.4	14.4	SA106G70	1	35
36	FF 150/100/80-B	0	0	0.0	10.8	10.8	SA106G70	1	36
37	PI 8" 80-A	678	0	0.0	24.7	24.7	SA106G70	1	37
38	EN 80/100/141/110	0	0	0.0	14.3	14.3	SA106G70	1	38
39	EN 80/100/141/110	0	0	0.0	14.0	14.0	SA106G70	1	39
40	2" SHELL BRK. 2	3481	800	8.0	174.9	174.9	SA106G70	1	40
41	2" SHELL BRK. 1	287	200	8.0	13.2	13.2	SA106G70	1	41

BELLELI REFERENCE DRAWINGS	
DA-7034-08-002	FORMED HEAD - TOP
DA-7034-08-003	FORMED HEAD - BOTTOM
DA-7034-08-004	BSH NAME PLATE
DA-7034-08-005	ASME NAME PLATE
ST-7034-08-001 FINISH REQUIREMENTS	
12	HEAD SEAMS SHALL BE FULLY RADIOGRAPHED. HEAD TO SHELL SEAMS SHALL BE SPOT RADIOGRAPHED PER UW-11(a)(5)(b) OTHER SEAMS SHALL BE SPOT RADIOGRAPHED PER UW-11(b).
13	FOR CARBON AND CARBON MANGANESE STEEL THE CARBON CONTENT SHALL BE LIMITED TO 0.25% MAXIMUM.
14	THE LONGITUDINAL BUTT WELD OF NOZZLES FABRICATED FROM PLATE SHALL BE 100% RADIOGRAPHED.
15	MARK INDICATES THE BSH WELD STANDARD NUMBER.
16	MARK INDICATES THE POSITION NUMBER WITH REFERENCE TO LIST OF MATERIAL.
17	MARK INDICATES THE NOZZLE MARK NUMBER.
18	SHOP HYD. TEST GASKETS - () BLUNDED NOZZLES WILL HAVE JOB GASKETS.
19	(x) ALL OTHER NOZZLES WILL HAVE CAF GASKET.
20	SPARE PARTS: ITEMS COMMISSIONING/STARTUP OPERATIONAL SHOP HYD. TEST
21	GASKETS 200% 100% 100%
22	FASTENERS 10X(MIN. 2 SETS) 10X(MIN. 2 SETS) NOT REQUIRED
23	QTY. OF SPARES FOR GASKETS AND FASTENERS ARE INCLUDED IN LIST OF MATERIALS.
24	ALL BOLTS & NUTS SHALL BE OF UNC SERIES UPTO & INCLUDING 1" SIZE & RUN ABOVE 1" SIZE.
25	FLANGES UPTO & INCLUDING 24" NB SHALL BE AS PER ANSI B16.5 & THE FLANGE FACE FINISH SHALL BE 3.2 TO 6.3 MICROMETER.
26	MINIMUM TEMPERATURE OF HYDROTEST WATER SHALL BE 17°C AND THE TEST PRESSURE SHALL BE HELD FOR HALF AN HOUR PER INCH OF THICKNESS WITH ONE HOUR MINIMUM.
27	EACH REINFORCING PAD OR SEGMENT THEREOF SHALL BE PROVIDED WITH ONE NO. (TWO NOS FOR NOZZLES 16" NB AND ABOVE @ 180° APART) 1/4" NPT. TELL TALE HOLE AS PER ANSI B1.20.1. ALL R.F. PAD WELDS SHALL BE TESTED TO 15 PSI. MINIMUM WITH AIR & SOAPY BUBBLE TEST.
28	A PERMANENT REFERENCE WORKLINE FOR VERTICAL VESSELS BOTTOM TAN LINE SHALL BE PUNCHMARKED AROUND THE VESSEL PERIMETER AT 0.90, 180 & 270° AND HORIZONTAL VESSELS CENTER LEVEL SHALL BE PUNCHMARKED ON BOTH SIDE SURFACES OF SHELL NEAR THE HEAD.
29	THE VESSEL SHALL BE THOROUGHLY CLEANED INSIDE & OUTSIDE AND SHALL BE FREE OF ALL DIRT, WELD ROD STUBS & LOOSE FOREIGN MATERIALS ETC.
30	ALL REMOVABLE INTERNALS SHALL PASS THROUGH THE NEAREST MANHOLE.
31	WELD SEAMS COMING UNDER WISC. ATTACHMENTS SHALL BE GROUND SMOOTH & RADIOGRAPHED FOR A DISTANCE OF 150mm BEYOND THE ATTACHMENT WELD.
32	ALL NOZZLES AND MANWAY THAT DO NOT EXTEND INTO THE VESSEL SHALL BE FINISHED FLUSH WITH THE INSIDE & THE INNER EDGE SHALL BE ROUNDED OFF TO A MIN. 3mm RADIUS.
33	NOZZLE POSITIONS ON VESSEL ELEVATIONS ARE CONVENTIONAL FOR TRUE LOCATION.
34	SEE NOZZLE ORIENTATION PLAN.
35	NOZZLE PROJECTION IS FROM CENTER LINE OF VESSEL TO GASKET FACE OF FLANGE UNLESS SPECIFIED OTHERWISE.
36	ALL FLANGE BOLT HOLES SHALL STRADDLE VERTICAL AND/OR NORTH SOUTH CENTER LINES UNLESS SHOWN OTHERWISE.
37	ALL DIMENSIONS ARE IN MILLIMETERS UNLESS OTHERWISE SPECIFIED.

GENERAL NOTES	
1	ALL DIMENSIONS ARE IN MILLIMETERS UNLESS OTHERWISE SPECIFIED.
2	ALL FLANGE BOLT HOLES SHALL STRADDLE VERTICAL AND/OR NORTH SOUTH CENTER LINES UNLESS SHOWN OTHERWISE.
3	NOZZLE PROJECTION IS FROM CENTER LINE OF VESSEL TO GASKET FACE OF FLANGE UNLESS SPECIFIED OTHERWISE.
4	NOZZLE POSITIONS ON VESSEL ELEVATIONS ARE CONVENTIONAL FOR TRUE LOCATION.
5	SEE NOZZLE ORIENTATION PLAN.
6	ALL NOZZLES AND MANWAY THAT DO NOT EXTEND INTO THE VESSEL SHALL BE FINISHED FLUSH WITH THE INSIDE & THE INNER EDGE SHALL BE ROUNDED OFF TO A MIN. 3mm RADIUS.
7	WELD SEAMS COMING UNDER WISC. ATTACHMENTS SHALL BE GROUND SMOOTH & RADIOGRAPHED FOR A DISTANCE OF 150mm BEYOND THE ATTACHMENT WELD.
8	ALL REMOVABLE INTERNALS SHALL PASS THROUGH THE NEAREST MANHOLE.
9	THE VESSEL SHALL BE THOROUGHLY CLEANED INSIDE & OUTSIDE AND SHALL BE FREE OF ALL DIRT, WELD ROD STUBS & LOOSE FOREIGN MATERIALS ETC.
10	A PERMANENT REFERENCE WORKLINE FOR VERTICAL VESSELS BOTTOM TAN LINE SHALL BE PUNCHMARKED AROUND THE VESSEL PERIMETER AT 0.90, 180 & 270° AND HORIZONTAL VESSELS CENTER LEVEL SHALL BE PUNCHMARKED ON BOTH SIDE SURFACES OF SHELL NEAR THE HEAD.
11	EACH REINFORCING PAD OR SEGMENT THEREOF SHALL BE PROVIDED WITH ONE NO. (TWO NOS FOR NOZZLES 16" NB AND ABOVE @ 180° APART) 1/4" NPT. TELL TALE HOLE AS PER ANSI B1.20.1. ALL R.F. PAD WELDS SHALL BE TESTED TO 15 PSI. MINIMUM WITH AIR & SOAPY BUBBLE TEST.
12	MINIMUM TEMPERATURE OF HYDROTEST WATER SHALL BE 17°C AND THE TEST PRESSURE SHALL BE HELD FOR HALF AN HOUR PER INCH OF THICKNESS WITH ONE HOUR MINIMUM.
13	FLANGES UPTO & INCLUDING 24" NB SHALL BE AS PER ANSI B16.5 & THE FLANGE FACE FINISH SHALL BE 3.2 TO 6.3 MICROMETER.
14	ALL BOLTS & NUTS SHALL BE OF UNC SERIES UPTO & INCLUDING 1" SIZE & RUN ABOVE 1" SIZE.
15	QTY. OF SPARES FOR GASKETS AND FASTENERS ARE INCLUDED IN LIST OF MATERIALS.
16	SPARE PARTS: ITEMS COMMISSIONING/STARTUP OPERATIONAL SHOP HYD. TEST
17	GASKETS 200% 100% 100%
18	FASTENERS 10X(MIN. 2 SETS) 10X(MIN. 2 SETS) NOT REQUIRED
19	MARK INDICATES THE BSH WELD STANDARD NUMBER.
20	MARK INDICATES THE POSITION NUMBER WITH REFERENCE TO LIST OF MATERIAL.
21	MARK INDICATES THE NOZZLE MARK NUMBER.
22	THE LONGITUDINAL BUTT WELD OF NOZZLES FABRICATED FROM PLATE SHALL BE 100% RADIOGRAPHED.
23	FOR CARBON AND CARBON MANGANESE STEEL THE CARBON CONTENT SHALL BE LIMITED TO 0.25% MAXIMUM.
24	HEAD SEAMS SHALL BE FULLY RADIOGRAPHED. HEAD TO SHELL SEAMS SHALL BE SPOT RADIOGRAPHED PER UW-11(a)(5)(b) OTHER SEAMS SHALL BE SPOT RADIOGRAPHED PER UW-11(b).

</											

TOP HEAD		STRESS RELIEVING 		205°C / HR ABOVE 427°C		60 Minutes		260°C / HR UPTO 427°C		AS PER BELLELI STD. PROCEDURE PR-HIT-001	
Part	Procedure	Holding Temp °C	Heating rate °C/h	Holding time min	Cooling rate °C/h	Temperature measured furnace/port Qty at Sensors					
HEAT TREATMENT											
33	FABRICATION WEIGHT		Kg			1900					
32	FULL OF WATER WEIGHT		Kg			6300					
31	OPERATING WEIGHT		Kg			5500					
30	ERECTION WEIGHT		Kg			2000					
29	MANUFACTURER'S SERIAL No.		---			2574					
28	MANUFACTURER'S JOB NUMBER		---			7034-08					
27	MANUFACTURER'S NAME		---			BELLELI SAUDI HEAVY IND. LTD.					
26	CODE STAMP		---			YES					
25	DESIGN CODE		---			ASME SEC VIII DIV.1 1995 EDITION					
24	SERVICE		---			LIFT ENGRGR. NO. 2					
23	VOLUME		m ³			3.11					
22	FIREPROOFING		mm			NO					
21	INSULATION		mm			NO					
20	SPECIFIC GRAVITY										
19	OPERATING FLUID		---			NITROGEN&CATALYST					
18	INSPECTION AUTHORITY		---			CLIENT/AHS					
17	WIND SPEED/EXPOSURE CATEGORY		km/hr			125/C					
16	EARTHQUAKE DESIGN		---			ASCE 7-88 ZONE 1					
15	MINIMUM DESIGN METAL TEMPERATURE		°C			9					
14	CHARPY IMPACT TEST		---			NO					
13	ULTRASONIC EXAMINATION		---			NO					
12	POST WELD HEAT TREATMENT		---			NO					
11	JOINT EFFICIENCY (SHELL/HEAD)		%			85/100					
10	RADIOGRAPHY (SHELL/HEAD)		---			R14 AS PER UG 116(c) (SEE NOTE-13)					
9	CORROSION ALLOWANCE		mm			3.0					
8	M.A.W.P. AT DESIGN TEMPERATURE		barG			8.84 (LIMITED BY SHELL)					
7	M.A.P. (NEW & COLD)		barG			14.79 (LIMITED BY SHELL)					
6	HILD HYDROTEST PRESSURE (CORRODED)		barG			13.26					
5	SHOP HYDROTEST PRESSURE (HOR)		barG			22.08 (TOP)					
4	OPERATING TEMPERATURE		°C			58					
3	OPERATING PRESSURE		barG								
2	DESIGN TEMPERATURE		°C			260					
1	DESIGN PRESSURE		barG			3.5					
No	DESIGN CONDITIONS			UNITS		VALUES					

JOB NO. 54001 BN RUSH INDUSTRIES PROJECT		CITYODATA PETROSTAR LTD.	
PO NO. SAT-POPO001		DATE	
REQ NO. MR-50-D-011		DATE	
IDENT NO. 52003-DW-0001		DATE	
TARE (GROSS WEIGHT)		TARE (GROSS WEIGHT)	
TARE (NET WEIGHT)		TARE (NET WEIGHT)	
TARE (TARE WEIGHT)		TARE (TARE WEIGHT)	
TARE (TARE WEIGHT)		TARE (TARE WEIGHT)	
TARE (TARE WEIGHT)			

CLIENT : IBN RUSHD
PROJECT : PTA & AROMATICS -
TITLE : AROMATICS
JOB NO. : 51046
DOC. NO. : **D5-52-D-003 (V1)**

REVISIONS					
MARK	APRD	CHKD	DATE	BY	REVISIONS
1					
2					
3					
4					

FOR RECORD

UOP

25 East Algonquin Road • PO Box 5017 • Des Plaines, Illinois 60017-5017 • USA

VESSELS

SERVICE LIFT ENGAGER NO. 2

ITEM NO D-5203 52-17-03

Design	INT 3.5 BAR (g)	@	260°C
Conditions	EXT	@	°C
At Top	Min Metal Temperature		9°C
Operating			38°C
Conditions			°C

Radiograph	MR
Postweld Heat Treat	MR
Joint Efficiency	MR %

Material Specifications

Heads	SA 516-70
Shell	SA 516-70

Shell	Thickness Reqd By Code-mm	Corrosion + Allowance mm (Min)
		3

Heads	3
-------	---

Vessel Heads Top: 2:1 Elliptical
Bottom: 2:1 Elliptical

Accessories Applied by Fabricator

Ladder & Platform Clips	NO
Insulation Clips & Rings	NO
Vessel Support	YES

Nozzles and Manways

Mark	No	Size Inches	Service
A	1	6	CATALYST INLET
B	1	10	OUTLET
C	1	5	LIFT PIPE
D	1	4	GAS INLET
E	1	12	CLEANOUT WITH BLIND
F	1	1	SAMPLE
G	1	2	DRAIN

Class-ANSI CL150


Facing-RAISED FACE

EXCEPT NOZZLES

ANSICL300

DUR O LOK COUPLING

STUDDED CONNECTION (PAD TYPE NOZZLE)

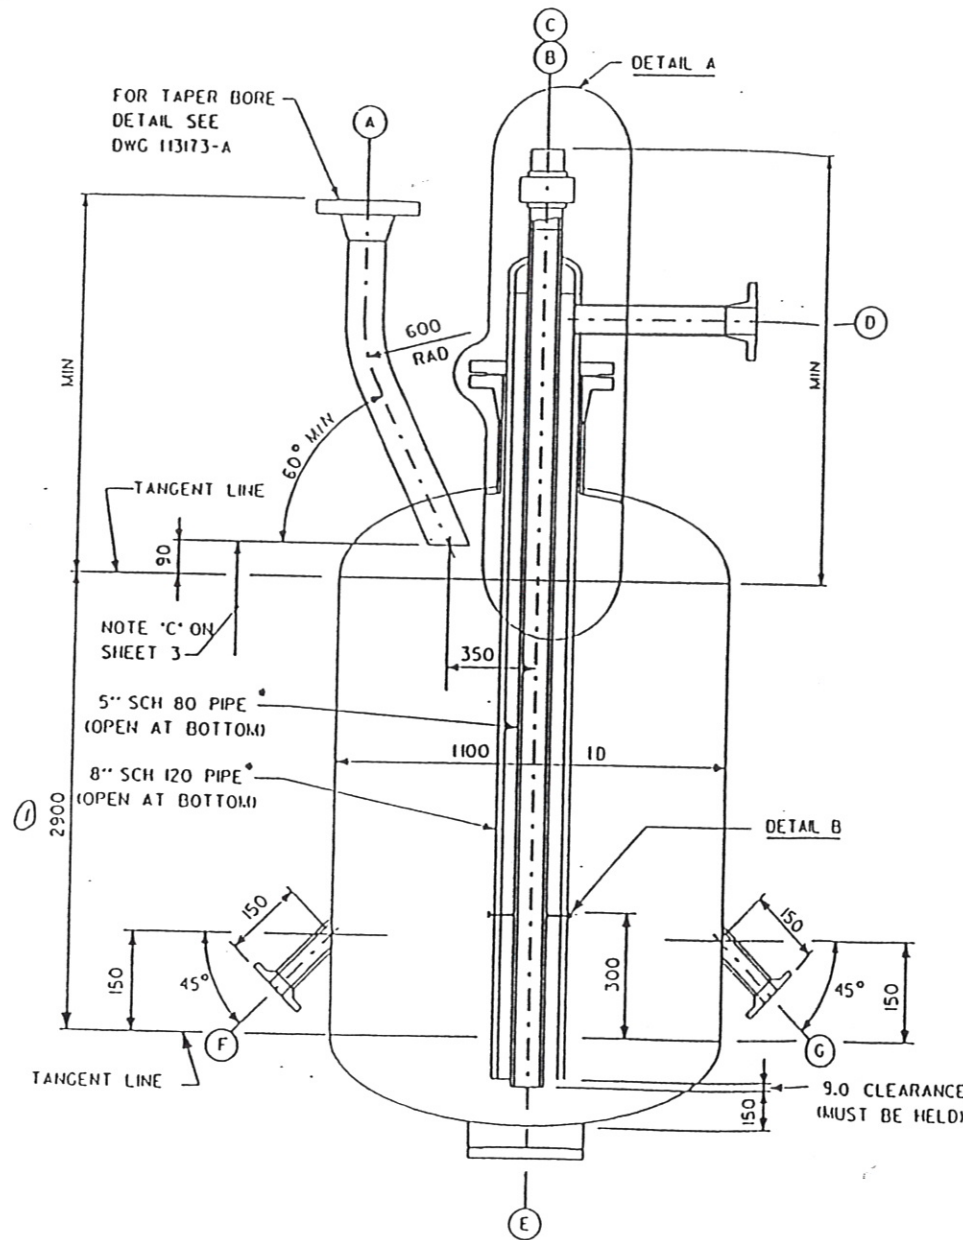

ELEVATION

Drawings Referred to in this Specification

113173-A-0

NOTES:


- NOZZLE 'A' TO BE OF BUILT-UP CONSTRUCTION USING SCH 80 PIPE AND WELDING NECK FLANGE BORED TO SCH 80. SEE NOTE 'E' ON SHEET 4.
- NOZZLE 'C' TO BE OF BUILT-UP CONSTRUCTION USING SCH 80 PIPE AND DUR O LOK COUPLING BORED TO SCH 80. SEE NOTES 'E' AND 'F' ON SHEET 4.

PROJECT SPECIFICATION


560690 - 301 - 1

SHEET 7

REV	DATE	BY	APP'D	REV	DATE	BY	APP'D
0	5/15/95						
1	11/28/95	ZD	ESL				

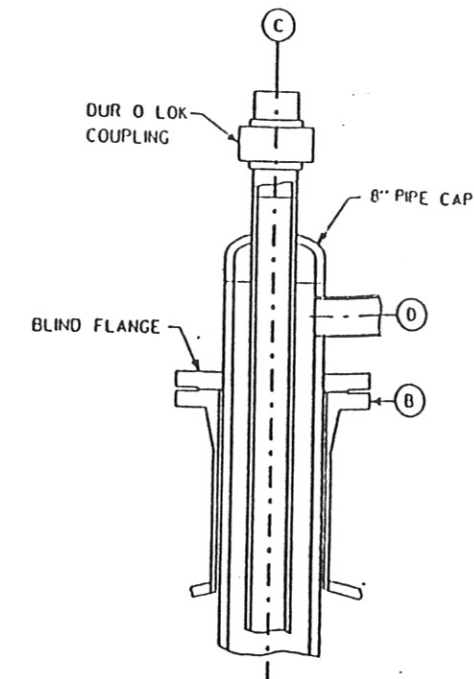

DETAIL A

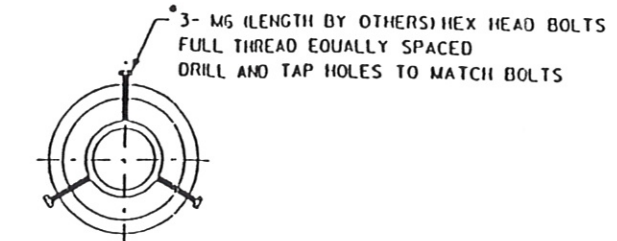


DETAIL B

- PROVIDE BOLT LENGTH TO KEEP PIPES CONCENTRIC AND TO ENABLE, WITHOUT INTERFERENCE, REMOVAL AND INSERTION OF LIFT PIPE ASSEMBLY THROUGH NOZZLE 'B'. SCHEDULE AND SIZE OF PIPES MUST BE HELD. PIPES SHALL BE CUT SQUARE AND ALL BURRS AT OPEN ENDS REMOVED.

560690v201.dgn

NOTE - These data are confidential and the property of UOP and shall not be disclosed to others or reproduced in any manner or used for any purpose whatsoever except by written permission or as provided in a signed agreement with UOP relating to such data.

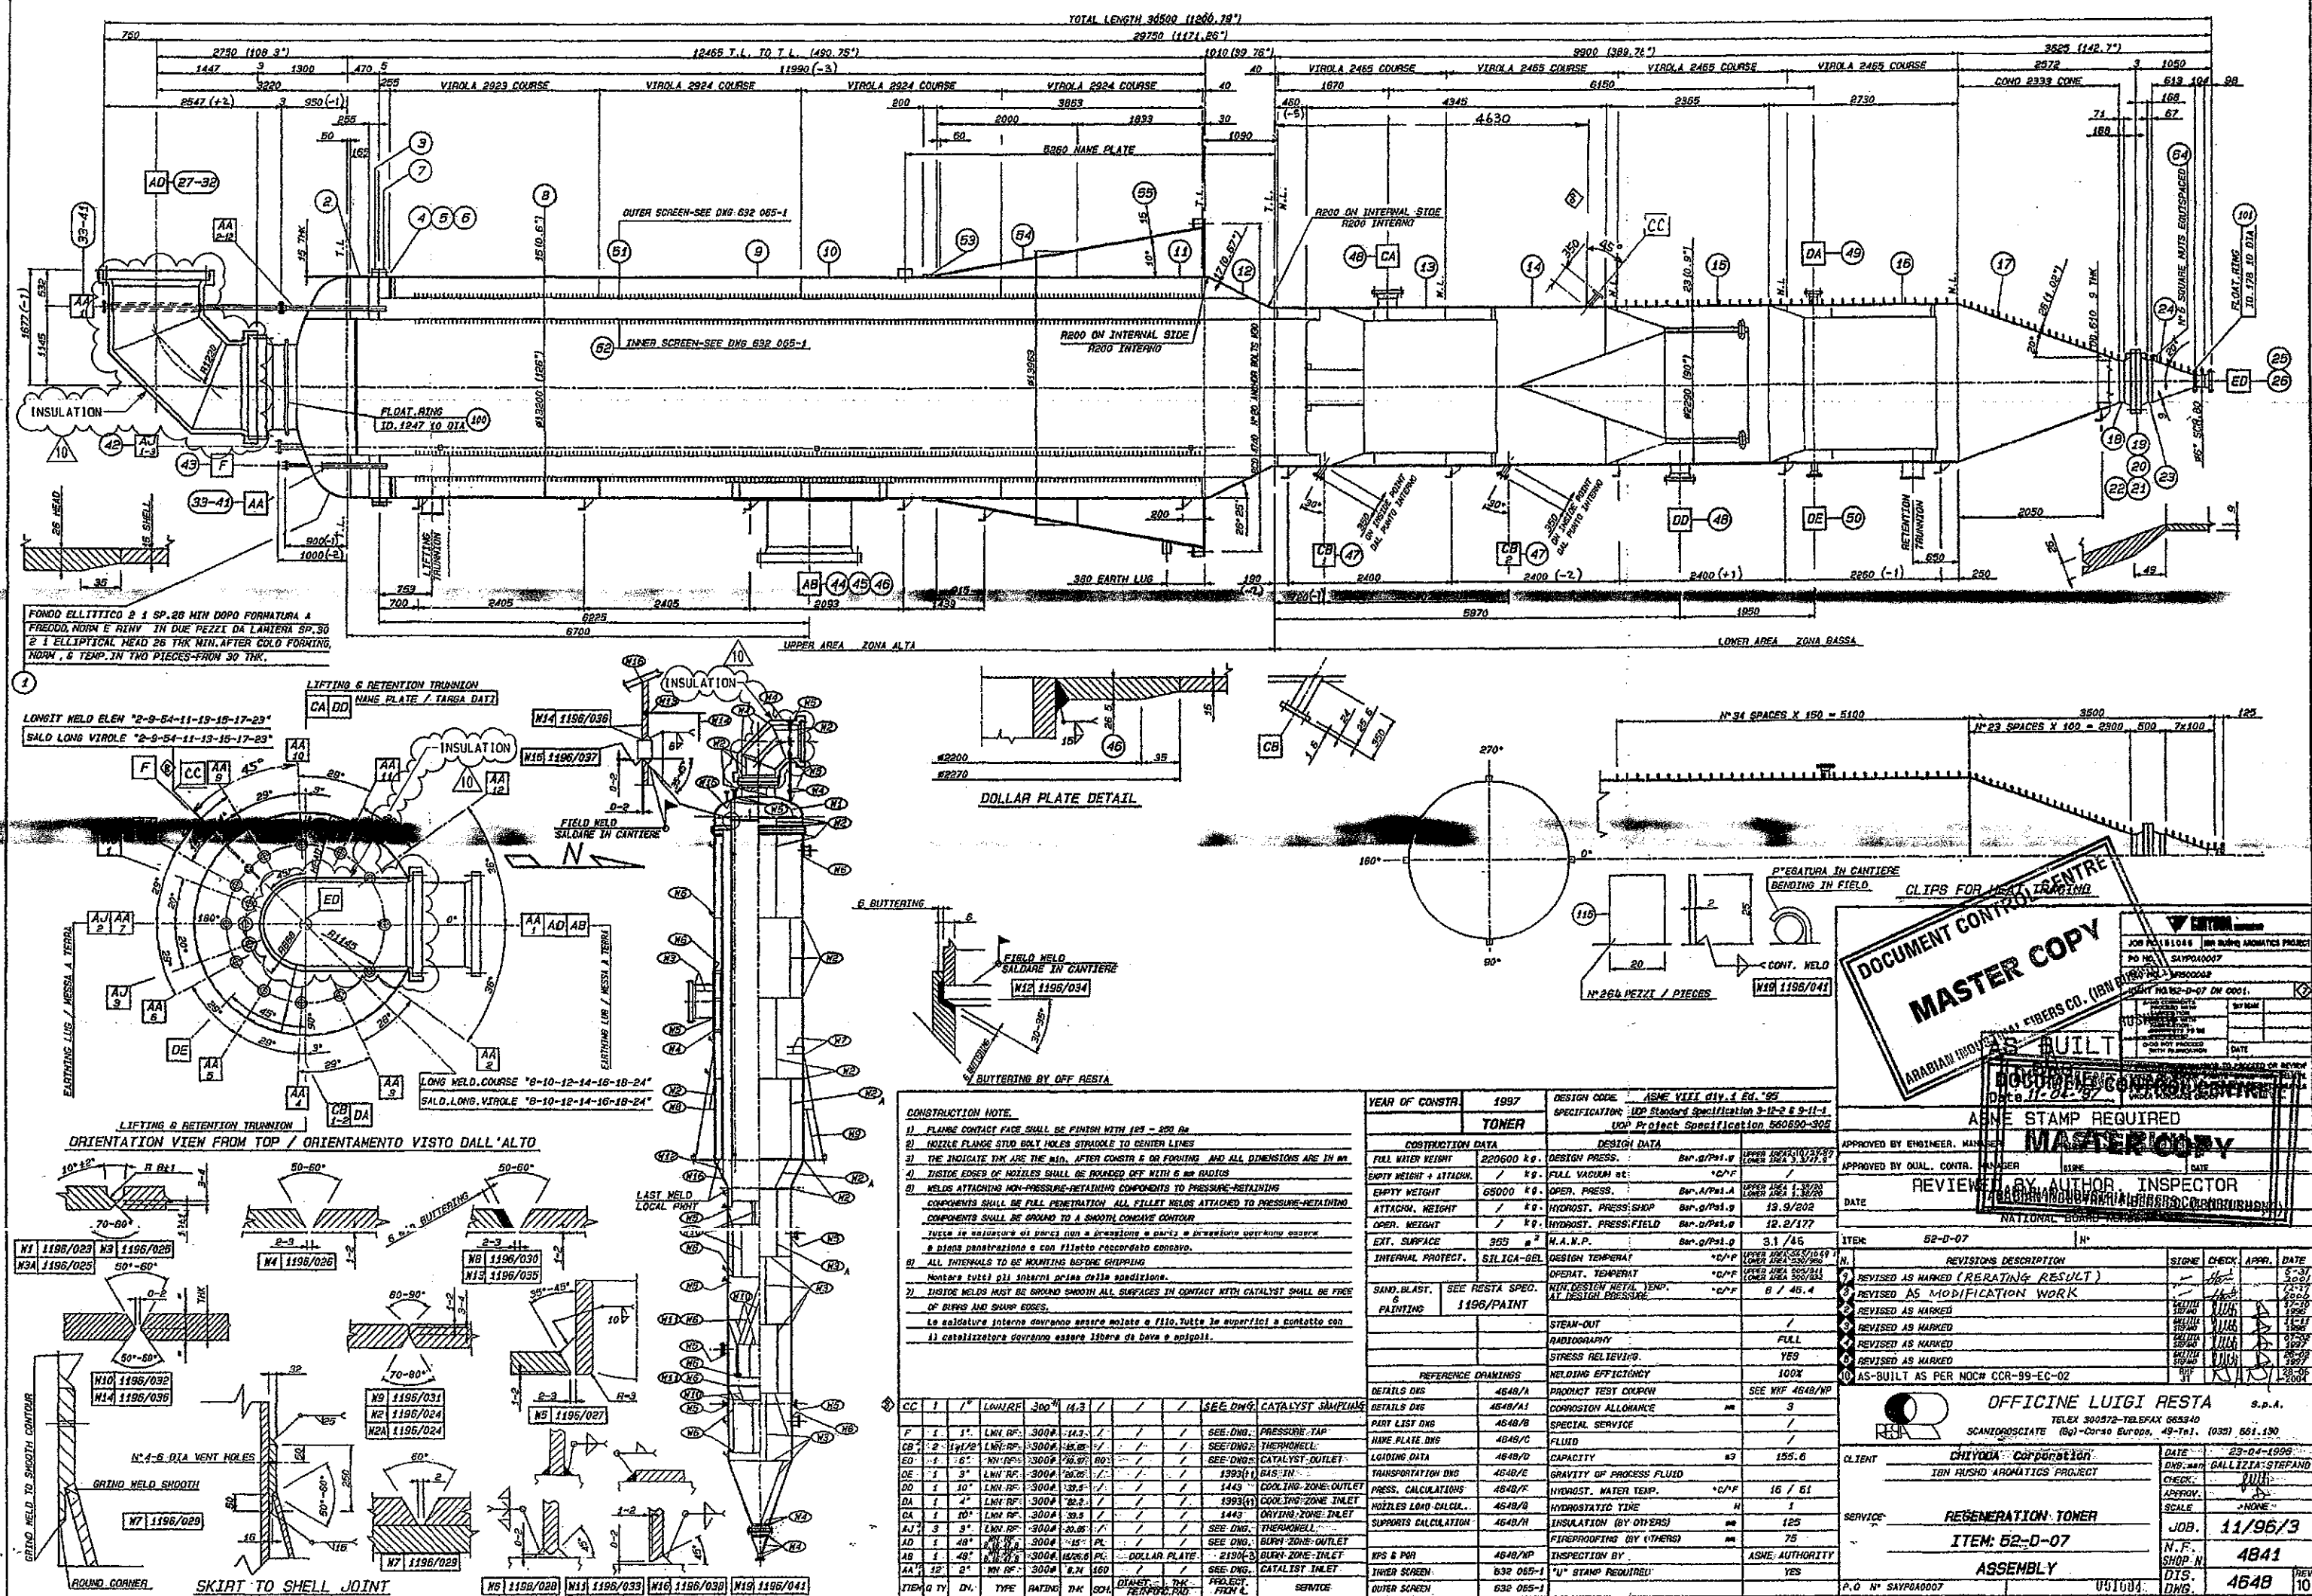


SECRET


FILE NO.	DATE	BY	DESCRIPTION	D.S.M. & A. E. APP. & REVIEWED
1	OCT. 11	T.Y.	ISSUED FOR CONSTRUCTION	216
2	FEB. 5 1971	H.Y.	AS BUILT	216 OK

REV.

	材準図
	参考図
○	製作図

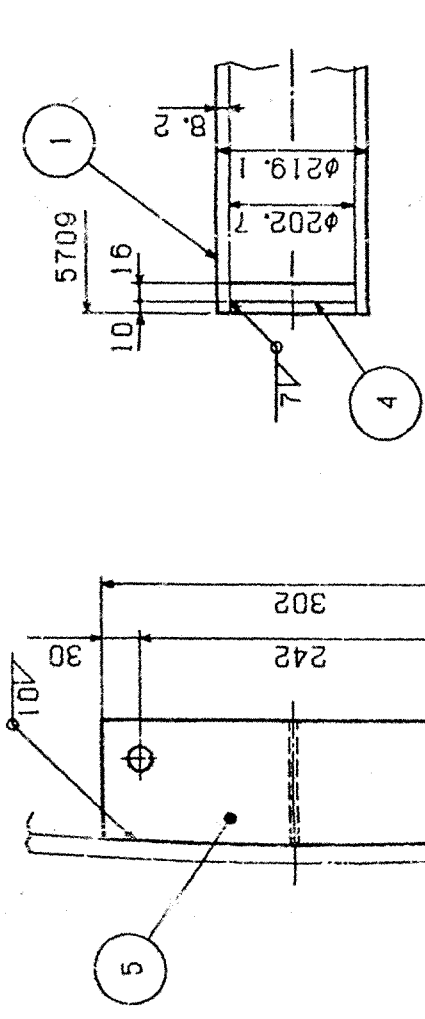



DETAIL B

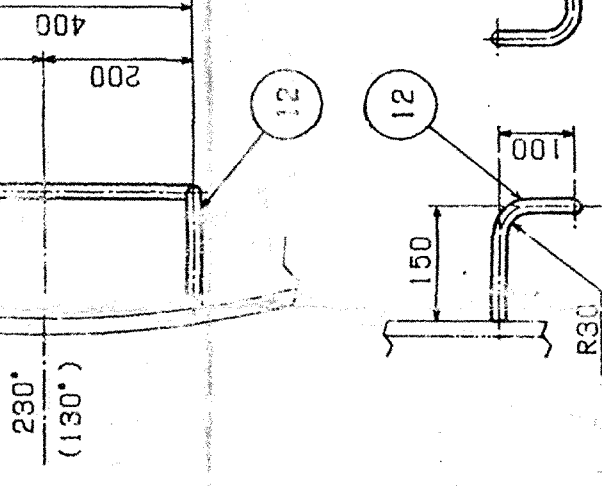


DETAIL OF INTERNAL LADDER

NOTE



1. 51-D-14B 'S ORIENTATION SHOWN IN ()

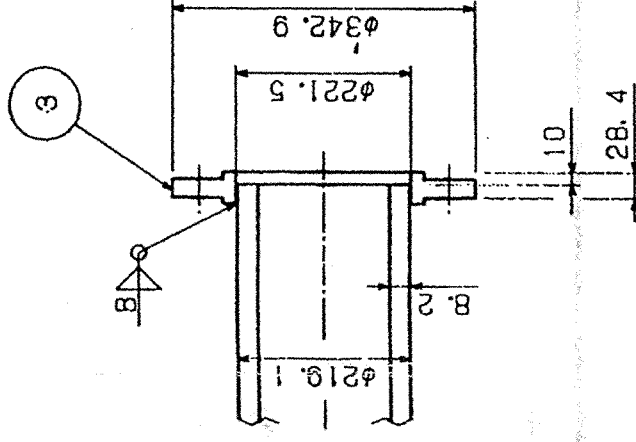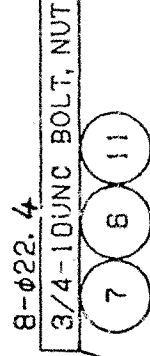

DETAIL C

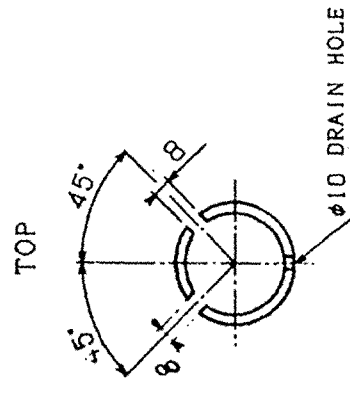

SEC. A-A

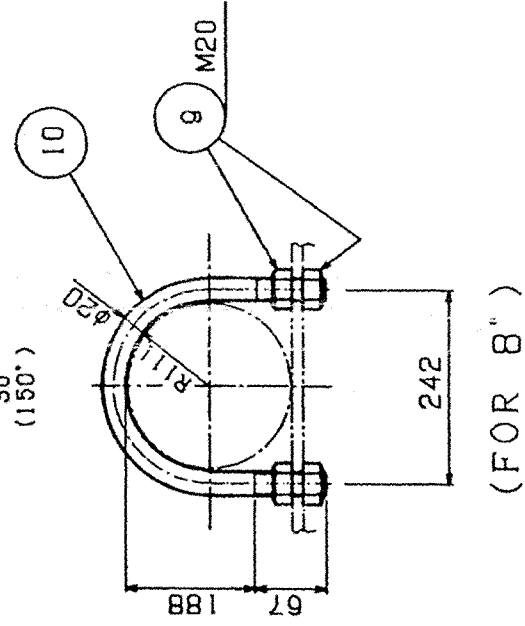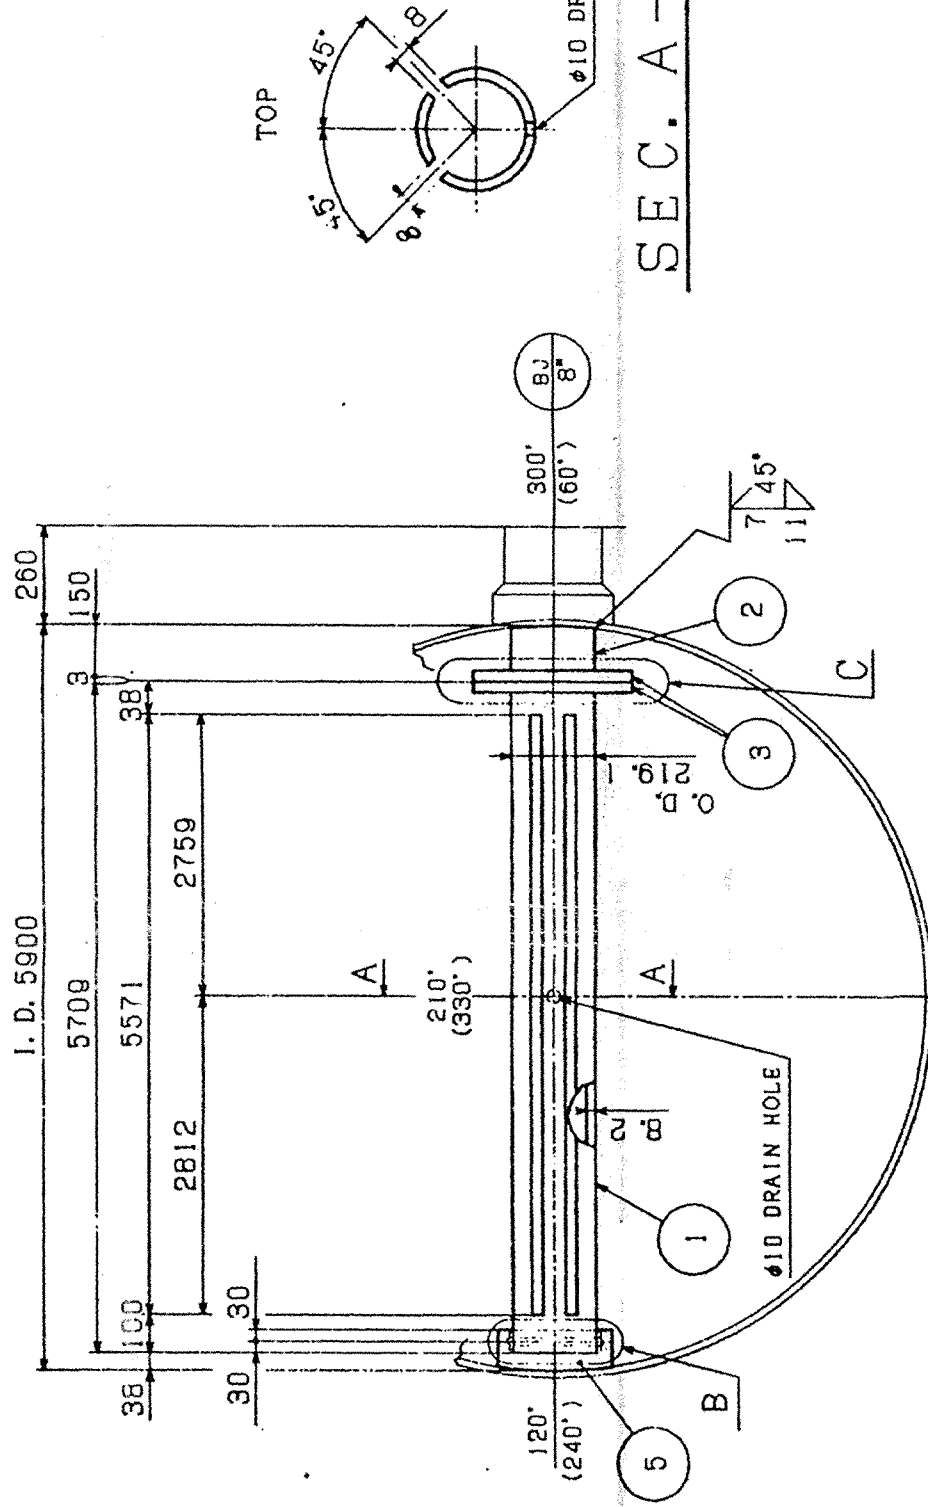

(FOR 8")

ASME YES
STAMP

DIV. 1 195
BY ASME SECTION
1995 EDITION
REVIEWED BY
Q. A. ENGINEER
DATE 1

CHUYODA CORPORATION

JOB NO. 51046 IBN RUSHD AROMATICS PROJECT

P.O. NO.

REQ. NO.

IDENT. NO.

A. 102-150000000
B. 102-150000000
C. 102-150000000
D. 102-150000000
E. 102-150000000
F. 102-150000000
G. 102-150000000
H. 102-150000000
I. 102-150000000
J. 102-150000000
K. 102-150000000
L. 102-150000000
M. 102-150000000
N. 102-150000000
O. 102-150000000
P. 102-150000000
Q. 102-150000000
R. 102-150000000
S. 102-150000000
T. 102-150000000
U. 102-150000000
V. 102-150000000
W. 102-150000000
X. 102-150000000
Y. 102-150000000
Z. 102-150000000

DATE

PURCHASER'S PERMISSION TO PROCEED OR REVIEW
TAKEN ON VENDOR PRINTS SHALL NOT RELIEVE
VENDOR FROM ITS RESPONSIBILITIES OR LIABILITIES
UNDER PURCHASE ORDER

TOTAL		295.7 Kg./VESSEL	
4 INT. LADDER	12 SA-36	1.5	6.0 Ø19
1 GASKET	11 T#1905 NON ASBESTOS	-	O.D. I.D. t3 X 27Ø.4 X 218.Ø
1 M20 V-BOLT	10 SUS304		1.2 (FOR 8")
4 M20 NUT	Ø	0.1	0.4
16 3/4-10UNC NUT	4	0.2	3.2
8 3/4-10UNC STUD	4 SUS304	0.3	2.4 120Ø
1 SUPPORT	Ø SA-516-70	0.7	t16
1 SUPPORT	Ø SA-516-70	3.7	t16
1 CLOSURE PLATE	4 SA-516-70	4.1	t16
2 8" INTERNAL FLANGE	3 SA-105	12.0	24.0 ANS1 150#RFSO
1 18" INTERNAL PIPE	2 SA-106-B	6.4	tB. 2 (SCH40)
1 18" INTERNAL PIPE	1 SA-106-B	243.6	tB. 2 (SCH40)
GR	PARTICULARS	REMARKS	
		1-OFF	TOTAL
		CAL WT (kg)	

CHIYODA CORPORATION

BN RUSHD PTA&
ROMATICS PROJECT--AROMATICS


CLAY TREATERS
51-D-14 A&B
INTERNAL

00238


DWG. No	B81481-124-01 B	REV
---------	-----------------	-----

SASEBO HEAVY INDUSTRIES CO., LTD. JAPAN


KEPRO ①①

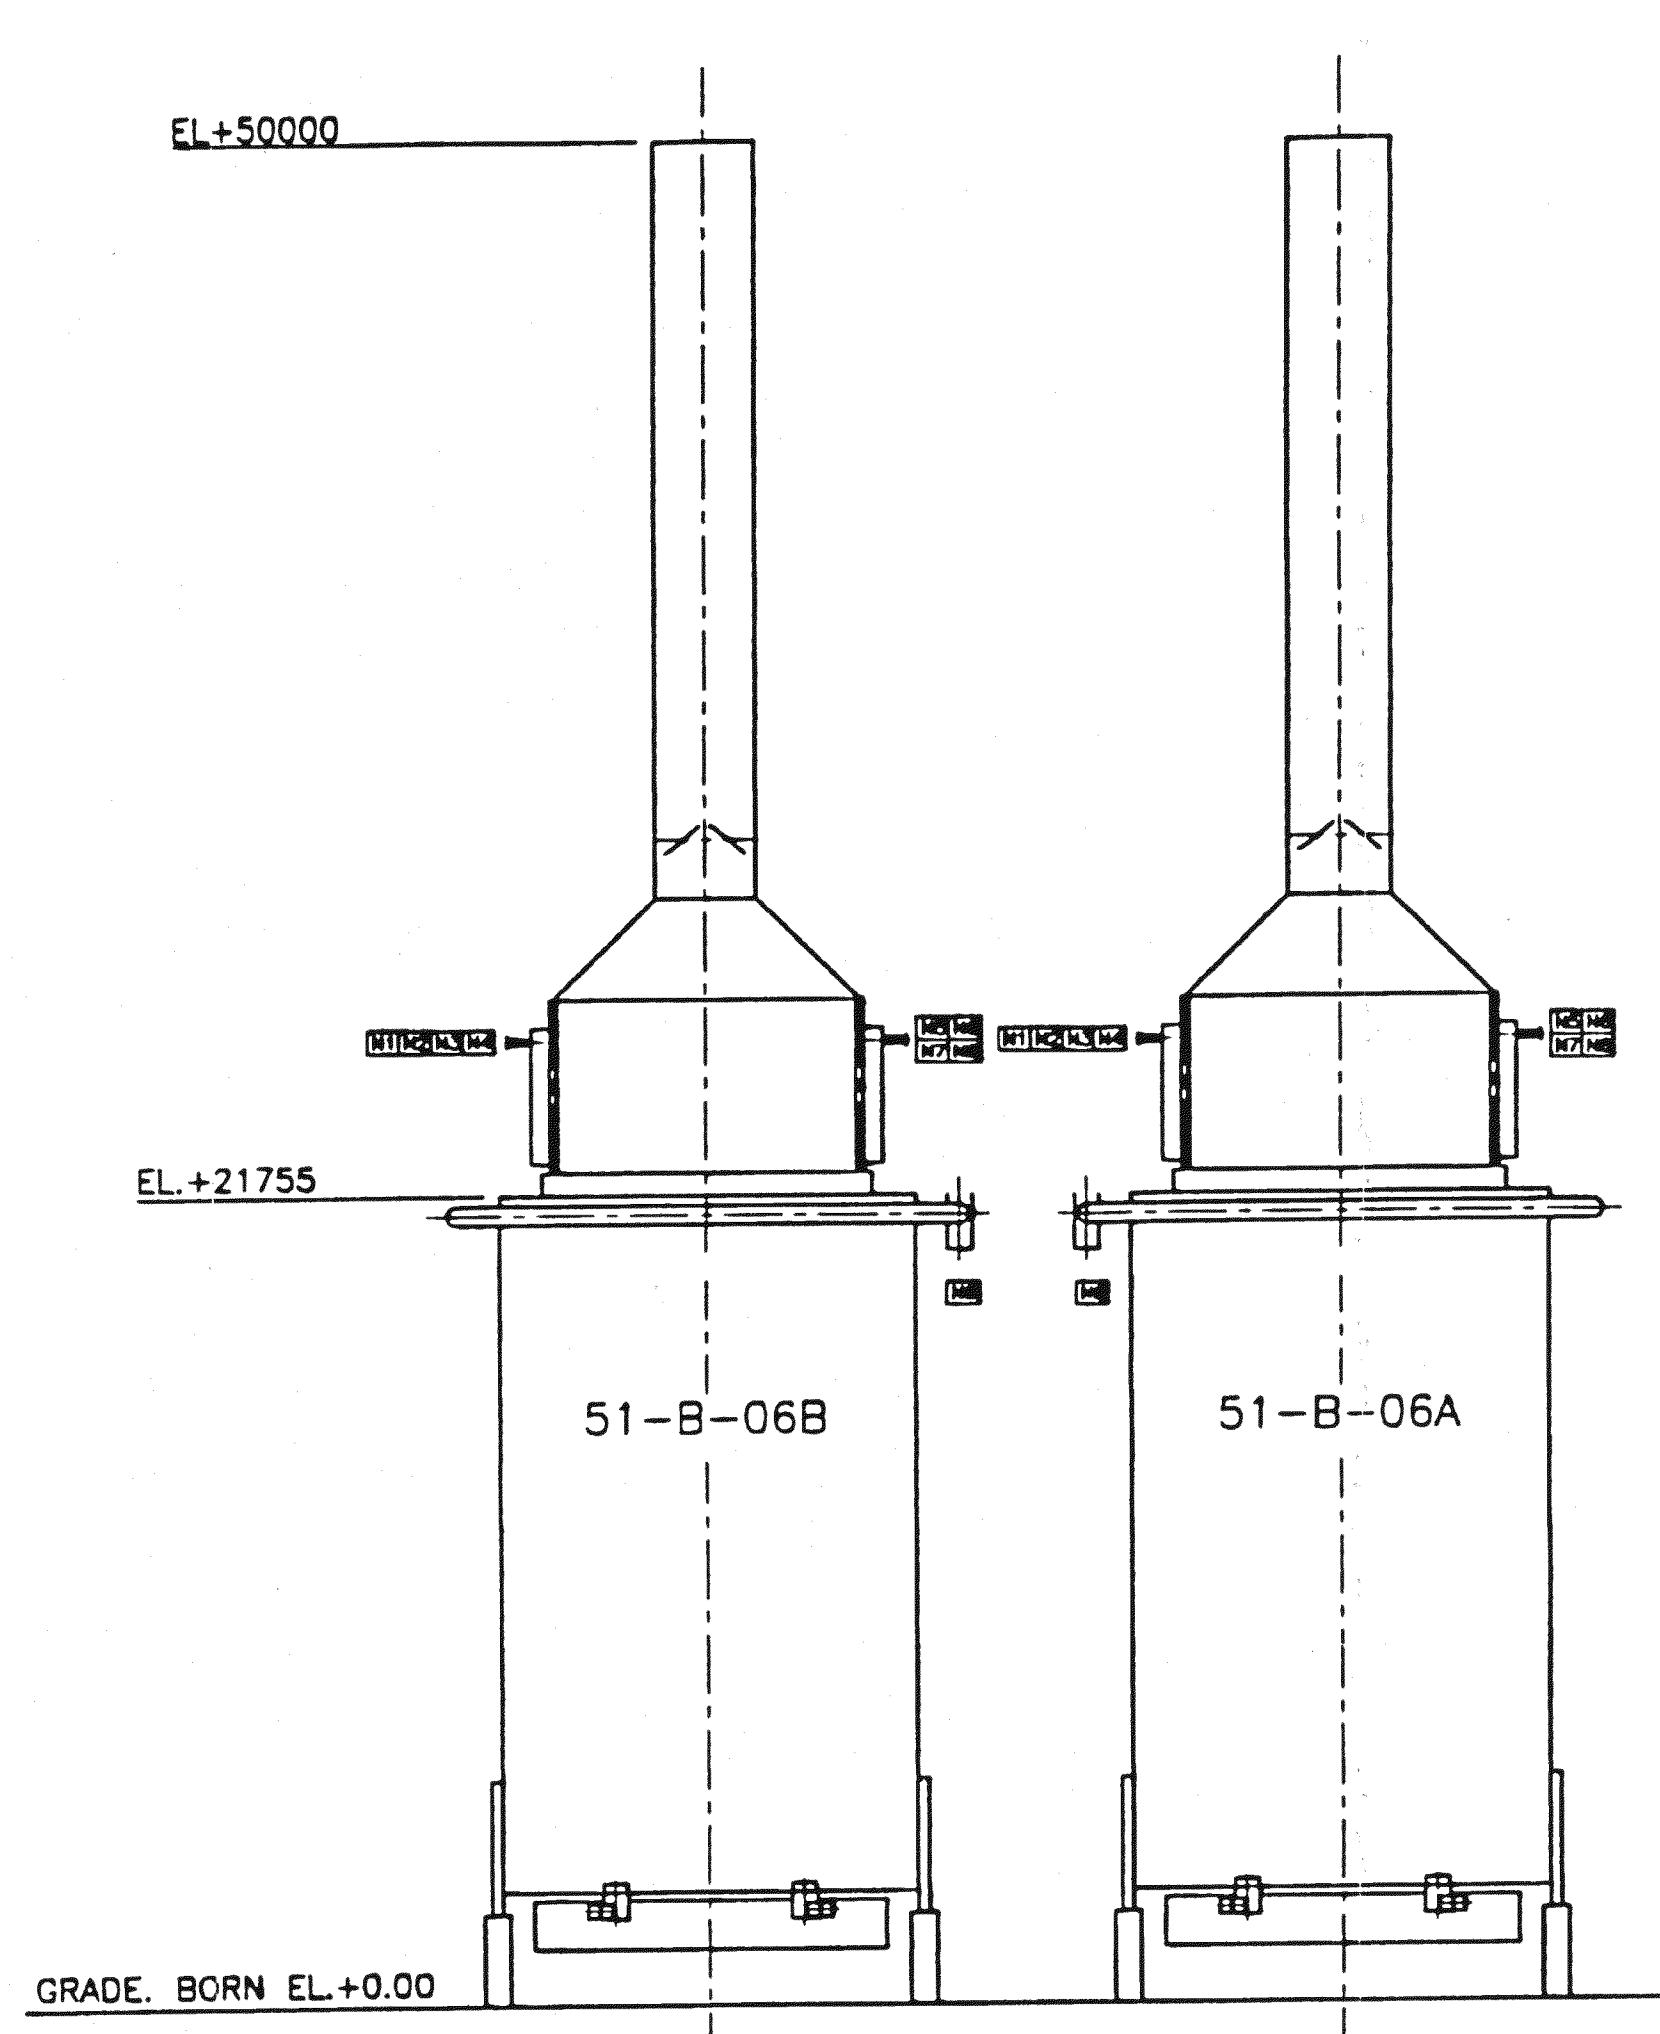

VIEW ON A-A

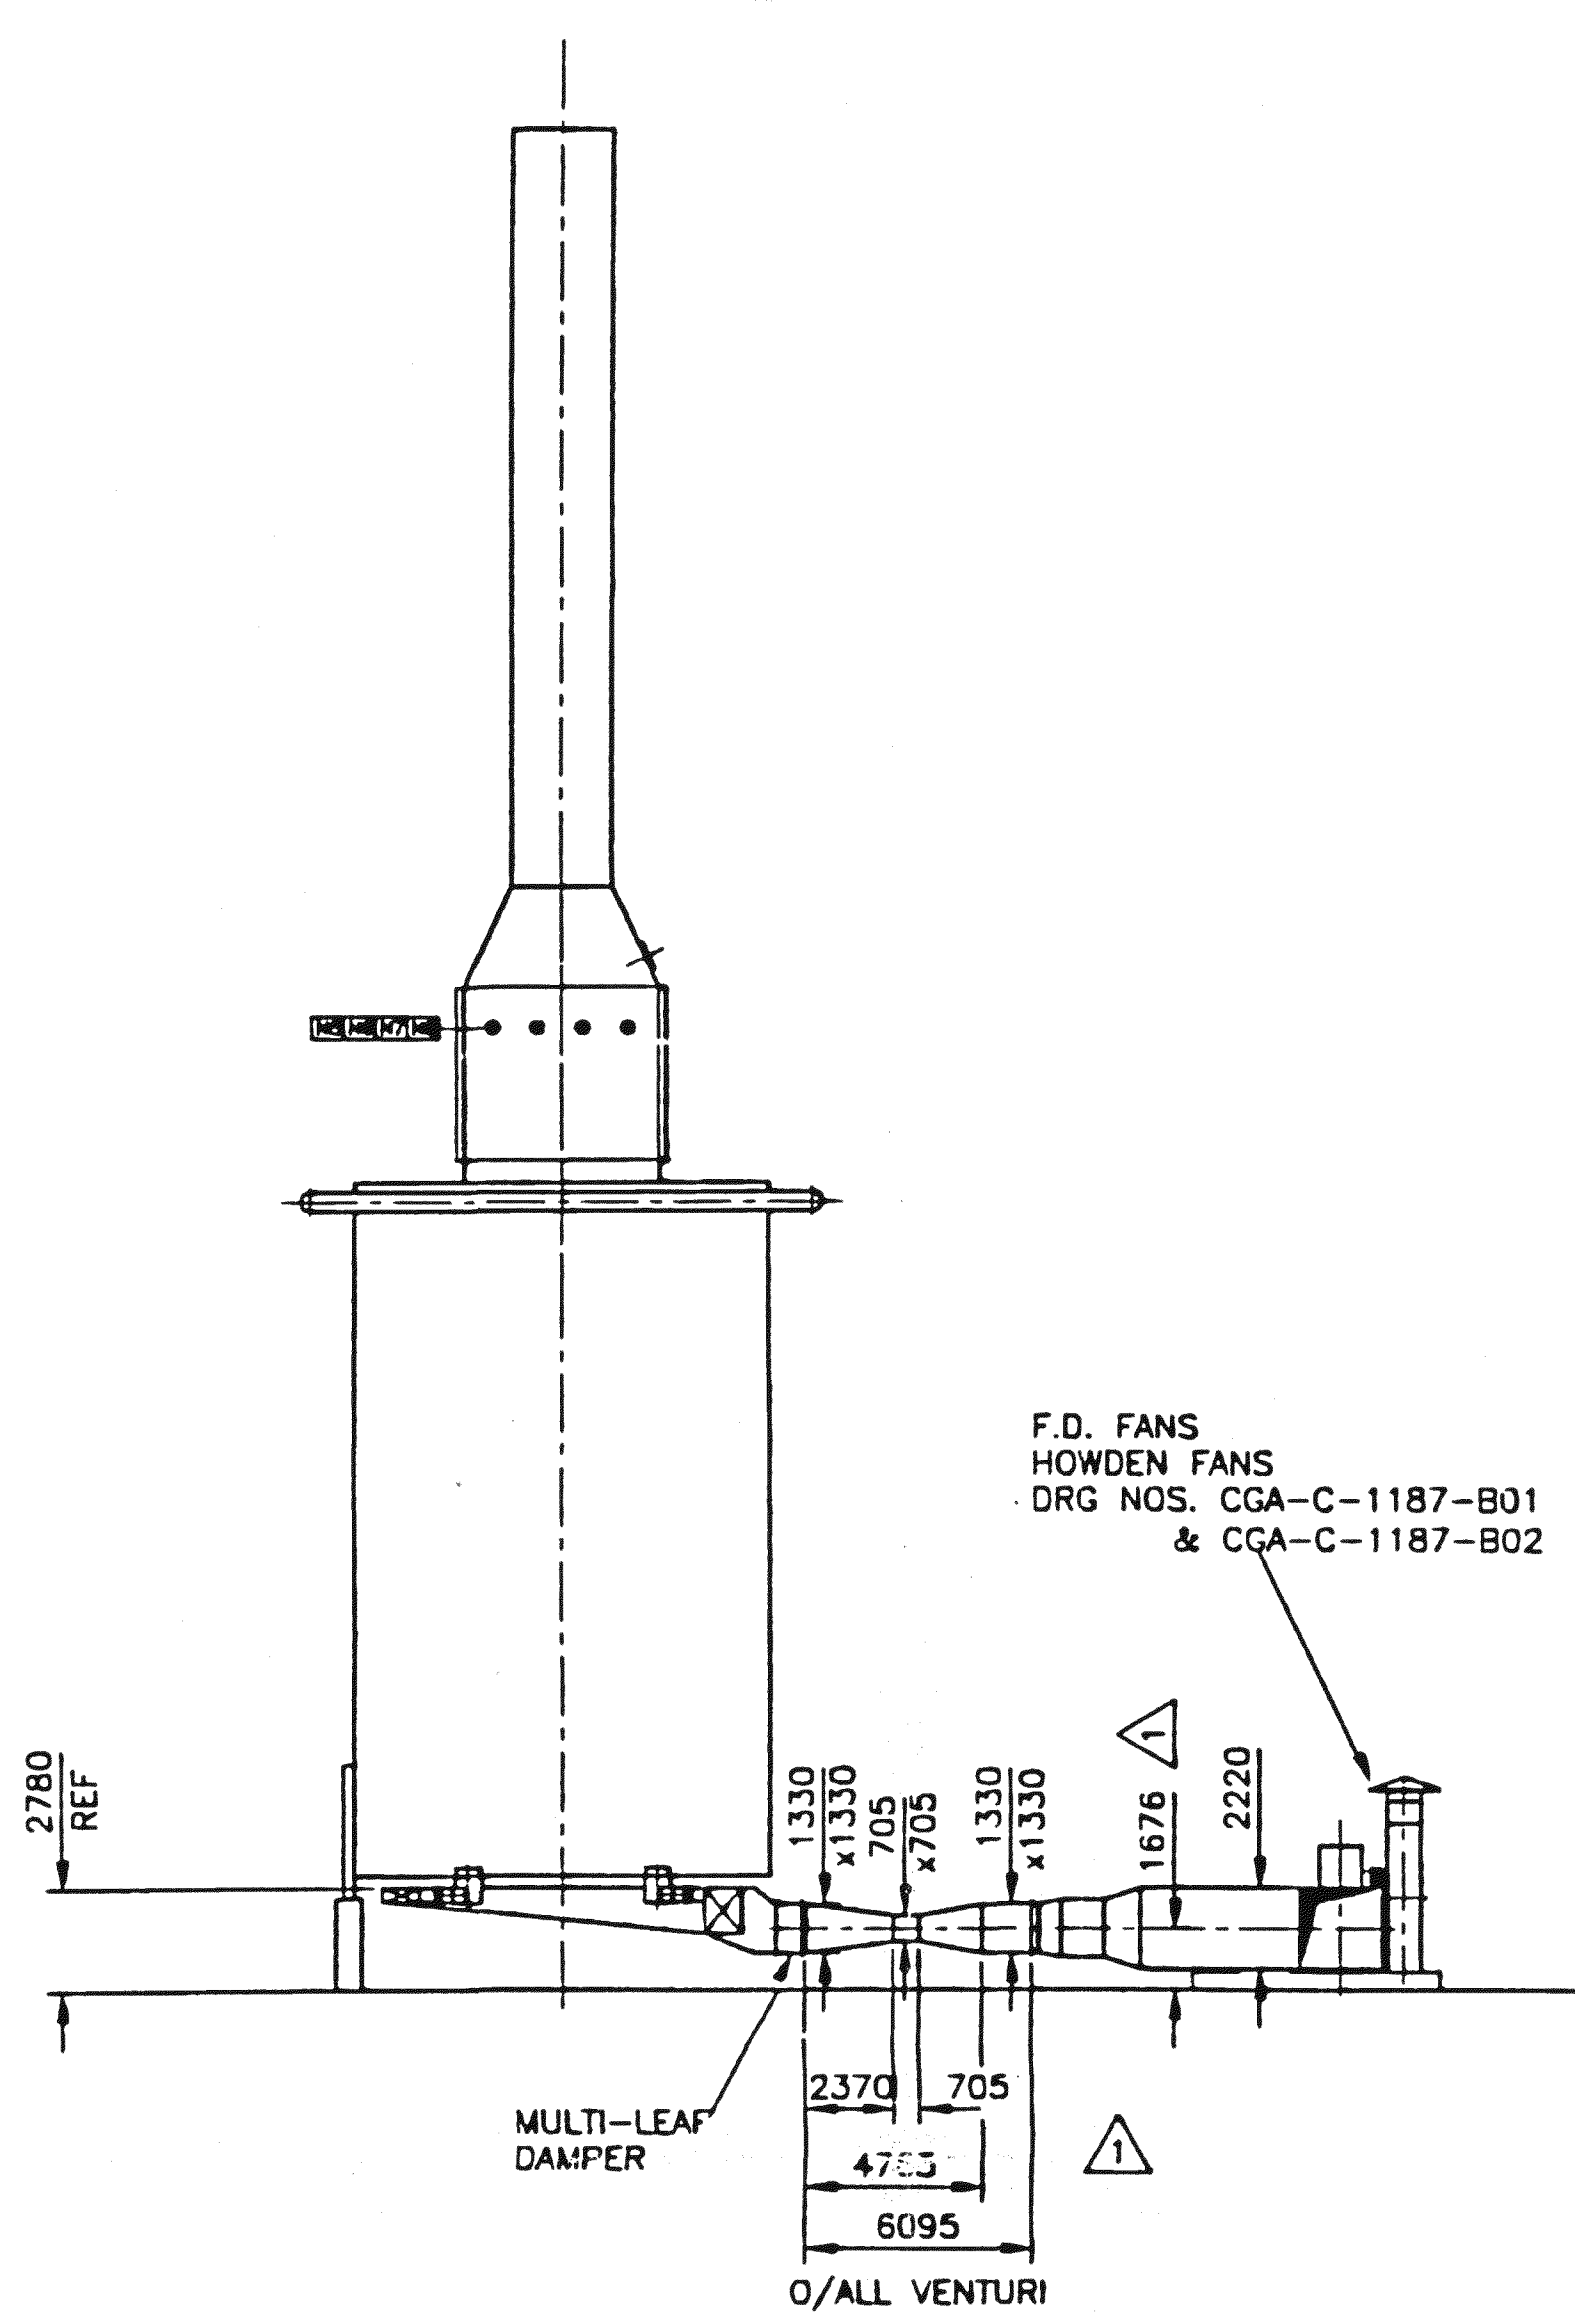

VIEW ON B-B


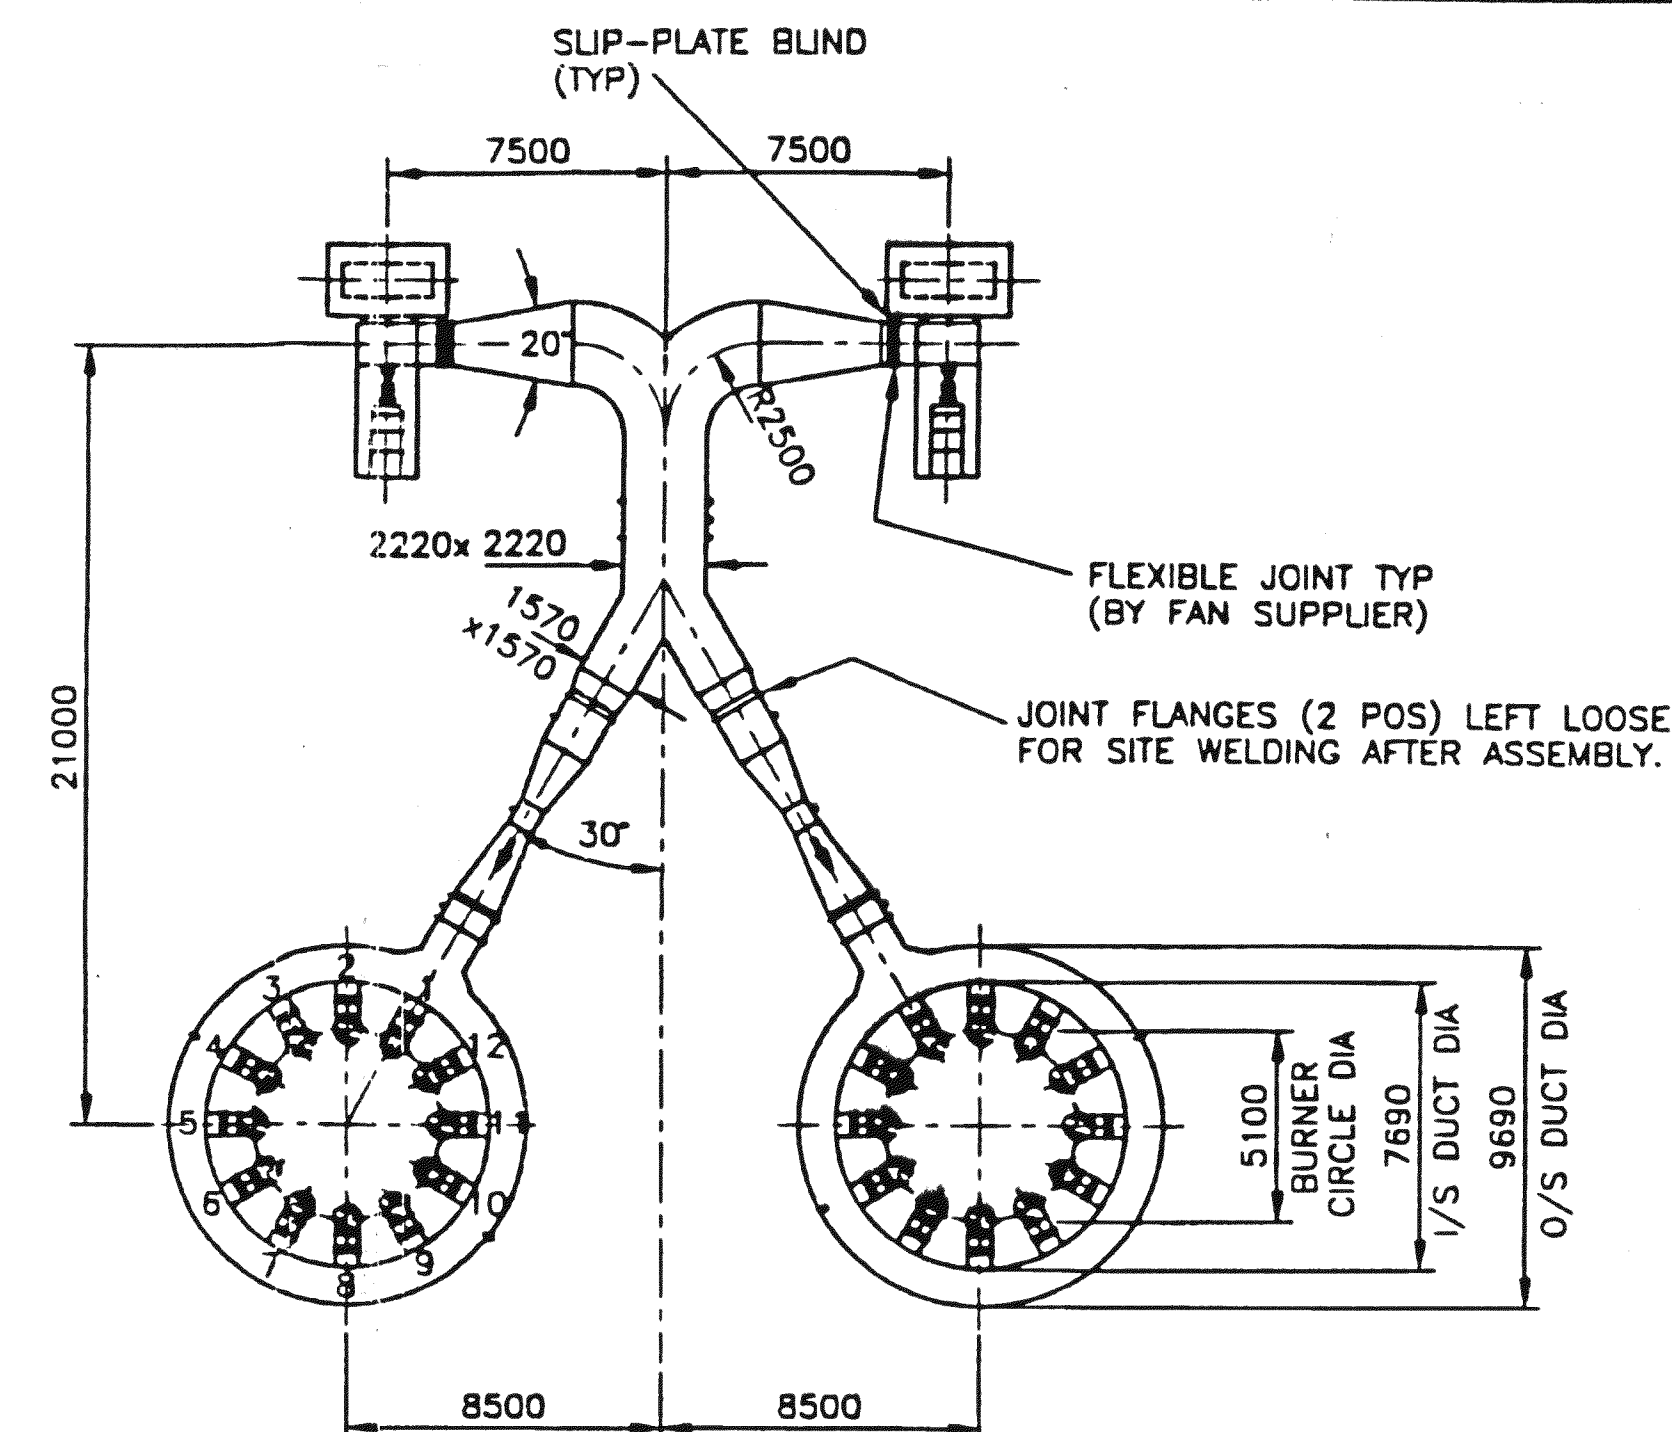


PLENUM DUCT FREE FLOW AREAS



AT BURNER 1,2,12 : 1.23 m²
AT BURNER 3,11 : 1.03 m²
AT BURNER 4,10 : 0.83 m²
AT BURNER 5,9 : 0.60 m²
AT BURNER 6,8 : 0.40 m²
AT BURNER 7 : 0.375 m²

PLAN ON BURNER DUCT

NOTE. ALL DUCT SIZES 1/SIDE STEEL (DUCT UNLINED)

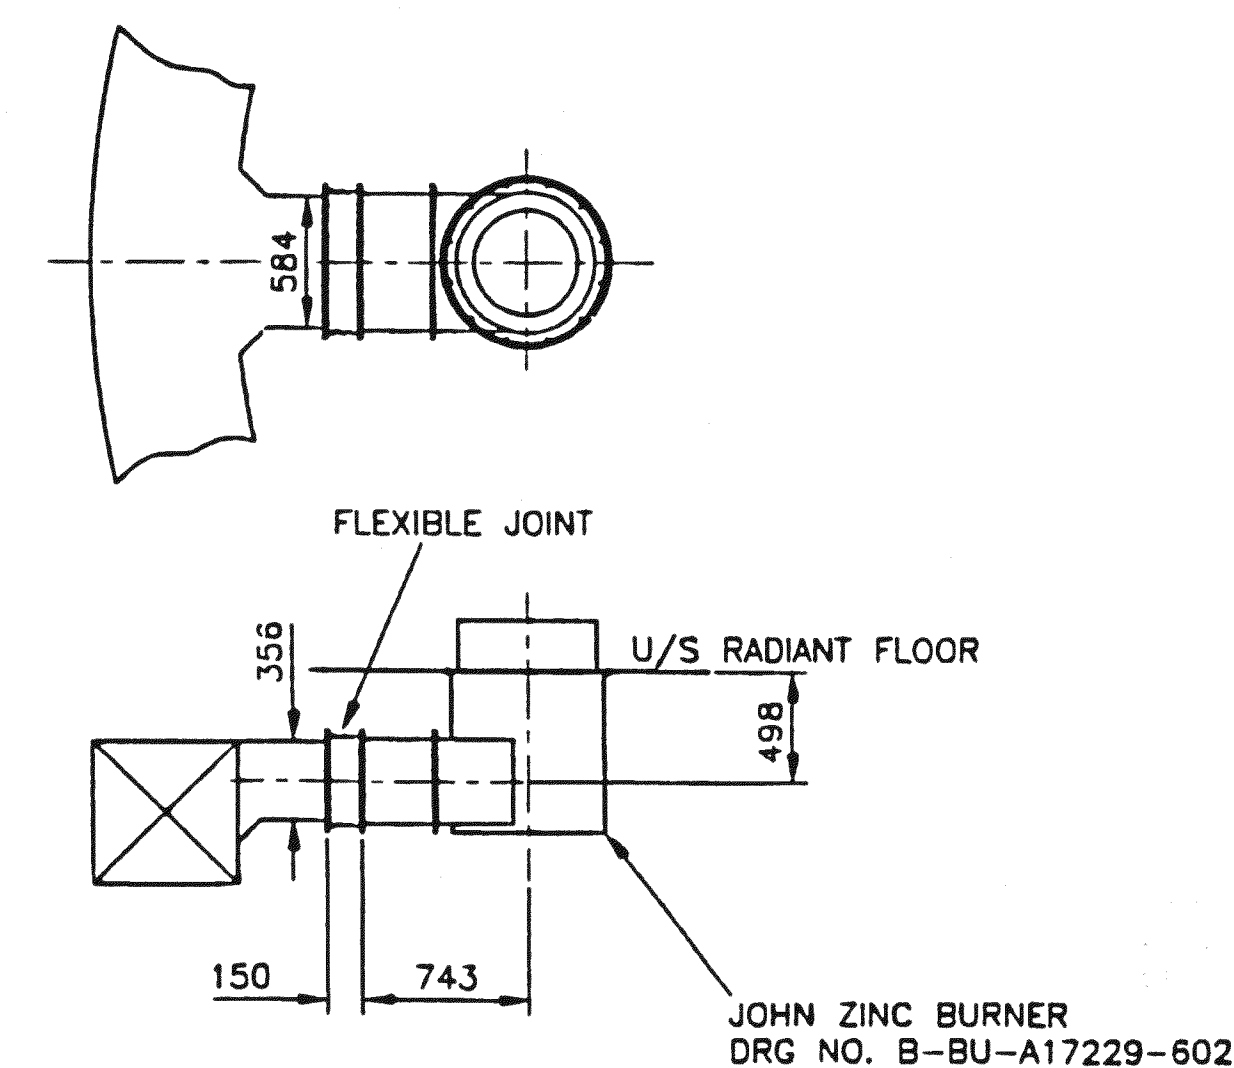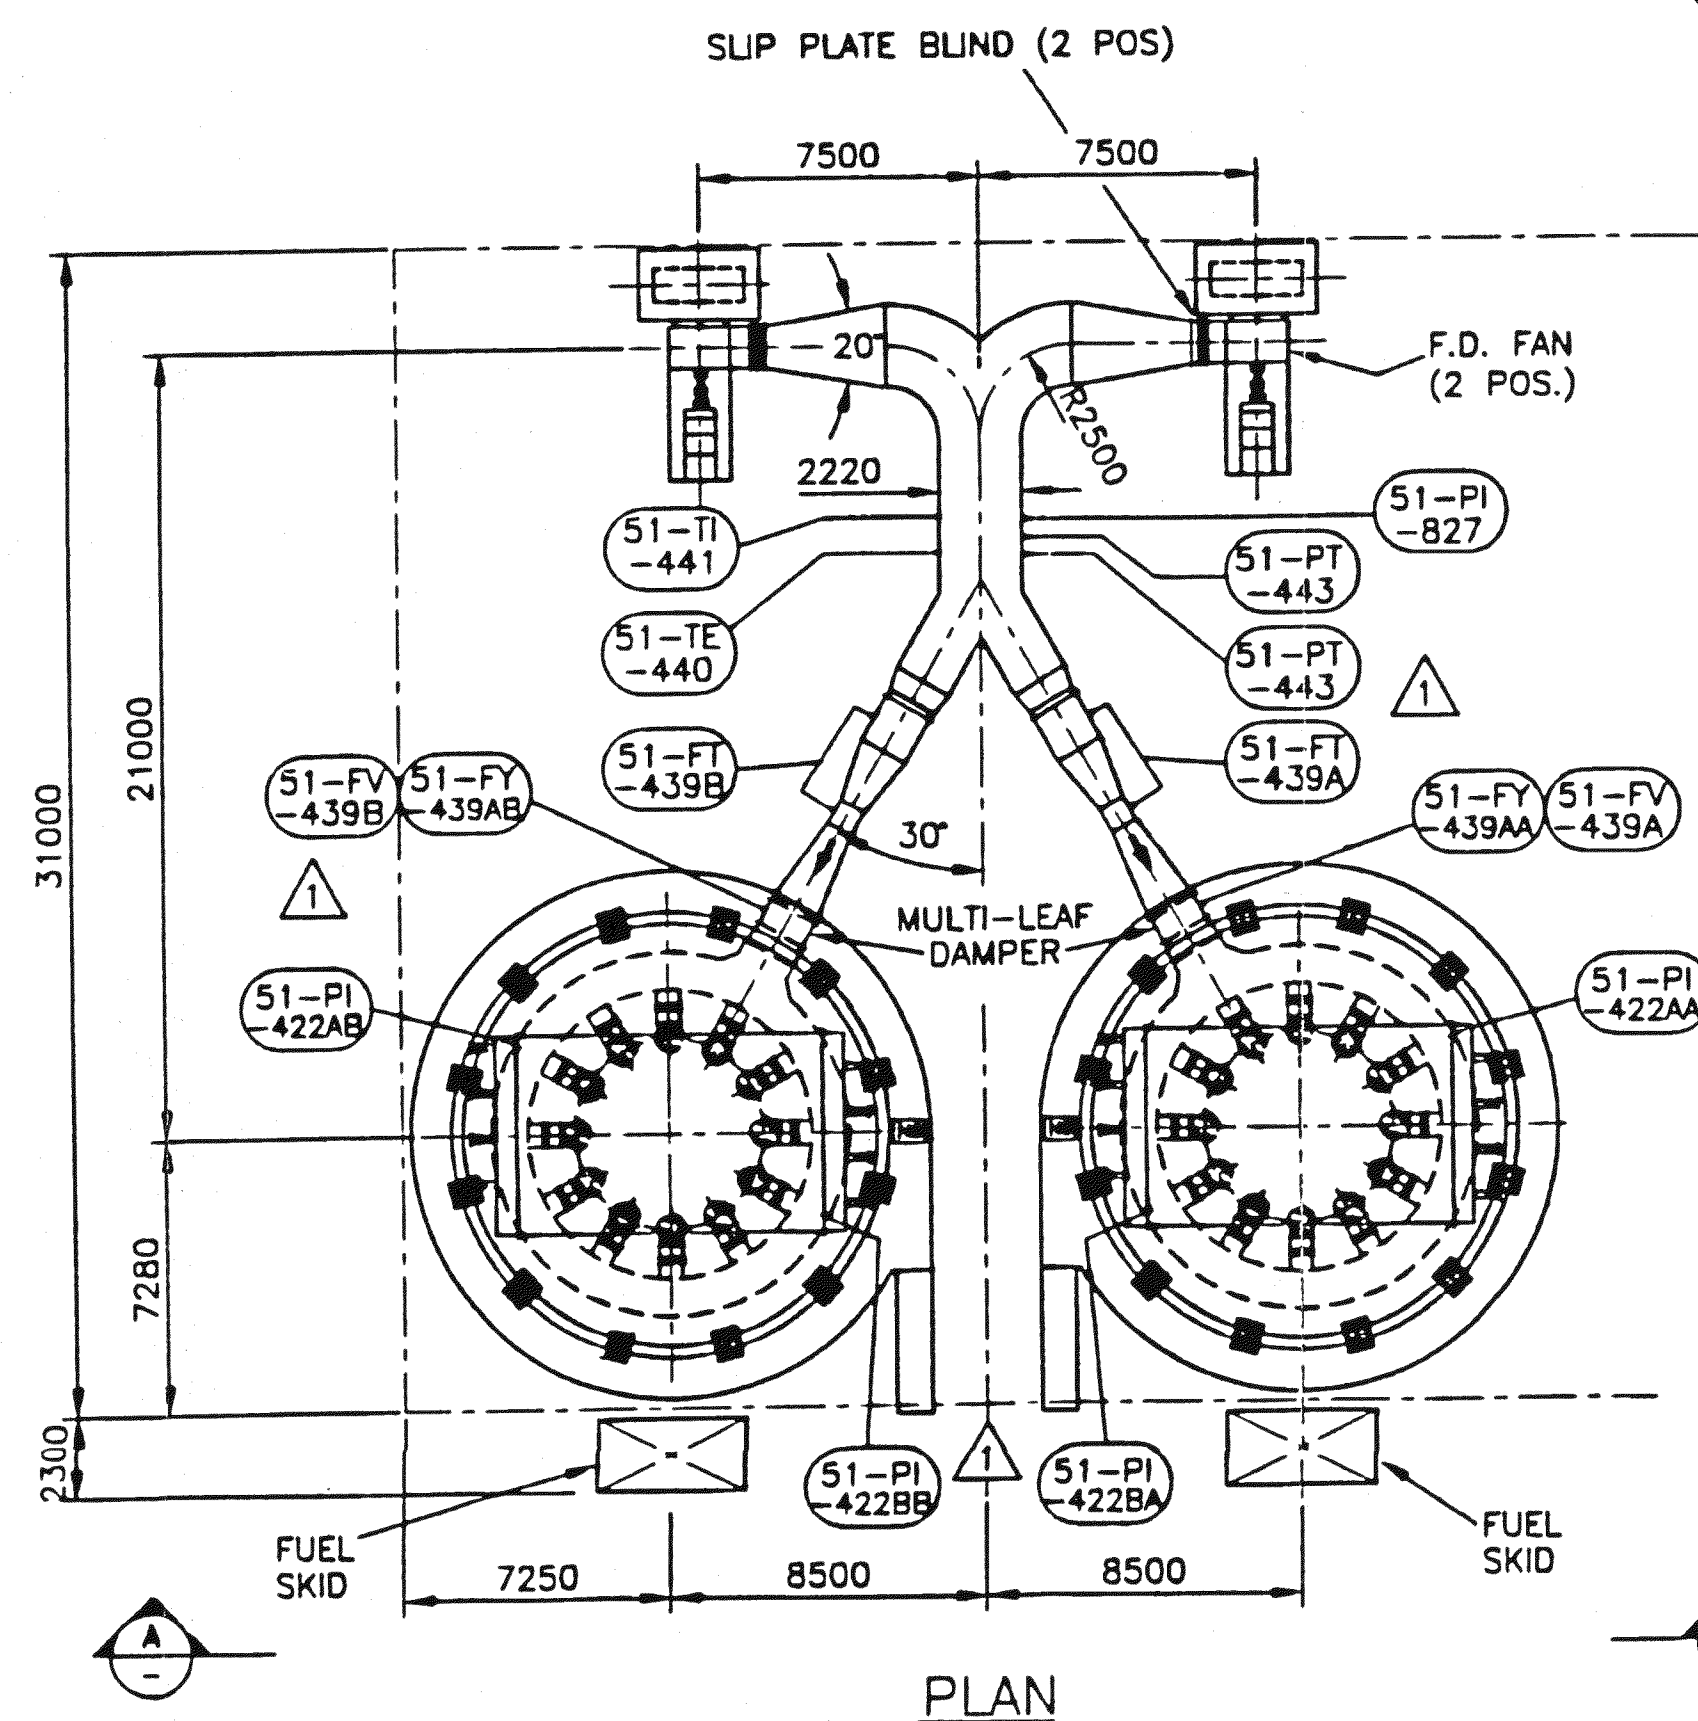


BURNER/DUCT DETAIL

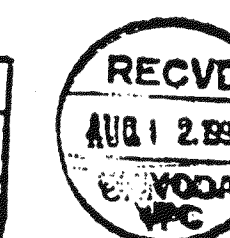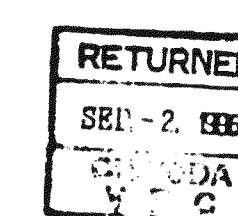

CHYODA	
JOB NO. 51048	IBN RUSHD AROMATICS PROJECT
PO NO.	SAYPOED002
REQ NO.	228540008501
IDENT NO.	228540008501DW0025
A-NO COMMENTS PROCEED WITH FABRICATION	SAY TEAM
B-PROCEED WITH FABRICATION COMMENTS TO BE CONSIDERED	FILED 22/1/96
C-DO NOT PROCEED WITH FABRICATION	DATE 22/1/96
PURCHASER'S PERMISSION TO PROCEED OR REVIEW TAKEN ON VENDOR PRINTS SHALL NOT RELIEVE VENDOR FROM ITS RESPONSIBILITIES OR LIABILITIES UNDER PURCHASE ORDER	

BORN

DRAWING TITLE	
OVERALL LAYOUT & PLOT	
SERVICE 51-B-06 STRIPPER REBOILER	
FOR IBN RUSHD 064021	
DRAWN	DATE
STEPHENS	JAN '96
CHECKED	DATE
G.T.	29.2.96
APPROVED	DATE
RG	7.3.96
JOB No. 2881 2881-51B06-01A	
REV. 1	

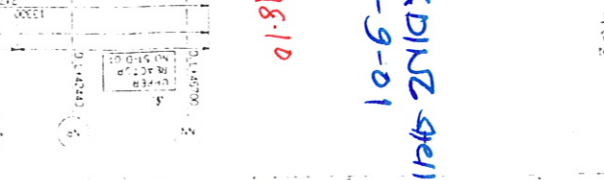

Technical drawing of a building floor plan with dimensions and annotations. The plan shows a rectangular building with several rooms and corridors. Dimensions are given in feet and inches. Annotations include a large yellow '2' with a red '#' and a large yellow '1' with a red '#'. A yellow circle highlights a specific area. The drawing is oriented horizontally.

5

I

FOR RECORD

CLIENT : IBN RUSHD
PROJECT : PTA & AROMATICS -
TITLE : AROMATICS
JOB NO. : 51046
DOC. NO. : DS-51-D-009 (1/1)

REVISIONS			
MARK	DATE	BY	APVD
1	Mar 05 '96	K. Kishore	K. Kishore
2	Mar 27 '96	K. Kishore	K. Kishore
3	Jun 20 '96	K. Kishore	K. Kishore
4	Jan 30 '97	K. Kishore	K. Kishore

UOP

25 East Algonquin Road • Des. Plaines, Illinois 60017-5017 • USA

VESSELS

PROJECT SPECIFICATION

560689 - 301 - 0 SHEET 11

REV	DATE	BY	APVD	REV	DATE	BY	APVD
0	5-26-95						

SERVICE LOW PRESSURE SEPARATOR

ITEM NO ~~D-5103~~ 51-D-09

Design	INT 3.5 BAR (g) @ 125 °C
Conditions	EXT FULL VACUUM @ 35 °C
At Top	Metal Temperature (Min) 9 °C
Operating	35 °C
Conditions	°C
Radiograph	MR
Postweld Heat Treat	MR
Joint Efficiency	MR%

Material Specifications	
Heads	SA516-60
Shell	SA516-60

Shell	Thickness Reqd By Code-mm	Corrosion Allowance mm (Min)
		3

Heads	3
-------	---

Vessel Heads TOP = 2:1 ELLIPTICAL
BOTTOM = 2:1 ELLIPTICAL

Accessories Applied by Fabricator

Ladder & Platform Clips AS REQUIRED (*)

Insulation Clips & Rings NO

Vessel Support YES

Nozzles and Manways

Mark	No	Size Inches	Service
AO	1	60	VAPOR OUT (+), C
BB	1	24	MANWAY
BJ	2	36	INLET (+), C
BL	2	1 1/2	LEVEL
BO	2	36	INLET (+), C
BR	2	1	LLS
BS	2	1	HHS
BX	2	1	ID TI
CD	1	8	OUTLET

Class- ANSI CL150 (+) SHEET 2-NOTE A


Facing- RAISED FACE
C- BEVEL FOR WELDING (OPTIONAL)

Normal Liquid Level- 620 mm ABOVE
BOTTOM TANGENT
Specific Gravity = 0.862

(*) BY CONTRACTOR

150 mm THICK MESH
BLANKET ~~OVER~~
SUPPORT PER DWG 3-264.

TANGENT LINE

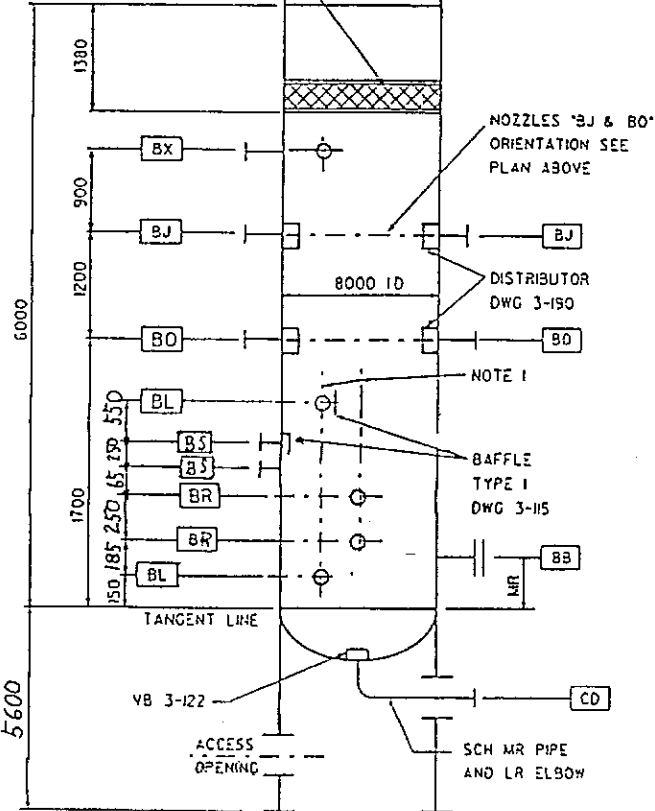

NOTES:




DO NOT LOCATE IN NOZZLE 'BJ & BO' AREA.

Drawings Referred to in this Specification

3-115-2	3-122-0	3-190-4	3-264-0
---------	---------	---------	---------

NOTE - These data are confidential and the property of UOP and shall not be disclosed to others or reproduced in any manner or used for any purpose whatsoever except by written permission or as provided in a signed agreement with UOP relating to such data.

560689v109.dgn

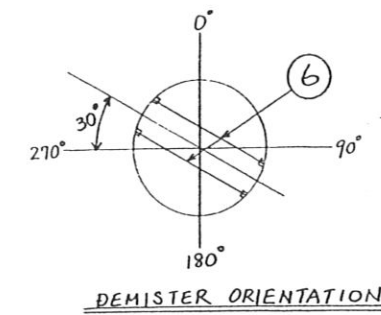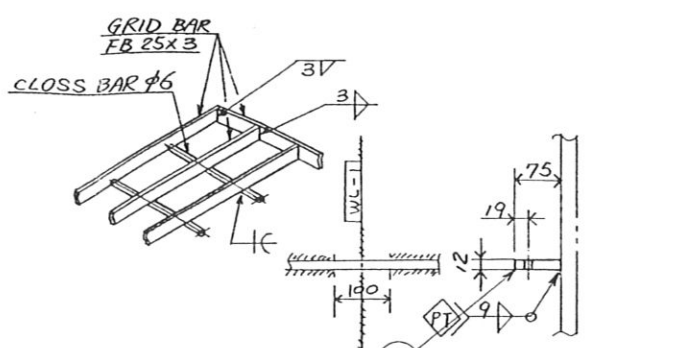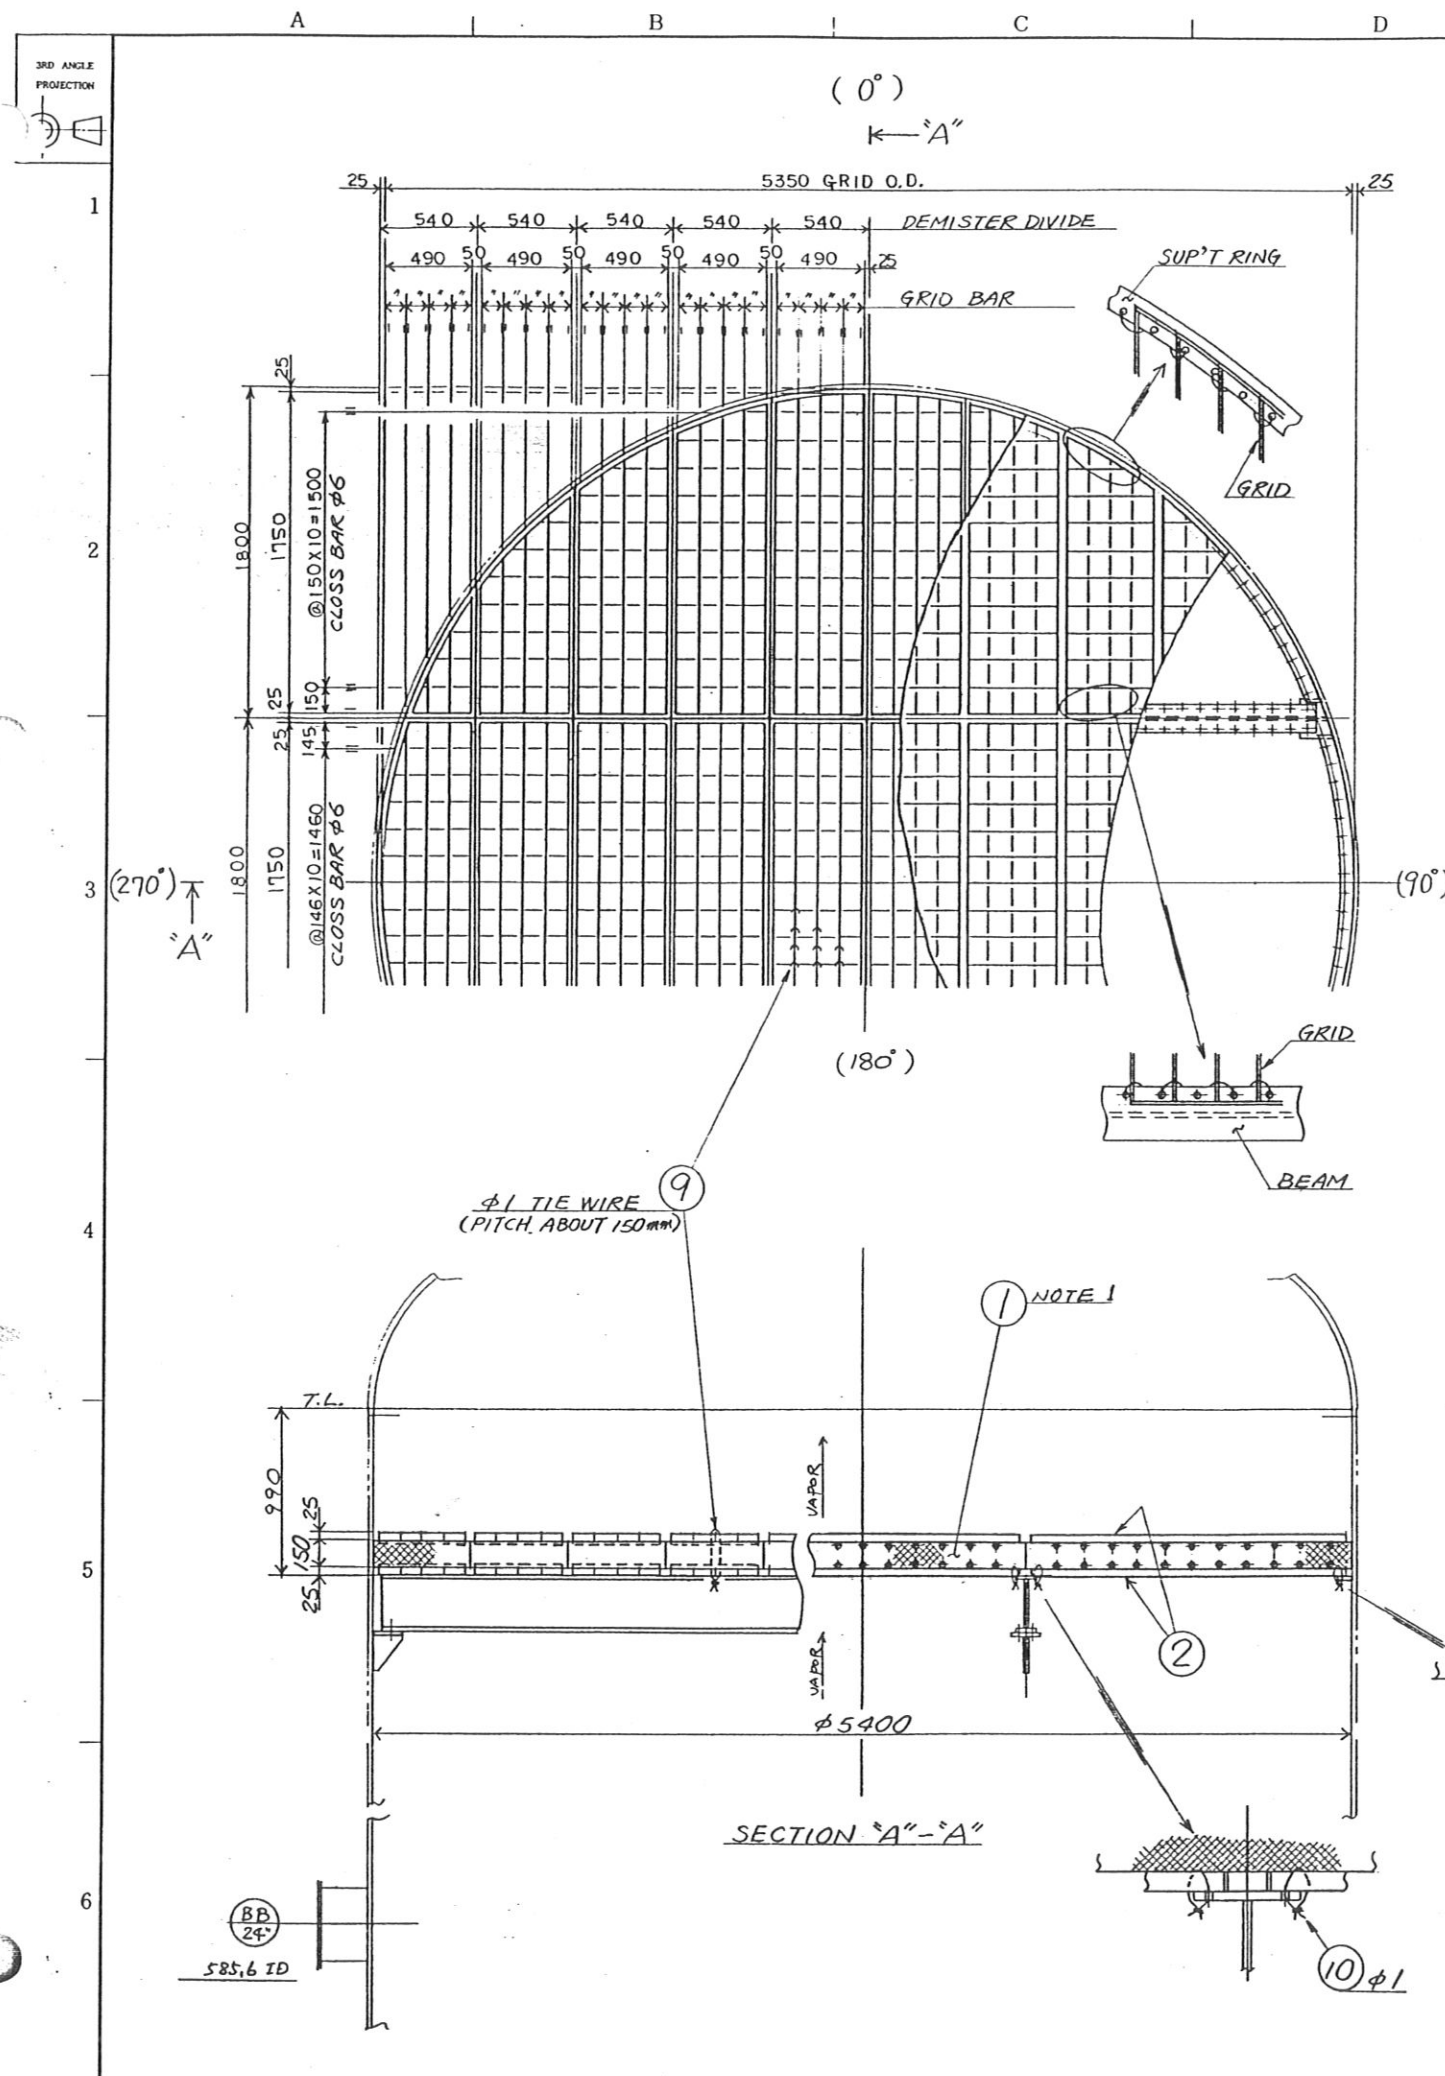

NOTE
 1. DEMISTER SPECIFICATION
 DENSITY: $9.16 / ft^3 (144.2 kg/m^3)$ } YORK 431 or EQ.
 FILAMENT WIRE: $0.011" (0.28 mm)$ } (N-STYLE)
 2. TOTAL WEIGHT OF MESH BLANKET = 655 kg (INCLUDING GRID BARS)

3. ALL MESH BLANKET SECTIONS MUST BE ABLE TO PASS THROUGH MANWAY BB (24" ID) LOCATED BELOW THE MESH BLANKET.


ITEM NO.	DESCRIPTION	MATERIAL	QTY	REMARKS
1	TIE WIRE	φ1 TYP 304 S.S.	1 SET	47 M
2	TIE WIRE	φ1 TYP 304 S.S.	1 SET	20 M
3	WASHER FOR 3/4"		8	
4	HEX. BOLT NUT 3/4-10X1/2X60A	TYP 304 S.S.	8 SETS	NUT TYPE 1
5	BEAM	φ12 SA283-C	2 SETS	BUILT-UP
6	SUPPORT RIB	φ19 SA516-70	4	
7	SUPPORT LUG	φ19 SA516-70	4	
8	SUPPORT RING	φ12 SA516-70	1 RING	
9	GRID	FB 25x3 TYP 304 S.S.	2 SETS	
10	DEMISTER	φ150 TYP 304 S.S.	1 SET	30 DIVIDE
TOTAL				

MARK O. NIKON MESH CO., LTD.

Reviewed by QA
 Date: SEP 17 '96
 T. Tokki Ltd.
 TOKKI LTD.
 Approved By Design Section
 Date: SEP 17 '96
 Manager of Design Section

CHUYODA
 JOB NO. 51046 IBN RUSHD AROMATICS PROJECT
 PO NO. SAY P0A 0022
 REQ NO. MR-50-D-008
 IDENT NO. 51-D-10-DW-0005
 DATE
 PURCHASER'S PERMISSION TO PROCEED OR REVIEW TAKEN ON VENDOR PRINTS SHALL NOT RELIEVE VENDOR FROM ITS RESPONSIBILITIES OR LIABILITIES UNDER PURCHASE ORDER

REV.	DESCRIPTION	DATE	APPROVE	CHECK	DRAWN
1	300-304 (USE OF FLAT BAR) 14.11.96	14.11.96			
2	OR, WEIGHT, etc	14.11.96			
3	5183-C → SA516-70	14.11.96			
4					
5					
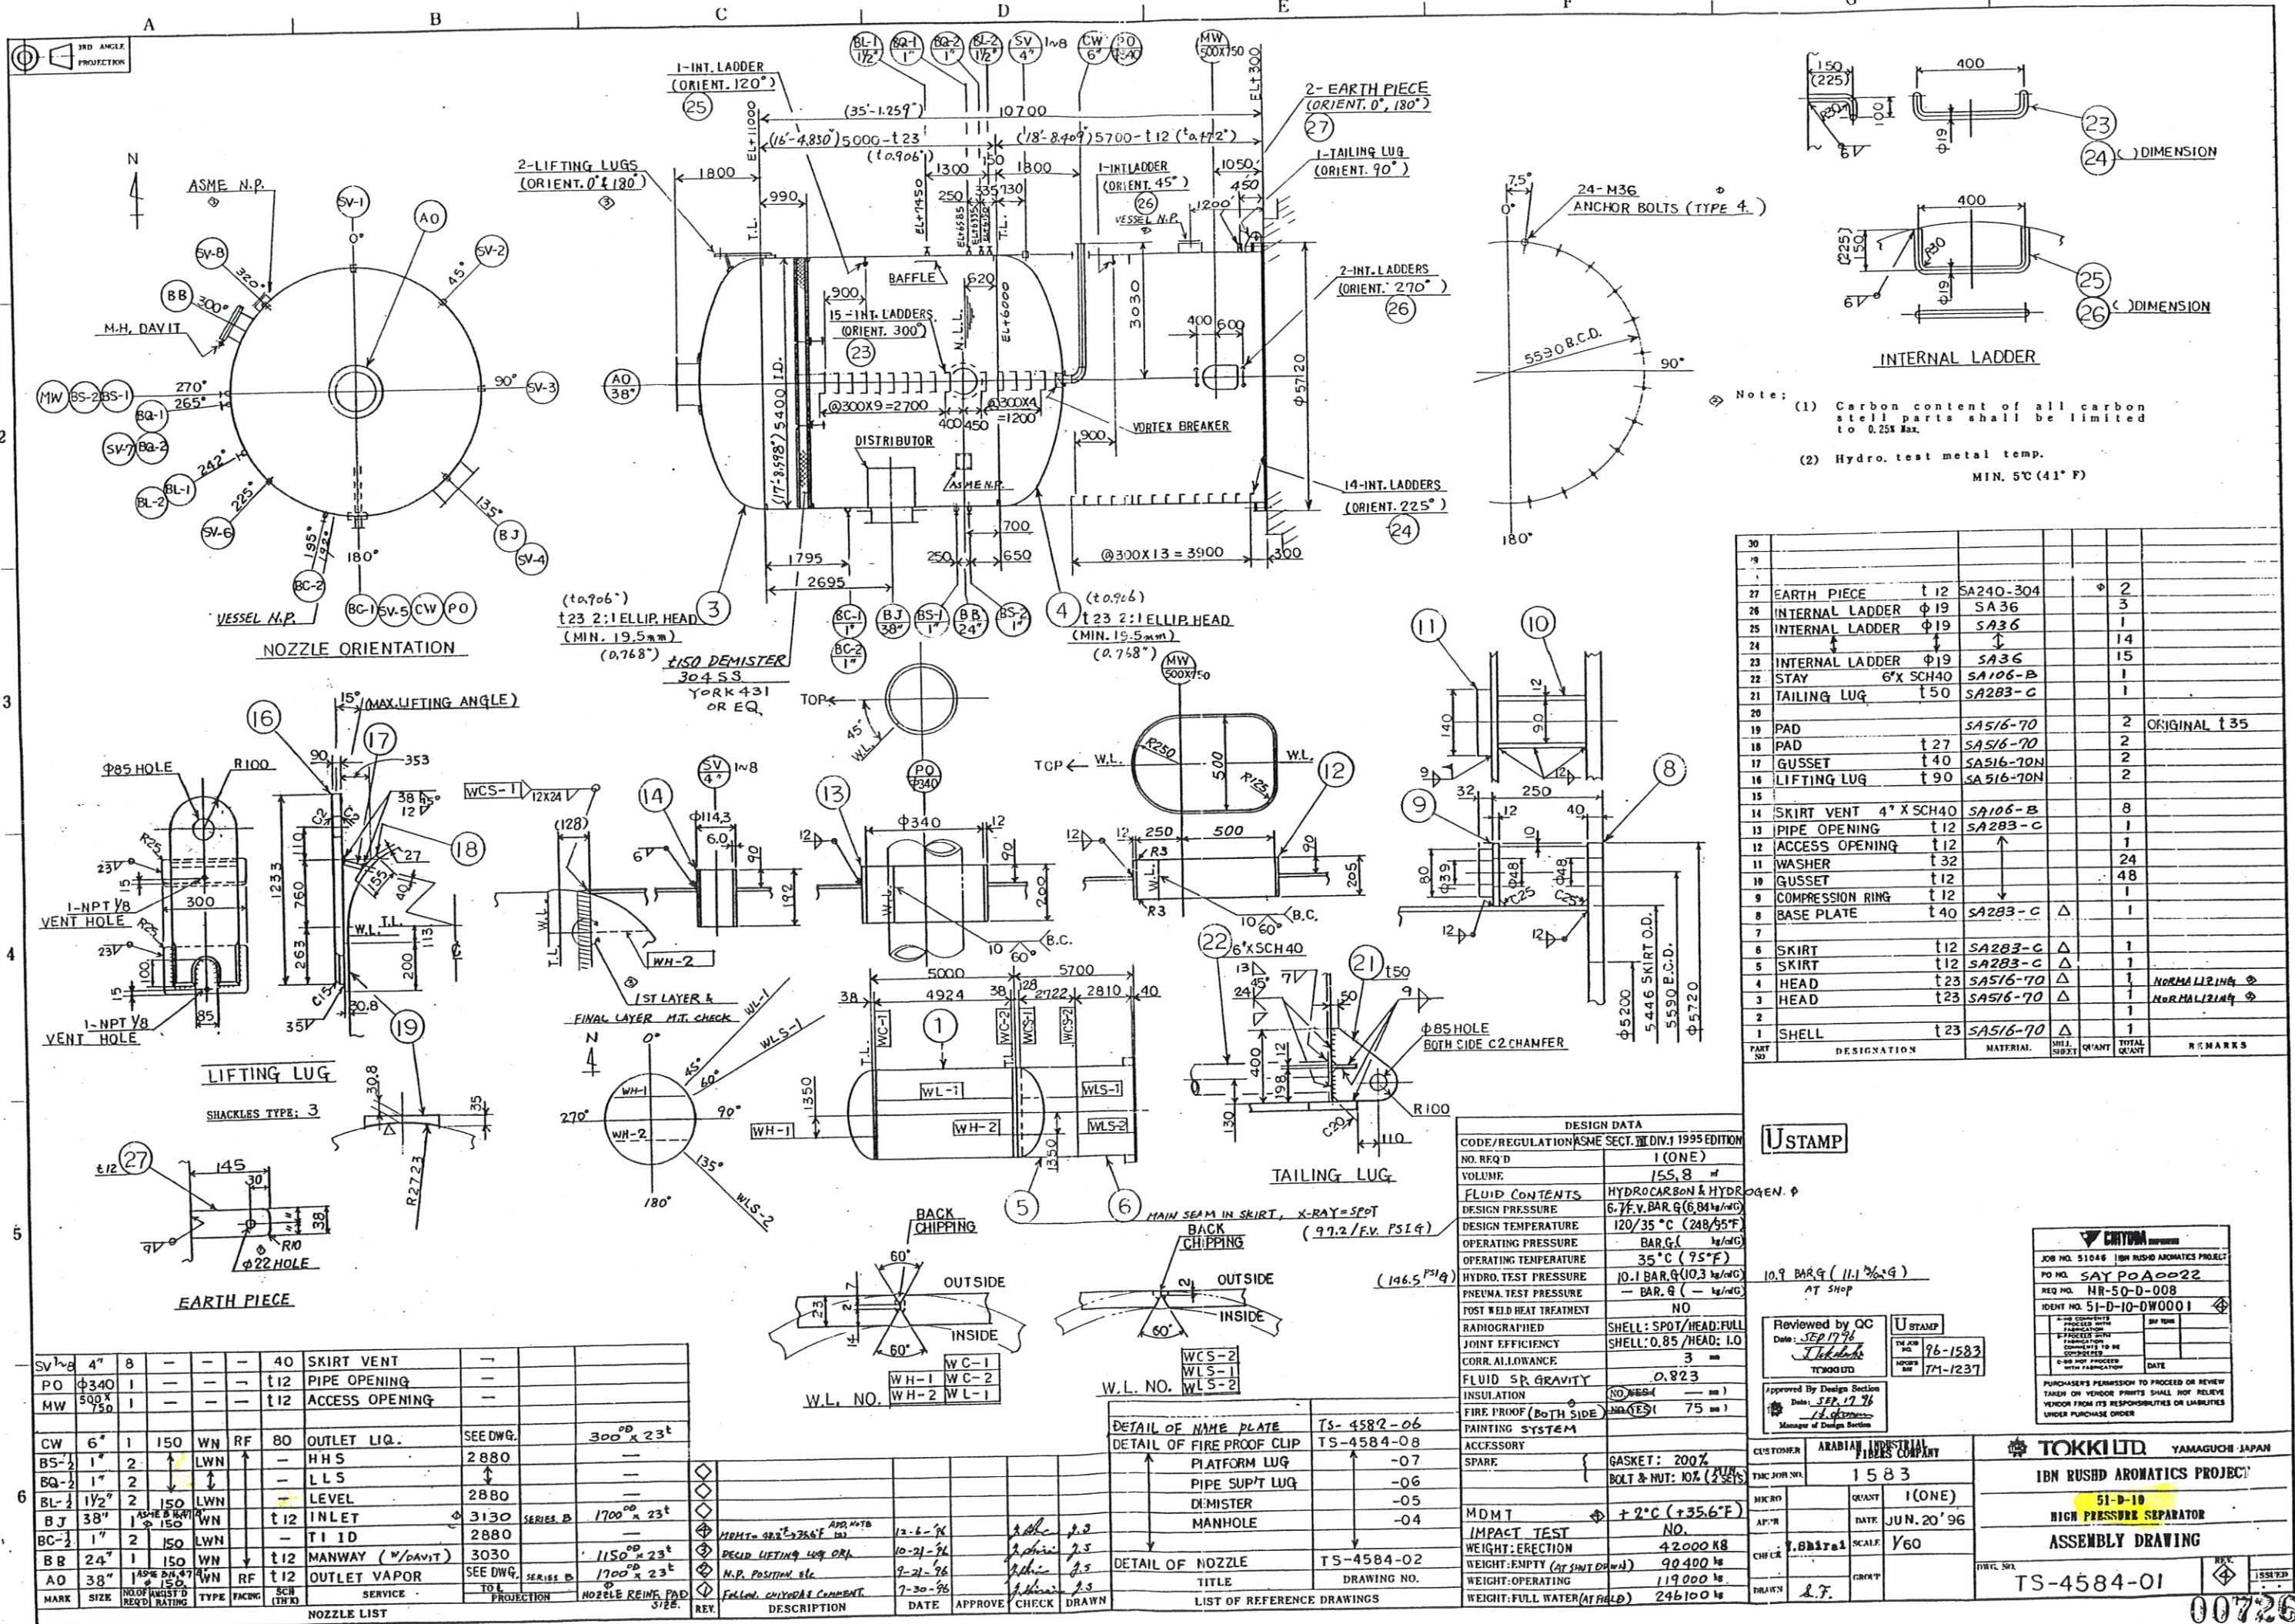

Note: (1) Carbon content of all carbon steel parts shall be limited to 0.25% Max.
(2) Hydro. test metal temp. MIN. 5°C (41° F)

NO.	DESCRIPTION	QTY	REMARKS
27	EARTH PIECE	12	SA240-304
26	INTERNAL LADDER	19	SA 36
25	INTERNAL LADDER	19	SA 36
24	INTERNAL LADDER	19	SA 36
23	INTERNAL LADDER	19	SA 36
22	STAY	6x SCH40	SA106-B
21	TAILING LUG	150	SA283-C
20	PAD	SA516-70	ORIGINAL t35
19	PAD	t27	SA516-70
18	GUSSET	t40	SA516-70N
17	LIFTING LUG	t90	SA516-70N
16	SKIRT VENT	4" X SCH40	SA106-B
15	PIPE OPENING	t12	SA283-C
14	ACCESS OPENING	t12	
13	WASHER	t32	24
12	GUSSET	t12	48
11	COMPRESSION RING	t12	1
10	BASE PLATE	t40	SA283-C
9	SKIRT	t12	SA283-C
8	SKIRT	t12	SA283-C
7	HEAD	t23	SA516-70
6	HEAD	t23	SA516-70
5	SHELL	t23	SA516-70
4	SHELL	t23	SA516-70
3	SHELL	t23	SA516-70
2	SHELL	t23	SA516-70
1	SHELL	t23	SA516-70

DESIGN DATA	
CODE/REGULATION	ASME SECT. VIII DIV.1 1995 EDITION
NO. REQ'D	1 (ONE)
VOLUME	155.8
FLUID CONTENTS	HYDROCARBON & HYDROGEN
DESIGN PRESSURE	6.7 F.V. BAR G (6.84 Mpa)
DESIGN TEMPERATURE	120/35 °C (248/95 °F)
OPERATING PRESSURE	BAR G (-)
OPERATING TEMPERATURE	35 °C (95 °F)
HYDRO. TEST PRESSURE	10.1 BAR G (10.3 Mpa)
PNEUMA. TEST PRESSURE	- BAR G (-)
POST WELD HEAT TREATMENT	NO
RADIOGRAPHED	SHELL: SPOT/HEAD: FULL
JOINT EFFICIENCY	SHELL: 0.85/HEAD: 1.0
CORR. ALLOWANCE	3 mm
FLUID S.G. GRAVITY	0.823
INSULATION	NO
FIRE PROOF (BOTH SIDE)	YES (75 mm)
PAINTING SYSTEM	
ACCESSORY	
SPARE	GASKET: 200% BOLT & NUT: 10% (2 sets)
MDMT	+ 2 °C (+ 35.6 °F)
IMPACT TEST	NO
WEIGHT: ERECTION	42000 kg
WEIGHT: EMPTY (AT SHUT DOWN)	90400 kg
WEIGHT: OPERATING	119000 kg
WEIGHT: FULL WATER (AT FIELD)	246100 kg

U STAMP

Reviewed by QC
Date: SEP 17 96
TOKK LTD


U STAMP
Date: SEP 17 96
TOKK LTD

JOB NO.	51046
PO NO.	SAY POA0022
REQ NO.	HR-50-D-008
IDENT NO.	51-D-10-DW0001
DATE	
BY	
CHECKED	
APPROVED	


CUSTOMER	ARABIAN INDUSTRIAL
TAC JOB NO.	1583
QUANT	1 (ONE)
DATE	JUN. 20 '96
SCALE	Y60
CHKD	Y. Shirel
DRWN	L.F.
PROJECT	IBN RUSHD AROMATICS PROJECT
51-D-10	
HIGH PRESSURE SEPARATOR	
ASSEMBLY DRAWING	
TS-4584-01	

ORDER NO. 56-050-2

DWG No.: 56-050-2 SHT#2 4

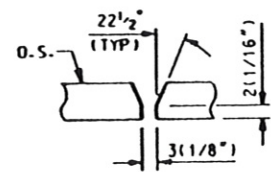

CIRCUM CLOSING SEAM

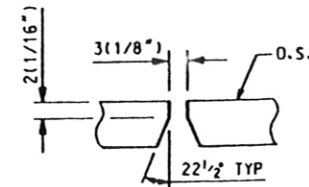


TYP LONG & CIRCUM SEAM U.N.

ITEM	QTY	DESCRIPTION AND SIZE	MAT'L	ADV	REV
2-1	2	3900(153 ⁹ / ₁₆ " O.D. X 21(1 ¹ / ₈ " MIN. THK ASME 2:1 ELLIP. HEAD W/ 51(2") S.F. PER ASME VIII-DIV 1 UG-79, 81 & UCS-79 EDGE PREP. PER SK "A", DET "B6", REV. 1	SA-516-70	A1	
2-2	6	PL 21(1 ¹ / ₈ " X 2870(9'-5") X 12189(39'-11 ⁷ / ₈ ") LG. C/F (6) PL 21(1 ¹ / ₈ " X 2896(114") X 12243 (482") LG.	SA-516-70	A2	1
2-3	1	PL 21(1 ¹ / ₈ " X 2777(9'-1 ⁵ / ₈ ") X 12189(39'-11 ⁷ / ₈ ") LG. C/F (1) PL 21(1 ¹ / ₈ " X 2896(114") X 13462 (530") LG.	SA-516-70	A2A	1

• PER SPEC #PV402-A, PARA. 2.1.6, 2.2.2, 2.2.3.
 CERTIFICATES TYPE REQUIRED IS DIN 50049-3.1-B

B/M SHOWN FOR ONE VESSEL; ONE VESSEL REQUIRED.

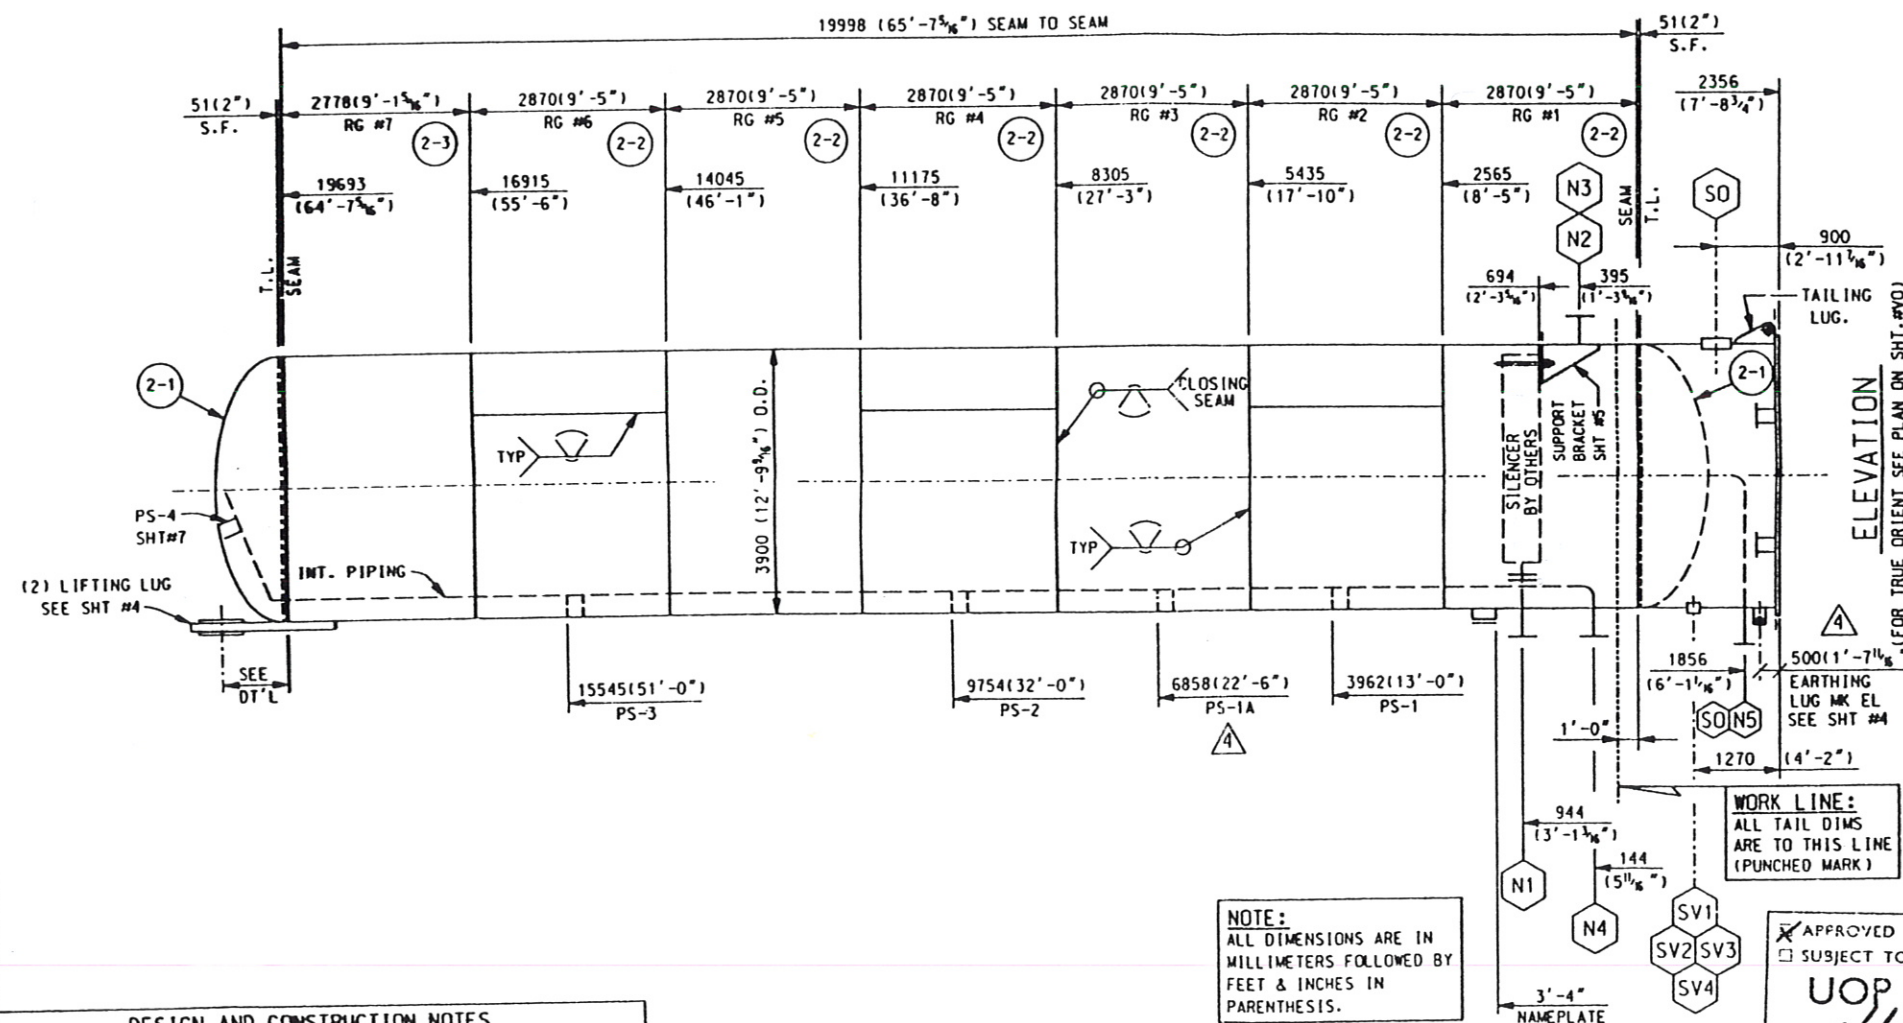

NOTE:
 ALL DIMENSIONS ARE IN
 MILLIMETERS FOLLOWED BY
 FEET & INCHES IN
 PARENTHESIS.

WORK LINE:
 ALL TAIL DIMS
 ARE TO THIS LINE
 (PUNCHED MARK)

RETURNED
 MAR - 7. 1997
 CHIYODA
 V P C

REC'D
 APR 24. 1997
 CHIYODA
 V P C

AS BUILT

CHIYODA CORPORATION	
JOB NO. 51048 (ON REQ. INDICATES PROJECT)	
PO NO. SAYPOAO020	
REQ. NO. MR-SI-Y-002	
DEPT. NO. SI-Y-01-DW 0101	
DATE 3/2/97	
PURCHASER'S PERMISSION TO PROCEED OR REVIEW TAKEN ON VENDOR PRINTS SHALL NOT RELIEVE VENDOR FROM ITS RESPONSIBILITIES OR LIABILITIES UNDER PURCHASE ORDER	

P.O. #64T139702

APPROVED
 SUBJECT TO COMMENTS
 UOP N.Y.
 DATE 12/1/96 BY J/S

NO.	DATE	BY	CHK	REVISIONS
12-9	96	BT	BOB	REVISED AS NOTED
2-15	97	BT	BOB	SEE DRR-3
				FINAL AS BUILT- SEE DRR-4

DESIGN AND CONSTRUCTION NOTES

- DESIGN PER ASME CODE: SECTION VIII DIV 1, 95 ED. A95
- STRESS RELIEVING: N/A
- RADIOGRAPH: 100%
- JOINT EFFICIENCY: HEAD 1.0 SHELL 1.0
- CORR. ALLOW.: HEAD 1.5(1¹/₈") SHELL 1.5(1¹/₈") NOZZS 1.5(1¹/₈")
- MIN. DESIGN METAL TEMP.: 9 °C (49 °F)
- INT DSG PRESS: 11 BARG(159 PSI) @ 120°C(248°F)
EXT DSG PRESS: 0 BARG(0 PSI) @ 148°C(300°F)
- M.A.W.P.: 11.8 BARG(171 PSI); MAPIN & C: 12.8 BARG(186 PSI)
- OPER. PRESS. 4.7 BARG(68 PSI) @ 37°C (99) °F
- HYDROSTATIC TEST PRESS. 19.2 BARG(279 PSI)
- PAINT: YES. SEE DWG 56-050-2 SHT #9

SCHEDULE OF OPENINGS

MARK	QTY	SIZE	SERVICE	DWG #	MARK	QTY	SIZE	SERVICE	DWG #
N1	1	12" -150# RF	INLET	SHT #5					
N2	1	24" -150# RF	MANWAY W/ DAVIT	SHT #5					
N3	1	2" -150# RF	OUTLET	SHT #5					
N4	1	2" -150# RF	VENT	SHT #7					
N5	1	2" -150# RF	DRAIN	SHT #6					
SO	2	21 1/4" X 31 1/8"	SKIRT OPENING	SHT #3					
SV1 THRU SV4	4	4"	SKIRT VENTS	SHT #3					
SS	1	4"	SKIRT SLEEVE F/ NOZZ H5	SHT #6					

ORDER NO. 56-050-2

GRAVER TANK & MFG. CO. INC.

(1) 3859 (151⁵/₈") I.D. X
 20100 (65'-11³/₈") T/T VERT P/V
 (SURGE DRUM) ITEM NO.: 51-D-23

ELEVATION

DWN: BT 8-20-96 CUST: UOP / IBN RUSHO
 YANBU, SAUDI ARABIA
 CHK: MB 9-13-96 56-050-2 SHT#2 4
 DWG. NO. REV.

MASTER FILE: ELEV

THIS DRAWING IS NOT TO BE REPRODUCED, COPIED, LENT OR DISPOSED OF WITHOUT PERMISSION.

AS BUILT

24" -
 12"


DRUM SPECIFICATION SHEET

FOR RECORD

CLIENT Arabian Industrial Fibers Company
PROJECT
TITLE Saudi Aromatics Yanbu Project
JOB NO. 51046
DOC.NO. DS-52-D-031 (1 / 1)

REV	BY	CHKD	APVD	DATE	MADE	CHKD	APVD	DATE
⑤	K. Hala	J.T.	G. J. S.	Feb 27 '96	MADE	J.T.	G.F.	Mar., 14, '96
④	I	J.T.	G. J. S.	7/19, '96	MADE	J.T.	G.F.	
③								

ITEM NO.: 52-D-31
SERVICE: CONDENSATE DRUM FOR 52-KS-01
NO. REQD.: 1

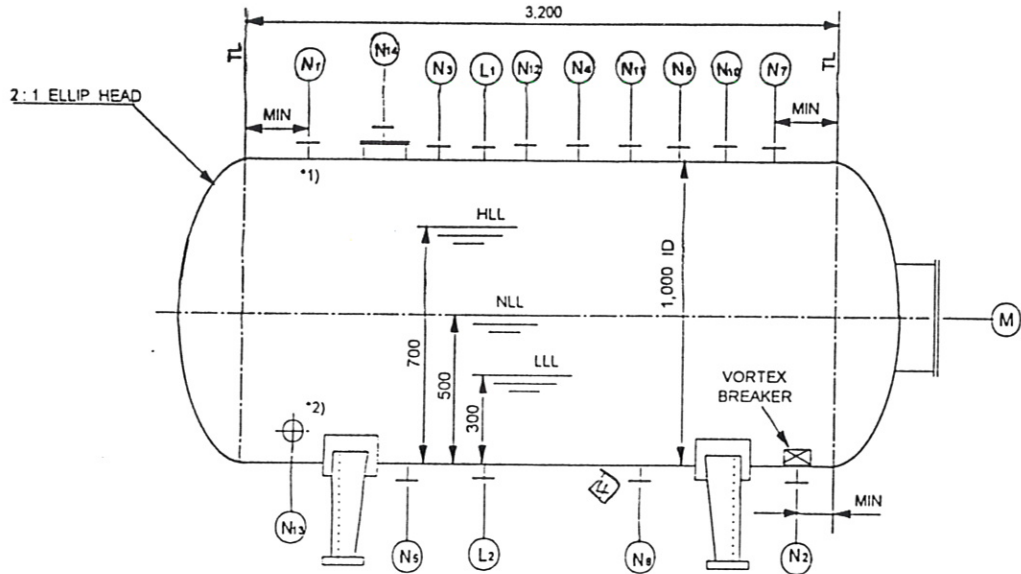

*2) BELOW LLL.
*1) FOR INTERNAL OF N1 NOZZLE, REFER TO UOP STD DWG. 3-190-4.

THIS DOCUMENT AND ANY DATA AND INFORMATION CONTAINED THEREIN ARE CONFIDENTIAL AND THE PROPERTY OF CHIYODA CORPORATION (CHIYODA) AND THE COPYRIGHT THEREIN IS VESTED IN CHIYODA. NO PART OF THIS DOCUMENT, DATA OR INFORMATION SHALL BE DISCLOSED TO OTHERS OR REPRODUCED IN ANY MANNER OR USED FOR ANY PURPOSE WHATSOEVER, EXCEPT WITH THE PRIOR WRITTEN PERMISSION OF CHIYODA.

OPERATING CONDITION				REMARKS			
FLUID:	CONDENSATE						
PRESSURE:	-0.86	BarG		L _{1,2}	2"	LT / LG	2 150# RF
TEMPERATURE:	54	°C		M	20"	MANHOLE	1 150# RF
LIQUID DENSITY:	987	Kg/m ³		N _{1,4}	4"X2"	VENT	1 150# RF
TOTAL VOLUME:	2.8	m ³		N _{1,2}	1"	TI	1 150# RF
NORMAL LIQUID HOLD-UP:	1.4	m ³	2.5 min.	N _{1,2}	3"	LINE DRAIN	1 150# RF
CONTROL RANGE REQUIRED:	2.6	min.	400 mm	N _{1,1}	1 1/2"	DWN INLET	1 150# RF
DESIGN CONDITION				N _{1,0}	3"	PUMP VENT	1 150# RF
CODE/REGULATION:	(ASME Sec. VIII div. 1, 1995)			N ₄	2"	COND RTN	1 150# RF
INSIDE DIA. & TL-TL LENGTH:	1,000 mm	3,200 mm		N ₇	1"	PG	1 150# RF
DESIGN PRESS. & TEMP.:	1.5/FV BarG	180 °C		N ₅	2"	MIN FLOW	1 150# RF
TEST PRESS. HYDROSTATIC:	18.22	BarG		N ₅	2"	DRAIN	1 150# RF
PNEUMATIC:		BarG		N ₄	3"	EQUALIZING	1 150# RF
CORROSION ALLOWANCE:	3.0	mm		N ₃	2"	EJECTOR CONN.	1 150# RF
POSTWELD HEAT TREATMENT:	CODE ☐ YES ☐ NO			N ₂	6"	CONDENSATE OUTLET	1 150# RF
RADIOGRAPHIC:	FULL ☐ SPOT ☐ % ☐ NO ☐ CODE			N ₁	6"	CONDENSATE INLET*1	1 150# RF
JOINT EFF.:	SHELL	%	HEAD				
MATERIAL				MARK	SIZE	SERVICE	Q'TY RATING
SHELL:	SA516-70			NOZZLE SCHEDULE			
HEAD:	SA516-70						
TRAY/INTERNAL:	CS			WEIGHT: ELECTION			
SUPPORT:	CS			OPERATION			
NOZZLE FRANGE:	SA105			FULL WATER			
NECK:				ACCESSORIES SUPPLIED BY MANUFACTURER			
GASKET:	SWG (Non Asst)			LADDER & PLATFORM CLIPS, PIPE SPRT CLIPS, DAVID,			
BOLT & NUT:	EXT. INT.			LIFTING LUG, CORROSION CAGE POINT, EARTH PIECE,			
INSULATION:	☒ NO ☐ HOT ☐ COLD ☐ PP mm			INTERNAL LADDER (SHELL, SKIRT), TEMPLATE,			
FIRE PROOF:	☐ YES ☒ NO			ANCHOR OR SETTING BOLTS, SLIDING PLATE,			

