


DR-000-LE-007

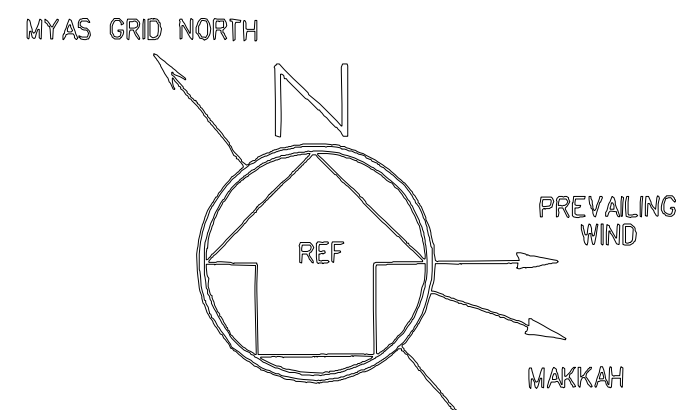

LEGEND	
	NEW-2: NEW FACILITY ON EXISTING FACILITY LOCATION
	DBN UNITS (PTA)
	NEW UNITS (ETP-III)

EQUIPMENT LIST		
EQUIP. No.	DESCRIPTION	ELEVATION
119-G-003	PTA FLARE KNOCKOUT DRUM	P.O.S. EL.103.750
119-G-005	PTA FLARE KO.DRUM PUMP	U/S BASEPLATE EL.101.200
119-G-006	PTA FLARE KO.DRUM PUMP	U/S BASEPLATE EL.101.200
120-Y-001	EFFLUENT TREATMENT PACKAGE	---
121-Y-001	INCINERATOR PACKAGE	---
000-G-014 / 035	STORM WATER SUMP PUMP (NEW-2)	---
000-G-015 / 036	STORM WATER SUMP PUMP (NEW-2)	---
000-G-016 / 037	CONTAMINATED STORM WATER SUMP PUMP (NEW-2)	---

EQUIPMENT LIST		
EQUIP. No.	DESCRIPTION	ELEVATION
000-G-005	SANITARY SUMP PUMP	---
000-G-006	SANITARY SUMP PUMP	---
000-G-007	SANITARY SUMP PUMP	---
000-G-008	SANITARY SUMP PUMP	---
000-G-009	SANITARY SUMP PUMP	---
000-G-010	SANITARY SUMP PUMP	---
000-G-014	STORM WATER SUMP PUMP	---
000-G-015	STORM WATER SUMP PUMP	---
000-G-016	STORM WATER SUMP PUMP	---
000-G-024	STORM WATER SUMP PUMP	---
000-G-025	STORM WATER SUMP PUMP	---
000-G-033	SANITARY SUMP PUMP	---
000-G-034	SANITARY SUMP PUMP	---
000-G-035	CONTAMINATED STORM WATER COLLECTION BASIN	---
000-G-036	CONTAMINATED STORM WATER COLLECTION BASIN	---
000-G-037	CONTAMINATED STORM WATER COLLECTION BASIN	---
000-PSL-004	FENCE LIGHTING SUB-STATION	---
000-Q-001	CONTAM. STORM WATER COLLECTION BASIN	---
000-Q-002	CONTAM. STORM WATER COLLECTION BASIN	---
000-Q-003	CONTAM. STORM WATER COLLECTION BASIN	---
000-Q-005	SANITARY PUMPING STATION	---
000-Q-008	SANITARY PUMPING STATION	---
000-Q-007	SANITARY PUMPING STATION	---
000-Q-011	STORM WATER PUMPING STATION	---
000-Q-013	SANITARY PUMPING STATION	---
000-Y-011	OILY WATER SEPARATOR PACKAGE	---


NOTES

- ALL COORDINATES ARE GIVEN IN METRES RELATIVE TO THE PLANT GRID SYSTEM.
- PLANT GRID ORIGIN E. 3000.000; N. 3000.000 EQUALS E. 25628.909; N. 37720.922 M.Y.A.S. PLANE GRID SYSTEM
- ALL ELEVATIONS ARE GIVEN IN METRES RELATIVE TO THE PLANT DATUM.
PLANT DATUM EL.100.000m (HPP) - 7.250 m M.Y.A.S. DATUM.
- HOLD ITEMS.
4.1 THIS PLOT ISSUE IS BASED ON PRELIMINARY INFORMATION TO DEVELOPING, AND THE RELATED DIMENSION OF PLAN AND ELEVATION OF STRUCTURE SHALL BE VERIFIED.
4.2 ALL RELATED DIMENSION OF 'HOLD' EQUIPMENT SHALL BE ADJUSTED IN ACCORDANCE WITH ADVANCED VERIFIED ENGINEERING DRAWING AND VENDOR INFORMATION
4.3 HOLD EQUIPMENT SEE EQUIPMENT LIST.

REFERENCE DRAWINGS

DRAWING No.	TITLE
DR-000-LE-001	OVERALL PLOT PLAN
3049/005	EFFLUENT TREATMENT PACKAGE PLOT PLAN
D-D-5-32703-00-28-001	INCINERATOR PACKAGE PLOT PLAN
DR-010-AE-211-009	COMPRESSED AIR EQUIPMENT LAYOUT PLAN & SECTION
DR-120-AE-5001	AREA PLOT PLAN FOR ETP-III

KEY PLAN

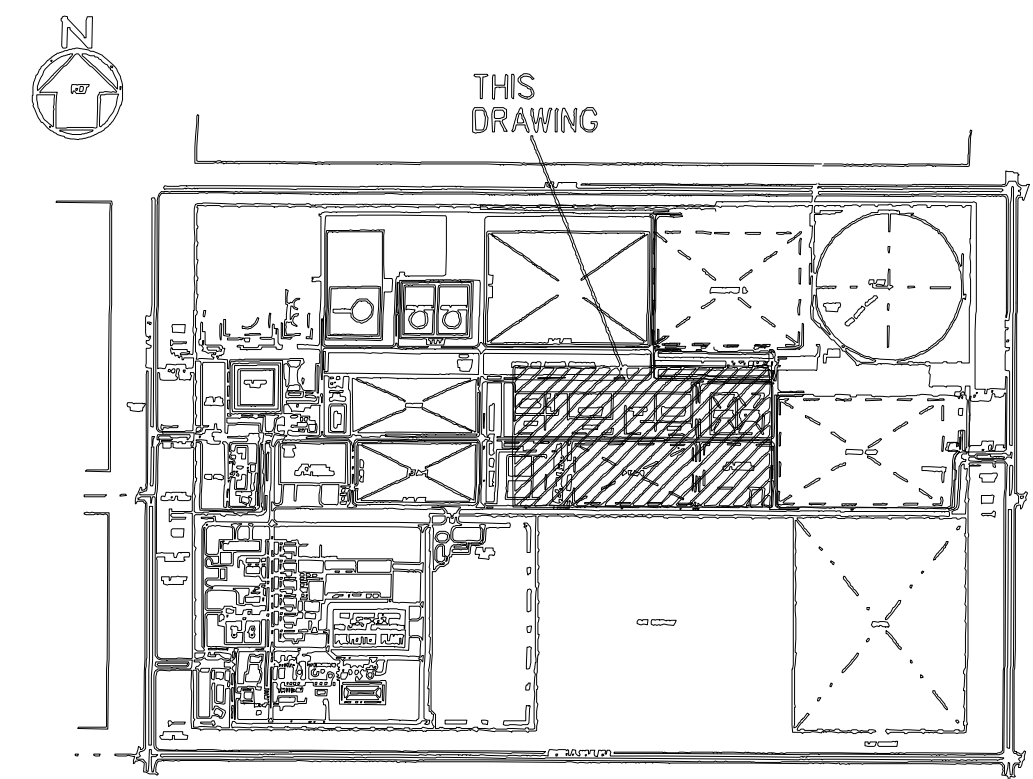

	AS BUILT	NICD	JYH	WEI	CHU	12 / MAR 2014
	REVISED PER UD-T-PT-CT-PP-2880	YEH	CHEN	WEI	CHU	19 / FEB 2015
	ISSUED FOR CONSTRUCTION	YEH	CHEN	WEI	CHU	07 / OCT 2011
	RESUBMIT PER UD-T-PT-CT-PP-0647	YEH	CHEN	WEI	CHU	13 / JUN 2011
	ISSUED FOR DESIGN	YEH	CHEN	WEI	CHU	05 / MAY 2011
	ISSUED FOR APPROVAL PER UD-T-PT-CT-PP-0647	YEH	M.C.C.	WEI	CHU	16 / MAR 2011
MD	REVISION	BY	CHK	APPR	PRD.J	DATE

سابك
SABIC
Saudi Basic Industries Corporation
Engineering and Project Management
Jubail, Kingdom of Saudi Arabia


ابن رشيد
ibn rashid
Arabian Industrial Fibers Company

中興工程股份有限公司
CTCI CORPORATION

FOR
IR-II U&O DBN PROJECT

TITLE
PLOT PLAN - AREA 5

CERTIFIED FOR CONSTRUCTION		DWG.	DSGL	CHK.	APPR.
BY DANIEL HSU		BY YEH	YEH	M.C.C.	WEI
DATE 2011/10/07		DATE 17/FEB/2011	17/FEB/2011	11/MAR/2011	16/MAR/2011
DWG. SIZE A0	IR DRAWING NO.	DR-000-LE-007		SH. 1	
CTCI PROJ. NO. 10C0541A02	CTCI DRAWING NO.	XB32-000-004		REV. 5	

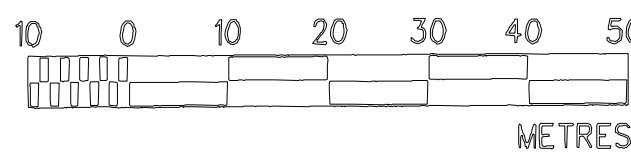

AS BUILT