

MATERIALS

COMPONENTS	MATERIALS SPECIFICATIONS
PLATES	
1 SHELLS	SA 240 304L (G5)
HEADS	SA 240 304L (G5)
4 NOZZLE FROM PLATE	SA 240 304L
5 REINFORCING PADS	SA 240 304L
6 SUPPORT SADDLES	SA 285 GR C
7 TRANSITION PLATE	SA 240 304L
9 INTERNALS	AISI 304 L
10 INTERNAL SUPPORTS	AISI 304 L
11 PLATF.&LADDERS SUPP.	SA 240 304L + SA 285 C
PIPES	
NOZZLES FROM PIPE	SA 312 TP304L (smls)
INTERNAL PIPES	SA 312 TP304L (smls)
FORGINGS	
1 FL. & BLIND	SA 182 F304L
BOLTING	
1 INT. STUD B. & NUTS	-
2 EXT. STUD B. & NUTS	A 193 B7/A 194 2H
SHAPES	
3 INSULATION SUPPORTS	SA 240 304L + SA 285 C
INTERNAL SHAPES	
GASKETS	
1 EXT. GASKETS	GFP (GLASS FIBRE FILLED PTFE)
2 INT. GASKETS	-
NOTES	
FLANGE FINISHING	6.4÷12.5 MICROMETERS Ra(ISO 468)
TREATMENTS	
RADIOGRAPHY	SPOT
STRESS RELIEVING	NOT REQ'D
DIMENSIONS	
PIPES	ASME B36.19M
FLANGES	ANSI B16.5
FITTINGS	ANSI B16.9
THREADS	ASME B1.1 CLASS 2A OR 2B
GASKETS	API 601

NOZZLES

MARK	N.D. in	RATING	FLANGES TYPE	FAC.	THK. mm	R.PAD D.xTHK. mm	PROJ. FM CL mm	OR.	ECC. mm	SERVICE	NOTES
N1	1.5"	150	LWN	RF	-	-	1575	-	-	BUTYL ACETATE MAKE-UP	
N2	3"	150	WN	RF	5.4	190x8	1575	-	-	LIQUID OUTLET	
N3	1.5"	150	LWN	RF	-	-	1575	-	-	LIQUID INLET	
N4	6"	150	WN	RF	7.1	270x8	1575	-	-	VENT	
N5	1"	150	LWN	RF	-	-	SEE DWG	-	-	UTILITY CONNECTION	
L1A	3"	150	WN	RF	5.4	190x8	1575	-	-	LEVEL BRIDLE	
L1B	3"	150	WN	RF	5.4	190x8	1575	-	-	LEVEL BRIDLE	
T1	1.5"	150	LWN	RF	-	-	SEE DWG	-	-	TEMPERATURE CONNECTION	
M1	24"	150	WN	RF	8.0	930x8	SEE DWG	-	-	MANWAY	Bl.flange, Davit

GENERAL NOTES

- The static pressure of the contents shall be added to this pressure.
- This vessel is subject to steamout at 120°C. and 0.5 bar g. (0.5 F.V.)
- All dimensions are in mm (unless otherwise specified)
- The indicated thicknesses are the minimum acceptable after construction.
- Nozzles projections referred from vessel centerline to flange contact face.
- Nozzles flange stud bolts holes straddle C.L.
- ASME "U" stamp is not req'd.
- Reinforcing plates shall be provided with 1/4 inch NPT diameter tell tale holes, to be filled with grease.
- All instrument nozzles sizes and location are hold.
- 90-100% butyl acetate, 0-10% water and acetic acid.

WEIGHTS & LOADING DATA

	ERECT.	TEST	OPERAT.
WEIGHTS Kgf	6380	57340	49320
EART.VERT.LOADS N	-	-	-
SHEAR	-	-	-
LG.WIND/EARTH. N	8160 / 9180	1632 / -	8872 / 77806
TV.WIND/EARTH. N	18152 / 9180	3671 / -	28145 / 86780
MOMENT	-	-	-
LG.WIND/EARTH. N.m	12645 / 14380	2550 / -	13971 / 122062
TV.WIND/EARTH. N.m	28451 / 14380	5711 / -	44053 / 136135

REFERENCE STANDARDS

Q01-E15	VESSEL LIFTING LUGS: TWO PLATE TYPE
Q01-F01	PRESSURE VESSELS: WELDING AND FABRICATION
Q01-F07	PRESSURE VESSELS - FABRICATION
Q01-F13	STEEL SADDLES SUPPORTS FOR HORIZONTAL VESSELS
Q01-F15	VESSELS: NAME PLATE AND STAMPING
Q01-F17	GRAB RUNGS AND STEPS FOR MANWAYS
Q01-F18	VORTEX BREAKER
Q01-F20	DAVIT FOR OUTDOOR MANHOLE COVERS
Q01-F21	VESSELS: PIPE GUIDE
Q01-F22	PRESSURE VESSELS: PIPE SUPPORT
Q01-F23/VEVF 1123	VESSELS: INSULATION AND FIRE PROOFING SUPPORT
Q01-F25	VESSELS: GROUNDING AND LUG DETAILS
Q01-F28	ALLOWABLE FABRICATION TOLERANCES HORIZONTAL AND VERTICAL PRESSURE VESSEL
Q01-F37	AUSTENITIC AND H.A. STEEL PRESS. VESSEL: FABRICATION
Q01-T02	INSPECTION REQUIREMENTS FOR PRESSURE VESSELS
W01-F01	WELDING AND INSPECTION
22854-SP-000-X-002	SHOP AND FIELD PAINTING
SZ5D	RECOMMENDED COATING SYSTEMS FOR EXTERNAL PROTECTION
1000.00.ST.0800.01	NAME PLATE
Q01-E01	PRESSURE VESSELS - GENERAL
Q01-E14	HORIZONTAL VESSEL ON TWO SADDLE: DESIGN
Q01-T01	TESTING AND INSPECTION - PRESSURE VESSELS
Q01-T06	PRESSURE VESSELS MATERIAL CONTROL PROGRAM
Q01-T07	MATERIALS IDENTIFICATION PROGRAM

REVISIONS

REV	DATE	DESCRIPTION	PREP.D	CHKD	APPD.	AUT.D
0	30-09-2002	ISSUED FOR PURCHASE TO M.I.S.	OE LUCA	MERET	IORIO	TILLI
B	04-07-2002	REVISED AS SHOWN-REISSUED FOR INQUIRY	OE LUCA	MERET	IORIO	TILLI
1	25-11-2002	REVISED AS SHOWN	OE LUCA	MERET	IORIO	TILLI

DESIGN DATA

CALCULAT. CODES		ASME VIII DIV.1 LAST EDIT. (NOTE 7)								
ALLOW.STRESSES		ASME VIII DIV.1 LAST EDIT.								
INSPECTION		SEE MR								
SPECIFICATIONS		SEE MR								
WIND/EARTHQUAKE		SEE JSD 0400.01 /SEE JSD 0400.01								
TYPE OF TEST		HYDRAULIC								
POSITION IN TEST		HORIZONTAL								
FLUID		(10)								
HAZARD CONSIDERATIONS		FLAMMABLE/TOXIC								
FLUID DENSITY		815/890 Kg/m3								
No.	ELEMENT	PRESSURE Bars g (1) (2)			TEST	TEMPERATURE °c			EFF.	CORR. mm
		DESIGN				DESIGN				
		1st	2nd	Ext.		1st	2nd	Ext.		
1	HEAD	5.0	-	F.V.	BY MFR 1	105	-	105	.85	-
2	SHELL	5.0	-	F.V.		105	-	105	.85	-
3	HEAD	5.0	-	F.V.		105	-	105	.85	-
		OPERATION Bars g				OPERATION				
		1.40	-			NORM 47/MAX 85/MIN 9				
MAX OPER. STATIC HEAD		FULL		m		1				
TOTAL VOLUME		48.45		m3						
EMPTY WEIGHT		6380		Kgf						
REMOV.INTERNAL WEIGHT		-		Kgf						
TRAYS WEIGHT		-		Kgf						
PACKING WEIGHT		-		Kgf						
EXTERNAL SURFACE		82		m2		(SUPPORTS EXCLUDED)				

LINING & PAINTING DATA

	TYPE	THK. mm	SURF. m2
INSULATION 1	P.P.	40	83
INSULATION 2	-	-	-
EXT. PAINTING	SEE REFER. STANDARD	-	-
INT. COATING	-	-	-
FIRE PROOFING	-	-	-
SURF. PREPAR. INT./EXT.	SEE REFER. STANDARD	-	-

TECHNIP-COFLEXIP

سابك
sabicSABIC ACETIC ACID PLANT
IBN RUSHD SITE - YANBU - KINGDOM OF SAUDI ARABIA

XXXX	ITEM : 100-D252
Status	SERVICE : ENTRAINER HOLDING DRUM
CAD model	
/	2121 05 DW 0811 - 02 1 of 2 1
Scale	Project Unit Type of doc. Code & progressive Sheet Rev.

GENERAL NOTES

- All dimensions are in mm (unless otherwise specified)
- Indicated values refer to one apparatus only.
- The indicated thicknesses are the minimum acceptable after construction.
- Nozzles projections referred from reactor centerline to flange contact face.
- Nozzles flange stud bolts holes straddle C.L.
- Nozzles flange contact faces finishing shall be: 3.2 TO 6.3 micrometers Ra (ISO468)
- ASME "U" stamp req'd.
the side is subject to steamout at 120°C. and 0.5 barg
shell side to be raised to 120°C. before steamout)
- Tubes shall be verified at ext. pressure of 67.0 barg at 315°C.
- Vendor shall verify and modify projections in order to dismount bolts from back side of flanges.
- Clad plate according to SA 264
- Pipe fittings shall be the same size and thickness as the attached pipe, elbows and bends shall be long radius type unless otherwise noted.
- All stainless steel welds (including heat effect zones) shall be dye penetrant inspected.
- tube to lower tubesheet joint to be strenght welded to tubesheet and tested in accordance with fig.2a of EEMUA 143 or equivalent.
Tube to upper tubesheet joint to have an equivalent integrity welded joint as the lower but the joint is to form a smooth contour to allow complete drainage of top channel.
Tube to tubesheet joints to be lightly expanded after welding.
- Tube holes in tubesheets to be TEMA special close fit.
- A detailed tube-hole layout shall be produced by the equipment supplier, who shall confirm the vessel diameter on the basis of the tube - hole layout.
- Tubesheet details shown on the attached sheets are typical only, alternative arrangements may be acceptable. The equipment supplier shall carry out a detailed analysis to confirm the integrity of the chosen arrangement.
Design shall consider: A) Design-life pressure and temperature cycles agreed between Detailed engineering contractor and Supplier.
B) Pressure drop through the catalyst tubes.
C) the worst combination of pressure/no pressure on either side of tubesheet.
- Water inlets (A to H) and steam outlets (A to H) are to be equi spaced around the shell circumference.
- The following data shall be used in the equipment and catalyst support device design :
-Catalyst density : 1460 - 1550 Kg/m³
-catalyst size : 3.175mm x 3.175mm (cylindrical)
-Design pressure drop through catalyst : 8.0 Bar (downwards).
Top of tubes are to be filled with 6mm diameter inert balls.
Vendor shall include details of proposed catalyst support. Vendor to supply catalyst support plus 5% spare and include any necessary insertion / removal tools.
Vendor shall perform a pullout test on 3 sample catalyst support using a section of production tube prior to manufacture of the remaining catalyst support. test load on spring to be 100 Kg minimum.
- Tubeside process gas at inlet is as follows (mol%):
Normal operation-48.5% C₂H₆; 20.3% CH₄; 18.3% N₂; 5.1% CO₂; 5% O₂; 1.5% C₂H₄; 0.9% H₂O
0.2% C₃H₈; 0.2% Ar.; 0.1% impurities.
Start-up/Shutdown- Nitrogen
- The equipment operating conditions are the following :
Case 1 SOR 43.2 bara at 255 °C 33.0/28.1 bara at 225/258 °C
Case 2 EOR 55.1 bara at 270 °C 33.0/27.2 bara at 225/271 °C
Future case 29 bara at 232 °C
- In addition of design conditions specified on design data, the tubes, tubesheets and shell side barrel shall be designed for the following combinations of temperature and pressure.
SHELL SIDE
-Case 1 43.2 bara at 255 °C 33.0 bara at 259 °C Tube Average Metal Temperature
-Case 2 55.1 bara at 270 °C 33.0 bara at 271 °C Tube Average Metal Temperature
-Case 3 55.1 bara at 270 °C 33.0 bara at 267 °C Tube Average Metal Temperature
Case 3 is emergency shutdown and purge.
- At shutdown shellside will be cooled at a rate of 15 °C/hour.
The maximum allowable differential metal temperature between tubes and shell is to be advised by vendor.
The equipment Supplier is required to confirm that shell bellows will not be required.
Vendor is to ensure all manifolds are subjected to flexibility analysis.
- Tube support grids shall preferably be of rod or bar type and designed by equipment supplier. Other design may be acceptable and are to be detailed in quotation.
Equipment supplier to advise number of tube support grids required. Tube support must not cause vapour pockets or disturb vapour flow. Equipment supplier to ensure that vibration is avoided during all cases listed above.
- All tube side surfaces in contact with the process gas shall be thoroughly cleaned and degreased prior to despatch.
- If solid stainless steel nozzles are used the vendor must ensure that mechanical properties are not impaired by Post Weld Heat Treatment.
- Details shown for perforated impingement cylinder and flow baffle are typical only.
To be designed impingement cylinder and flow baffle to ensure even distribution of water across tube bundle. Vapour release holes are to be provided in the flow baffle between tubes
- Temperature T1 to T4 are accommodate 20 tubeside thermocouples (18 "in tube" and 2 reactor head thermocouples). The two reactor head thermocouples shall be secured to the inside of the top dished head (see detail on follow sheets).

NOZZLES

MARK	N.D. in	FLANGES			THK. mm	R.PAD D.xTHK. mm	PROJ. FM CL (4) mm	OR.	ECC. mm	SERVICE	NOTES
		RATING	TYPE	FAC.							
N1	16	600	WN	RF	12.7+3	SELF REINF	SEE DWG	-	-	GAS INLET	
N2	16	600	WN	RF	12.7+3	SELF REINF	SEE DWG	-	-	GAS OUTLET	
N3A	12		BUTT WELD		12.7	SELF REINF	SEE DWG	-	-	STEAM OUTLET FROM MANIFOLD	
N3B	12		BUTT WELD		12.7	SELF REINF	SEE DWG	-	-	STEAM OUTLET FROM MANIFOLD	
N4A	6		BUTT WELD		11	SELF REINF	2050	-	-	PUMP DISCHARGE	
N4B	6		BUTT WELD		11	SELF REINF	2050	-	-	PUMP DISCHARGE	
N5	1.5	600	LWN	RF	-	-	2040	-	-	STEAM VENT	
N6	2		BUTT WELD		8.7	SELF REINF	2000	-	-	INTERMITTENT BLOWDOWN	
N7	1.5	600	LWN	RF	-	-	2000	-	-	UTILITY CONNECTION	
N8	2"	600	LWN	RF	-	-	SEE DWG	-	-	GAS VENT	
N9A	10"		BUTT WELD		12.7	SELF REINF	SEE DWG	-	-	DOWNCOMER CONNECTION TO MANIFOLD	
N9B	10"		BUTT WELD		12.7	SELF REINF	SEE DWG	-	-	DOWNCOMER CONNECTION TO MANIFOLD	
N10	1"	600	LWN	RF	-	-	2020	-	-	DRAIN	(BL. FLG.)
P1	1.5	600	LWN	RF	-	-	2000	-	-	PRESSURE TAPPING	
P2	1.5	600	LWN	RF	-	-	2000	-	-	PRESSURE TAPPING	
P3	1.5	600	LWN	RF	-	-	SEE DWG	-	-	PRESSURE TAPPING	
P4	1.5	600	LWN	RF	-	-	SEE DWG	-	-	PRESSURE TAPPING	
T1	4	600	WN	RF	11.1+3	SELF REINF	SEE DWG	-	-	TEMPERATURE TAPPING	
T2	4	600	WN	RF	11.1+3	SELF REINF	SEE DWG	-	-	TEMPERATURE TAPPING	
T3	4	600	WN	RF	11.1+3	SELF REINF	SEE DWG	-	-	TEMPERATURE TAPPING	
T4	4	600	WN	RF	11.1+3	SELF REINF	SEE DWG	-	-	TEMPERATURE TAPPING	
T5	1.5	900	LWN	RF	-	-	SEE DWG	-	-	TEMPERATURE TAPPING	
T6	1.5	900	LWN	RF	-	-	SEE DWG	-	-	TEMPERATURE TAPPING	
T7	1.5	900	LWN	RF	-	-	SEE DWG	-	-	TEMPERATURE TAPPING	
T8	1.5	900	LWN	RF	-	-	SEE DWG	-	-	TEMPERATURE TAPPING	
M1	24	600	WN	RF	10+3	SELF REINF	SEE DWG	-	-	MANWAY	(37)
M2	24	600	WN	RF	10+3	SELF REINF	SEE DWG	-	-	MANWAY	(37)
M3	24	600	WN	RF	10+3	SELF REINF	SEE DWG	-	-	MANWAY	(37)

29 Temperature tapping T5 to T8 accommodate 4 shellside thermocouples. Typical thermocouple entry details are shown in detail on sheet 6. The machined coupling shall be welded to the perforated tube prior to insertion of the tube into the tubesheet. The upper portion of the coupling shall be left blind until after shellside hydrotest. After shell side hydrotest the upper portion of the coupling shall be drilled out and the assembly completed.
It is imperative that the nozzles T5 to T8 are accurately aligned with the respective perforated tube.

30 DELETE

31 Vendor shall undertake the flexibility analysis of the riser and downcomers piping system. All risers and downcomer support and guides shall be provided. Horizontal legs shall be avoided in the riser pipe.

32 Upset conditions : Equipment supplier to take in to consideration that an upset condition exists whereby the generation in the reactor process side is 128% of Design Rate. Equipment supplier to ensure that the thermal and mechanical integrity of the reactor can be maintained at this upset condition.

33 Reactor designer shall ensure that the vessel is designed for a site hydrotest and that the requirements of the design code are met.

34 Holes in coolant thermocouple tubes shall be smooth (de-burred) to allow insertion of thermocouples.

35 DELETE

36 Tubesheets shall be designed acc. to ASME VIII Div.1 + Finite Elements Analysis

37 With blind flange and davit.

38 Minimum design temperature at pressure:

Shell side: 9°C at 67.0 barg F.V.

Tube side: 9°C at 42.0 barg

39 All carbon steel material shall be supplied as normalized condition.

DESIGN DATA

CALCULAT. CODES	ASME VIII DIV.1 - LAST EDIT. (36)	
ALLOW.STRESSES	ASME VIII DIV.1 - LAST EDIT.	
INSPECTION	SEE MR	
SPECIFICATIONS	SEE MR	
WIND/EARTHQUAKE	SEE MR / SEE MR	
FLUID	SHELL SIDE	TUBE SIDE
DESIGN PRESSURE	67.0 Bars g	42.0 Bars g
DESIGN TEMPERAT.	295 °C	315 °C
TEST PRESSURE	BY MFR Bars g	BY MFR Bars g
EXTERNAL PRESS.	F. V. AT 295°C	(9) Bars g
TUBESHEET PRESS.	- Bars g	
TUBESHEET TEMPER.	315 °C	
TUBESHEET TOT.CORR.	3 + CLAD mm	
FLOAT.HEAD TOT.CORR.	- mm	
WORK. TEMP. (IN)	NOTE 21	NOTE 21
WORK. TEMP. (OUT)	NOTE 21	NOTE 21
FLUID DENSITY	950 Kg/m ³	22.63 (SOR) Kg/m ³
CORROSION	3 mm	3 CLAD mm
JOINT EFFICIENCY	1.0	1.0
NO. OF PASSES	1	1
RADIOGRAPHY	FULL	FULL
STRESS RELIEVING	YES	YES
FLOAT.HEAD STRESS RE	-	
TOTAL VOLUME	126.67 m ³	
HAZARD CONSIDERATION	-	YES-OXYGEN+H/C
FATIGUE DESIGN REQ.D	-	TUBESHEET-NOTE 17

TUBE BUNDLE DATA

NO.TUBES	3600	O.D.	38.1 mm
THK. (MIN.)	12 BWG mm	LENGTH	10400 mm
PITCH	48.1 mm	LAYOUT	◇
SURFACE (net)	BY MFR m ²	JOINT	(SEE NOTE 14)
SECT.IN PAR.	-	SECT.IN SER.	-

LINING & PAINTING DATA

	TYPE		THK. mm		SURF. m ²	
	S.S.	T.S.	S.S.	T.S.	S.S.	T.S.
INT.COATING	-	-	-	-	-	-
INSULATION	H.C.	H.C.	75	75	-	-
EXT.PAINTING	SEE REFERENCE STANDARD					
SURF.PREPAR. INT./EXT.	SEE REFERENCE STANDARD					

TECHNIP-COFLEXIP

سابك
sabicSABIC ACETIC ACID PLANT
IBN RUSHD SITE - YANBU - KINGDOM OF SAUDI ARABIAXXXX
Status
ITEM : 100-R-121
SERVICE : REACTOR

2121	02	DW	0411 - 01	1 of 6	0
Project	Unit	Type of doc.	Code & progressive	Sheet	Rev.

WEIGHTS & LOADING DATA















WEIGHT OF EACH SECTION		TOTAL DRY		255000	Kgf
		FULL OF WATER		395300	Kgf
		ERECT.	TEST	OPERAT.	
WTS	Kgf	255000	395300	367700	
HT.VERT.LOADS	N	—		—	
SHEAR					
LG.WIND/EARTH.	N	/	/	/	
TV.WIND/EARTH.	N	37300 / 328800	7700 /	42000 / 521400	
MOMENT					
LG.WIND/EARTH.	N.m	/	/	/	
TV.WIND/EARTH.	N.m	94800 / 1575300	19500 /	106900 / 2440000	


REVISIONS

REV	DATE	DESCRIPTION	PREP.D	CHKD.	APPD.	AUT.D
0	29-07-02	ISSUED FOR PURCHASE TO HITACHI ZOSEN	De Luca	Merel	Iorio	THI
B	10-06-02	REISSUED FOR INQUIRY	De Luca	Merel	Iorio	THI
A	19-04-02	ISSUED FOR INQUIRY	De Luca	Merel	Iorio	THI

MATERIALS		REFERENCE STANDARDS	
SHELL		Q01-E10	THICK WALLED VESSELS AND HEAT EXCHANGERS - DESIGN CRITERIA
TUBE SUPPORT GRIDS	SA 516 Gr 70	Q01-E13	VESSEL LIFTING LUGS: TRUNNION AND DOUBLE RING TYPE
TUBE AND CATALYST SUPPORTS	AISI 316L STAINLESS SPRING STEEL	Q01-E24	PRESSURE VESSELS: ALLOY CLAD CARBON STEEL - DESIGN CRITERIA
BARREL	SA 516 Gr 70	Q01-F01	PRESSURE VESSELS: WELDING AND FABRICATION
MANIFOLDS AND PIPING	SA 106 B	Q01-F05	VESSELS - SUPPORT LUG FABRICATION
NOZZLE FROM PIPE	SA 106 B	Q01-F07	PRESSURE VESSELS - FABRICATION
NOZZLE FROM PLATE	SA 516 Gr 70	Q01-F08	WELDING OVERLAY AND WELDING OF CLAD MATERIAL
NOZZLES FLANGES	SA 105	Q01-F10	FABRICATION (ALLOY CLAD CARBON STEEL)
PIPE FITTINGS	SA 234 WPB	Q01-F15	VESSELS: NAME PLATE AND STAMPING
NOZZLE REINF.PAD	SA 516 Gr 70	Q01-F20	DAVIT FOR OUTDOOR MANHOLE COVERS
REACTOR SUPPORTS (BRACKETS)	SA 516 Gr 70	Q01-F21	VESSELS: PIPE GUIDE
FORGINGS	SA 266 GR 4	Q01-F22	PRESSURE VESSELS: PIPE SUPPORT
STIFFENING RINGS	-	Q01-F23/VEVF 1123	VESSELS: INSULATION AND FIRE PROOFING SUPPORT
EXPANSION JOINT	-	Q01-F25	VESSELS: GROUNDING AND LUG DETAILS
MANIFOLD STUBS	SA 105 / SA 106 Gr B	Q01-F28	ALLOWABLE FABRICATION TOLERANCES HORIZONTAL AND VERTICAL PRESSURE VESSEL
INT. ATTACHMENTS	SA 516 Gr 70	Q01-F34	CARBON AND LOW ALLOY STEELS FABRICATION - PRESSURE VESSELS
EXT. ATTACHMENTS	SA 516 Gr 70	Q01-F35	THICK WALLED - FABRICATION
SHELL COVER		Q01-F37	AUSTENITIC AND HIGH-ALLOY STEEL PRESSURE VESSEL : FABRICATION
BARREL	-	Q01-T02	INSPECTION REQUIREMENTS FOR PRESSURE VESSELS
COVER	-	Q01-T07	MATERIALS IDENTIFICATION PROGRAM
FLANGES	-	22854-SP-000-X-002	SHOP AND FIELD PAINTING
CHANNEL (11)		SZ5D	RECOMMENDED COATING SYSTEMS FOR EXTERNAL PROTECTION
BARREL	SA 516 Gr 70+3mm AISI 316L	1000.00.ST.0800.01	NAME PLATE
ANNULAR FORGING	SA 266 GR 4 + 3mm AISI 316L W.O.(TUBE SIDE)	Q01-T02	INSPECTION REQUIREMENTS FOR PRESSURE VESSELS
HEADS	SA 516 Gr 70 + 3mm AISI 316L W.O.	Q01-T02	INSPECTION REQUIREMENTS FOR PRESSURE VESSELS
FLAT COVER	-	Q01-T02	INSPECTION REQUIREMENTS FOR PRESSURE VESSELS
NOZZLES FLANGES	SA 105 + AISI 316L W.O. (26)	Q01-T02	INSPECTION REQUIREMENTS FOR PRESSURE VESSELS
NOZZLE FROM PLATE	SA 516 Gr 70 + 3mm AISI 316L	SG1-12S	DELETED
MANIFOLDS AND PIPING	SA 312 TP 316L		
COUPLINGS & PLUGS	SA 403 WP 316L		
FORGING	SA 266 GR 4 + 3mm AISI 316L W.O.		
SEPARATION PLATES	-		
INT. ATTACHMENTS	SA 240 316L		
EXT. ATTACHMENTS	SA 516 Gr 70		
FLOATING HEAD			
COVER	-		
FLANGES	-		
SPLIT RING	-		
TUBE BUNDLE			
TUBES	SA 789 UNS S31803 (SMLS) (SAF 2205)		
TUBESHEETS	SA 516 Gr 70 + AISI 316L W.O. (TUBE SIDE)		
BRAZING FLEES/SUPPORTS/IMP.PLATE	SA 516 Gr 70		
TIE RODS & SPACERS	C.S.		
BOLTS & NUTS			
EXT. BOLTS	SA 193 B7 / SA 194 2H		
INT. BOLTING	AISI 316L		
GASKETS			
BLIND COVER MANHOLE	AISI 316L SP. WOUND FIBRE FILLED+AISI 316 INNER RING AND C.S. CENTERING RING		
NOTES			
FLANGE FINISHING	SEE NOTE 6		
TREATMENTS			
RADIOGRAPHY	FULL		
STRESS RELIEVING	YES		
DIMENSIONS			
PIPES	ASME B36.10M/B36.19M		
FLANGES	ANSI B16.5		
FITTINGS	ANSI B16.9		
THREADS	ANSI B1.1 CLASS 2A OR 2B		
GASKETS	API 601		

TECHNIP-COFLEXIP		سابك SABIC	
SABIC ACETIC ACID PLANT IBN RUSHD SITE - YANBU - KINGDOM OF SAUDI ARABIA			
XXXX Status	ITEM : 100-R121 SERVICE : REACTOR		
CAD model			
/	2121	02	DW
Scale	Project	Unit	Type of doc.
	0411 - 01	2 of 6	0
	Code & progressive	Sheet	Rev.

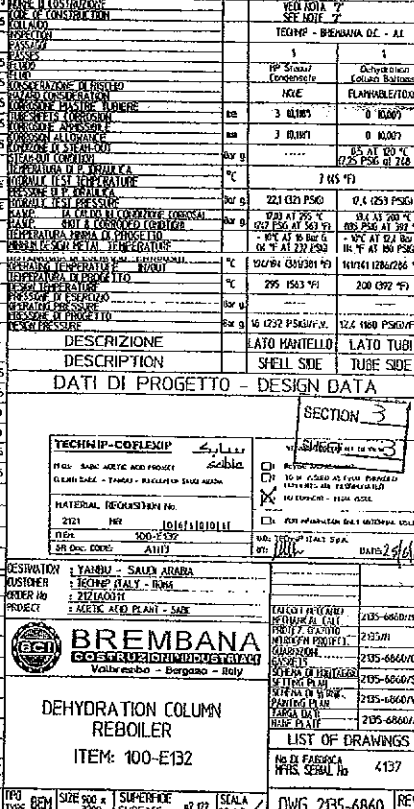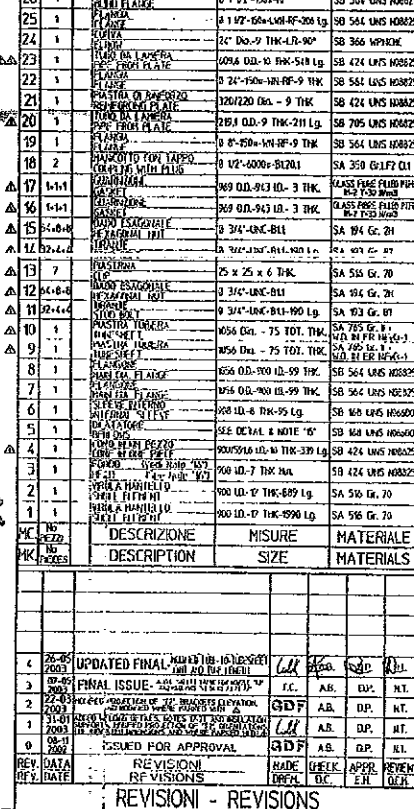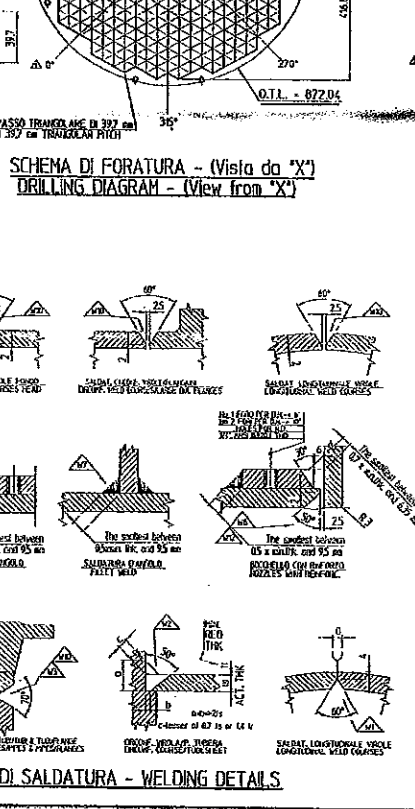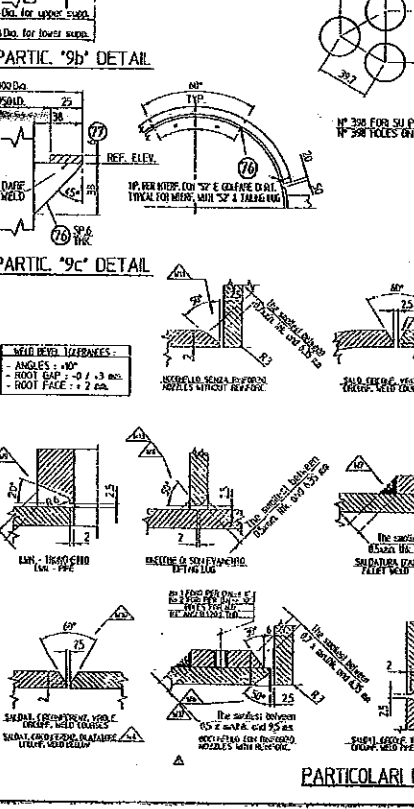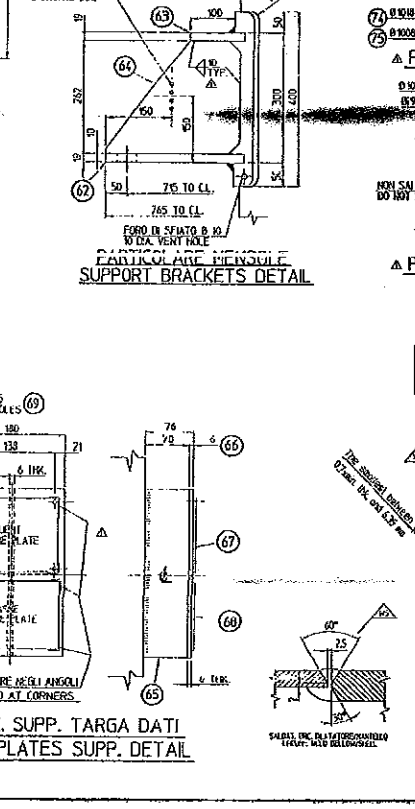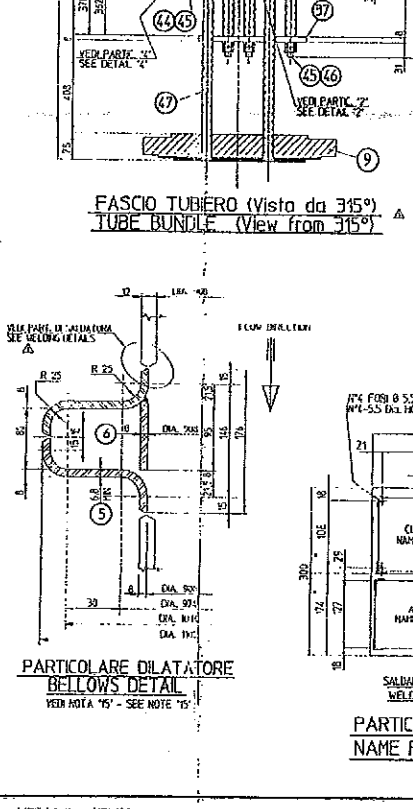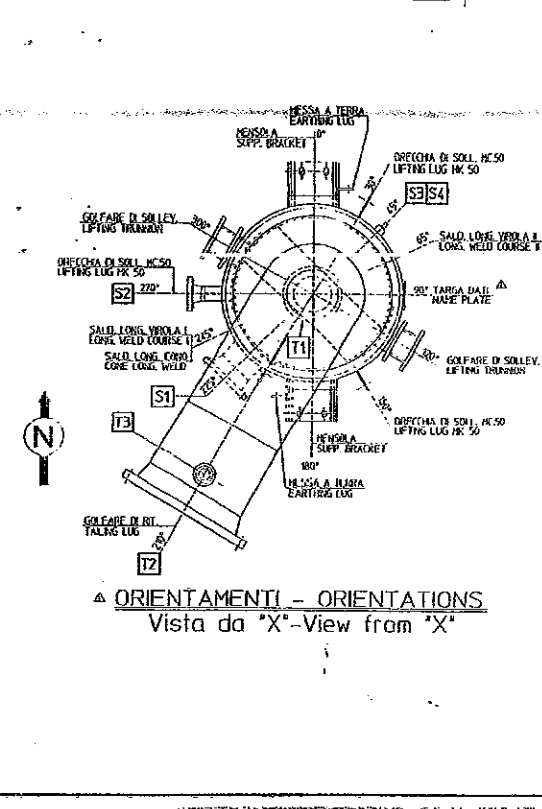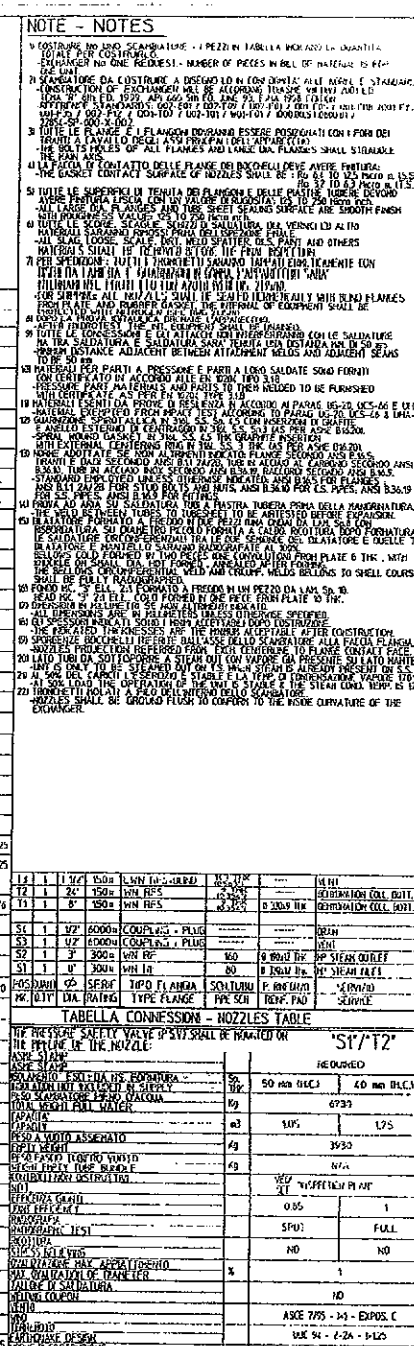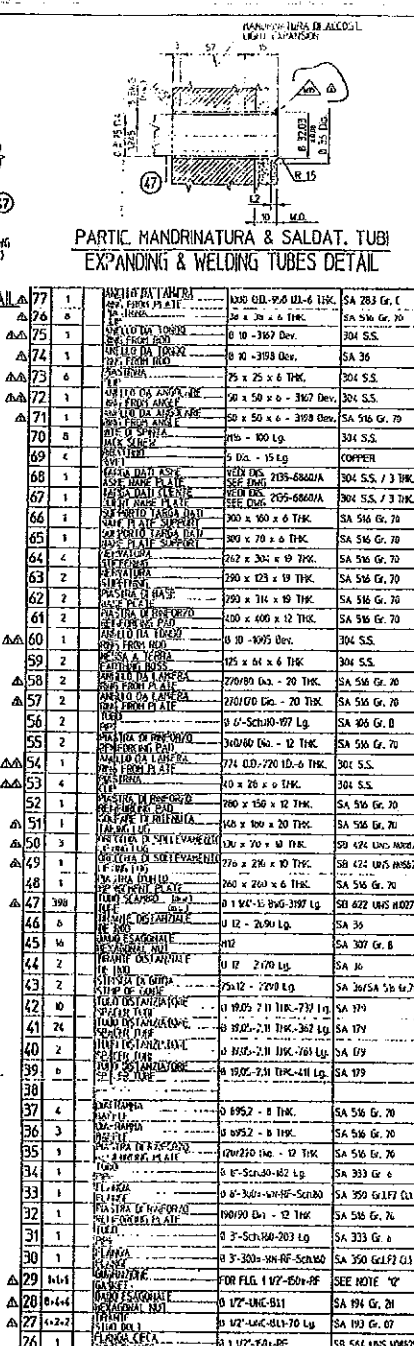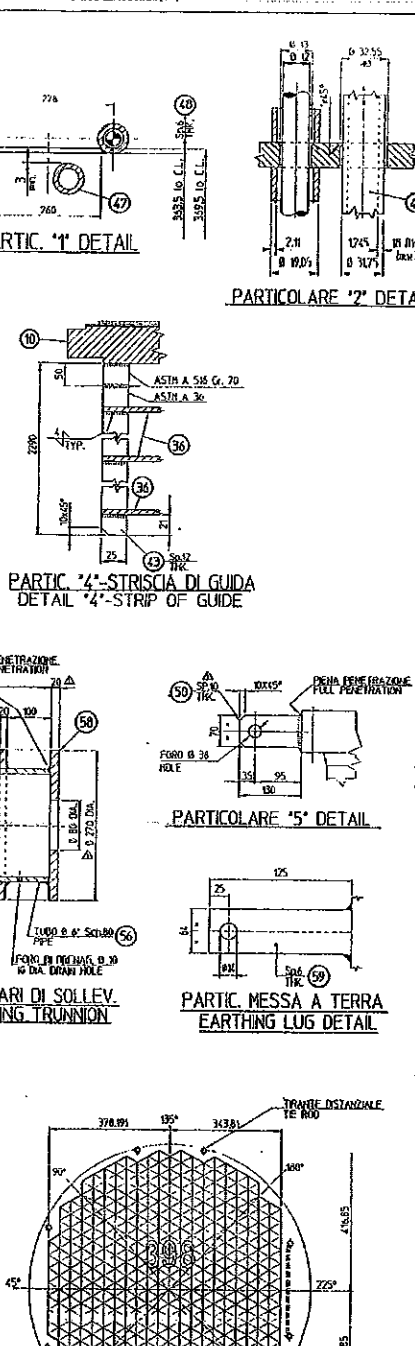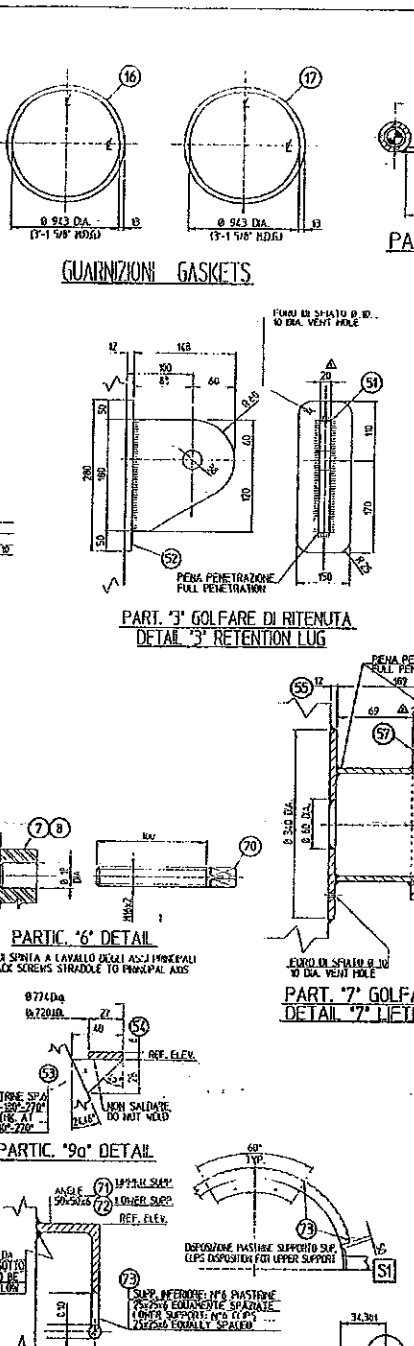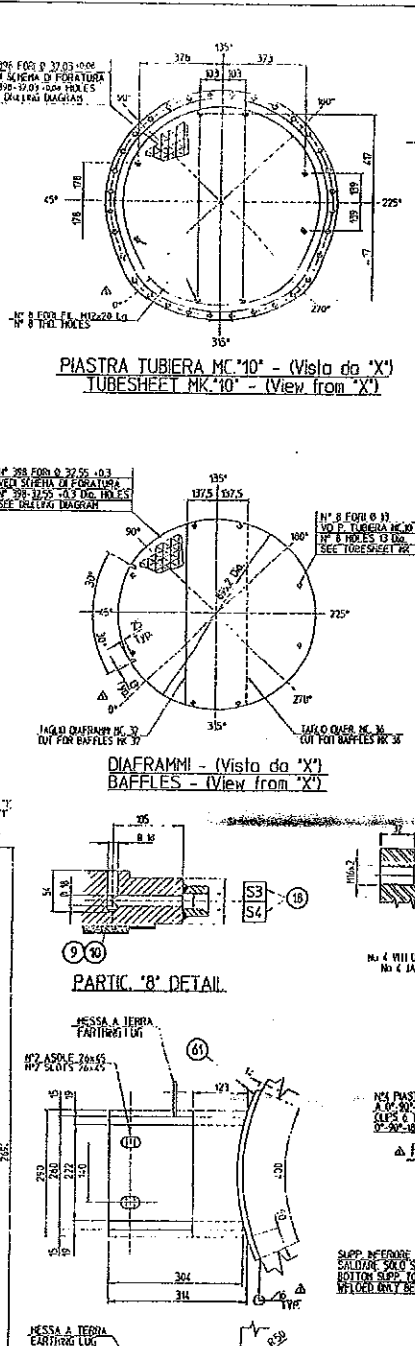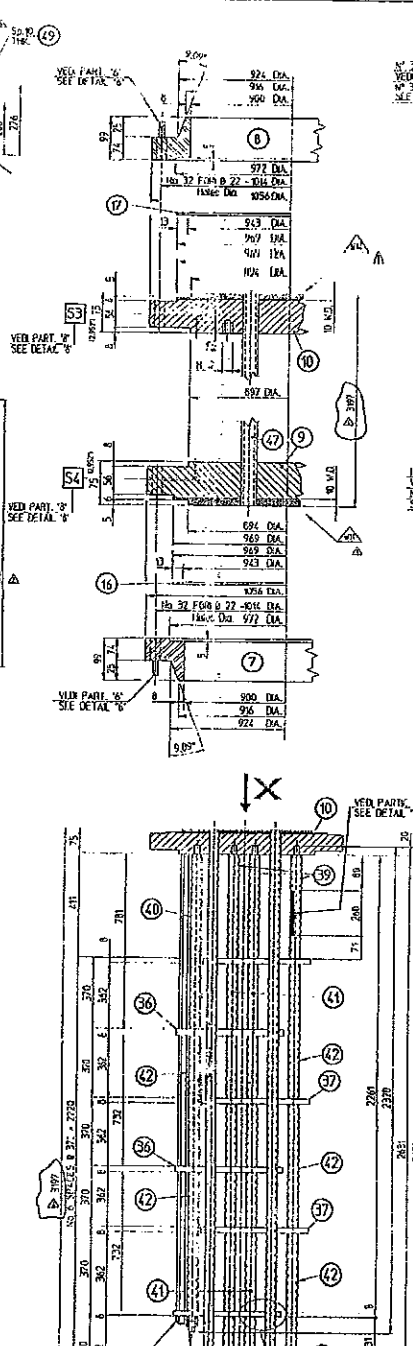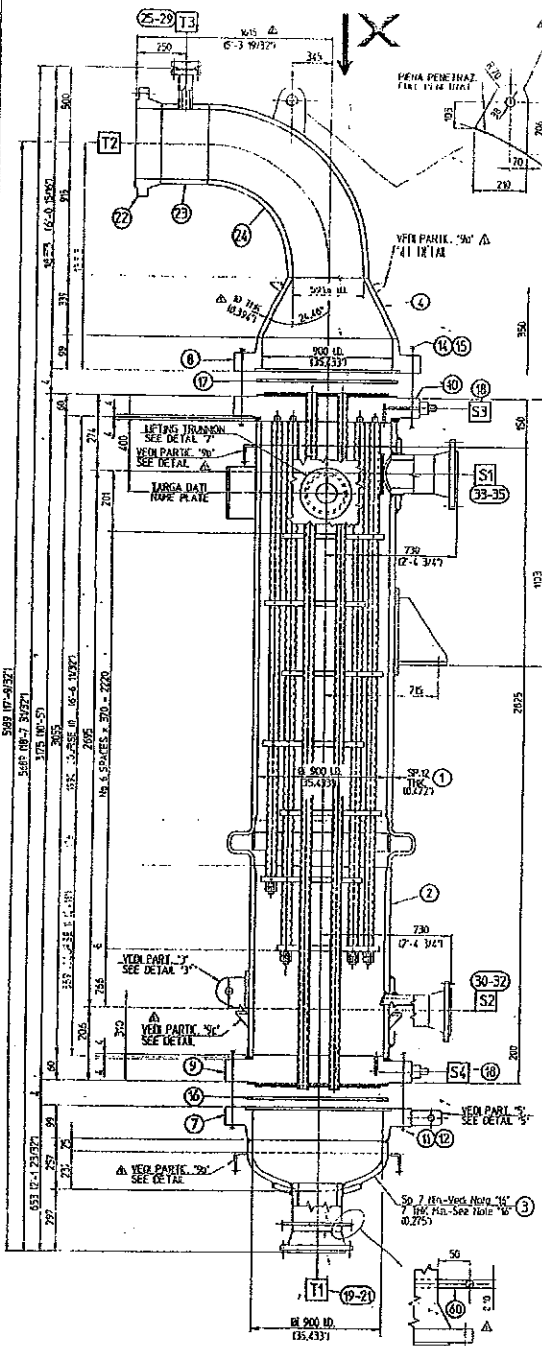



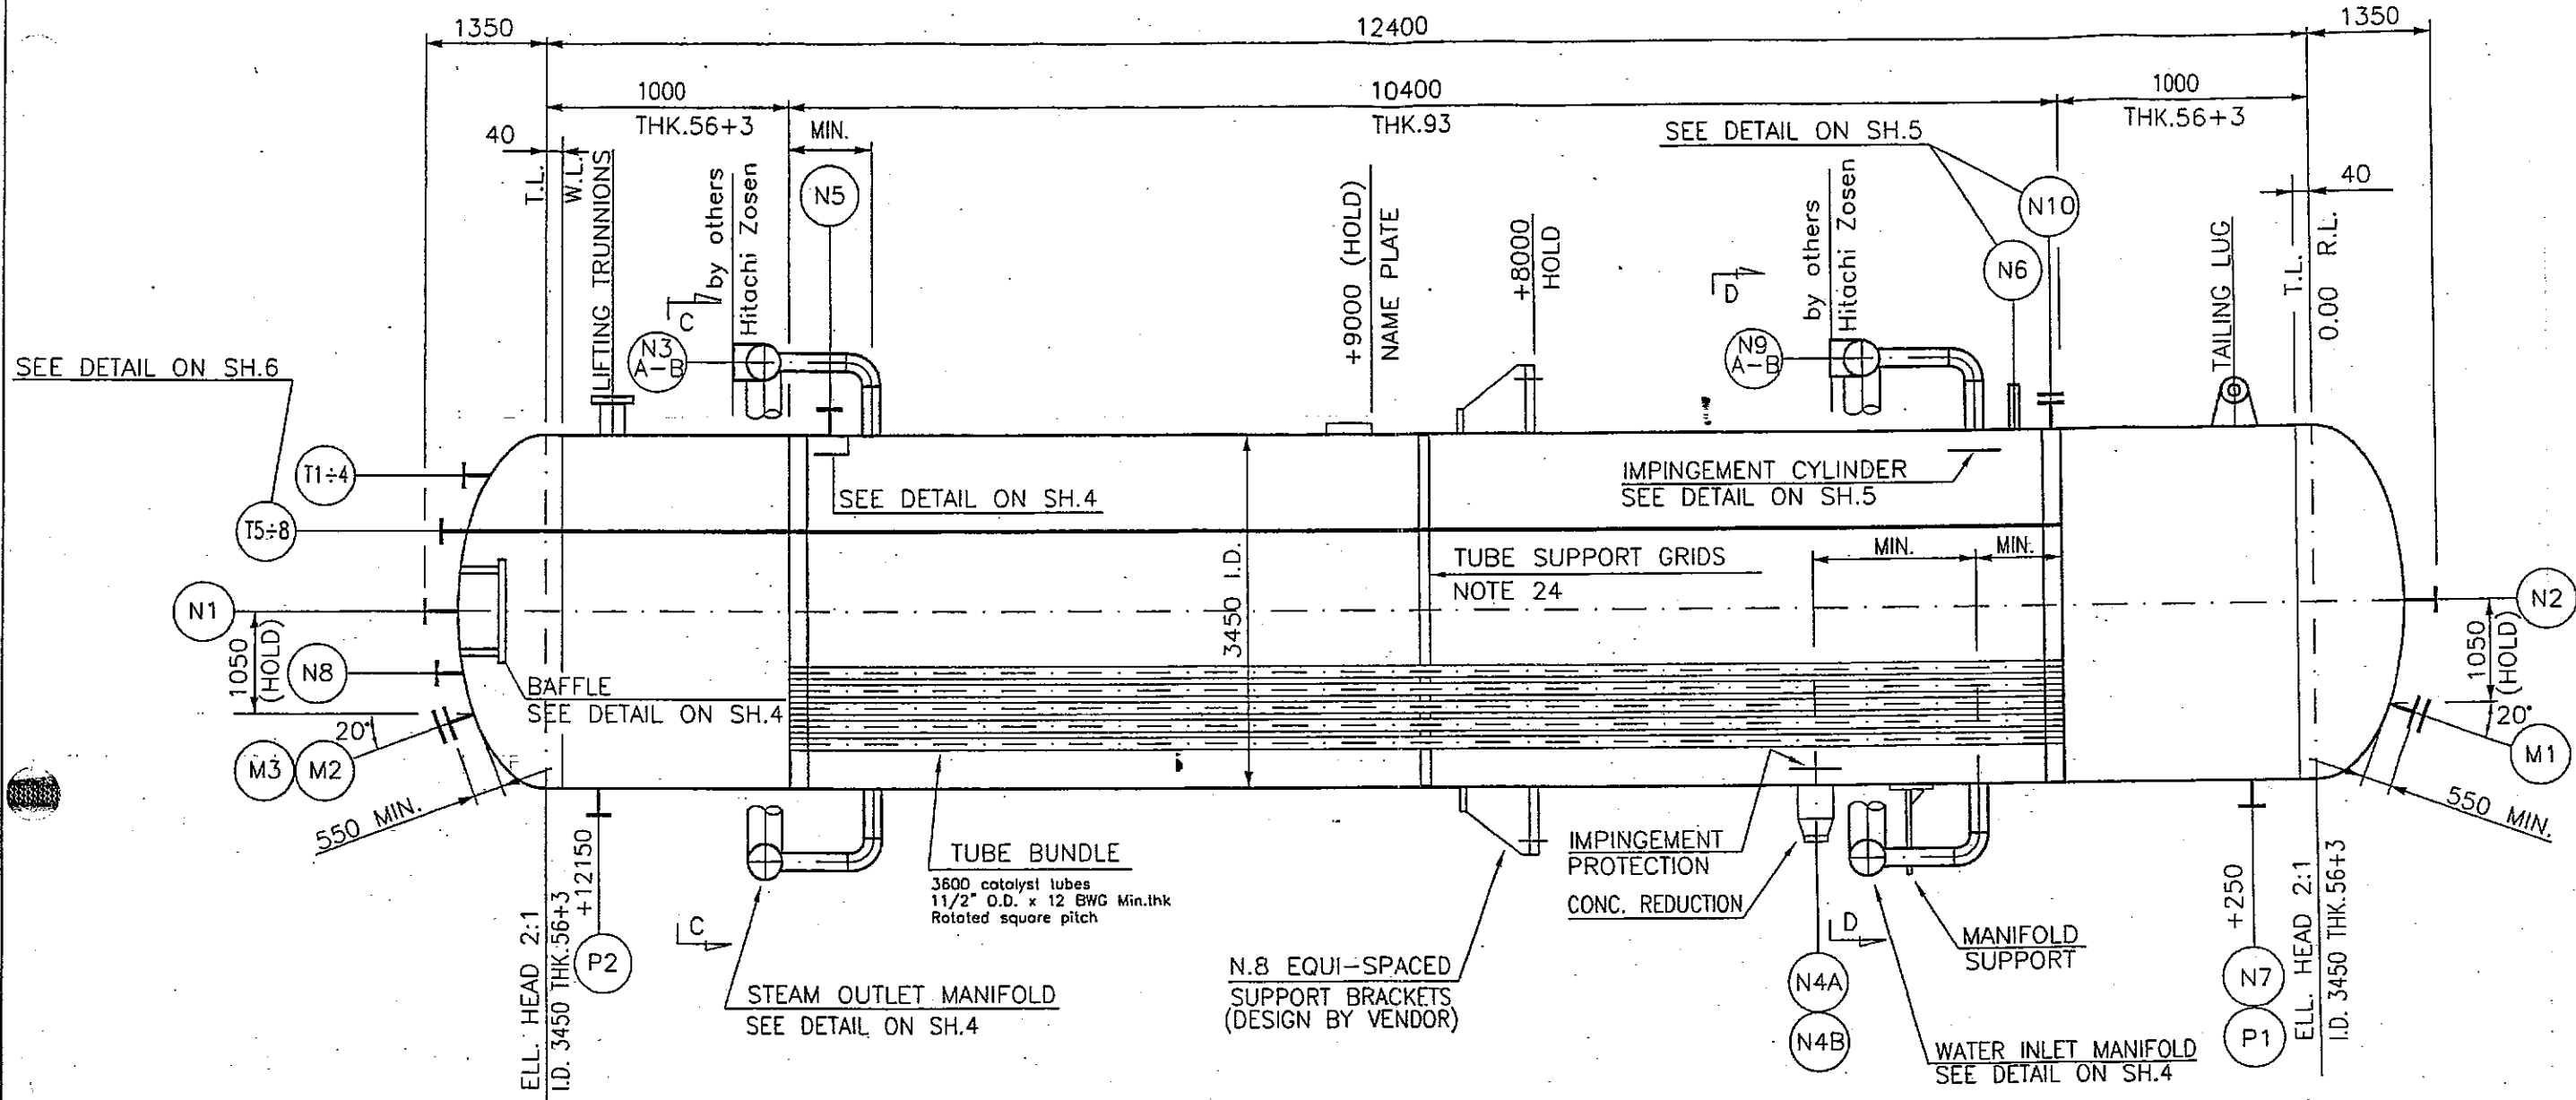


ORIENTATION TO BE DEFINED LATER

سابک
sabic

SABIC ACETIC ACID PLANT
IBN RUSHD SITE - YANBU - KINGDOM OF SAUDI ARABIA



XXXX Status	ITEM : 100-R121					
-	SERVICE : REACTOR					
CAD model						
/	2121	02	DW	0411 - 01	3 of 6	0
Scale	Project	Unit	Type of doc.	Code & progressive	Sheet	Rev.

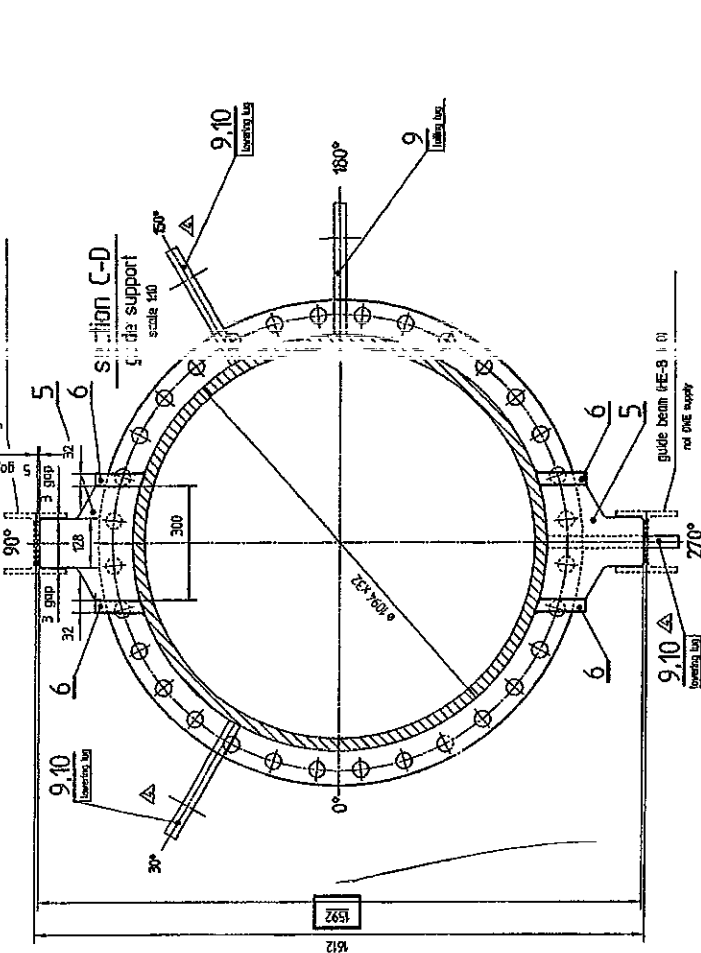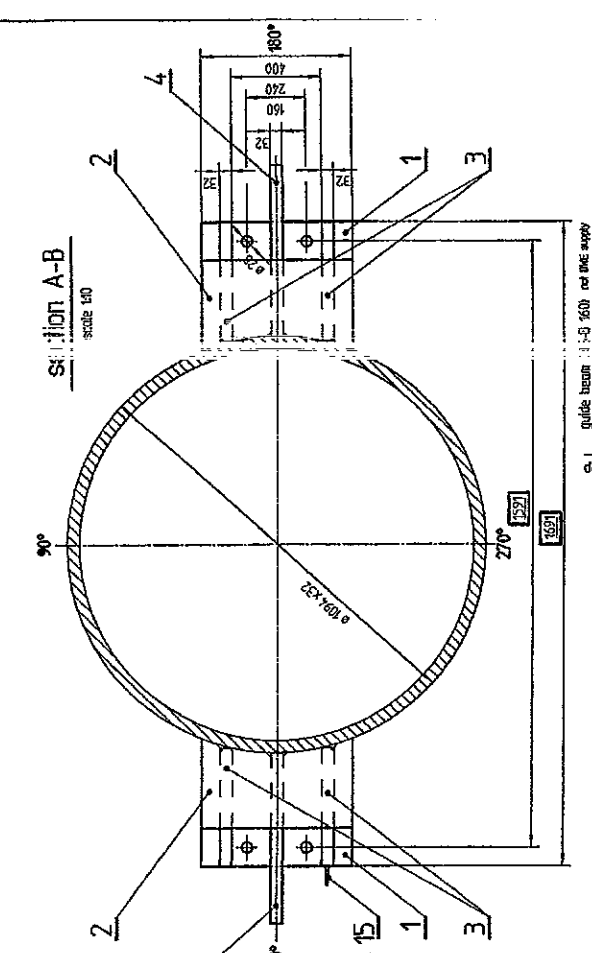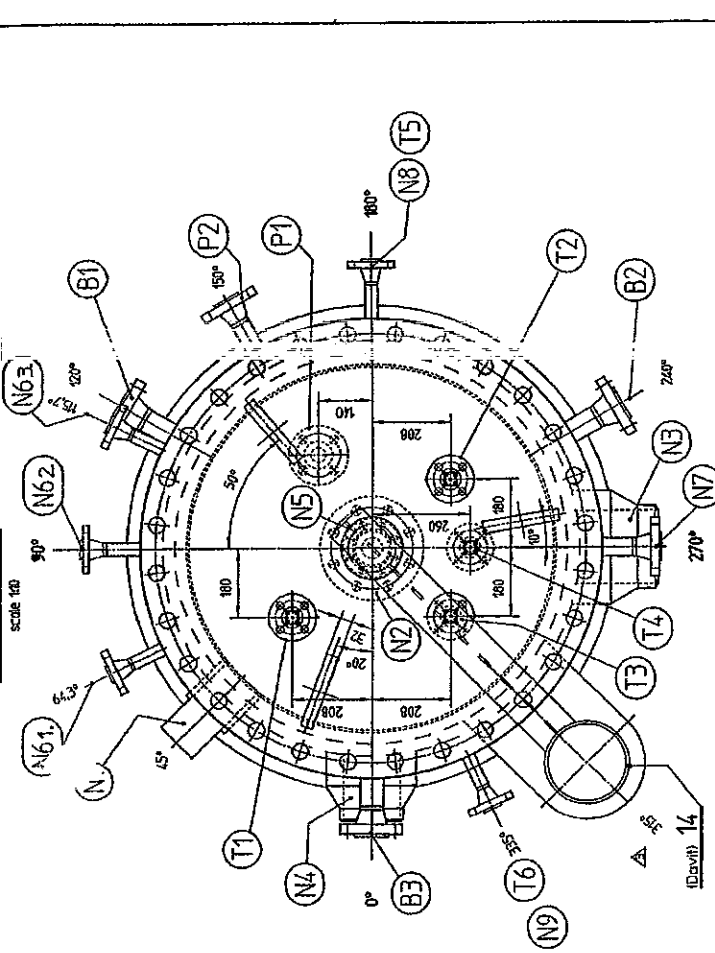[illegible]



STUTZENTABELLE				NOZZLE DATA			
Mark	No.	Size	Rating	Code	Rating	Design	Remarks
1	2	3	4	5	6	7	8
BERECHNUNGSDATEN							
Berechnungszone				ASME SEC. VII DIV. 1			
Code for installation:				EDITION 01, APPENDIX —			
1. Height				2. Shell			
3. Nozzle				4. Flange			
5. Bolt				6. Nut			
7. Washer				8. Gasket			
9. Sealant				10. Lubricant			
11. Paint				12. Coating			
13. Insulation				14. Protection			
15. Support				16. Foundation			
17. Anchorage				18. Bracing			
19. Vibration				20. Seismic			
21. Corrosion				22. Erosion			
23. Fatigue				24. Creep			
25. Stress				26. Strain			
27. Deflection				28. Settlement			
29. Buckling				30. Torsion			
31. Tension				32. Compression			
33. Shear				34. Bending			
35. Twisting				36. Pulling			
37. Pushing				38. Lifting			
39. Lowering				40. Hoisting			
41. Moving				42. Stopping			
43. Holding				44. Releasing			
45. Locking				46. Unlocking			
47. Opening				48. Closing			
49. Turning				50. Rotating			
51. Tilting				52. Leveling			
53. Aligning				54. Squaring			
55. Flattening				56. Rounding			
57. Smoothing				58. Polishing			
59. Buffing				60. Grinding			
61. Drilling				62. Boring			
63. Tapping				64. Reaming			
65. Milling				66. Turning			
67. Boring				68. Grinding			
69. Polishing				70. Buffing			
71. Grinding				72. Drilling			
73. Boring				74. Reaming			
75. Milling				76. Turning			
77. Boring				78. Grinding			
79. Polishing				80. Buffing			
81. Grinding				82. Drilling			
83. Boring				84. Reaming			
85. Milling				86. Turning			
87. Boring				88. Grinding			
89. Polishing				90. Buffing			
91. Grinding				92. Drilling			
93. Boring				94. Reaming			
95. Milling				96. Turning			
97. Boring				98. Grinding			
99. Polishing				100. Buffing			
101. Grinding				102. Drilling			
103. Boring				104. Reaming			
105. Milling				106. Turning			
107. Boring				108. Grinding			
109. Polishing				110. Buffing			
111. Grinding				112. Drilling			
113. Boring				114. Reaming			
115. Milling				116. Turning			
117. Boring				118. Grinding			
119. Polishing				120. Buffing			
121. Grinding				122. Drilling			
123. Boring				124. Reaming			
125. Milling				126. Turning			
127. Boring				128. Grinding			
129. Polishing				130. Buffing			
131. Grinding				132. Drilling			
133. Boring				134. Reaming			
135. Milling				136. Turning			
137. Boring				138. Grinding			
139. Polishing				140. Buffing			
141. Grinding				142. Drilling			
143. Boring				144. Reaming			
145. Milling				146. Turning			
147. Boring				148. Grinding			
149. Polishing				150. Buffing			
151. Grinding				152. Drilling			
153. Boring				154. Reaming			
155. Milling				156. Turning			
157. Boring				158. Grinding			
159. Polishing				160. Buffing			
161. Grinding				162. Drilling			
163. Boring				164. Reaming			
165. Milling				166. Turning			
167. Boring				168. Grinding			
169. Polishing				170. Buffing			
171. Grinding				172. Drilling			
173. Boring				174. Reaming			
175. Milling				176. Turning			
177. Boring				178. Grinding			
179. Polishing				180. Buffing			
181. Grinding				182. Drilling			
183. Boring				184. Reaming			
185. Milling				186. Turning			
187. Boring				188. Grinding			
189. Polishing				190. Buffing			
191. Grinding				192. Drilling			
193. Boring				194. Reaming			
195. Milling				196. Turning			
197. Boring				198. Grinding			
199. Polishing				200. Buffing			
201. Grinding				202. Drilling			
203. Boring				204. Reaming			
205. Milling				206. Turning			
207. Boring				208. Grinding			
209. Polishing				210. Buffing			
211. Grinding				212. Drilling			
213. Boring				214. Reaming			

STUTZENTABELLE				NOZZLE DATA			
Mark	No.	Size	Rating	Code	Rating	Design	Remarks
1	2	3	4	5	6	7	8
BERECHNUNGSDATEN							
Berechnungszone				ASME SEC. VII DIV. 1			
Code for installation:				EDITION 01, APPENDIX —			
1. Height				2. Shell			
3. Nozzle				4. Flange			
5. Bolt				6. Nut			
7. Washer				8. Gasket			
9. Sealant				10. Lubricant			
11. Paint				12. Coating			
13. Insulation				14. Protection			
15. Support				16. Foundation			
17. Anchorage				18. Bracing			
19. Vibration				20. Seismic			
21. Corrosion				22. Erosion			
23. Fatigue				24. Creep			
25. Stress				26. Strain			
27. Deflection				28. Settlement			
29. Buckling				30. Torsion			
31. Tension				32. Compression			
33. Shear				34. Bending			
35. Twisting				36. Pulling			
37. Pushing				38. Lifting			
39. Lowering				40. Hoisting			
41. Moving				42. Stopping			
43. Holding				44. Releasing			
45. Locking				46. Unlocking			
47. Opening				48. Closing			
49. Turning				50. Rotating			
51. Tilting				52. Leveling			
53. Aligning				54. Squaring			
55. Flattening				56. Rounding			
57. Smoothing				58. Polishing			
59. Buffing				60. Grinding			
61. Drilling				62. Boring			
63. Tapping				64. Reaming			
65. Milling				66. Turning			
67. Boring				68. Grinding			
69. Polishing				70. Buffing			
71. Grinding				72. Drilling			
73. Boring				74. Reaming			
75. Milling				76. Turning			
77. Boring				78. Grinding			
79. Polishing				80. Buffing			
81. Grinding				82. Drilling			
83. Boring				84. Reaming			
85. Milling				86. Turning			
87. Boring				88. Grinding			
89. Polishing				90. Buffing			
91. Grinding				92. Drilling			
93. Boring				94. Reaming			
95. Milling				96. Turning			
97. Boring				98. Grinding			
99. Polishing				100. Buffing			
101. Grinding				102. Drilling			
103. Boring				104. Reaming			
105. Milling				106. Turning			
107. Boring				108. Grinding			
109. Polishing				110. Buffing			
111. Grinding				112. Drilling			
113. Boring				114. Reaming			
115. Milling				116. Turning			
117. Boring				118. Grinding			
119. Polishing				120. Buffing			
121. Grinding				122. Drilling			
123. Boring				124. Reaming			
125. Milling				126. Turning			
127. Boring				128. Grinding			
129. Polishing				130. Buffing			
131. Grinding				132. Drilling			
133. Boring				134. Reaming			
135. Milling				136. Turning			
137. Boring				138. Grinding			
139. Polishing				140. Buffing			
141. Grinding				142. Drilling			
143. Boring				144. Reaming			
145. Milling				146. Turning			
147. Boring				148. Grinding			
149. Polishing				150. Buffing			
151. Grinding				152. Drilling			
153. Boring				154. Reaming			
155. Milling				156. Turning			
157. Boring				158. Grinding			
159. Polishing				160. Buffing			
161. Grinding				162. Drilling			
163. Boring				164. Reaming			
165. Milling				166. Turning			
167. Boring				168. Grinding			
169. Polishing				170. Buffing			
171. Grinding				172. Drilling			
173. Boring				174. Reaming			
175. Milling				176. Turning			
177. Boring				178. Grinding			
179. Polishing				180. Buffing			
181. Grinding				182. Drilling			
183. Boring				184. Reaming			
185. Milling				186. Turning			
187. Boring				188. Grinding			
189. Polishing				190. Buffing			
191. Grinding				192. Drilling			
193. Boring				194. Reaming			
195. Milling				196. Turning			
197. Boring				198. Grinding			
199. Polishing				200. Buffing			
201. Grinding				202. Drilling			
203. Boring				204. Reaming			
205. Milling				206. Turning			
207. Boring				208. Grinding			
209. Polishing				210. Buffing			
211. Grinding				212. Drilling			
213. Boring				214. Reaming			

THESE DOCUMENTS ARE THE PROPERTY OF TECHNIP COFLEXIP. ANY REPRODUCTION OR TRANSMISSION WITHOUT THE WRITTEN PERMISSION OF TECHNIP COFLEXIP IS PROHIBITED. WHO WILL SUREGUARD ITS RIGHTS ACCORDING TO THE CIVIL AND PENAL PROVISIONS OF THE LAW.

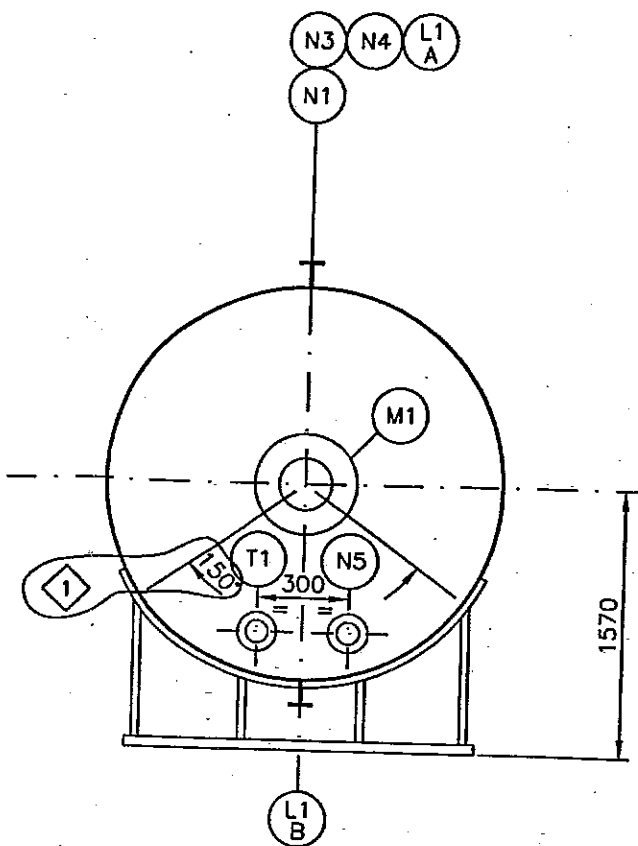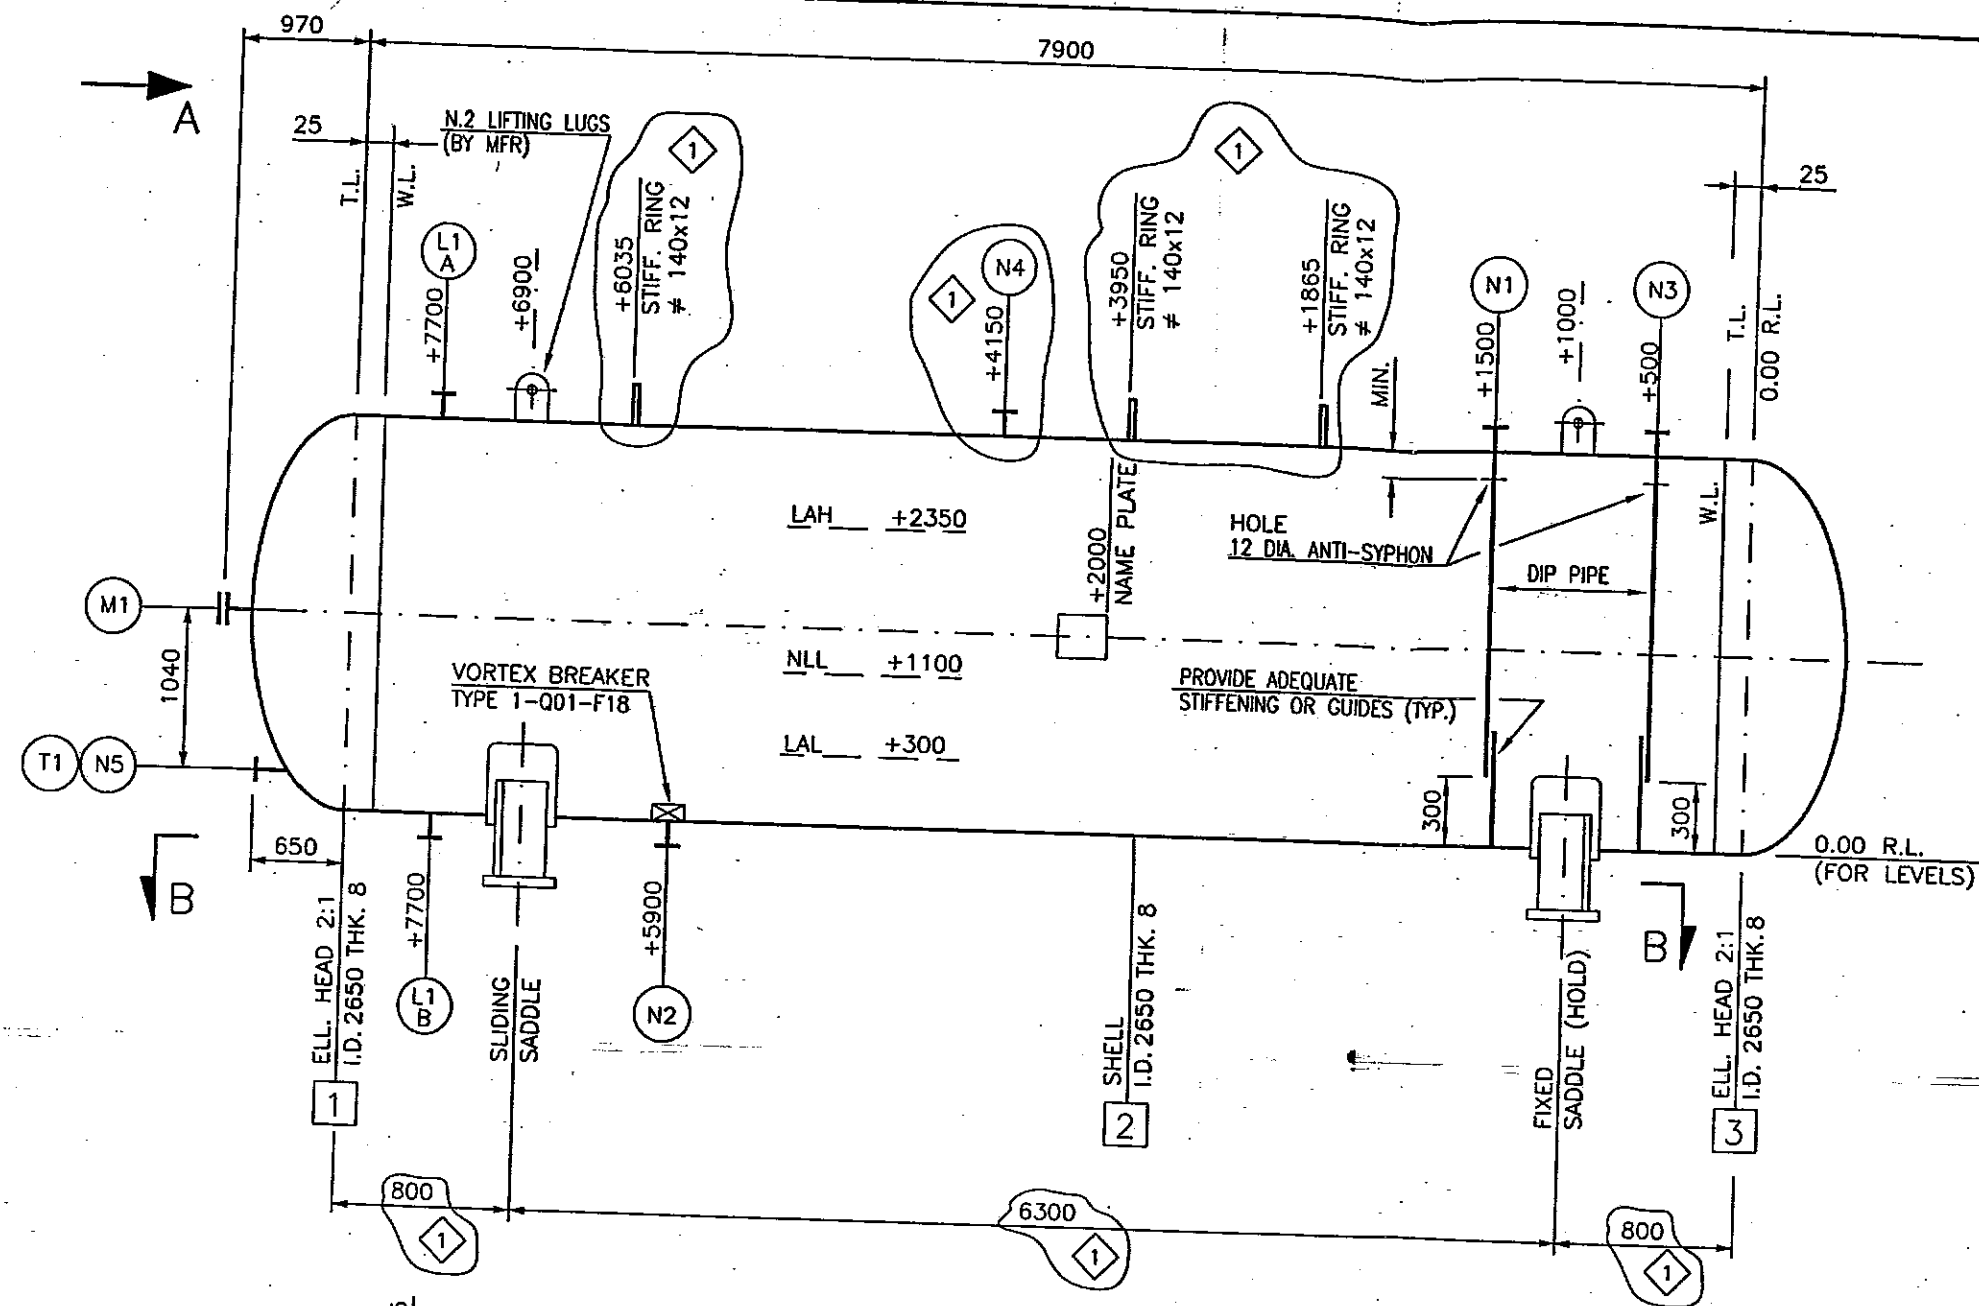

VIEW A
ORIENTATION HOLD

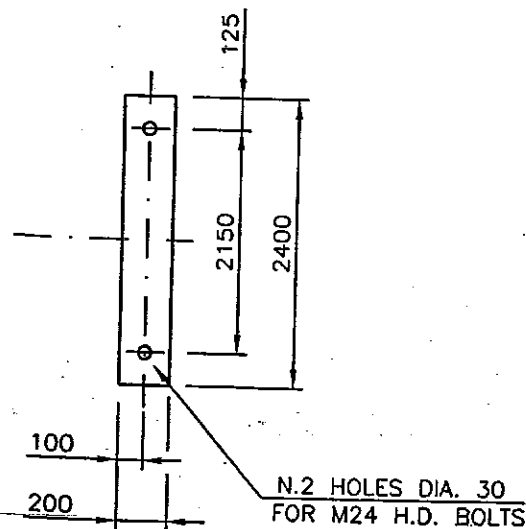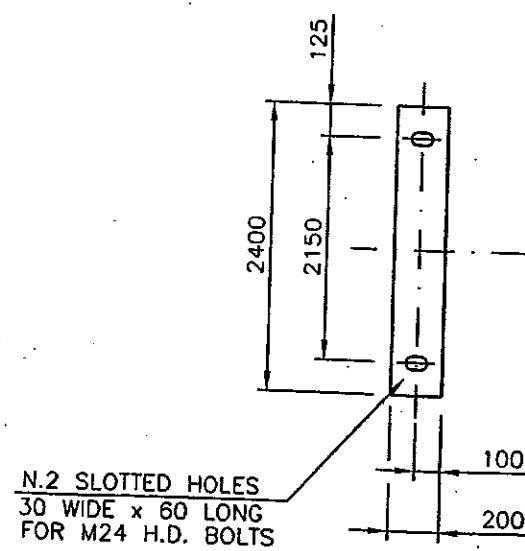


VIEW "B-B"
SUPPORT BASES



TECHNIP-COFLEXIP

سابك
sabik




SABIC ACETIC ACID PLANT
IBN RUSHD SITE - YANBU - KINGDOM OF SAUDI ARABIA

XXXX Status	ITEM : 100-D252
CAD model	SERVICE : ENTRAINER HOLDING DRUM
/	2121 05 DW 0811 - 02 2 of 2 1
Scale	Project Unit Type of doc. Code & progressive Sheet Rev.

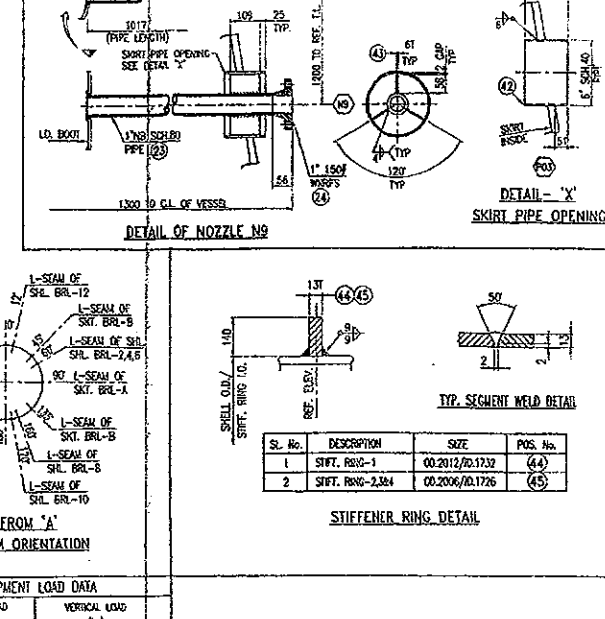[illegible][illegible]

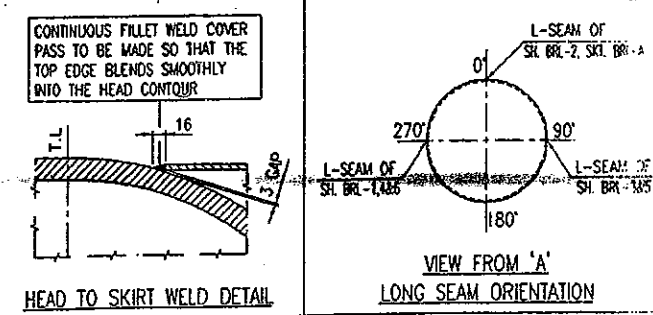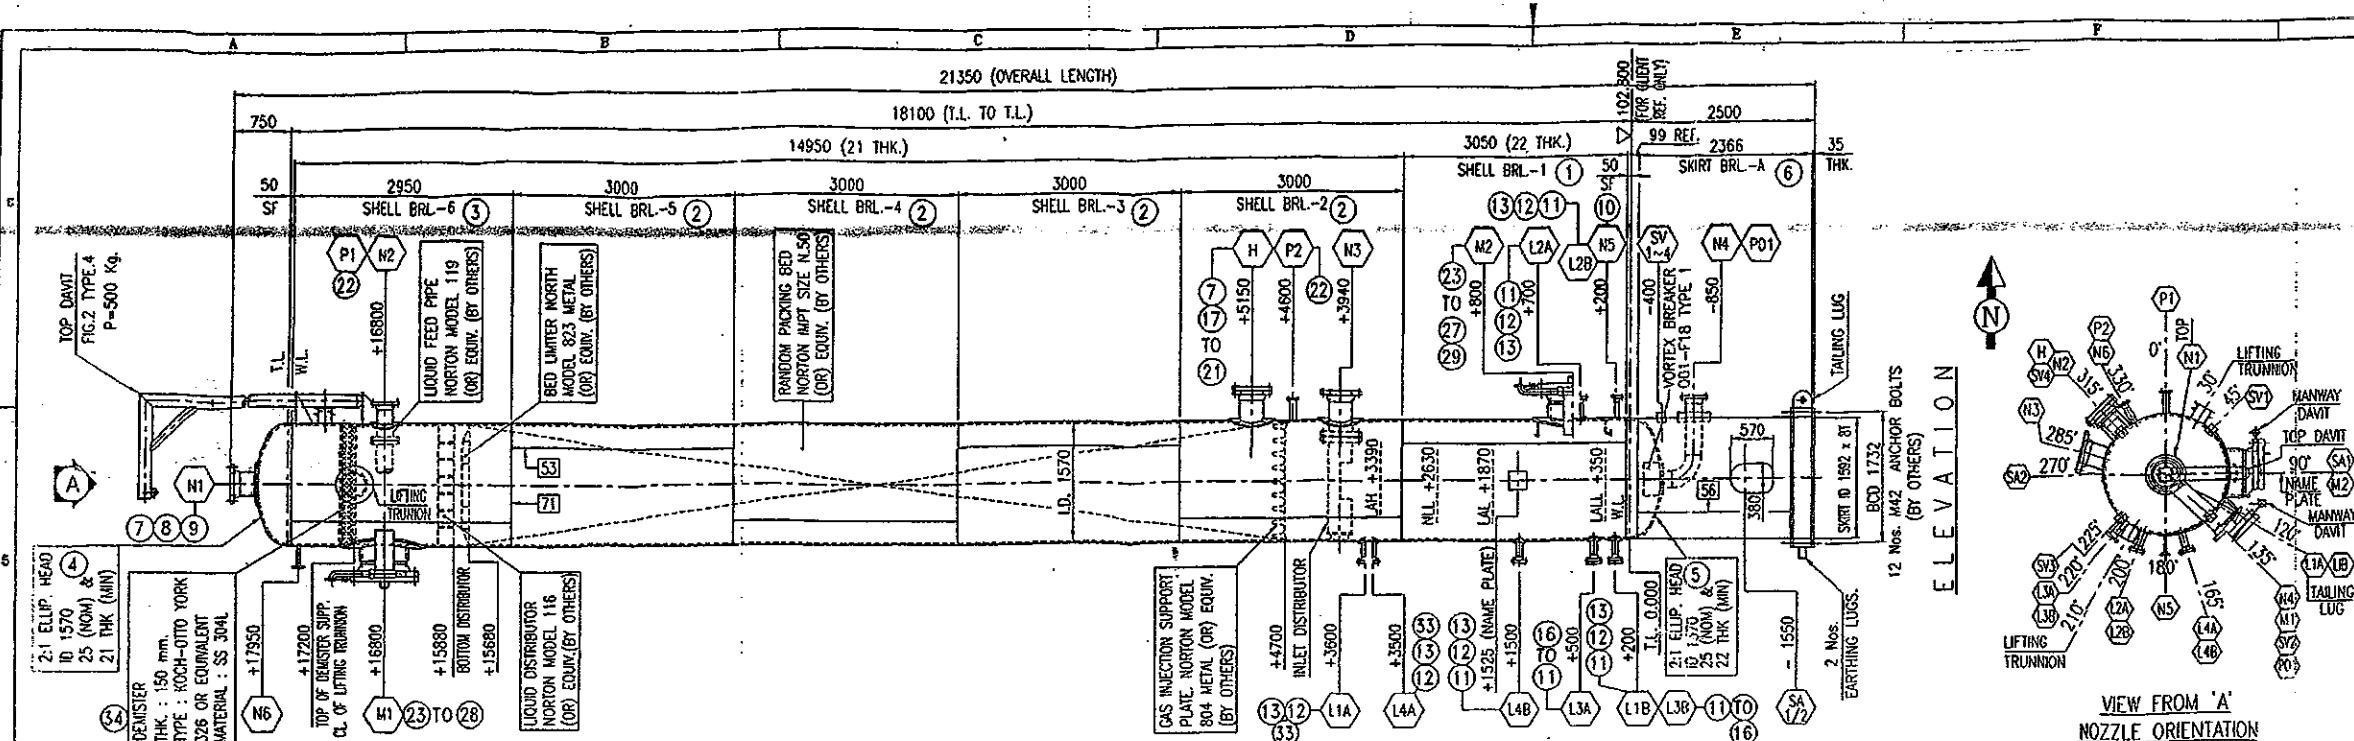

BELLELI REFERENCE DRAWINGS	
DA-7391-04-002	DETAIL DRAWING
DA-7391-04-003	FORMED HEAD (TOP)
DA-7391-04-004	FORMED HEAD (BOTL)
DA-7391-04-005	CLIENT NAME PLATE
DA-7391-04-006	ASME NAME PLATE
DA-7391-04-007	CLIPS FOR PLTF. & LADDERS
DA-7391-04-008	CLIPS FOR PIPE SUPP./GUIDES & INSULATION
DA-7391-04-009	DEMISTER SUPPORT DETAILS
DA-7391-04-010	INTERNAL ATTACHMENTS
DA-7391-04-001	GEN. ASSY. FOR PLATFORM & LADDERS
DS-7391-04-001	PLATFORM & HANDRAIL DETAILS
DS-7391-04-002	LADDERS & SAFETY GUARD DETAIL
DA-7391-00-002	MANWAY DAVIT DETAIL
DA-7391-00-007	SKIRT ACCESS OPENING COVER
DA-7391-00-005	TOP DAVIT
DA-7391-00-009	HAND HOLE HINGE 12"-300#
DO-7391-04-001	SHIPPING ARRANGEMENT
ST-7391-04-001	FINISH REQUIREMENTS
GT-7391-04-001	TEMPLATE

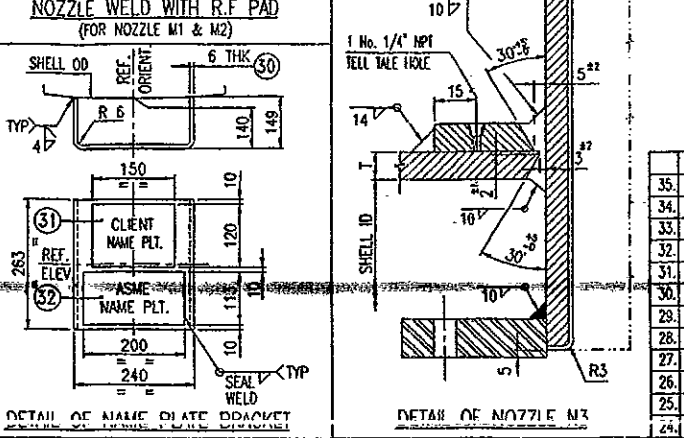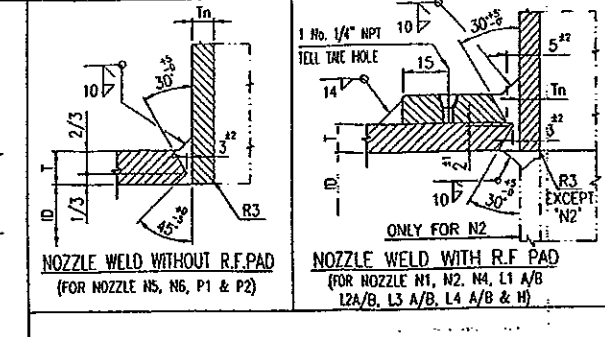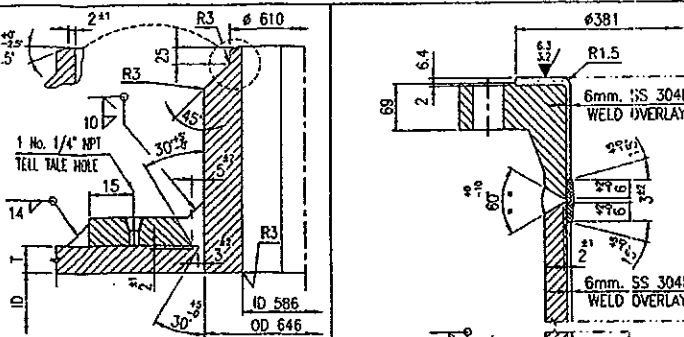

CONDITION	LOAD	VERTICAL LOAD (kg)
EMPTY (ERECTION)		21800
OPERATING		43950
HYDROTEST		65300

DRAWING No.	DESCRIPTION	MARK	QTY	SIZE	PROJ. FROM CL.	SERVICE
G01-G01	SHIP PREPARATION OF EQUIPMENT FOR SHIPMENT					
C01-T06	PRESSURE VESSEL MATERIAL CONTROL PROGRAM					
10000101000001	NAME PLATE					
SZSD	RECOMMENDED COATING SYS. FOR EXL. PROTECTION					
2004-S-001-1-001	SHOP AND FIELD PAINTING					
W12-F04	WELD BEAD AND STRESS RELIEF OF WELD					
W01-F01	WELDING AND INSPECTION					
Q01-T72	COLUMN TRAYS AND MEDIA - TESTING AND INSPECTION					
Q01-T07	MATERIALS IDENTIFICATION PROGRAM					
Q01-T02	INSPECTION REQUIREMENTS FOR PRESSURE VESSELS					
Q01-F72	COLUMN, TRAYS & INTERNAL FABRICATION					
Q01-F34	CARBON & LOW ALLOY STEELS FABRICATION - PRESSURE VESSELS					
Q01-F31	DEMISTER PAD ASSEMBLY AND DETAILS					
Q01-F20	DAVIT FOR OUTDOOR MANHOLE COVERS					
Q01-F19	COLUMN DAVIT FABRICATION DETAIL					
Q01-F17	GRAB RINGS AND STEPS FOR MANWAYS					
Q01-F02	COLUMN FABRICATION					
Q01-F01	PRESSURE VESSELS - WELDING AND FABRICATION					
Q01-E02	PRESSURE VESSELS: CARBON AND LOW ALLOY - STEELS-DESIGN CRITERIA					
Q01-F28	ALLOWABLE FABRICATION TOLERANCES					
Q01-F25	VESSEL LUG MANUFACTURE & GROUNDING DETAIL					
Q01-F23/REV1123	VESSEL INSULATION AND FIRE PROTECTIVE SUPPORT					
Q01-F22	PRESSURE VESSEL PIPE SUPPORT					
Q01-F21	VESEL PIPE GUIDE					
Q01-F18	VORTEX BREAKER					
Q01-F15	VESSEL NAME PLATE AND STAMPING					
Q01-E13	VESSEL LIFTING LUGS, TRUNNION & DOLE RING TYPE					
Q01-F12	SKIRT-TYPE SUPPORTS, VERTICAL VESSELS					
Q01-T01	TESTING & INSPECTION PRESSURE VESSELS					
Q01-E01	PRESSURE VESSELS - GENERAL					
Q01-F07	PRESSURE VESSELS - FABRICATION					
Q01-E12	COLUMN-DESIGN CRITERIA					
2121A/0001-01	DATA SHEET					

No.	HAZARD CONSIDERATIONS	FLAMMABLE/TOXIC
35		
34		
33		
32	FULL OF WATER WEIGHT (SHOP)	kg (lb) 57850 (127559)
31		
30	FABRICATED WEIGHT	kg (lb) 21800 (48069)
29	MANUFACTURER'S SERIAL No.	3217
28	JOB NUMBER	7391-04
27	MANUFACTURER'S NAME	BELLELI S.H.I. LTD.
26	CODE STAMP	YES 'U' STAMP
25	DESIGN CODE	ASME SECTION VIII DIV.1 2001 EDITION
24	SERVICE	CO2 ABSORBER
23	VOLUME	m³ (ft³) 36.05 (1273)
22	FIREPROOFING	NO
21	INSULATION (BY OTHERS)	90 (HC) NOTE-27
20	LIQUID SPECIFIC GRANTY	1.256-1.258
19	INSPECTION AUTHORITY	CLIENT/BSH/AI
18	WIND VELOCITY	140 (87)
17	EARTHQUAKE ZONE	2A
16	MINIMUM DESIGN METAL TEMPERATURE	°C (F) 1 (33.8)
15	CHARPY IMPACT TEST	NO. EXEMPTED AS PER UCS-66 (c)
14	LETHAL SERVICE/CYCIC SERVICE	NO/NO
13	WET SOUR SERVICE	NO
12	POST WELD HEAT TREATMENT	YES (SEE NOTE No. 20)
11	JOINT EFFICIENCY	100
10	RADIOGRAPHY	FULL (RT-1)
9	CORROSION ALLOWANCE	mm 3.0
8	M.A.W.P. AT DESIGN TEMPERATURE	bar (psig) 31.04 (450.1) LIMITED BY SHELL 2
7	M.A.P. (NEW & COLD)	bar (psig) 36.31 (526.5) LIMITED BY SHELL 2 TO 6
6	FIELD HYDROTEST PRESSURE (CORRODED)	bar (psig) 40.35 (585)
5	SHOP HYDROTEST PRESSURE (HOR-TOP)	bar (psig) 47 (682)
4	WORKING TEMPERATURE (TOP/BOTL)	°C (F) 110.1 (230) / 108.9 (228)
3	WORKING PRESSURE (TOP/BOTL)	bar (psig) 25.46 (369.2) / 25.6 (371.2)
2	DESIGN TEMPERATURE (INT/EXT.)	°C (F) 150 (302) / 120 (248)
1	DESIGN PRESSURE (INT/EXT.)	bar (psig) 31 (449.6) / 0.5 (7.5) (SEE NOTE 22)

TOTAL WT. = 19438.3 Kgs.									
ITEM NO.	DESCRIPTION	QTY	UNIT	WT. (KGS)	WT. (LBS)	MAT'L	MAT'L CODE	MR. NO.	REMARKS
34	DEMISTER	0		0.0	0.0	SS304L	7391A1202	739100-017	REMARK
33	RP OD 150/80	0		0.0	0.0	SS304L	7391A1202	739100-005	11A14
32	ASME NAME PLATE	200		113.10	250.0	SS304	7391A1202	739100-005	STOCK
31	CLEAR NAME PLATE	150		120.00	265.0	SS304	7391A1202	739100-005	STOCK
30	NAME PLATE BKT	518		253.00	558.0	SS304	7391A1202	739100-005	STOCK
29	RP OD 1050/520	0		0.0	0.0	SS304L	7391A1202	739100-005	STOCK
28	RP OD 1100/620	0		0.0	0.0	SS304L	7391A1202	739100-005	STOCK
27	ST+200 1/2" BUN	270		0.0	0.0	SS304L	7391A1202	739100-005	STOCK
26	OK-24-300/-R 4.51	0		0.0	0.0	SS304L	7391A1202	739100-005	STOCK
25	BRF-24-300/-R 4.51	0		0.0	0.0	SS304L	7391A1202	739100-005	STOCK
24	FAB. PIPE	1935		327.00	721.0	SS304L	7391A1202	739100-005	STOCK
23	F-24-WHRF-300/-R 4.51	0		0.0	0.0	SS304L	7391A1202	739100-005	STOCK
22	F-24-WHRF-300/-R 4.51	0		0.0	0.0	SS304L	7391A1202	739100-005	STOCK
21	ST+200 1/2" BUN	175		0.0	0.0	SS304L	7391A1202	739100-005	STOCK
20	OK-12-300/-R 4.51	0		0.0	0.0	SS304L	7391A1202	739100-005	STOCK
19	RP OD 625/334	0		0.0	0.0	SS304L	7391A1202	739100-005	STOCK
18	PI 12" SCH.60	302		0.0	0.0	SS304L	7391A1202	739100-005	STOCK
17	BRF-12-300/-R 4.51	0		0.0	0.0	SS304L	7391A1202	739100-005	STOCK
16	ST+200 3/4" UNC	110		0.0	0.0	SS304L	7391A1202	739100-005	STOCK
15	OK-3-300/-R 4.51	0		0.0	0.0	SS304L	7391A1202	739100-005	STOCK
14	F-3-WHRF-300/-R 4.51	0		0.0	0.0	SS304L	7391A1202	739100-005	STOCK
13	F-3-WHRF-300/-R 4.51	0		0.0	0.0	SS304L	7391A1202	739100-005	STOCK
12	PI 3" SCH.160	237		0.0	0.0	SS304L	7391A1202	739100-005	STOCK
11	RP OD 180/88	0		0.0	0.0	SS304L	7391A1202	739100-005	STOCK
10	F-1-WHRF-300/-R 4.51	0		0.0	0.0	SS304L	7391A1202	739100-005	STOCK
9	RP OD 515/334	0		0.0	0.0	SS304L	7391A1202	739100-005	STOCK
8	PI 12" SCH.60	337		0.0	0.0	SS304L	7391A1202	739100-005	STOCK
7	F-12-WHRF-300/-R 4.51	0		0.0	0.0	SS304L	7391A1202	739100-005	STOCK
6	SK. BRL-A	5026		2368.00	5218.0	SS304L	7391A1202	739100-005	STOCK
5	ER-0-1570-251	0		0.0	0.0	SS304L	7391A1202	739100-005	STOCK
4	ER-0-1570-251	0		0.0	0.0	SS304L	7391A1202	739100-005	STOCK
3	SK. BRL-6	4986		2950.00	6500.0	SS304L	7391A1202	739100-005	STOCK
2	SK. BRL-2,3,4,5	4986		3000.00	6615.0	SS304L	7391A1202	739100-005	STOCK
1	SK. BRL-1	5001		3950.00	8700.0	SS304L	7391A1202	739100-005	STOCK

LIST OF MATERIAL

BELLELI SAUDI HEAVY INDUSTRIES LTD.

AS BUILT

CERTIFIED BY: *[Signature]*

TECHNIP-COFLEXIP

PROJ.: SABIC ACETIC ACID PROJECT

CLIENT: SABIC - YANBU - KINGDOM OF SAUDI ARABIA

MATERIAL REQUESTION No. 2121 MR 051102

ITEM: 100-0141

SR Doc. CODE: AI103 / A0402

VENDOR DOCUMENT REVIEW

☐ 1. REVIEW AND REWORK

☒ 2. TO BE ISSUED AS FINAL PROVIDED COMMENTS ARE INCORPORATED

☐ 3. NO COMMENT - FINAL ISSUE

☐ 4. FOR INFORMATION ONLY (INTERNAL USE)

U.O. TECHNIP ITALY S.p.A.

DATE: 14/05/05

REV.	DATE	DESCRIPTION	DRAWN	CHK'D	APP
4	30 Apr 05	REVISED AS PER CLIENT COMMENTS MARKED A & 'AS BUILT'	HEAVAT		
3	12 Jul 03	REVISED AS MARKED A & 'AS BUILT'	HEAVAT		
2	26 Apr 03	REVISED AS PER CLIENT COMMENTS MARKED A	HEAVAT		
1	26 Dec 02	REVISED AS PER CLIENT COMMENTS & ISSUED FOR CONSTRUCTION	HEAVAT		
0	27 Sep 02	ISSUED FOR APPROVAL & INTERNAL COMMENTS.	HEAVAT		

BELLELI SAUDI HEAVY INDUSTRIES LTD.

HEAVY INDUSTRIES LTD.

AL- JUBAL, KINGDOM OF SAUDI ARABIA



SABIC ACETIC ACID PLANT










IBN RUSHD SITE-YANBU-KINGDOM OF SAUDI ARABIA

CO2 ABSORBER (ITEM NO. 100-C141)

GENERAL ASSEMBLY

DRAWING NO. DA-7391-04-001

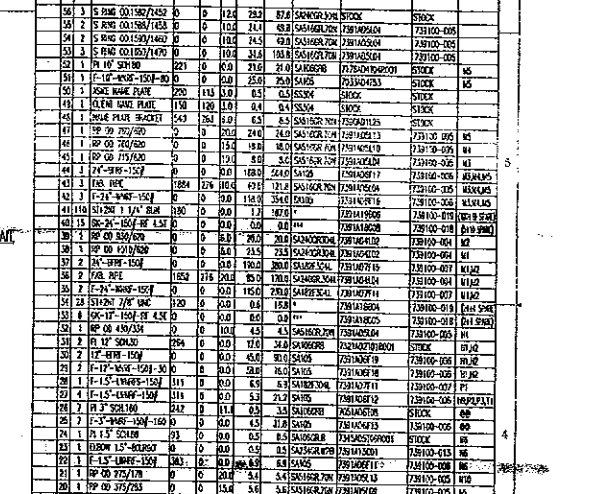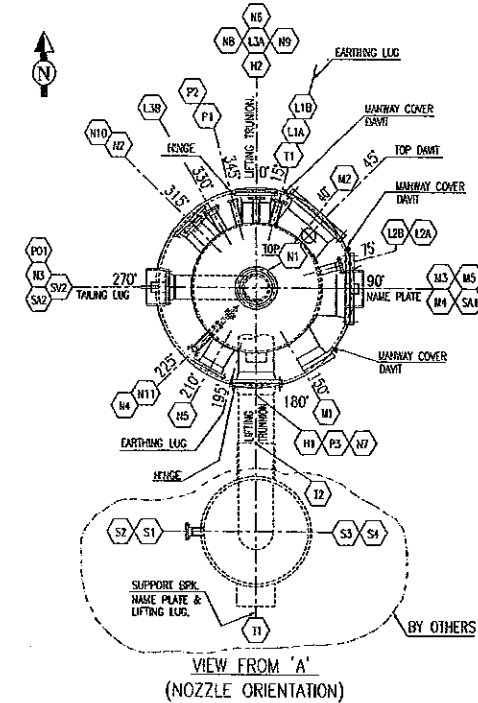[illegible]









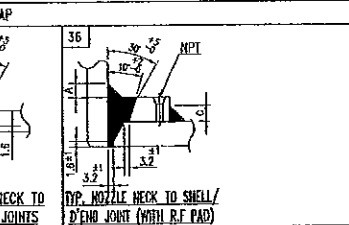
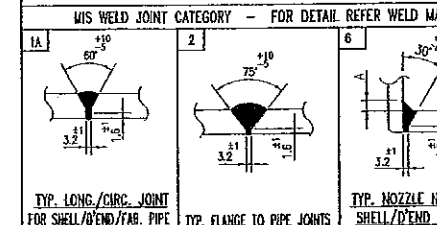
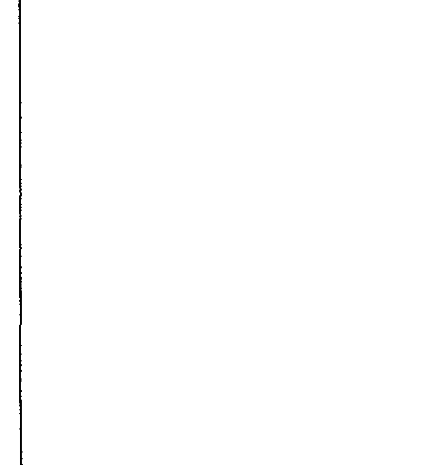
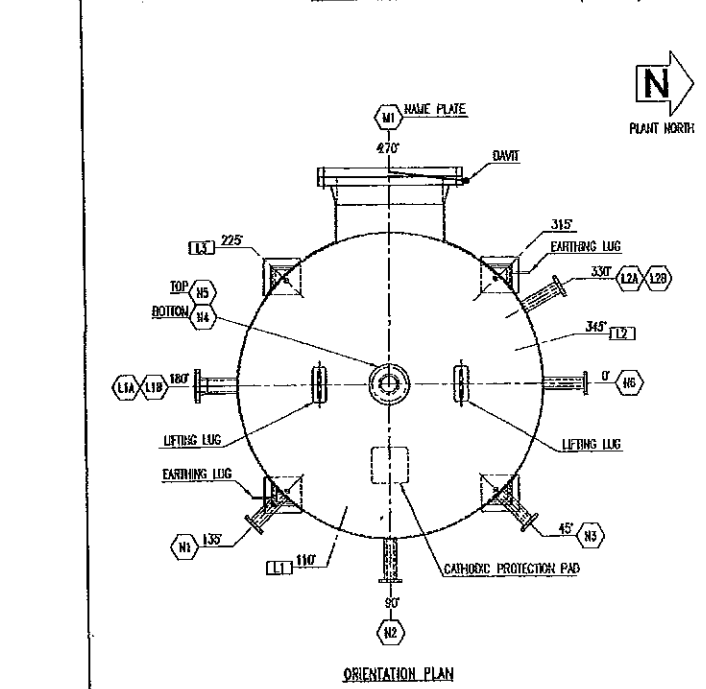
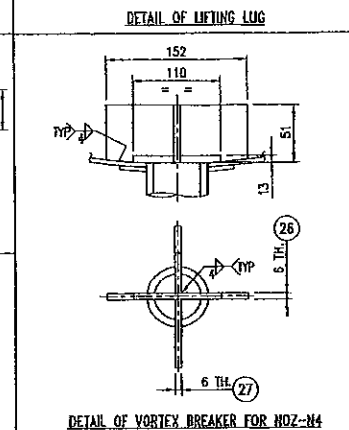
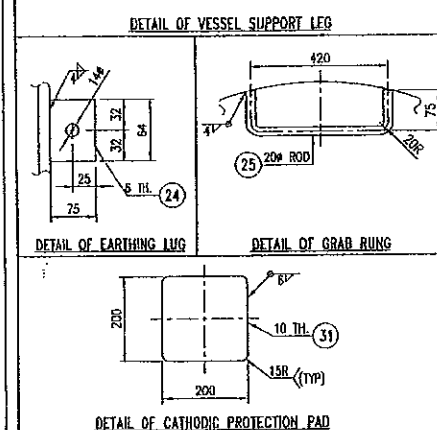
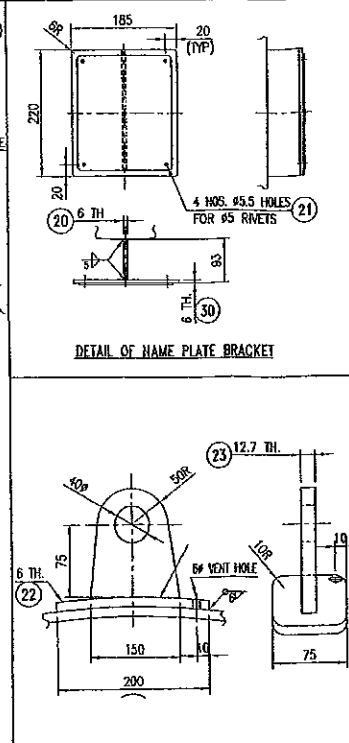
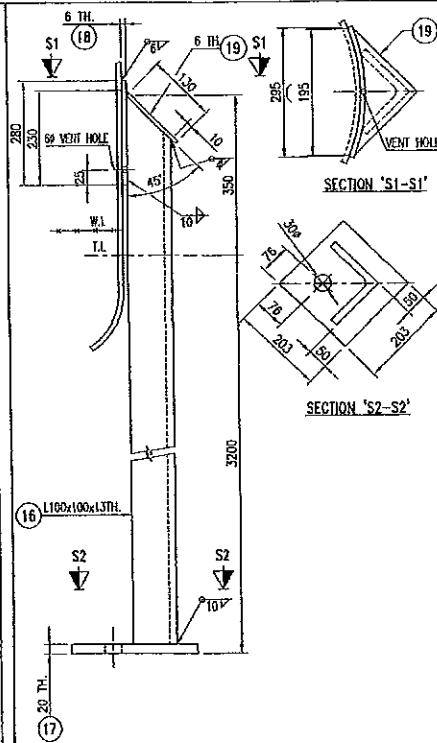
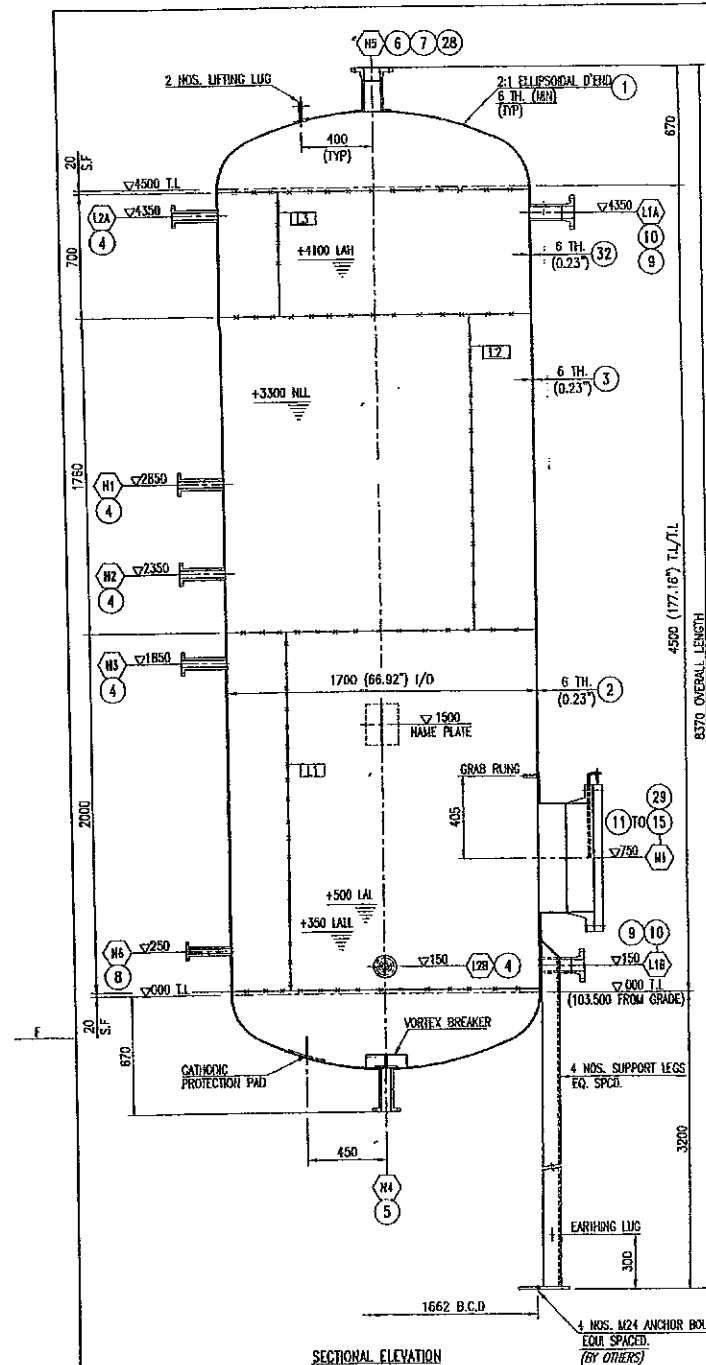


GENERAL NOTES

- THE VESSEL SHALL BE FABRICATED AS PER ASME SEC. VIII DIV. 1, ED. 2001.
- ALL DIMENSIONS ARE IN MM & NOZZLE ELEVATIONS ARE FROM TAN LINE UNLESS OTHERWISE NOTED.
- NOZZLE PROJECTIONS REFERRED FROM VESSEL CENTERLINE TO FLANGE CONTACT FACE.
- FLANGE GASKET CONTACT SURFACE FINISH SHALL BE AS PER ASME B 16.5 TO SUIT GASKET, 6.4 TO 12.5 RO. (ISO 488).
- NOZZLE BOLT HOLES SHALL STRADDLE PRINCIPAL CENTER LINES.
- ALL NOZZLES RF PADS SHALL HAVE 1 NO. 1/4" NPT TEL-TALE HOLE FOR AIR TEST AT 30 KPa WITH SOAP SUDS. THE HOLE SHALL BE FILLED WITH HARD GREASE AFTER HYDROTEST.
- ALL NOZZLES INSIDE EDGES EXCEPT NOZZLES WITH INSIDE PROJECTIONS SHALL BE FLUSHED WITH INTERNAL SURFACE OF VESSEL & ROUNDED OFF WITH 3 MM RADIUS.
- ALL PRESSURE RETAINING WELDS TO BE FULL PENETRATION.
- ALL INTERNAL WELDS SHALL BE CONTINUOUS FILLET WELDS.
- WELDING & NDT PER WELD MAP NO. MIS-4674-M010-V & QC INSPECTION PLAN.
- INDICATES WELD SEAM NUMBER.
- HYDROTEST SHALL BE CARRIED OUT IN HORIZONTAL POSITION USING POTABLE WATER WITH CHLORIDE CONTENT NOT EXCEEDING 50 PPM MAX. FOR 1 HR. TEMPERATURE FOR HYDROTEST SHALL BE 17 C MINIMUM AFTER TEST VESSEL SHALL BE FLUSHED WITH CLEAN WATER & SHALL BE THOROUGHLY DRAINED & DRIED.
- THE VESSEL SHALL BE THOROUGHLY DRIED AND CLEANED INSIDE AND OUTSIDE. IT SHALL BE FREE FROM WELD SPATTER, SCALE, SLAG, RUST AND ANY FOREIGN MATTERS.
- THE FABRICATION TOLERANCES SHALL BE AS PER CODE AS WELL AS SABIC STD. DWG. NO.: Q01-F28 REV. 0
- FLANGED CONNECTIONS & ALL OTHER MACHINED SURFACES SHALL BE PROTECTED BY A COATING & FITTED WITH STEEL OR WOODEN COVER, 3 MM THK & NEOPRENE GASKET USING AT LEAST 4 BOLTS.
- EXTERNAL S.S. SURFACE PREPARATION & PAINTING: AS PER SYSTEM S2 306 OF TECHNIP SPEC. 2121-00-JSD-2300-01. - VESSEL COMPONENTS (SHELL, DISHED ENDS, NOZZLES ETC.). ALL EXTERNAL S.S. SURFACES PREPARATION SHALL BE AS PER - SSPC SP 7. PAINTING: 2 COATS OF EPOXY PHENOLIC 150 MICRONS DFT. TOTAL DFT - 300 MICRONS
- EXTERNAL C.S. SURFACE PREPARATION & PAINTING: AS PER SYSTEM 'S1' OF TECHNIP SPEC. 2121-00-JSD-2300-01. - SUPPORT LEG, EXTERNAL ATTACHMENT ETC. ALL EXTERNAL C.S. SURFACES SHALL BE GRIT BLASTED AS PER - SA 2 PAINTING: PRIMER - EPOXY MASTIC - 125 MICRONS DFT. TOP COAT - POLYURETHANE ENAMEL (ALIPHATIC) - 50 MICRONS DFT. TOTAL DFT - 175 MICRONS
- EXTERNAL ATTACHMENT PADS SHALL HAVE 1 NO. #6 VENT HOLES & SHALL BE FILLED WITH HARD GREASE ONLY AFTER HYDROTEST.
- MARKINGS ON VESSEL BEFORE SHIPMENT SHALL BE IN ACCORDANCE WITH SPECS. Q01-G01.
- THE INDICATED THICKNESS ARE THE MINIMUM ACCEPTABLE AFTER CONSTRUCTION
- INSIDE SURFACE OF S.S. SHALL BE PICKLED AND PASSIVATED AS PER SPEC. 2121-00-JSD-3200-01

ITEM	QTY.	SIZE	SCH./WTH.	RATING	TYPE	FACE	IN FROM C/L	PROJECTION (NOTE 3)	SERVICE	TYPE	A	B	C	REMARKS
M1	1	24"	6 TH.	150#	WN	RF	-	1160	MANWAY	1A2.35	6	-	6	BLIND FLG. / DAVIT & RF PAD 6 TH. x 200
L2B	1	1/2"	14.2 TH.	150#	LWN	RF	-	1100	LEVEL TRIP	6	6	-	-	
L2A	1	1/2"	14.2 TH.	150#	LWN	RF	-	1100	LEVEL TRIP	6	6	-	-	
L1B	1	3"	SCH 40S	150#	WN	RF	-	1100	LEVEL BRIDLE	2.6	6	-	-	
L1A	1	3"	SCH 40S	150#	WN	RF	-	1100	LEVEL BRIDLE	2.6	6	-	-	
N6	1	1"	12.7 TH.	150#	LWN	RF	-	1100	PUMP SPILLBACK	6	6	-	-	
N5	1	4"	SCH 40S	150#	WN	RF	-	1100	VENT	2.36	6	-	6	RF PAD 6 TH. x 200
N4	1	2"	13.2 TH.	150#	LWN	RF	-	1100	LIQUID OUTLET	6	6	-	-	VORTEX BREAKER
N3	1	1/2"	14.2 TH.	150#	LWN	RF	-	1100	RECYCLE WATER FEED	6	6	-	-	
N2	1	1/2"	14.2 TH.	150#	LWN	RF	-	1100	RECYCLE CONDENSATE FEED	6	6	-	-	
N1	1	1/2"	14.2 TH.	150#	LWN	RF	-	1100	DEAERATED WATER FEED	6	6	-	-	

NOZZLE MARK	QTY.	SIZE	SCH./WTH.	RATING	TYPE	FACE	IN FROM C/L	PROJECTION (NOTE 3)	SERVICE	TYPE	A	B	C	REMARKS
001-001	1	24"	6 TH.	150#	WN	RF	-	1160	MANWAY	1A2.35	6	-	6	BLIND FLG. / DAVIT & RF PAD 6 TH. x 200
001-002	1	1/2"	14.2 TH.	150#	LWN	RF	-	1100	LEVEL TRIP	6	6	-	-	
001-003	1	1/2"	14.2 TH.	150#	LWN	RF	-	1100	LEVEL TRIP	6	6	-	-	
001-004	1	3"	SCH 40S	150#	WN	RF	-	1100	LEVEL BRIDLE	2.6	6	-	-	
001-005	1	3"	SCH 40S	150#	WN	RF	-	1100	LEVEL BRIDLE	2.6	6	-	-	
001-006	1	1"	12.7 TH.	150#	LWN	RF	-	1100	PUMP SPILLBACK	6	6	-	-	
001-007	1	4"	SCH 40S	150#	WN	RF	-	1100	VENT	2.36	6	-	6	RF PAD 6 TH. x 200
001-008	1	2"	13.2 TH.	150#	LWN	RF	-	1100	LIQUID OUTLET	6	6	-	-	VORTEX BREAKER
001-009	1	1/2"	14.2 TH.	150#	LWN	RF	-	1100	RECYCLE WATER FEED	6	6	-	-	
001-010	1	1/2"	14.2 TH.	150#	LWN	RF	-	1100	RECYCLE CONDENSATE FEED</					

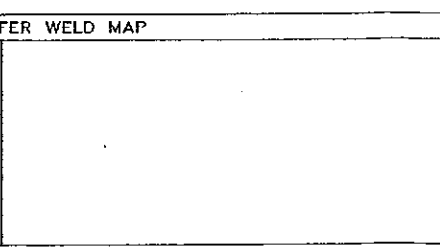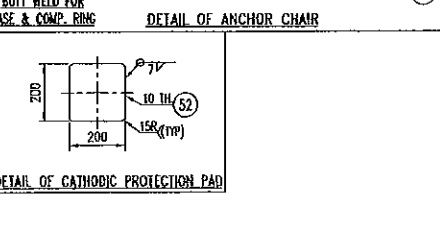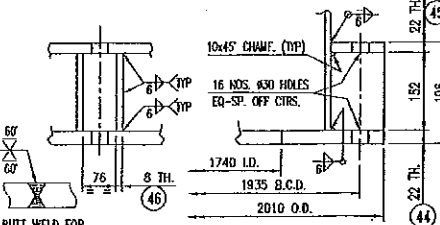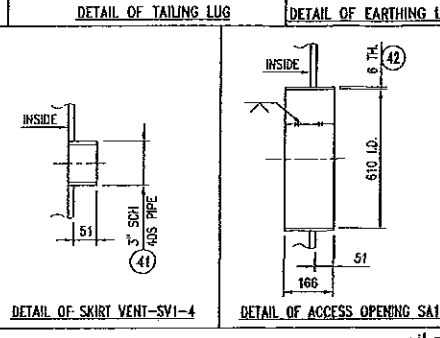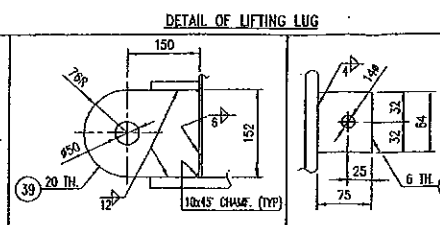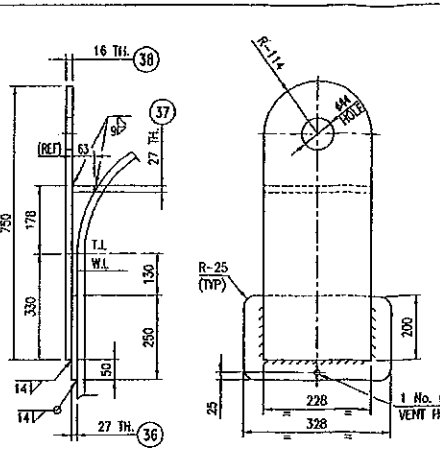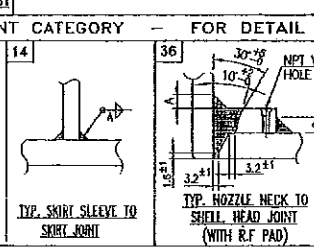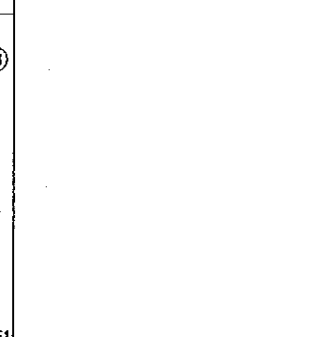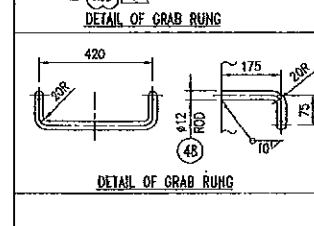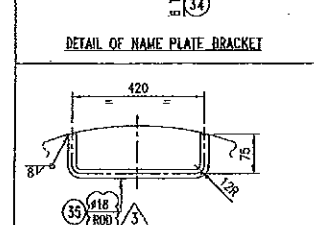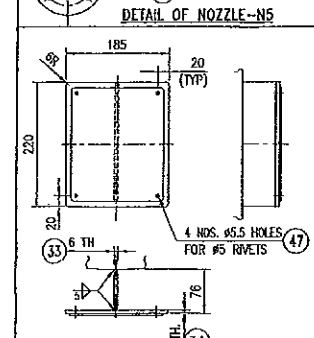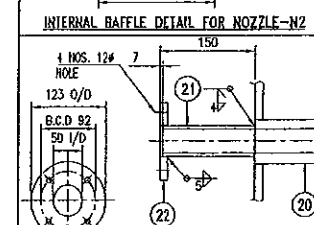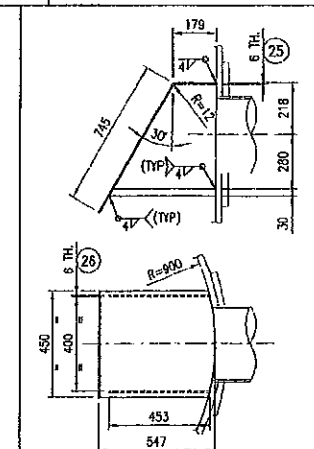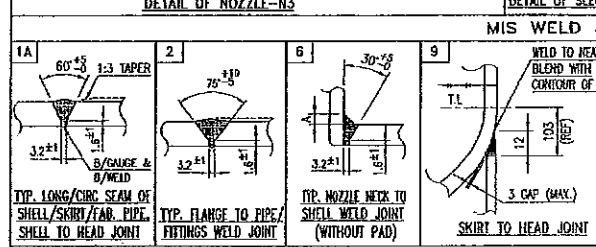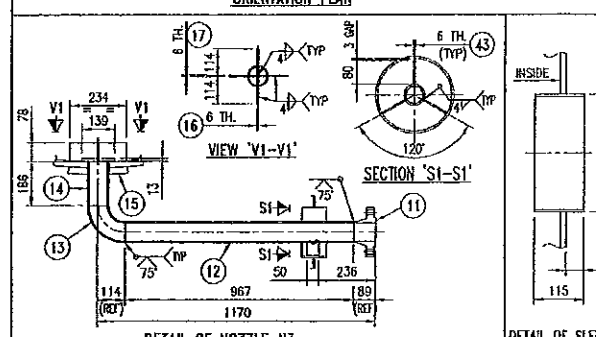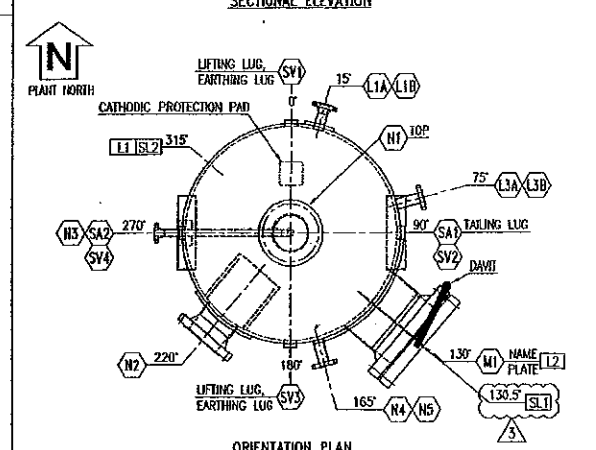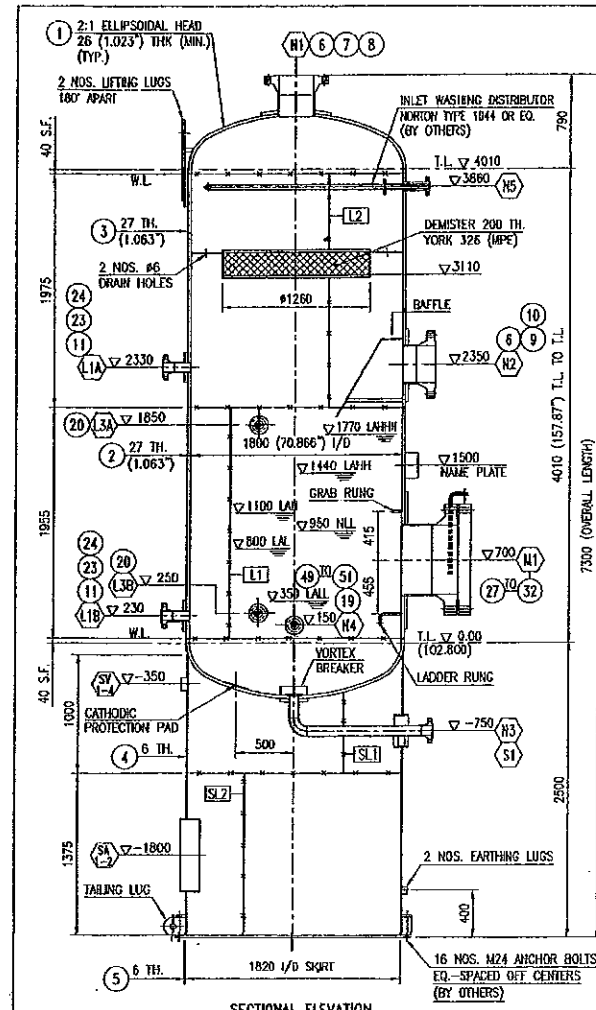

GENERAL NOTES

- THE VESSEL SHALL BE FABRICATED AS PER ASME SEC. VIII DIV. 1, ED. 2001.
- ALL DIMENSIONS ARE IN MM & NOZZLE ELEVATIONS ARE FROM TAN LINE UNLESS OTHERWISE NOTED.
- NOZZLE PROJECTIONS REFERRED FROM VESSEL CENTERLINE TO FLANGE CONTACT FACE.
- FLANGE GASKET CONTACT SURFACE FINISH SHALL BE AS PER ASME B 16.5 TO SUIT GASKET, 3.2 TO 6.3 RO. (ISO 408).
- NOZZLE BOLT HOLES SHALL STRADDLE PRINCIPAL CENTER LINES.
- ALL NOZZLES RF PADS SHALL HAVE 1 NO. 1/4" NPT TEL-TALE HOLE FOR AIR TEST AT 30 MPa WITH SOAP SUDS. THE HOLE SHALL BE FILLED WITH HARD GREASE AFTER HYDROTEST.
- ALL NOZZLES INSIDE EDGES EXCEPT NOZZLES WITH INSIDE PROJECTIONS SHALL BE FLUSHED WITH INTERNAL SURFACE OF VESSEL & ROUNDED OFF WITH 3 MM RADIUS.
- ALL PRESSURE RETAINING WELDS TO BE FULL PENETRATION.
- ALL INTERNAL WELDS SHALL BE CONTINUOUS FILLET WELDS.
- WELDING & NOT PER WELD MAP No. MIS-4674-M013-V & QC INSPECTION PLAN.
- INDICATES WELD SEAM NUMBER.
- HYDROTEST SHALL BE CARRIED OUT IN HORIZONTAL POSITION USING POTABLE WATER WITH CHLORIDE CONTENT 50 PPM FOR 1 HR. 15 MINUTES. TEMPERATURE FOR HYDROTEST SHALL BE 17 C MINIMUM. AFTER TEST VESSEL SHALL BE FLUSHED WITH CLEAN WATER & SHALL BE THOROUGHLY DRAINED & DRIED.
- THE VESSEL SHALL BE THOROUGHLY DRIED AND CLEANED INSIDE AND OUTSIDE. IT SHALL BE FREE FROM WELD SPATTER, SCALE, SLAG, RUST AND ANY FOREIGN MATTERS.
- SERVICE GASKETS & BOLTINGS SHALL BE USED DURING HYDROTEST.
- THE FABRICATION TOLERANCES SHALL BE AS PER CODE AS WELL AS SADR STD. DWG. NO. : 001-728 REV. 0.
- FLANGED CONNECTIONS & ALL OTHER MACHINED SURFACES SHALL BE PROTECTED BY A COATING & FITTED WITH STEEL OR WOODEN COVER, 3 MM THK & NEOPRENE GASKET USING AT LEAST 4 BOLTS.
- EXTERNAL S.S. SURFACE PREPARATION & PAINTING : AS PER SYSTEM S2 306 OF TECHNIP SPEC. 2121-00-JSD-2300-01, REV. 0. VESSEL COMPONENTS (SHELL, DISHED ENDS, NOZZLES, TOP S.S. SKIRT INTERNAL/EXTERNAL ETC.) ALL EXTERNAL S.S. SURFACES PREPARATION SHALL BE AS PER - SSPC SP 7. PAINTING : 2 COATS OF EPOXY PHENOLIC 150 MICRONS DFT. TOTAL DFT - 300 MICRONS. EXTERNAL C.S. SURFACE PREPARATION & PAINTING : AS PER SYSTEM 'S1' OF TECHNIP SPEC. 2121-00-JSD-2300-01, REV. 0. VESSEL COMPONENTS (BOT. C.S. SKIRT, EXTERNAL ETC.) ALL EXTERNAL C.S. SURFACES SHALL BE GRIT BLASTED AS PER - SA 2. PAINTING : PRIMER - EPOXY MASTIC - 125 MICRONS DFT. TOP COAT - POLYURETHANE ENAMEL (ALIPHATIC) - 50 MICRONS DFT. TOTAL DFT - 175 MICRONS.
- EXTERNAL ATTACHMENT PADS SHALL HAVE 1 NO. 66 VENT HOLES & SHALL BE FILLED WITH HARD GREASE ONLY AFTER HYDROTEST.
- MARKINGS ON VESSEL BEFORE SHIPMENT SHALL BE IN ACCORDANCE WITH SPECS. 001-001.
- ALL REMOVABLE INTERNALS SHALL PASS THROUGH 500 MM ID MANWAY.
- THE STATIC PRESSURE OF THE CONTENTS SHALL BE ADDED TO THIS PRESSURE.
- DEMISTER TO BE KOCH OFFO YORK 326 OR EQUIVALENT AND IS TO BE REMOVABLE FROM BELOW. AS PER STD. 001-F31 FOR SUPPORT DETAILS. DEMISTER TO BE 1260 DIA. AND TO BE 260 mm THK.
- FLUID COMPOSITION (moles): VAPOUR: ETHANE 51.4, METHANE 22.6, NITROGEN 20.3, CARBON DIOXIDE 2.5, ETHYLENE 1.6, WATER 0.8, OXYGEN 0.4, ARGON 0.2, PROPANE 0.2, OTHERS 0.1. LIQUID : WATER 100.0.
- MINIMUM DESIGN TEMPERATURE AT 9'C AT 31.6 barg.
- INSIDE SURFACE OF S.S. SHALL BE PICKLED AND PASSIVATED AS PER SPEC. 2121-00-JSD-3200-01.

PART		QTY.	PART	DESCRIPTION	MATERIAL	REF. DRG. (MIS USE)	WT. (KGS)
52	1		PAD PLATE	PLATE 10 TH. x 200 x 200	SA 240 GR. 304L	SEE DRG.	3
51	4+3		NOZ. N4	SHD #5/8" x 3 1/2" LG. w/2 HEX NUTS	SA 193-07/194-2H	SEE DRG.	2
50	1+2		NOZ. N4	GASKET SPIRAL WOUND 1" 600# RF API-601	##	SEE DRG.	-
49	1		NOZ. N4	BLIND FLANGE 1" 600# RFS ASME B16.5	SA 182 F 304L	SEE DRG.	3
48	1		LADDER RUNG	ROD #12 x 880 LG.	SS 304L	SEE DRG.	3
47	4		NAME PLATE	RIVETS #5	##	SEE DRG.	-
46	32		GUSSET	PLATE 8 TH. x 152 x 91	SA 516 GR. 70	SHOP DRG.	98
45	1		COMP. RING	PLATE 22 TH. x 2010 O/D x 1832 I/D	SA 516 GR. 70	SHOP DRG.	23
44	1		BASE RING	PLATE 22 TH. x 2010 O/D x 1740 I/D	SA 516 GR. 70	SHOP DRG.	137
43	3		NOZ. N3	FIN PLATE 6 TH. x 50 x 85 (CUT TO SUIT)	SA 240 GR. 304L	SEE DRG.	1
42	2		SHORT ACCESS	FAB. PIPE PLX. 6 TH. x 160W x 1935	A 36 OR EQ.	SEE DRG.	39
41	4		SHORT VENT	PIPE 3" SCH 40S x 58 LG.	SA 312 TP 304L	SEE DRG.	3
40	2		EARTHING LUG	PLATE 6 TH. x 64 x 75	SS	SEE DRG.	1
39	1		TAILING LUG	PLATE 20 TH. x 226 x 152	SA 516 GR. 70	SEE DRG.	5

DESIGN CODE		ASME SEC. VIII, DIV-1, ED. 2001	CODE STAMP	YES
INT. DESIGN	SHELL	31.6 BARG (458.3 PSIG)	SERIAL NO.	152-14
DESIGN PRESSURE	HEAD	31.6 BARG (458.3 PSIG)	YEAR BUILT	2003
DESIGN PRESSURE (EXT.)	NIL		OPERATING PRESSURE	25.26/28.16 BARG (366.3/373.4 PSIG)
DESIGN TEMPERATURE	150° C (302° F)		OPERATING TEMP. MAX.	60° C (140° F)
MIN. DESIGN METAL TEMP.	9° C (48.2° F)		WAMP (H&C)	32.45 BARG (470.6 PSIG)
CORROSION ALLOWANCE	NIL		WAMP (H&C)	32.7 BARG (474.3 PSIG)
IMPACT TEST	NO		HYDROTEST	42.82 BARG (621.1 PSIG)
RADIOGRAPHY	RT-1		PRESSURE	42.51 BARG (616.5 PSIG)
JOINT EFFICIENCY	1.0		FIRE PROOFING	NO
P.W.M.T.	NO		INSULATION	NO
MAX. OPER. STATIC HEAD	FULL		CYCLIC/SOAR/LETHAL SERVICE	NO / NO / NO
EARTH QUAKE	UBC-ZONE 2A		EXTERNAL PADIT	YES (SEE NOTE-17)
WIND SPEED	38.0 m/s (ASCE-7)		INTERNAL COATING	NO
INSPECTION	A.I.		OPERATING MEDIUM	SEE NOTE-23
WEIGHTS	ERECTOR	8900 KGS.	SPECIFIC GRAVITY OF LIQUID	0.991
	OPERATING	16300 KGS.	HAZARD CONSIDERATION	FLAMMABLE
	HYDROTEST	22700 KGS.	NORMAL CAPACITY	11.73 CLM.

MATERIAL OF CONSTRUCTION	
SHELL	SA 240 GR. 304L
HEAD	SA 240 GR. 304L
FLANGES	SA 182 F 304L
PIPE	SA 312 TP 304L (SUS)
FAB. PIPE	SA 240 GR. 304L
TOP SKIRT	SA 240 GR. 304L
BOTTOM SKIRT	SA 516 GR. 70
ANCHOR CHAIR, BASE/COMP. FLT.	SA 516 GR. 70
INTERALS	SS 304L
INTERNAL PIPE	SA 312 TP 304L
EXTERNAL ATTACH.	SA 240 GR. 304L/A 36 OR EQ.
BOLTING EXTERNAL	SA 193 GR 87/SA 194 GR 2H
BOLTING INTERNAL	SS 304L
GASKETS (EXT.)	SS 304L SPWD GRAPHITE FILLED
GASKETS (INT.)	HW
FITTINGS	SA 403 WP 304L

BILL OF MATERIAL Contd...		##	SS 304L SPIRAL WOUND GRAPHITE FILLED
38	2	LIFTING LUG	PLATE 16 TH. x 228 x 750
37	2	LIFTING LUG	PLATE 27 TH. x 100 x 220 (CUT TO SUIT)
36	2	LIFTING LUG	PAD PLATE 27 TH. x 250 x 328
35	1	GRAB RUNG	ROD #18 x 553 LG.
34	1	NAME PLATE	PLATE 6 TH. x 185 x 220
33	1	NAME PLATE	PLATE 6 TH. x 78 x 220
32	14+3	MANWAY-M1	SHD #1 7/8" x 13" LG. w/2 HEX NUTS
31	142	MANWAY-M1	GASKET SPIRAL WOUND 24" 600# RF API-601
30	1	MANWAY-M1	BLIND FLANGE 24" 600# RFS ASME B16.5
29	1	MANWAY-M1	R.F. PAD PLATE 27 TH. x 1165 O/D x 622 I/D
28	1	MANWAY-M1	FAB. PIPE 12 TH. x 314 x 1891
27	1	MANWAY-M1	FLANGE 24" WN 600# RFS ASME B16.5 (6500 BORE)
26	2	INT. BAFFLE	PLATE 6 TH. x 30 x 453
25	1	INT. BAFFLE	PLATE 6 TH. x 450 x 935 (CUT TO SUIT)
24	2	NOZ. LIA/B	R.F. PAD PLATE 27 TH. x 255 O/D x 102 I/D
23	2	NOZ. LIA/B	PIPE 3" SCH 40S x 142 LG.
22	1	NOZ. N5	PLATE FLANGE 10 TH. x 123 O/D x 50 I/D
21	1	NOZ. N5	PIPE 1 1/2" SCH 80S x 147 LG.
20	3	NOZ. N5	FLANGE 1 1/2" WN 600# RFS x 231 LG. ASME B16.5
19	1	NOZ. N4	FLANGE 1" WN 600# RFS x 231 LG. ASME B16.5
18	1	NOZ. N3	SLEEVE PIPE 10" SCH 40S x 118 LG.
17	2	VORTEX BREAKER	PLATE 6 TH. x 78 x 114
16	1	VORTEX BREAKER	PLATE 6 TH. x 78 x 234
15	1	NOZ. N3	R.F. PAD PLATE 27 TH. x 245 O/D x 102 I/D
14	1	NOZ. N3	PIPE 3" SCH 40S x 186 LG.
13	1	NOZ. N3	ELBOW 3" SCH 40S 90° LR. ASME B16.9
12	1	NOZ. N3	PIPE 3" SCH 40S x 967 LG.
11	3	NOZ. N3/LIA/B	FLANGE 3" WN 600# RFS ASME B16.5 (SCH 40S BORE)
10	1	NOZ. N2	R.F. PAD PLATE 27 TH. x 610 O/D x 342 I/D
9	1	NOZ. N1	FAB. PIPE 10 TH. 132W x 889 LG.
8	1	NOZ. N1	R.F. PAD PLATE 27 TH. x 610 O/D x 342 I/D
7	1	NOZ. N1	FAB. PIPE 10 TH. 186W x 889 LG.
6	2	NOZ. N1/N2	FLANGE 12" WN 600# RFS ASME B16.5 (SCH 40S BORE)
5	1	SKIRT	PLATE 6 TH. x 1375W x 5737 LG.
4	1	SKIRT	PLATE 6 TH. x 1050W x 5737 LG. (ALLOWANCE ADDED)
3	1	SHELL	PLATE 27 TH. x 1975W x 5740 LG.
2	1	SHELL	PLATE 27 TH. x 1955W x 5740 LG.
1	2	HEAD	2-1 ELLIPSOIDAL HEAD 1800 I/D x 26 TH. (MIN)

BILL OF MATERIAL	
TECHNIP-COFLIXIP	
NOMINAL SABIC ACETIC ACID PLANT	
CLIENT SABIC - YANBU - KINGDOM OF SAUDI ARABIA	
MATERIAL REQUISITION No.	
2121	MR 01811110121
ITEM 100-0241	
SR Des. CODE: A1103	
U.O.: TECHNIP ITALY S.p.A.	
BY:	DATE:
☐ 1 REVISE AND RE-SUBMIT ☐ 2 TO BE ISSUED AS FINAL PROVIDED COMMENTS ARE INCORPORATED ☐ 3 NO COMMENT - FINAL ISSUE ☐ 4 FOR INFORMATION ONLY (INTERNAL USE)	
ASME NATI. BOARD No. 21	
3 12.07.03 AS BUILT. SMK MHO/RSS	
2 07.04.03 REVISED AS MARKED. SMK MHO/RSS	
1 22.02.03 REVISED AS MARKED. SMK MHO/RSS	
0 05.01.03 ISSUED FOR CONSTRUCTION & REVISED AS MARKED. SMK MHO/RSS	
A 16.11.02 ISSUED FOR CLIENT'S APPROVAL SMK MHO/RSS	
REV	DATE
DESCRIPTION	
BY	DATE
DATE	
DATE	
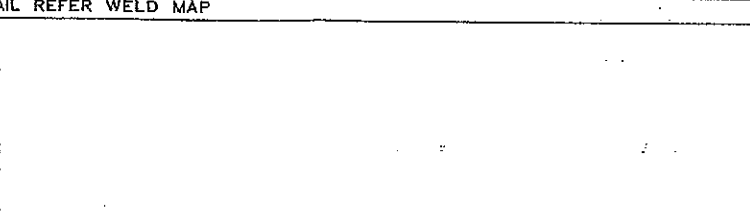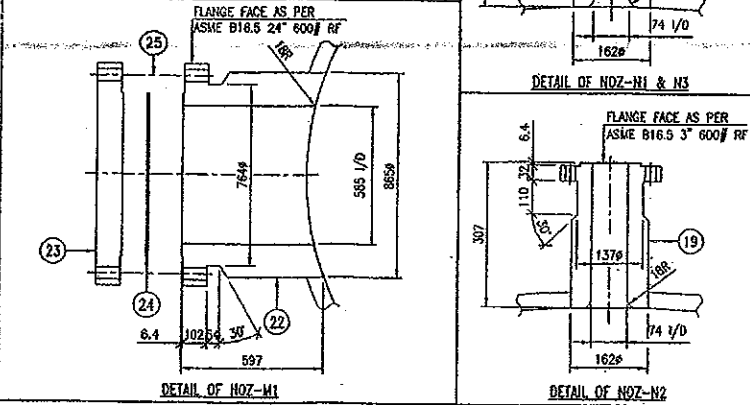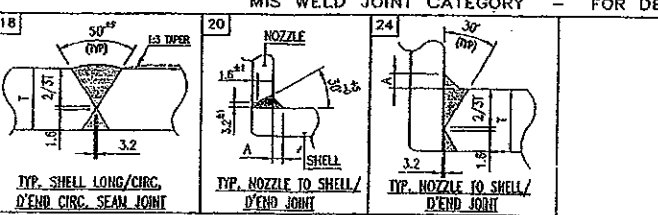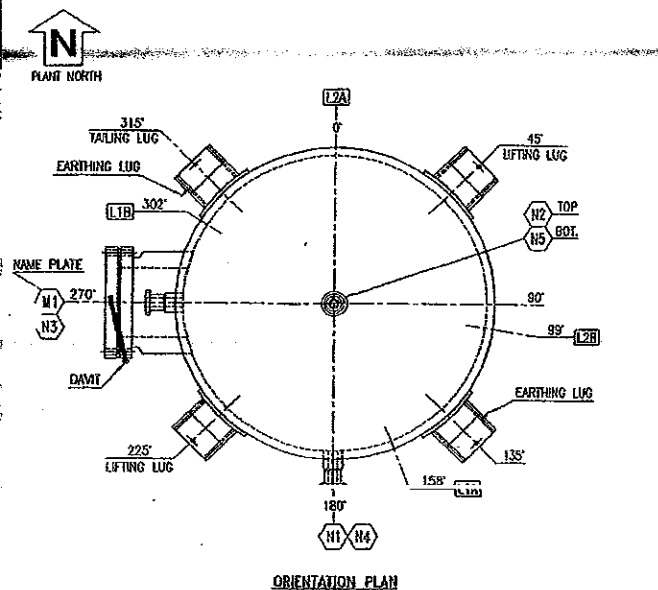[illegible]

R
I.

ISS 304L SPW0 NAF FILLED, SS 304L INNER RING & C.S. OUTER RING									
								TOTAL WT.	3248
29	842	NOZ-N5	STUD BOLT 5/8" Φ x 4 1/4" LG. W/2 HXY HEX NUTS	SA 105 GR 70/SA 105 GR 70	SEE DRG.	12			
28	142	NOZ-N5	GASKET 2" 600F-RF API 601	#	SEE DRG.	-			
27	1	NOZ-N5	BUND FLANGE 2" 600F-RF ASME B16.5	SA 105	SEE DRG.	6			
26	1	NAME PLATE	PLATE 6 TH. x 67 x 220	SA 516 GR. 70	SEE DRG.	2			
25	24+3	NOZ-M1	STUD BOLT 1 7/8" Φ x 13" LG. W/2 HXY HEX NUTS	SA 105 GR 70/SA 105 GR 70	SEE DRG.	183			
24	1+2	NOZ-M1	GASKET 24" 600F-RF API 601	#	SEE DRG.	-			
23	1	NOZ-M1	BUND FLANGE 24" 600F-RF ASME B16.5	SA 105	SEE DRG.	573			
22	1	NOZ-M1	SR FORGING 24" 600F-RF x 597 LG. (SEE DETAIL)	SA 105	SEE DRG.	1482			
21	1	NOZ-M5	FLANGE LNN 2" 600F-RF ASME B16.5 x 238 LG.	SA 105	SEE DRG.	70			
20	1	NOZ-M4	FLANGE LNN 1" 600F-RF ASME B16.5 x 242 LG.	SA 105	SEE DRG.	11			
19	1	NOZ-M2	SR FORGING 3" 600F-RF x 307 LG. (SEE DETAIL)	SA 105	SEE DRG.	41			
18	2	NOZ-M1 & N3	SR FORGING 3" 600F-RF x 313 LG. (SEE DETAIL)	SA 105	SEE DRG.	83			
17	1	TAILING LUG	PLATE 25 TH. x 200 x 200	A 36	SEE DRG.	8			
16	1	TAILING LUG	PAD PLATE 30 TH. x 300 x 125	SA 516 GR. 70	SEE DRG.	9			
15	8	SUPT. BRACKET	PLATE 20 TH. x 348 x 250	A 36	SEE DRG.	110			
14	4	SUPT. BRACKET	PLATE 20 TH. x 400 x 165	A 36	SEE DRG.	41			
13	4	SUPT. BRACKET	PLATE 30 TH. x 400 x 353	A 36	SEE DRG.	132			
12	4	SUPT. BRACKET	PAD PLATE 32 TH. x 450 x 550	SA 516 GR. 70	SEE DRG.	233			
11	2	EARTHING LUG	PLATE 6 TH. x 64 x 75	SS	SEE DRG.	1			
10	4	NAME PLATE	RIVETS .45	SA 516 GR. 70	SEE DRG.	-			
9	1	NAME PLATE	PLATE 6 TH. x 185 x 220	SA 516 GR. 70	SEE DRG.	2			
8	2	LIFTING LUG	PLATE 30 TH. x 408 x 1036	A 36	SEE DRG.	198			
7	2	LIFTING LUG	PLATE 30 TH. x 150 x 446 (CUT TO SUIT)	SA 516 GR. 70	SEE DRG.	32			
6	2	LIFTING LUG	PAD PLATE 30 TH. x 250 x 505	SA 516 GR. 70	SEE DRG.	60			
5	1	GRAB RING	ROD Φ 20 x 590 LG. (CUT TO SUIT)	A 36 OR EQ.	SEE DRG.	2			
4	2	LADDER RUNG	ROD Φ 20 x 340 LG. (CUT TO SUIT)	A 36 OR EQ.	SEE DRG.	6			
3	1	SHELL	PLATE 70 TH. x 2400W x 8074 LG.	SA 516 GR. 70	SHOP DRG.	10640			
2	1	SHELL	PLATE 70 TH. x 2500W x 8074 LG.	SA 516 GR. 70	SHOP DRG.	11084			
1	2	HEAD	2.1 ELIPSOIDAL D'END 2500 1/0 x 68 TH. (MIN.)	SA 516 GR. 70	SEE DRG.	7546			
PART NO.	QTY.	PART	DESCRIPTION	MATERIAL	REF. DRG.	WT. (KGS)			

BILL OF MATERIAL (FORM FOR 1 NO. EGYPT)	
TECHNICAL CASE FILE MODEL: SAUD ACETIC ACID PRODUCTS CEMENT: SAUD - YAMBO - KHAMOON OF SAUD ARABIA	☐ 1. REVISE AND RESUBMIT ☐ 2. TO BE ISSUED AS FINAL PROVIDED COMMENTS ARE INCORPORATED ☐ 3. NO COMMENT - FINAL ISSUE ☐ 4. FOR INFORMATION ONLY (EXTERNAL USE)
MATERIAL REQUISITION No. 2121 MR 1010111011	DATE:
ITEM: 100-D274 SR Doc. CODE: A1102	BY: TECHNIP ITALY S.p.A.


3	12.07.03	AS BUILT	SMK	PL/ABD
2	18.03.03	REVISED AS MARKED.	SMK	PL/ABD
1	02.03.03	REVISED AS MARKED.	SMK	PL/ABD
0	22.01.03	ISSUED FOR CONSTRUCTION & REVISED AS MARKED.	SMK	PL/ABD
A	27.11.02	ISSUED FOR CLIENT'S APPROVAL.	SMK	PL/ABD
REV	DATE	DESCRIPTION	BY	CHKD/APPD

DRN BY : SMK
 DATE : 27.11.02
 CHKD. / APPD. BY :
 DATE : 27.11.02
 JOB No. 4674
 CNO FILE NAME : 4574020
 S. CITY.

MARITIME INDUSTRIAL SERVICES CO. LTD. INC.
 P.O. BOX 4586, SHARJAH, UNITED ARAB EMIRATES

CLIENT : TECHNIP-COFLUXIP - SABIC
 PROJECT : SABIC ACETIC ACID PLANT, IBN RUSHD SITE - YANGBU, K.S.A.
 EQUIPMENT HP START-UP NITROGEN VESSEL (ITEM NO. 100-0274)
 GENERAL ARRANGEMENT & DETAILS

SCALE : 1:30
 DRAWING NO. MIS-4674-020-V

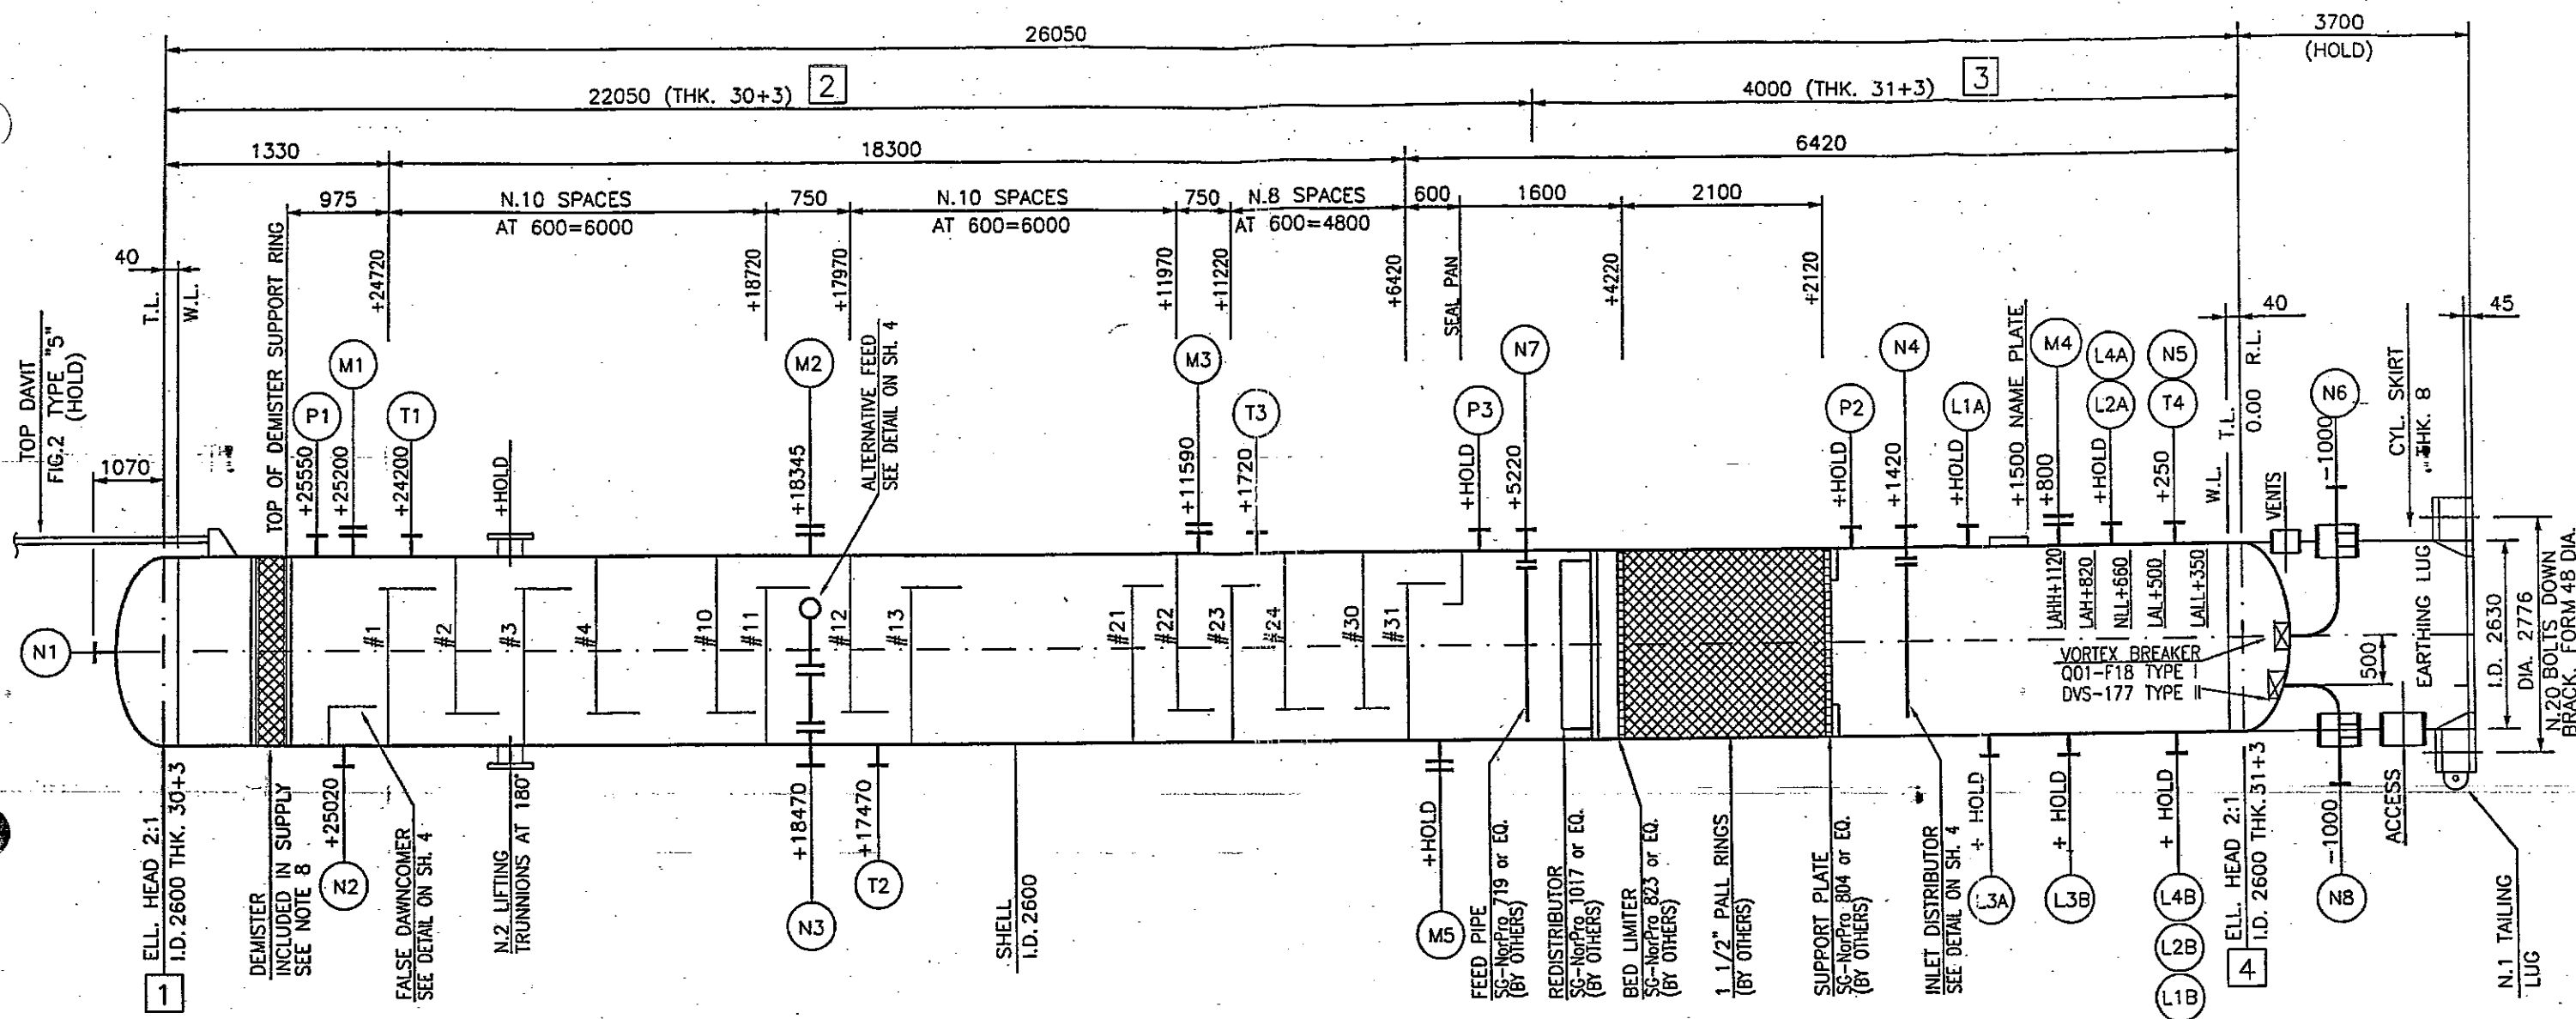


TECHNIP-COFLEXIP


سابك
sabik

SABIC ACETIC ACID PLANT
IBN RUSHD SITE - YANBU - KINGDOM OF SAUDI ARABIA


XXXX Status	ITEM : 100-C131					
	SERVICE : SCRUBBER					
CAD model	2121	03	DW	0511 - 01	3 of 4	0
Scale	Project	Unit	Type of doc.	Code & progressive	Sheet	Rev.

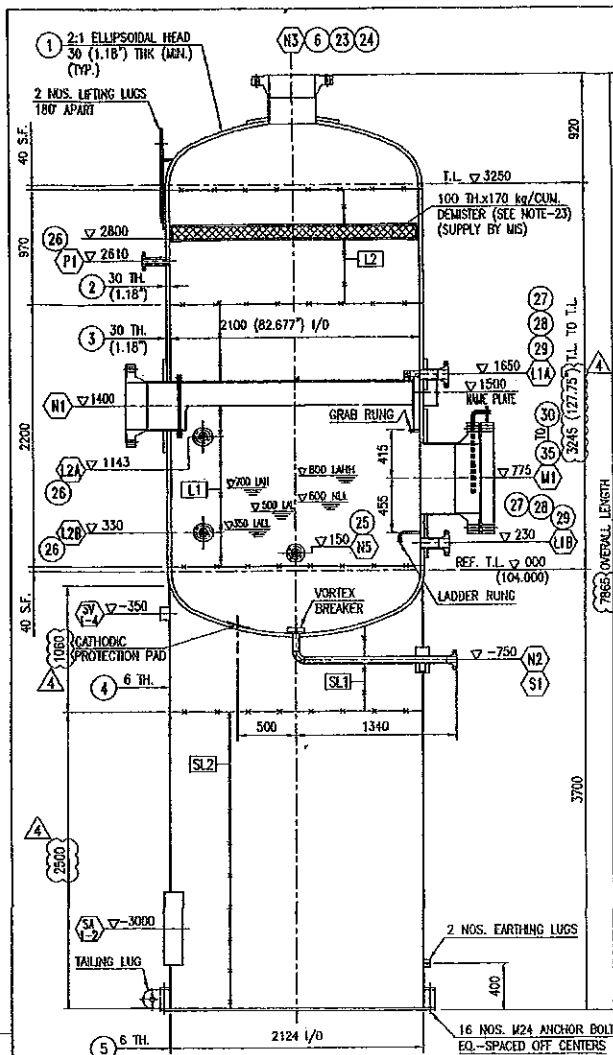


SECTIONAL ELEVATION

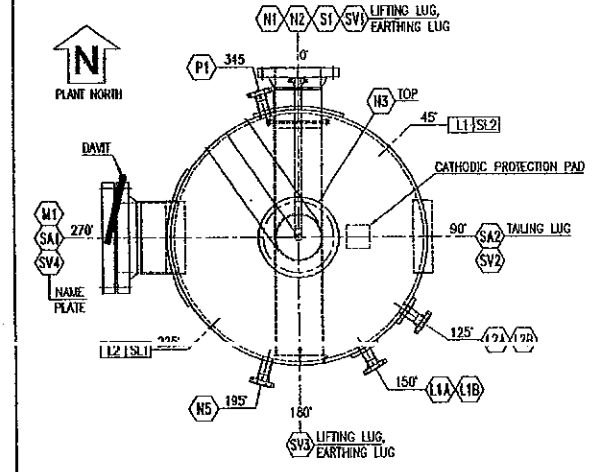


ORIENTATION PLAN

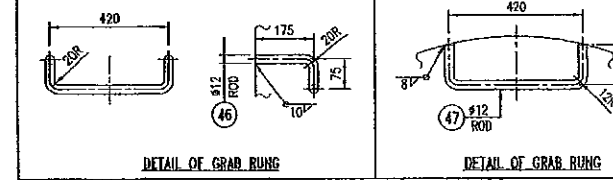


DETAIL OF GRAB RUNG

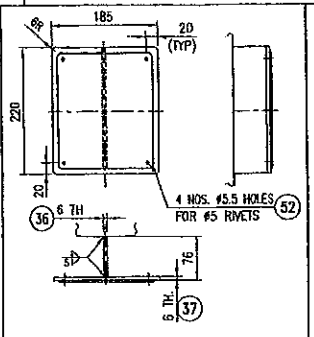


DETAIL OF NAME PLATE BRACKET

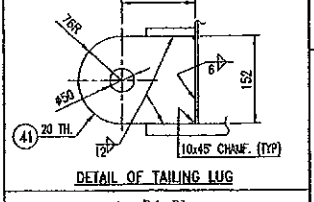


DETAIL OF TAILING LUG

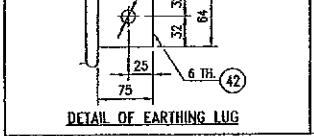


DETAIL OF EARTHING LUG

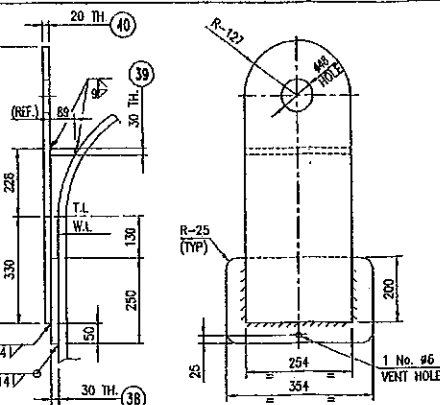


DETAIL OF LIFTING LUG

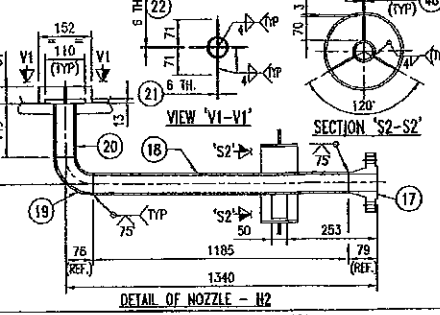


DETAIL OF NOZZLE - H2

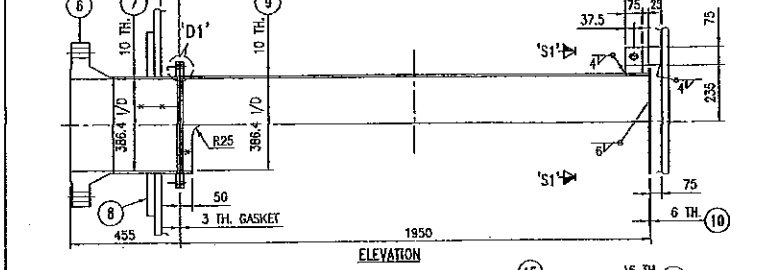


SECTION 'S1-S1'

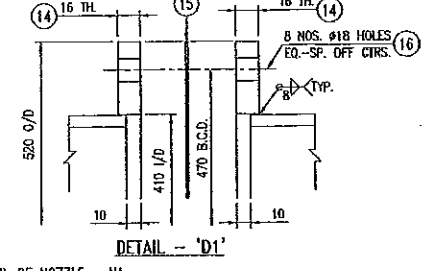


DETAIL - 'D1'

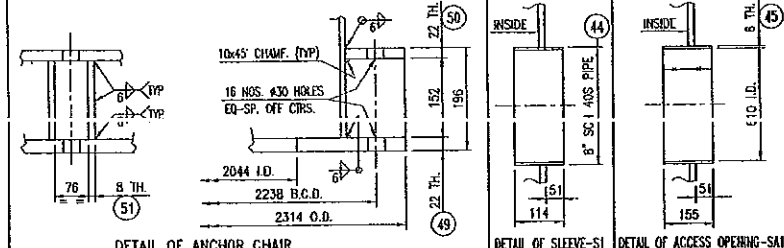


DETAIL OF NOZZLE - H1

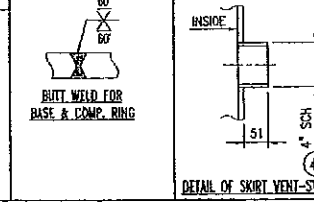

DETAIL OF ANCHOR CHAIR

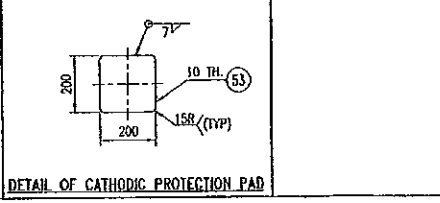

DETAIL OF SLEEVE - S1

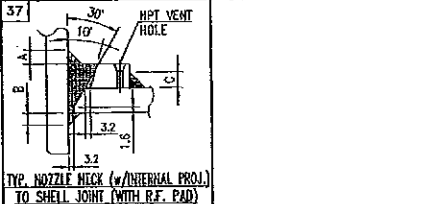

DETAIL OF ACCESS OPENING - SAI-2

GENERAL NOTES

1. THE VESSEL SHALL BE FABRICATED AS PER ASME SEC. VIII DIV. 1, ED. 2001.
2. ALL DIMENSIONS ARE IN MM & NOZZLE ELEVATIONS ARE FROM VAN LINE UNLESS OTHERWISE NOTED.
3. NOZZLE PROJECTIONS REFERRED FROM VESSEL CENTERLINE TO FLANGE CONTACT FACE.
4. FLANGE GASKET CONTACT SURFACE FINISH SHALL BE AS PER ASME B 16.5 TO SUIT GASKET, 3.2 TO 6.3 NO. (ISO 468).
5. NOZZLE BOLT HOLES SHALL STRADDLE PRINCIPAL CENTER LINES.
6. ALL NOZZLES RE PADS SHALL HAVE 1 NO. 1/4" NPT TEL-TALE HOLE FOR AIR TEST AT 30 MPa WITH SOAP SUDS. THE HOLE SHALL BE FILLED WITH HARD GREASE AFTER HYDROTEST.
7. ALL NOZZLES INSIDE EDGES EXCEPT NOZZLES WITH INSIDE PROJECTIONS SHALL BE FLUSHED WITH INTERNAL SURFACE OF VESSEL & ROUNDED OFF WITH 3 MM RADIUS.
8. ALL PRESSURE RETAINING WELDS TO BE FULL PENETRATION.
9. ALL INTERNAL WELDS SHALL BE CONTINUOUS FILLET WELDS.
10. WELDING & NOT PER WELD MAP NO. MS-4674-0408-V & QC INSPECTION PLAN.
11. [] INDICATES WELD SEAM NUMBER.
12. HYDROTEST SHALL BE CARRIED OUT IN HORIZONTAL POSITION USING POTABLE WATER WITH CHLORIDE CONTENT 50 PPM FOR 1 HR. 15 MINUTES. TEMPERATURE FOR HYDROTEST SHALL BE 17 C MINIMUM. AFTER TEST VESSEL SHALL BE FLUSHED WITH CLEAN WATER & SHALL BE THOROUGHLY DRIED & DRY.
13. THE VESSEL SHALL BE THOROUGHLY DRIED AND CLEANED INSIDE AND OUTSIDE. IT SHALL BE FREE FROM WELD SPATTER, SCALE, SLAG, RUST AND ANY FOREIGN MATTERS.
14. SERVICE GASKETS & BOLTINGS SHALL BE AS PER CODE AS WELL AS SABIC STD. DWG. NO. : Q01-F28 REV. 0.
15. THE FABRICATION TOLERANCES SHALL BE AS PER CODE AS WELL AS SABIC STD. DWG. NO. : Q01-F28 REV. 0.
16. FLANGED CONNECTIONS & ALL OTHER MACHINED SURFACES SHALL BE PROTECTED BY A COATING & FITTED WITH STEEL OR WOODEN COVER, 3 MM THK & NEOPRENE GASKET USING AT LEAST 4 BOLTS.
17. EXTERNAL S.S. SURFACE PREPARATION & PAINTING: AS PER SYSTEM S2 306 OF TECHNIP SPEC. 2121-00-JSD-2300-01, REV. 0.
18. EXTERNAL C.S. SURFACE PREPARATION & PAINTING: AS PER SYSTEM 'S1' OF TECHNIP SPEC. 2121-00-JSD-2300-01, REV. 0.
19. VESSEL COMPONENTS (SHELL, DISHED ENDS, NOZZLES, TOP S.S. SKIRT INTERNAL/EXTERNAL ETC.) SHALL BE PAINTED WITH: PRIMER - EPOXY WASHING - 125 MICRONS DFT. PAINTING: 2 COATS OF EPOXY PHENOLIC 150 MICRONS DFT. TOTAL DFT - 300 MICRONS.
20. EXTERNAL ATTACHMENT PADS SHALL HAVE 1 NO. 1/4" VENT HOLES & SHALL BE FILLED WITH HARD GREASE ONLY AFTER HYDROTEST.
21. MARKINGS ON VESSEL BEFORE SHIPMENT SHALL BE IN ACCORDANCE WITH SPECS. Q01-G01.
22. ALL REMOVABLE INTERIORS SHALL PASS THROUGH 500 MM LD UNMANNY.
23. THE STAINLESS STEEL OF THE CONTENTS SHALL BE IN ACCORDANCE WITH THIS SPECIFICATION.
24. THE INDICATED THICKNESS ARE THE MINIMUM ACCEPTABLE AFTER CONSTRUCTION.
25. DEMISTER TO BE KNIMESH TYPE 9032 OR EQUIVALENT.
26. THICKNESS: 100mm, FREE VOLUME: 97.90%, BULK DENSITY: 170 Kg/CUM, SURFACE AREA: 350 SQM/CUM MIN.
27. DEMISTER TO BE SUITABLE FOR THE FOLLOWING PROCESS CONDITION: DESIGN VAPOUR FLOWRATE: 145992 Kg/h LIQUID DENSITY: 980 Kg/CUM. MIN. OPERATING VAPOUR FLOWRATE: 79402 Kg/h MAX. ALLOWABLE PRESSURE DROP: 0.05 bar VAPOUR DENSITY: 25.5 Kg/CUM.
28. DEMISTER IS TO BE REMOVABLE FROM BELOW, AS PER STD. Q01-F34 FOR SUPPORT DETAILS.
29. FLUID COMPOSITION (mass %): VAPOUR: ETHANE 49.7, METHANE 21.8, NITROGEN 18.6, DIOXIDE 5.5, ETHYLENE 1.6, WATER 0.9, OXYGEN 0.4, ARGON 0.2, PROPANE 0.2, OTHERS 0.1. LIQUID: WATER 99.4, ACETIC ACID 0.5, OTHERS 0.1.
30. THE DRUM IS SUBJECT TO STEAM CUT AT 120°C AND 0.5 BAR.
31. MINIMUM DESIGN TEMPERATURE AT 9°C AT 31.6 BAR.
32. INSIDE SURFACE OF S.S. SHALL BE PICKLED AND PASSIVATED AS PER SPEC. 2121-00-JSD-3200-01.

PART NO.		QTY.	PART	DESCRIPTION	MATERIAL	REF. DWG. (MIS USE)	WT. (KGS.)
53	1		PAD PLATE	PLATE 10 TH. x 200 x 200	SA 240 GR. 304L	SEE DRG.	3
52	4		NAME PLATE	RIMCIS #5	SS	SEE DRG.	-
51	32		GUSSET	PLATE 8 TH. x 152 x 91	SA 516 GR. 70	SHOP DRG.	28
50	1		COMP. RING	PLATE 22 TH. x 2314 O/D x 2136 I/D	SA 516 GR. 70	SHOP DRG.	80
49	1		BASE RING	PLATE 22 TH. x 2314 O/D x 2044 I/D	SA 516 GR. 70	SHOP DRG.	147
48	3		NOZ. H2	FIN PLATE 6 TH. x 50 x 73 (CUT TO SUIT)	SA 240 GR. 304L	SEE DRG.	1
47	1		GRAB RUNG	ROD #12 x 553 LG.	SS 304L	SEE DRG.	2
46	1		LADDER RUNG	ROD #12 x 886 LG.	SS 304L	SEE DRG.	3
45	2		SKIRT ACCESS	FAB. PIPE PLT. 6 TH. x 155W x 1935	SA 516 GR. 70	SHOP DRG.	26
44	1		SLEEVE	PIPE 8" SCH 40S x 114 LG.	SA 312 TP 304L	SEE DRG.	3
43	4		SKIRT VENT	PIPE 4" SCH 40S x 59 LG.	SA 312 TP 304L	SEE DRG.	1
42	2		EARTHING LUG	PLATE 6 TH. x 64 x 75	SS	SEE DRG.	5
41	1		TAILING LUG	PLATE 20 TH. x 226 x 152	SA 516 GR. 70	SEE DRG.	5
40	2		LIFTING LUG	PLATE 20 TH. x 254 x 812	SA 516 GR. 70	SEE DRG.	11
39	2		LIFTING LUG	PLATE 30 TH. x 100 x 254 (CUT TO SUIT)	SA 240 GR. 304L	SEE DRG.	11

DESIGN CODE		ASME SEC. VIII, DIV. 1, ED. 2001	CODE STAMP	YES
INT. DESIGN SHELL	31.6 BARG (458.3 PSIG)		SERIAL NO.	152-10
DESIGN PRESSURE HEAD	31.6 BARG (458.3 PSIG)		YEAR BUILT	2003
DESIGN TEMPERATURE (EXT.)	0.5 BARG (7.25 PSIG) @ 120°C		OPERATING PRESSURE MAX.	21.4/25.4 BARG (313.3/369.4 PSIG)
MIN. DESIGN METAL TEMP.	9°C (48.2°F)		WAMP (H&C)	32.21 BARG (467.2 PSIG)
CORROSION ALLOWANCE	NIL		WAMP (H&C)	32.34 BARG (468.1 PSIG)
IMPACT TEST	NO		HYDROTEST SITE	41.87 BARG (607.3 PSIG)
RADIOGRAPHY	RT-1		FIRE PROOFING	YES (50 mm BY OTHERS)
JOINT EFFICIENCY	1.0		INSULATION	NO
P.W.N.T.	NO		MAX. OPER. STATIC HEAD	0.85m
MAX. OPER. STATIC HEAD	0.85m		CYCLOC/SOUR/AETNAL SERVICE	NO / NO / NO
EARTH QUAKE	UBC-ZONE 2A		EXTERNAL PAINT	YES (SEE NOTE-17)
WIND SPEED	38.9 m/s (ASCE-7)		INTERNAL COATING	NO
INSPECTION	A1		OPERATING MEDIUM	SEE NOTE-24
WEIGHTS			SPECIFIC GRAVITY OF LIQUID	0.98
HYDROTEST	28800 KGS.		HAZARD CONSIDERATION	FLAMMABLE
OPERATING	18100 KGS.		NORMAL CAPACITY	13.68 CUM.

MATERIAL OF CONSTRUCTION		INTERVALS	SS 304L
SHELL	SA 240 GR. 304L	INTERNAL PIPE	SA 240 GR. 304L
HEAD	SA 240 GR. 304L	EXTERNAL ATTACH: SA 240 GR. 304L/SA 516 GR. 70	
FLANGES	SA 182 F 304L	BOLTING EXTERNAL: A 193 GR B7A 194 GR 2H	
PIPE	SA 312 TP 304L (SUS)	BOLTING INTERNAL: SA 304L	
FAB. PIPE	SA 240 GR. 304L	GASKETS (EXT.)	SS 316L W/FLUO. SS 316L INNER RING & C.S. OVER RING
TOP SKIRT	SA 240 GR. 304L	GASKETS (INT.)	N/A
BOTTOM SKIRT	SA 516 GR. 70	FITTINGS	SA 403 WP 304L
ANCHOR CHAIR, BASE/COMP. PLT.	SA 516 GR. 70		
INTERNAL ATTACHMENTS	SS 304L		

BILL OF MATERIAL Contd....		SA 240 GR. 304L	SEE DRG.	42
38	2	LIFTING LUG	PAD PLATE 30 TH. x 250 x 354	
37	1	NAME PLATE	PLATE 6 TH. x 185 x 220	
36	1	NAME PLATE	PLATE 6 TH. x 220 x 50	
35	24+3	WANNWAY-WI	STUD #1 7/8" x 13" LG. W/2 HEX NUTS	
34	1+2	WANNWAY-WI	GASKET SPIRAL WOUND 24" 600# RF	
33	1	WANNWAY-WI	BLIND FLANGE 24" 600# RFS ASME B16.5	
32	1	WANNWAY-WI	R.F. PAD PLATE 30 TH. x 1170 O/D x 622 I/D	
31	1	WANNWAY-WI	FAB. PIPE 10 TH. x 326W x 1885	
30	1	WANNWAY-WI	FLANGE 24" WN 600# RFS ASME B16.5 (4380 BORE)	
29	2	NOZ. L1A/B	R.F. PAD PLATE 30 TH. x 270 O/D x 102 I/D	
28	2	NOZ. L1A/B	PIPE 3" SCH 40S x 147 LG.	
27	2	NOZ. L1A/B	FLANGE 3" WN 600# RFS ASME B16.5 (SCH 40S BORE)	
26	3	NOZ. P12A/B	FLANGE 1 1/2" WN 600# RFS x 237 LG. ASME B16.5	
25	1	NOZ. H5	FLANGE 1" WN 600# RFS x 236 LG. ASME B16.5	
24	1	NOZ. H3	R.F. PAD PLATE 30 TH. x 755 O/D x 414 I/D	
23	1	NOZ. H3	FAB. PIPE 10 TH. x 222W x 1245 LG.	
22	2	VORTEX BREAKER	PLATE 6 TH. x 51 x 73	
21	1	VORTEX BREAKER	PLATE 6 TH. x 51 x 152	
20	1	NOZ. H2	PIPE 2" SCH 80S x 149 LG.	
19	1	NOZ. H2	ELBOW 2" SCH 80S 90°-LR. ASME B16.9	
18	1	NOZ. H2	PIPE 2" SCH 80S x 1185 LG.	
17	1	NOZ. H2	FLANGE 2" WN 600# RFS ASME B16.5 (SCH 80S BORE)	
16	8	NOZ. H1	HEX. BOLT M16 x 55 LG. W/1 HEX. NUT	
15	1	NOZ. H1	GASKET 3 TH. x 520 O/D x 410 I/D	
14	2	NOZ. H1	PLATE FLANGE 16 TH. x 520 O/D x 410 I/D	
13	1	NOZ. H1	HEX. BOLT M16 x 55 LG. W/1 HEX. NUT	
12	1	NOZ. H1	PLATE 6 TH. x 75 x 107	
11	1	NOZ. H1	PLATE 6 TH. x 75 x 181	
10	1	NOZ. H1	PLATE 6 TH. x 440	
9	1	NOZ. H1	FAB. PIPE 10 TH. x 1245W x 1834 LG.	
8	1	NOZ. H1	R.F. PAD PLATE 30 TH. x 770 O/D x 414 I/D	
7	1	NOZ. H1	FAB. PIPE 10 TH. x 286W x 1245 LG.	
6	2	NOZ. H1A3	FLANGE 16" WN 600# RFS ASME B16.5 (4380 BORE)	
5	1	SKIRT	PLATE 6 TH. x 2500W x 6892 LG.	
4	1	SKIRT	PLATE 6 TH. x 1110W x 6892 LG. (ALLOWANCE ADDED)	
3	1	SHELL	PLATE 30 TH. x 2200W x 6892 LG.	
2	1	SHELL	PLATE 30 TH. x 970W x 6892 LG.	
1	2	HEAD	2:1 ELLIPSOIDAL HEAD 2100 I/D x 30 TH. (WN)	

TECHNIP-COFLUX		VENUE DOCUMENT REVIEW		ASME NAT'L. BOARD No. 19 4	
ITALY: SABC ACETIC ACID PROJECT CLIENT NAME: YAMBO - KINGDOM OF SAUDI ARABIA		☐ REVIEW AND REVISION ☐ TO BE ISSUED AS FINAL PROVIDED COMMENTS ARE INCORPORATED ☐ NO COMMENT - FINAL ISSUE			
MATERIAL RECEIPT No. 2121 MR <u>10/01/11/01/21</u> ITEM: 100 - D211		☐ FOR INFORMATION ONLY (EXTERNAL USES)			
SR Doc. Code: A1103		U.O.: TECHNIP ITALY S.p.A. BY: _____ DATE: _____			
4	12.07.03	AS BUILT			SAB <i>[Signature]</i>
3	07.04.03	REVISED AS MARKED.			RO PL/MHD
2	18.03.03	REVISED AS MARKED.			SNK PL/MHD
1	09.02.03	REVISED AS MARKED.			SNK PL/MHD
0	04.01.03	ISSUED FOR CONSTRUCTION & REVISED AS MARKED.			SNK PL/MHD
A	16.11.02	ISSUED FOR CLIENT'S APPROVAL.			SNK PL/MHD
REV	DATE	DESCRIPTION			BY CHKD/APPD

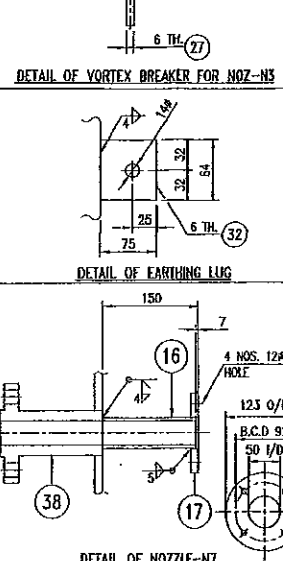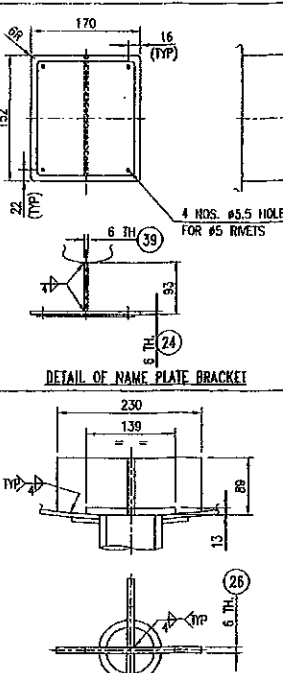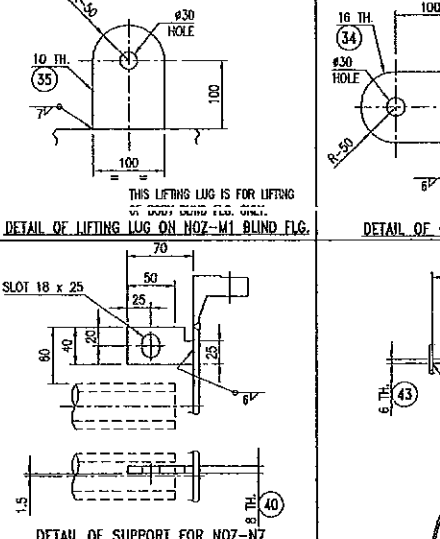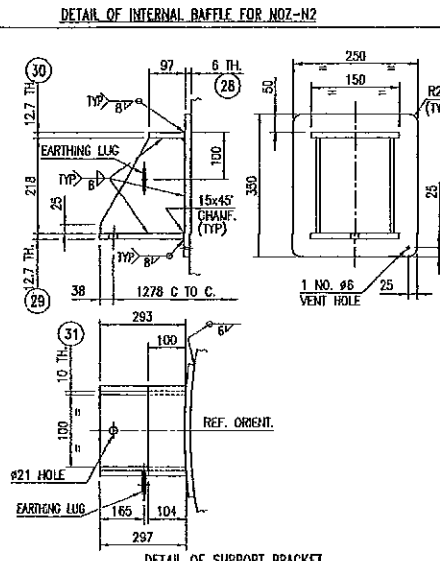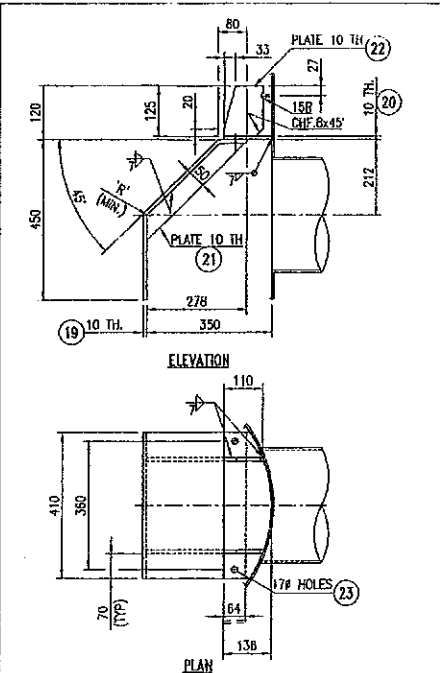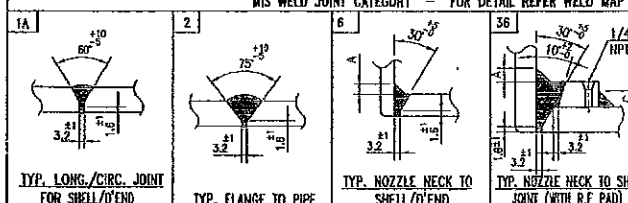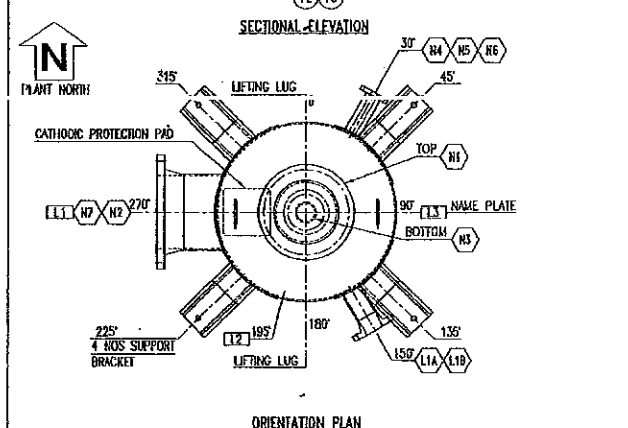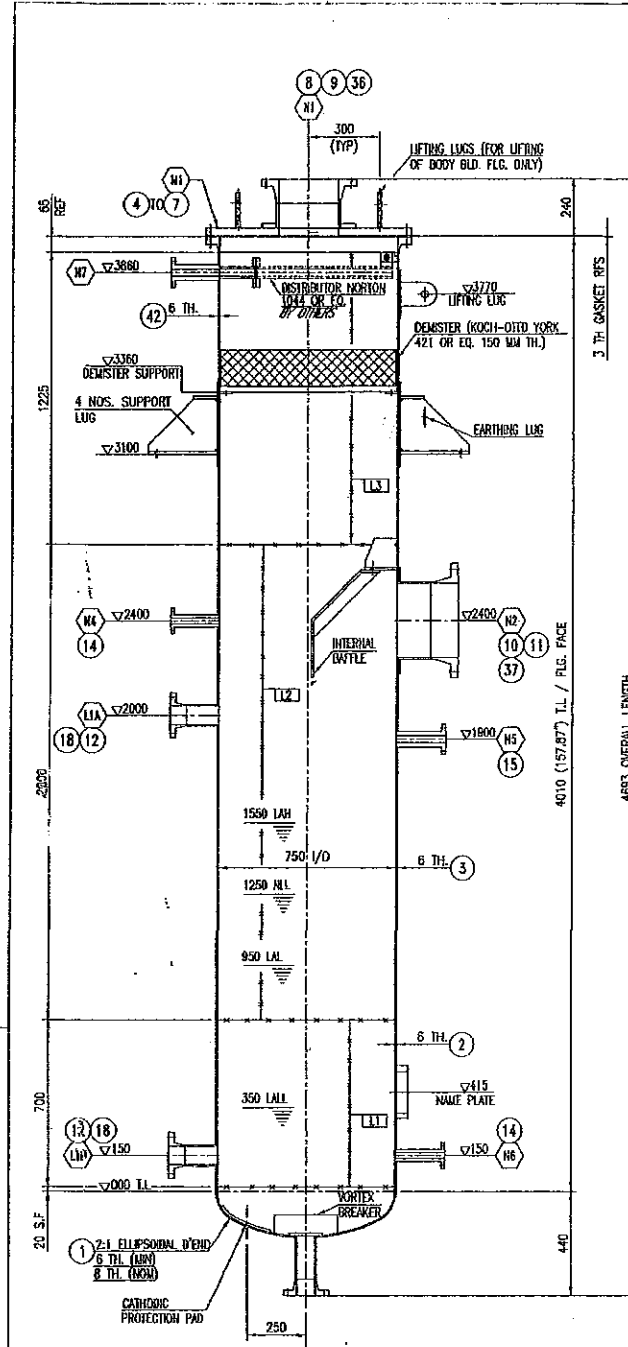



























GENERAL NOTES


- THE VESSEL SHALL BE FABRICATED AS PER ASME SEC. VIII DIV. 1, ED. 2001.
- ALL DIMENSIONS ARE IN MM & NOZZLE ELEVATIONS ARE FROM TAN LINE UNLESS OTHERWISE NOTED.
- NOZZLE PROJECTIONS REFERRED FROM VESSEL CENTERLINE TO FLANGE CONTACT FACE.
- FLANGE GASKET CONTACT SURFACE FINISH SHALL BE AS PER ASME B 16.5 TO SUIT GASKET, 3.2 TO 6.4 RFS & 6.4 TO 12.5 FOR RF.
- NOZZLE BOLT HOLES SHALL STRADDLE PRINCIPAL CENTER LINES.
- ALL NOZZLES RF PADS SHALL HAVE 1 NO. 1/4" NPT TAIL-HOLE FOR AIR TEST AT 30 KPA WITH SOAP SUDS.
- THE HOLE SHALL BE FILLED WITH HARD GREASE AFTER HYDROTEST.
- ALL NOZZLES INSIDE EDGES EXCEPT NOZZLES WITH INSIDE PROJECTIONS SHALL BE FLUSHED WITH INTERNAL SURFACE OF VESSEL & ROUNDED OFF WITH 3 MM RADIUS.
- ALL PRESSURE RETAINING WELDS TO BE FULL PENETRATION.
- ALL INTERNAL WELDS SHALL BE CONTINUOUS FILLET WELDS.
- WELDING & NOT PER WELD MAP NO. MIS-4674-M014-V & QC INSPECTION PLAN.
- INDICATES WELD SEAM NUMBER.
- HYDROTEST SHALL BE CARRIED OUT IN HORIZONTAL POSITION USING POTABLE WATER WITH CHLORIDE CONTENT NOT EXCEEDING 50 PPM MAX. FOR 1 HR. TEMPERATURE FOR HYDROTEST SHALL BE 17 C MINIMUM.
- AFTER TEST VESSEL SHALL BE FLUSHED WITH CLEAN WATER & SHALL BE THOROUGHLY DRIED & DRIED.
- THE VESSEL SHALL BE THOROUGHLY DRIED AND CLEANED INSIDE AND OUTSIDE. IT SHALL BE FREE FROM WELD SPATTER, SCALE, SLAG, RUST AND ANY FOREIGN MATTERS.
- THE FABRICATION TOLERANCES SHALL BE AS PER CODE AS WELL AS SABC STD. DWS. NO. : Q01-F28 REV. D
- FLANGED CONNECTIONS & ALL OTHER MACHINED SURFACES SHALL BE PROTECTED BY A COATING & FITTED WITH STEEL OR WOODEN COVER, 3 MM THK & NEOPRENE GASKET USING AT LEAST 4 BOLTS.
- EXTERNAL S.S. SURFACE PREPARATION & PAINTING : AS PER SYSTEM S2 306 OF TECHNIP SPEC. 2121-00-JSD-2300-01 - VESSEL COMPONENTS (SHELL, DISHED ENDS, NOZZLES ETC.)
ALL EXTERNAL S.S. SURFACES PREPARATION SHALL BE AS PER - SSPC SP 7.
PAINTING : 2 COATS OF EPOXY PHENOLIC 150 MICRONS DFT.
TOTAL DFT - 300 MICRONS
EXTERNAL C.S. SURFACE PREPARATION & PAINTING : AS PER SYSTEM 'S1' OF SPEC. 2121-00-JSD 2300-01
- SUPPORT BRACKET, EXTERNAL ATTACHMENT ETC.
ALL EXTERNAL C.S. SURFACES SHALL BE GRIT BLASTED AS PER - SA 2 1/2 OR SSPC-SP6
PAINTING : PRIMER - EPOXY MASTIC 125 MICRONS
TOP COAT - POLYURETHANE ENAMEL (ALPHATIC) 50 MICRONS
TOTAL DFT - 175 MICRONS
- EXTERNAL ATTACHMENT PADS SHALL HAVE 1 NO. #6 VENT HOLES & SHALL BE FILLED WITH HARD GREASE ONLY AFTER HYDROTEST.
- MARKINGS ON VESSEL BEFORE SHIPMENT SHALL BE IN ACCORDANCE WITH SPEC. 001-G01.
- ALL REMOVABLE INTERNALS SHALL PASS THROUGH 750 MM I.D. BODY FLANGE.
- THE INDICATED THICKNESS ARE THE MINIMUM ACCEPTABLE AFTER CONSTRUCTION.
- THE STATIC PRESSURE OF THE CONTENT SHALL BE ADDED TO THIS PRESSURE.
- FLUID COMPOSITION (max):
VAPOUR: ETHANE 0.5, METHANE 0.2, NITROGEN 0.5, CARBON DIOXIDE 79.7, WATER 10.3 LIQUID WATER 100.0
- STATIC HEAD SHALL ADD TO DESIGN PRESSURE.
- INSIDE SURFACE OF S.S. SHALL BE PICKLED AND PASSIVATED AS PER SPEC. 2121-00-JSD-3200-01

BILL OF MATERIAL				TOTAL WT.	
PART NO.	QTY.	PART	DESCRIPTION	MATERIAL	WT. (KGS.)
43	1	DEMISTER SUPPORT	PAD PLATE 6 TH. x 750 O/D x 650 I/D	SA 240 GR 304L	1122
42	1	SHELL	PLATE 6 TH. x 1225W x 2375 LG.	SA 240 GR 304L (G5)	5
41	1	PAD PLATE	PLATE 10 TH. x 200 x 200	SA 240 GR 304L	137




BILL OF MATERIAL (BOM IS FOR 1 NO. EQUIP.)									
* RFS STANDS FOR RAISED FACE SMOOTH FINISH 3.2-6.3 R _a . * RF STANDS FOR RAISED FACE SMOOTH FINISH 6.4-12.5 R _a									
ITEM	QTY.	SIZE	SCH/THK	RATING	TYPE	FACE	IN	OUT	SERVICE
N1	1	30"	75	WN	RFS	-	SEE DWS	SEE DWS	BODY FLANGE
N2	1	3"	SCH 40S	150	WN	RFS	-	-	LEVEL BRIDLE
N3	1	3"	SCH 40S	150	WN	RFS	-	-	LEVEL BRIDLE
N4	1	1 1/2"	14.2 TH.	150	WN	RFS	SEE DWS	SEE DWS	DEMISTER WASHING
N5	1	1 1/2"	14.2 TH.	150	WN	RFS	SEE DWS	SEE DWS	UTILITY CONNECTION
N6	1	1"	12.7 TH.	150	WN	RFS	SEE DWS	SEE DWS	DEMISTER WASHING
N7	1	1"	12.7 TH.	150	WN	RFS	SEE DWS	SEE DWS	UTILITY CONNECTION
N8	1	1"	12.7 TH.	150	WN	RFS	SEE DWS	SEE DWS	DEMISTER WASHING
N9	1	1"	12.7 TH.	150	WN	RFS	SEE DWS	SEE DWS	UTILITY CONNECTION
N10	1	1"	12.7 TH.	150	WN	RFS	SEE DWS	SEE DWS	DEMISTER WASHING
N11	1	1"	12.7 TH.	150	WN	RFS	SEE DWS	SEE DWS	UTILITY CONNECTION
N12	1	12"	6 TH.	150	WN	RFS	SEE DWS	SEE DWS	VAPOR / LIQUID INLET
N13	1	10"	SCH 40S	150	WN	RFS	SEE DWS	SEE DWS	VAPOR OUTLET
N14	1	10"	SCH 40S	150	WN	RFS	SEE DWS	SEE DWS	VAPOR OUTLET
NOZZLE SCHEDULE				REMARKS	
NOZZLE	QTY.	SIZE	SCH/THK	RATING	TYPE
001-001	1	30"	75	WN	RFS
001-002	1	3"	SCH 40S	150	WN
001-003	1	3"	SCH 40S	150	WN
001-004	1	1 1/2"	14.2 TH.	150	WN
001-005	1	1 1/2"	14.2 TH.	150	WN
001-006	1	1"	12.7 TH.	150	WN
001-007	1	1"	12.7 TH.	150	WN
001-008	1	1"	12.7 TH.	150	WN
001-009	1	1"	12.7 TH.	150	WN
001-010	1	1"	12.7 TH.	150	WN
001-011	1	12"	6 TH.	150	WN
001-012	1	10"	SCH 40S	150	WN
001-013	1	10"	SCH 40S	150	WN
001-014	1	10"	SCH 40S	150	WN
001-232	1	10"	SCH 40S	150	WN
001-233	1				

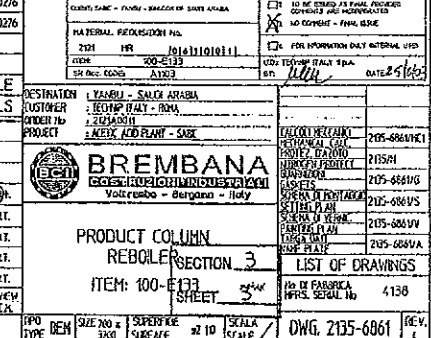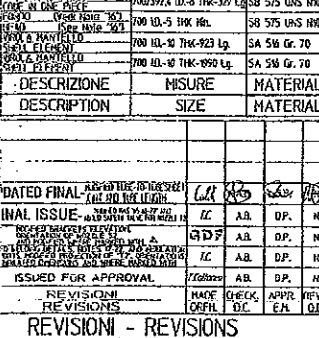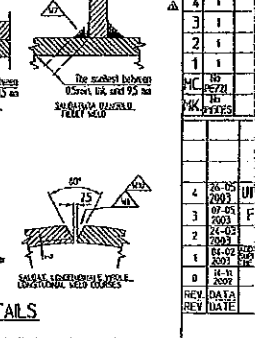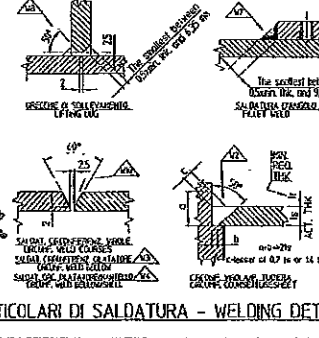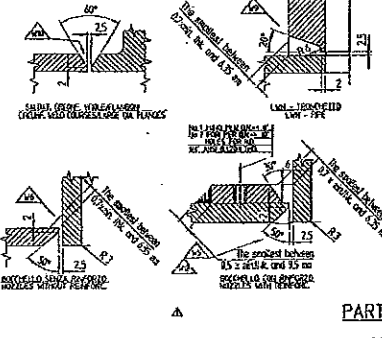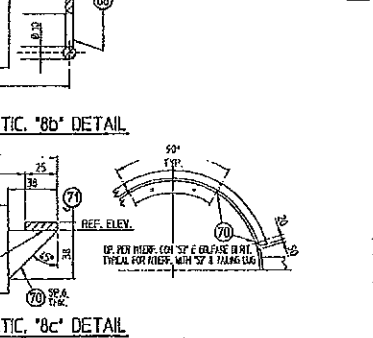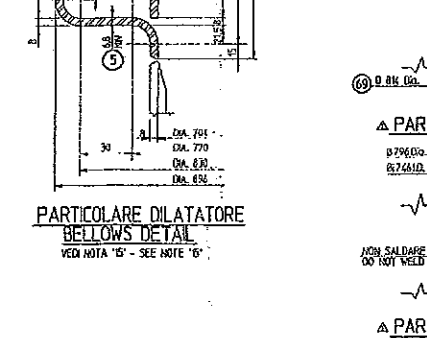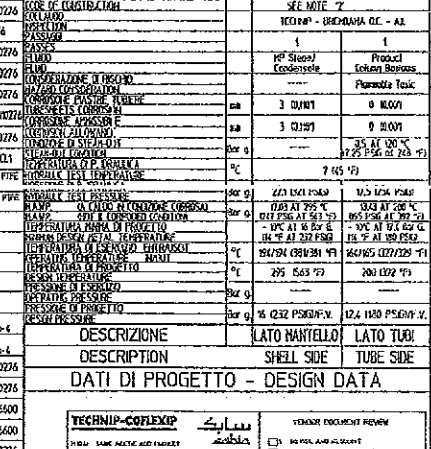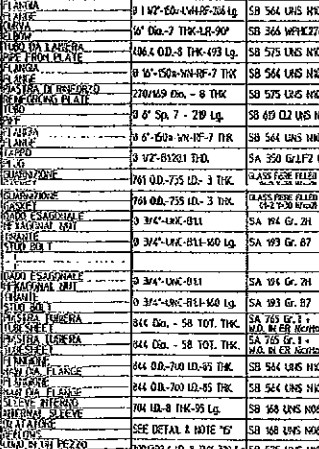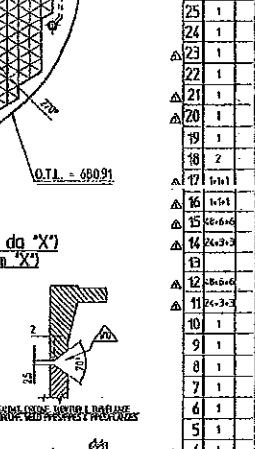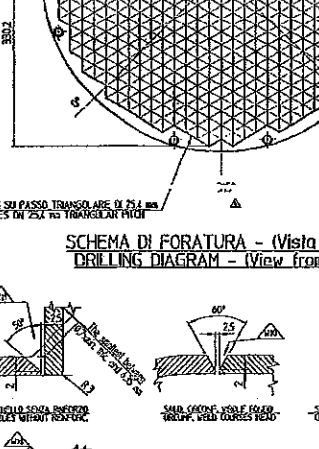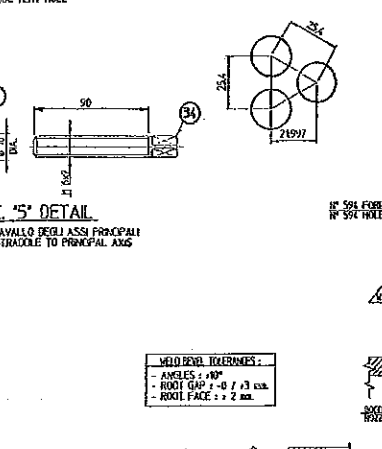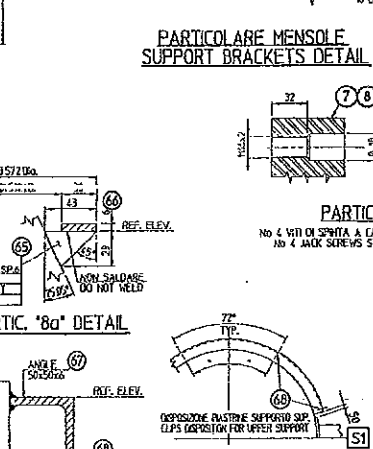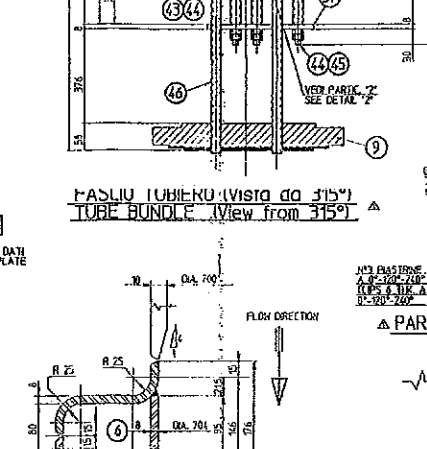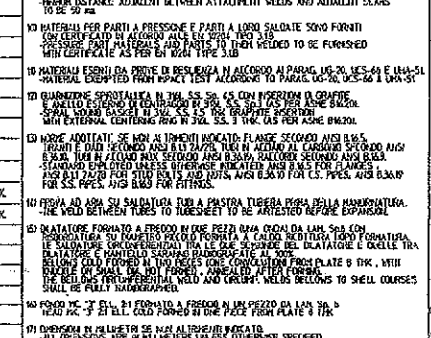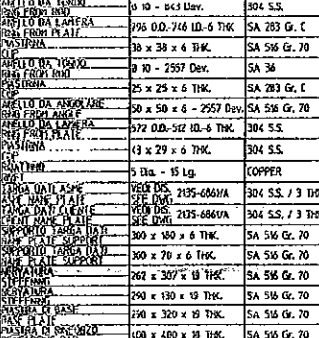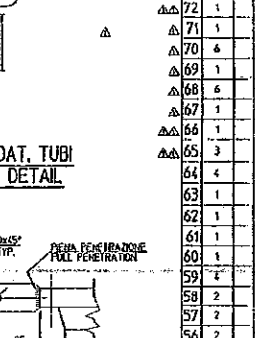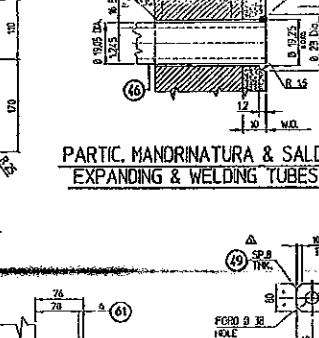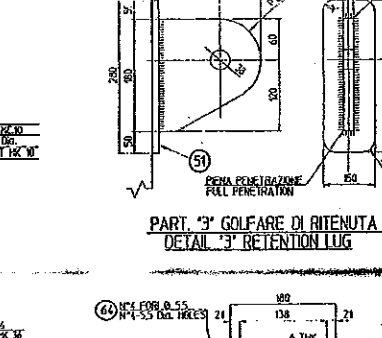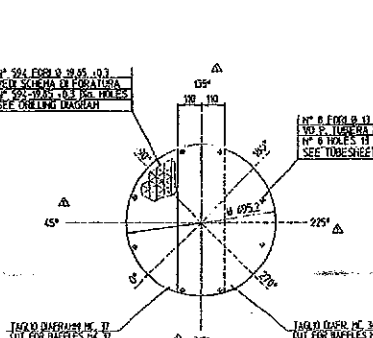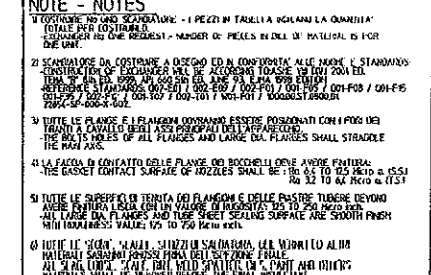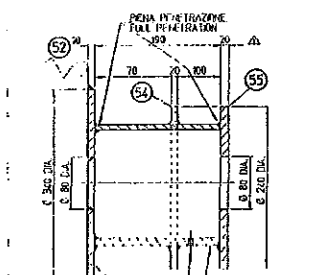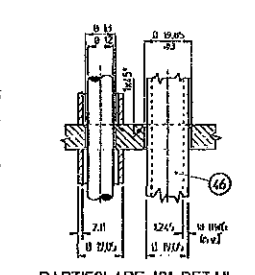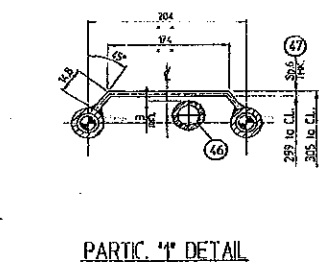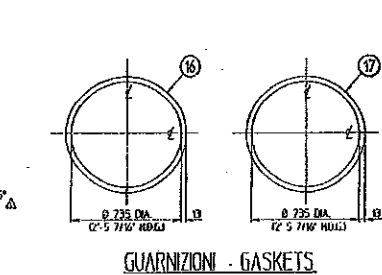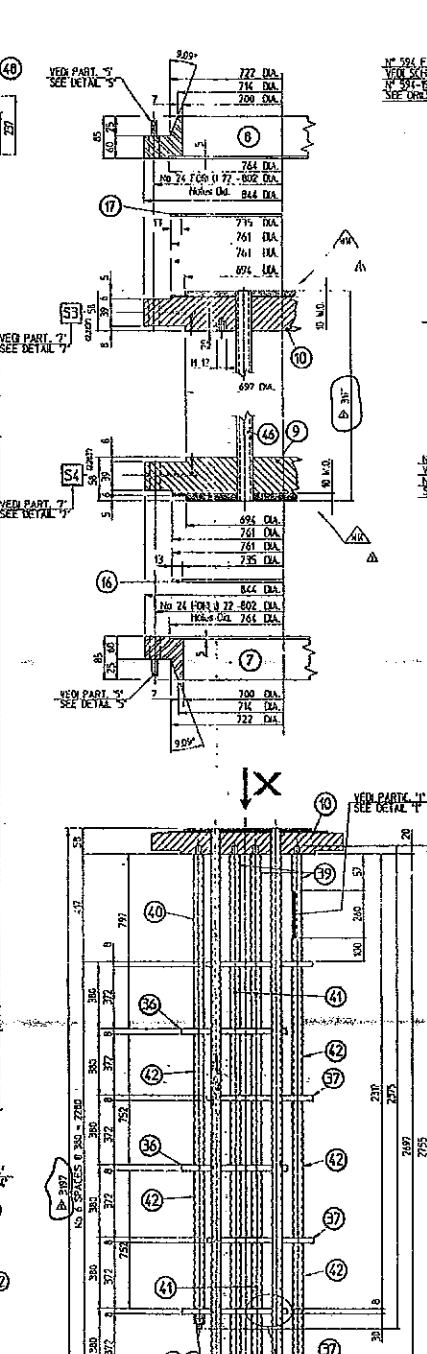

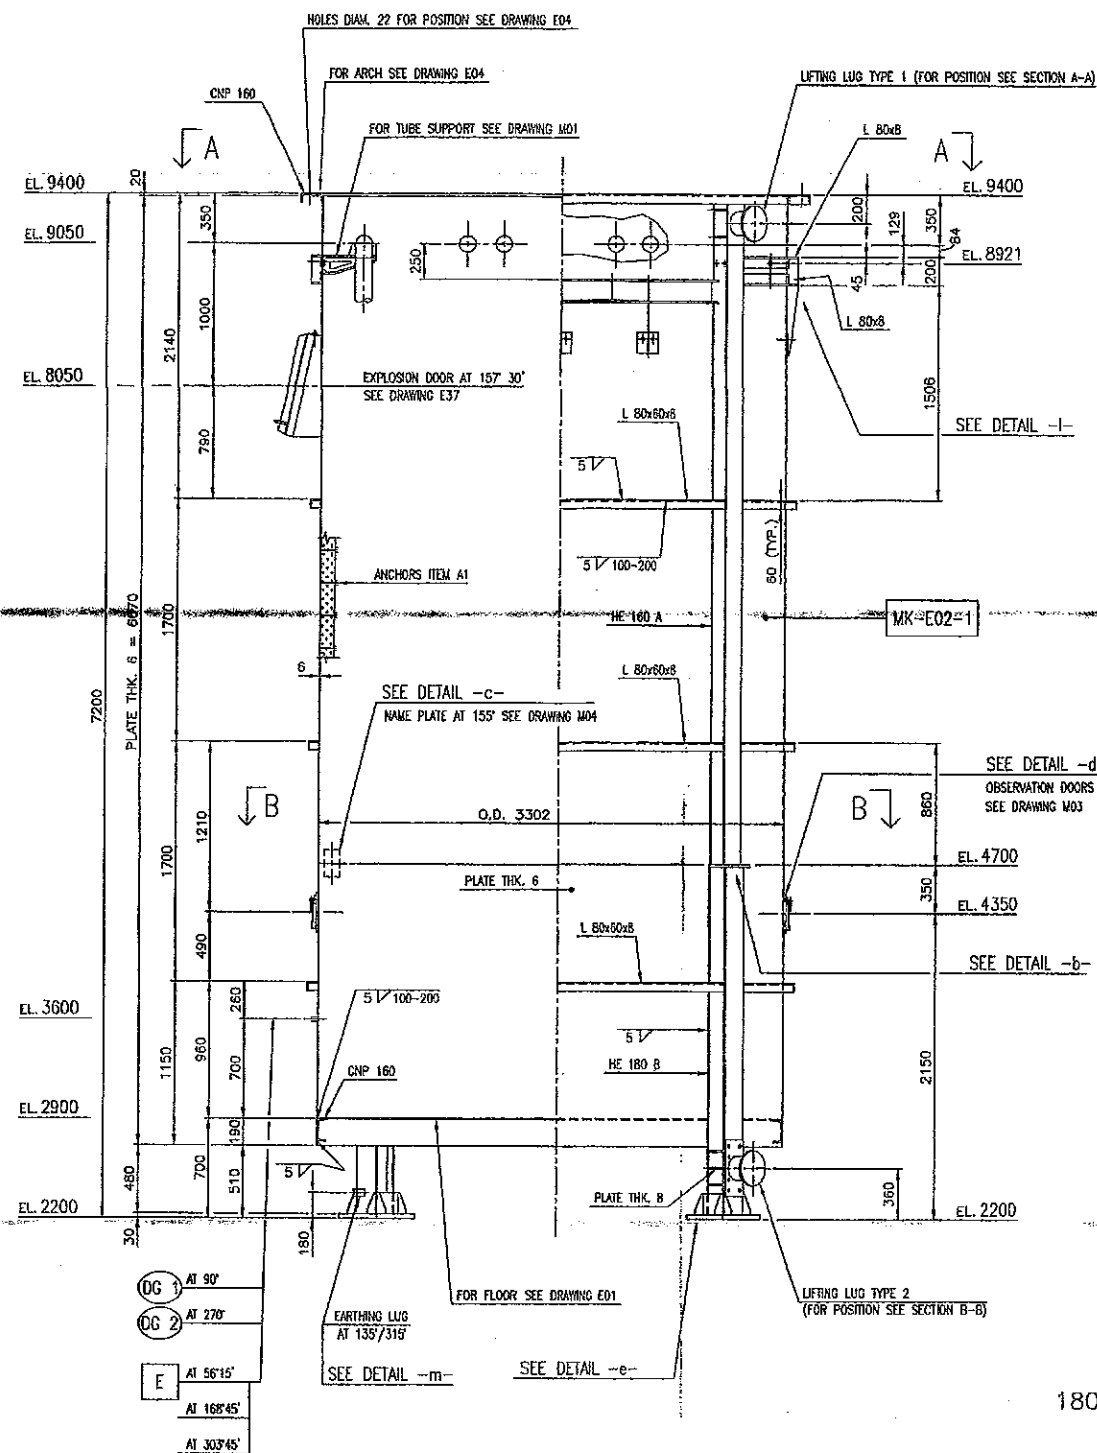

1/2 VIEW 1/2 SECTION FROM 90°

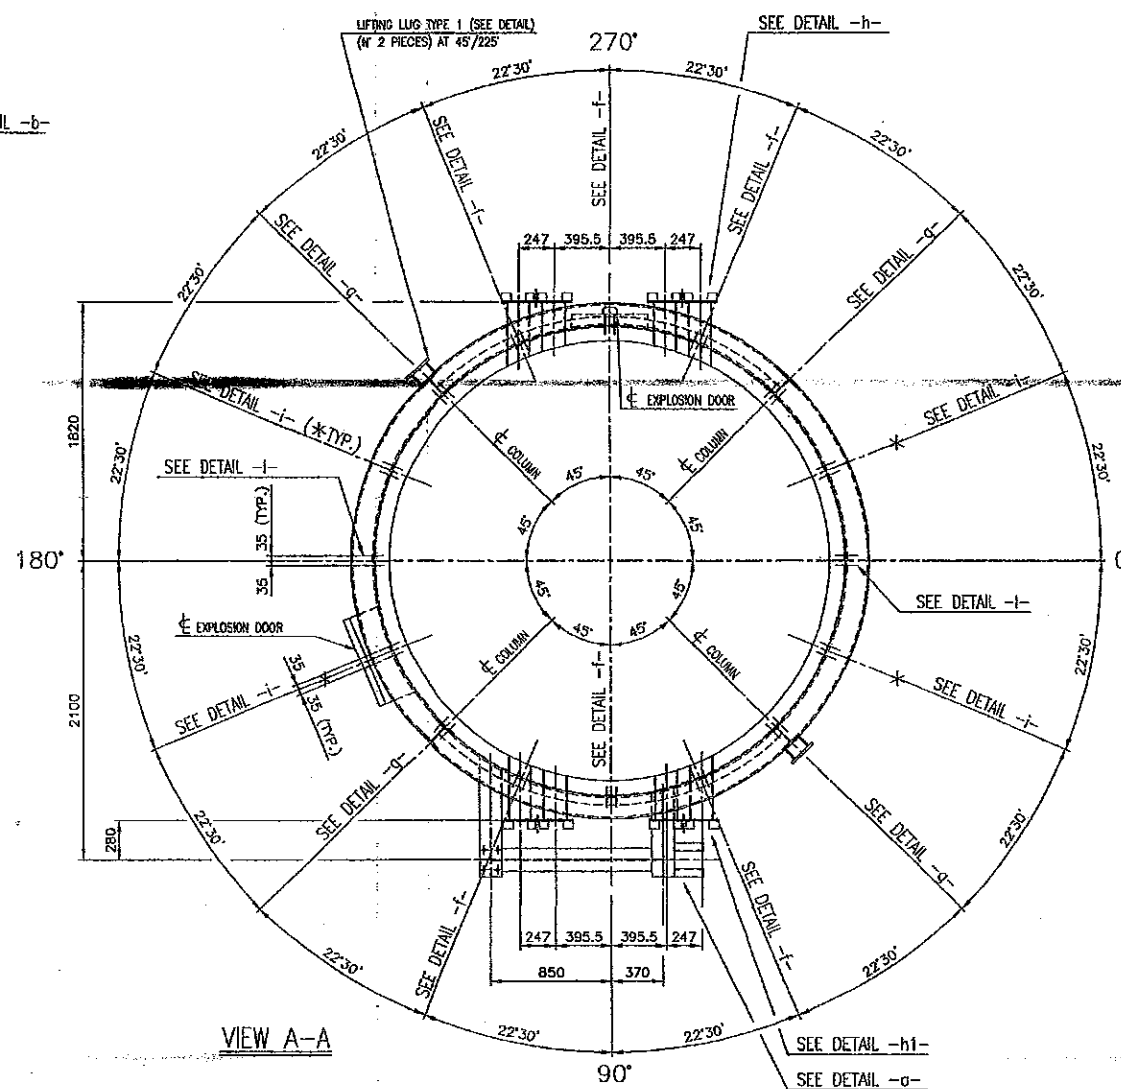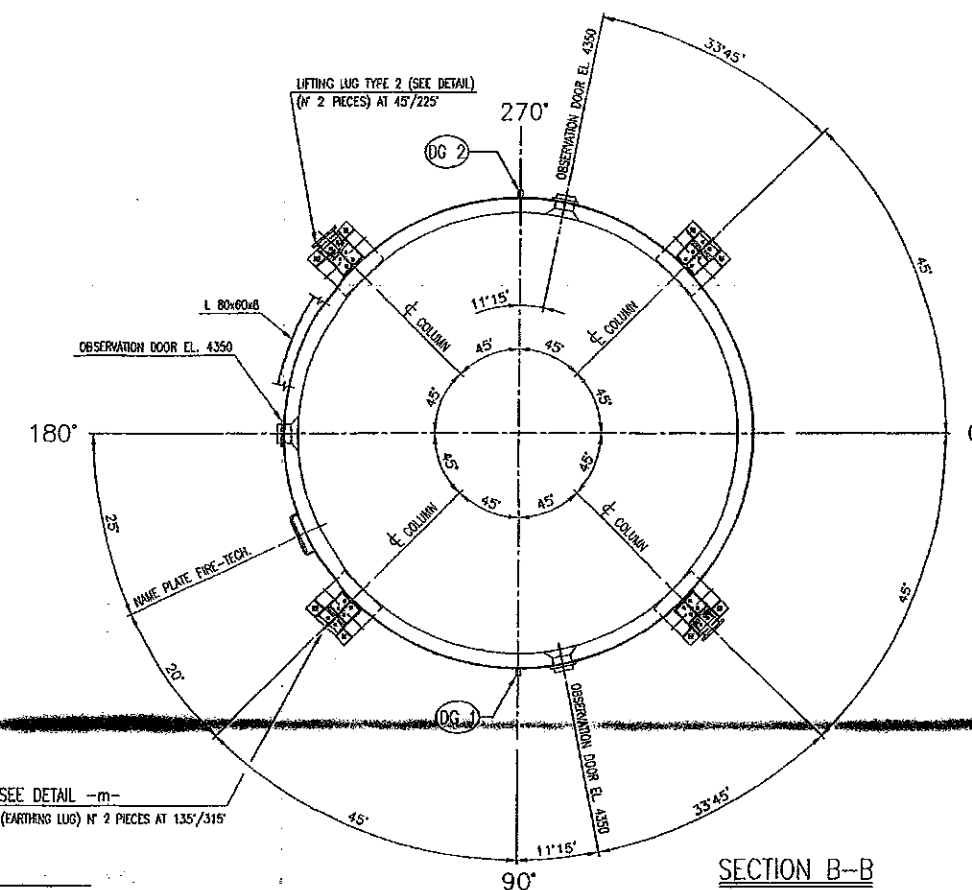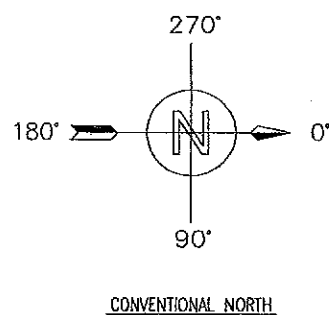

- INSULATION ANCHORS WILL BE WELDED IN SHOP
- LINING APPLICATION WILL BE IN SHOP

GENERAL NOTES:

- 1) FOR GENERAL ARRANGEMENT SEE DRAWINGS B01 / B02
- 2) FOR RADIANT SECTION (DETAILS) SEE DRAWING E03
- 3) FOR RADIANT SUPPORT FOR TUBE NO 3 1/2" SEE DRAWING M01
- 4) FOR INSULATION ANCHORS SEE DRAWING M02
- 5) FOR OBSERVATION DOOR SEE DRAWING B03
- 6) FOR NAME PLATE SEE DRAWING M04
- 7) FOR FLOOR SEE DRAWING E01
- 8) FOR ARCH SEE DRAWING E04
- 9) FOR EXPLOSION DOOR SEE DRAWING E37
- 10) FOR INSTRUMENT CONNECTION SEE DRAWING E50
- 11) FOR GENERAL NOTES FOR STEELWORK SEE SPECIFICATION E65
- 12) FOR LIST OF MARKS SEE SPECIFICATION E60
- 13) FOR LIST OF BOLTS FOR ERECTION SEE SPECIFICATION E61

TECHNIP-COFLUX		س.ا.ف.ك		VENDOR DOCUMENT REVIEW	
PROJ: SABIC ACETIC ACID PROJECT		SABIC		☐ 1. REVISE AND RESUBMIT ☐ 2. TO BE ISSUED AS FINAL PROVIDED COMMENTS ARE INCORPORATED ☒ 3. NO COMMENT - FINAL ISSUE ☐ 4. FOR INFORMATION ONLY (OPTIONAL USE)	
CLIENT: SABIC - YAMBU - KINGDOM OF SAUDI ARABIA		MATERIAL REQUISITION No.		U.O.C. TECHNIP ITALY S.p.A.	
2121 MR 1011101011		ITEM: 100-H-181		BY: <i>Quarrell</i> DATE: 5/2/03	
BR Doc. CODE: A 2001					

REV.	DATE	DESCRIPTION	DRAWN	CHECKED	APPROV.
2	14/07/03	AS BUILT	O. FELIS	CI	C. Beneditt.
1	15/02/03	ISSUED FOR CONSTRUCTION	A.E. FAHRESE		C. Beneditt.
0	16/01/03	ISSUED FOR APPROVAL	A.E. FAHRESE		C. Beneditt.

FIRE-TECH. ENGINEERING S.r.l.		This drawing and information are property of FIRE-TECH Engineering s.r.l. and are not to be reproduced, copied, lent or exhibited without written permission.	
TECHNIP FOR SABIC-SAUDI ARABIA		SCALE: 1:25	
SABIC ACETIC ACID PROJECT		NAME FILE: C336-02-401-A1-R2	
STEAM FIRED HEATER ITEM 100-H181		DRAWING No.	
RADIANT SECTION (ASSEMBLY)		1002-R-A1-E02	
		REV. 2	

C336-02-401-A1-R1

