
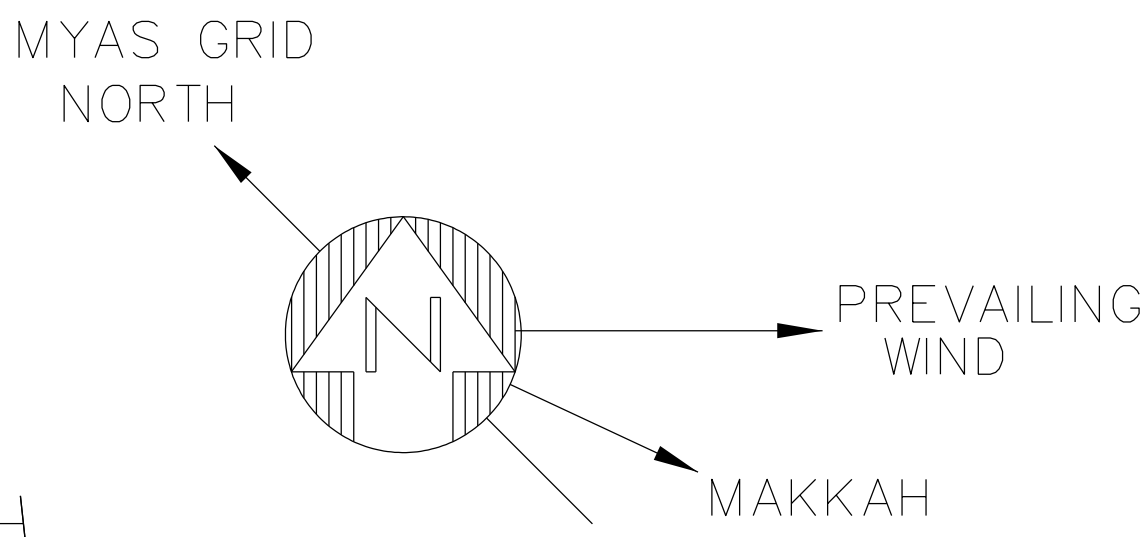


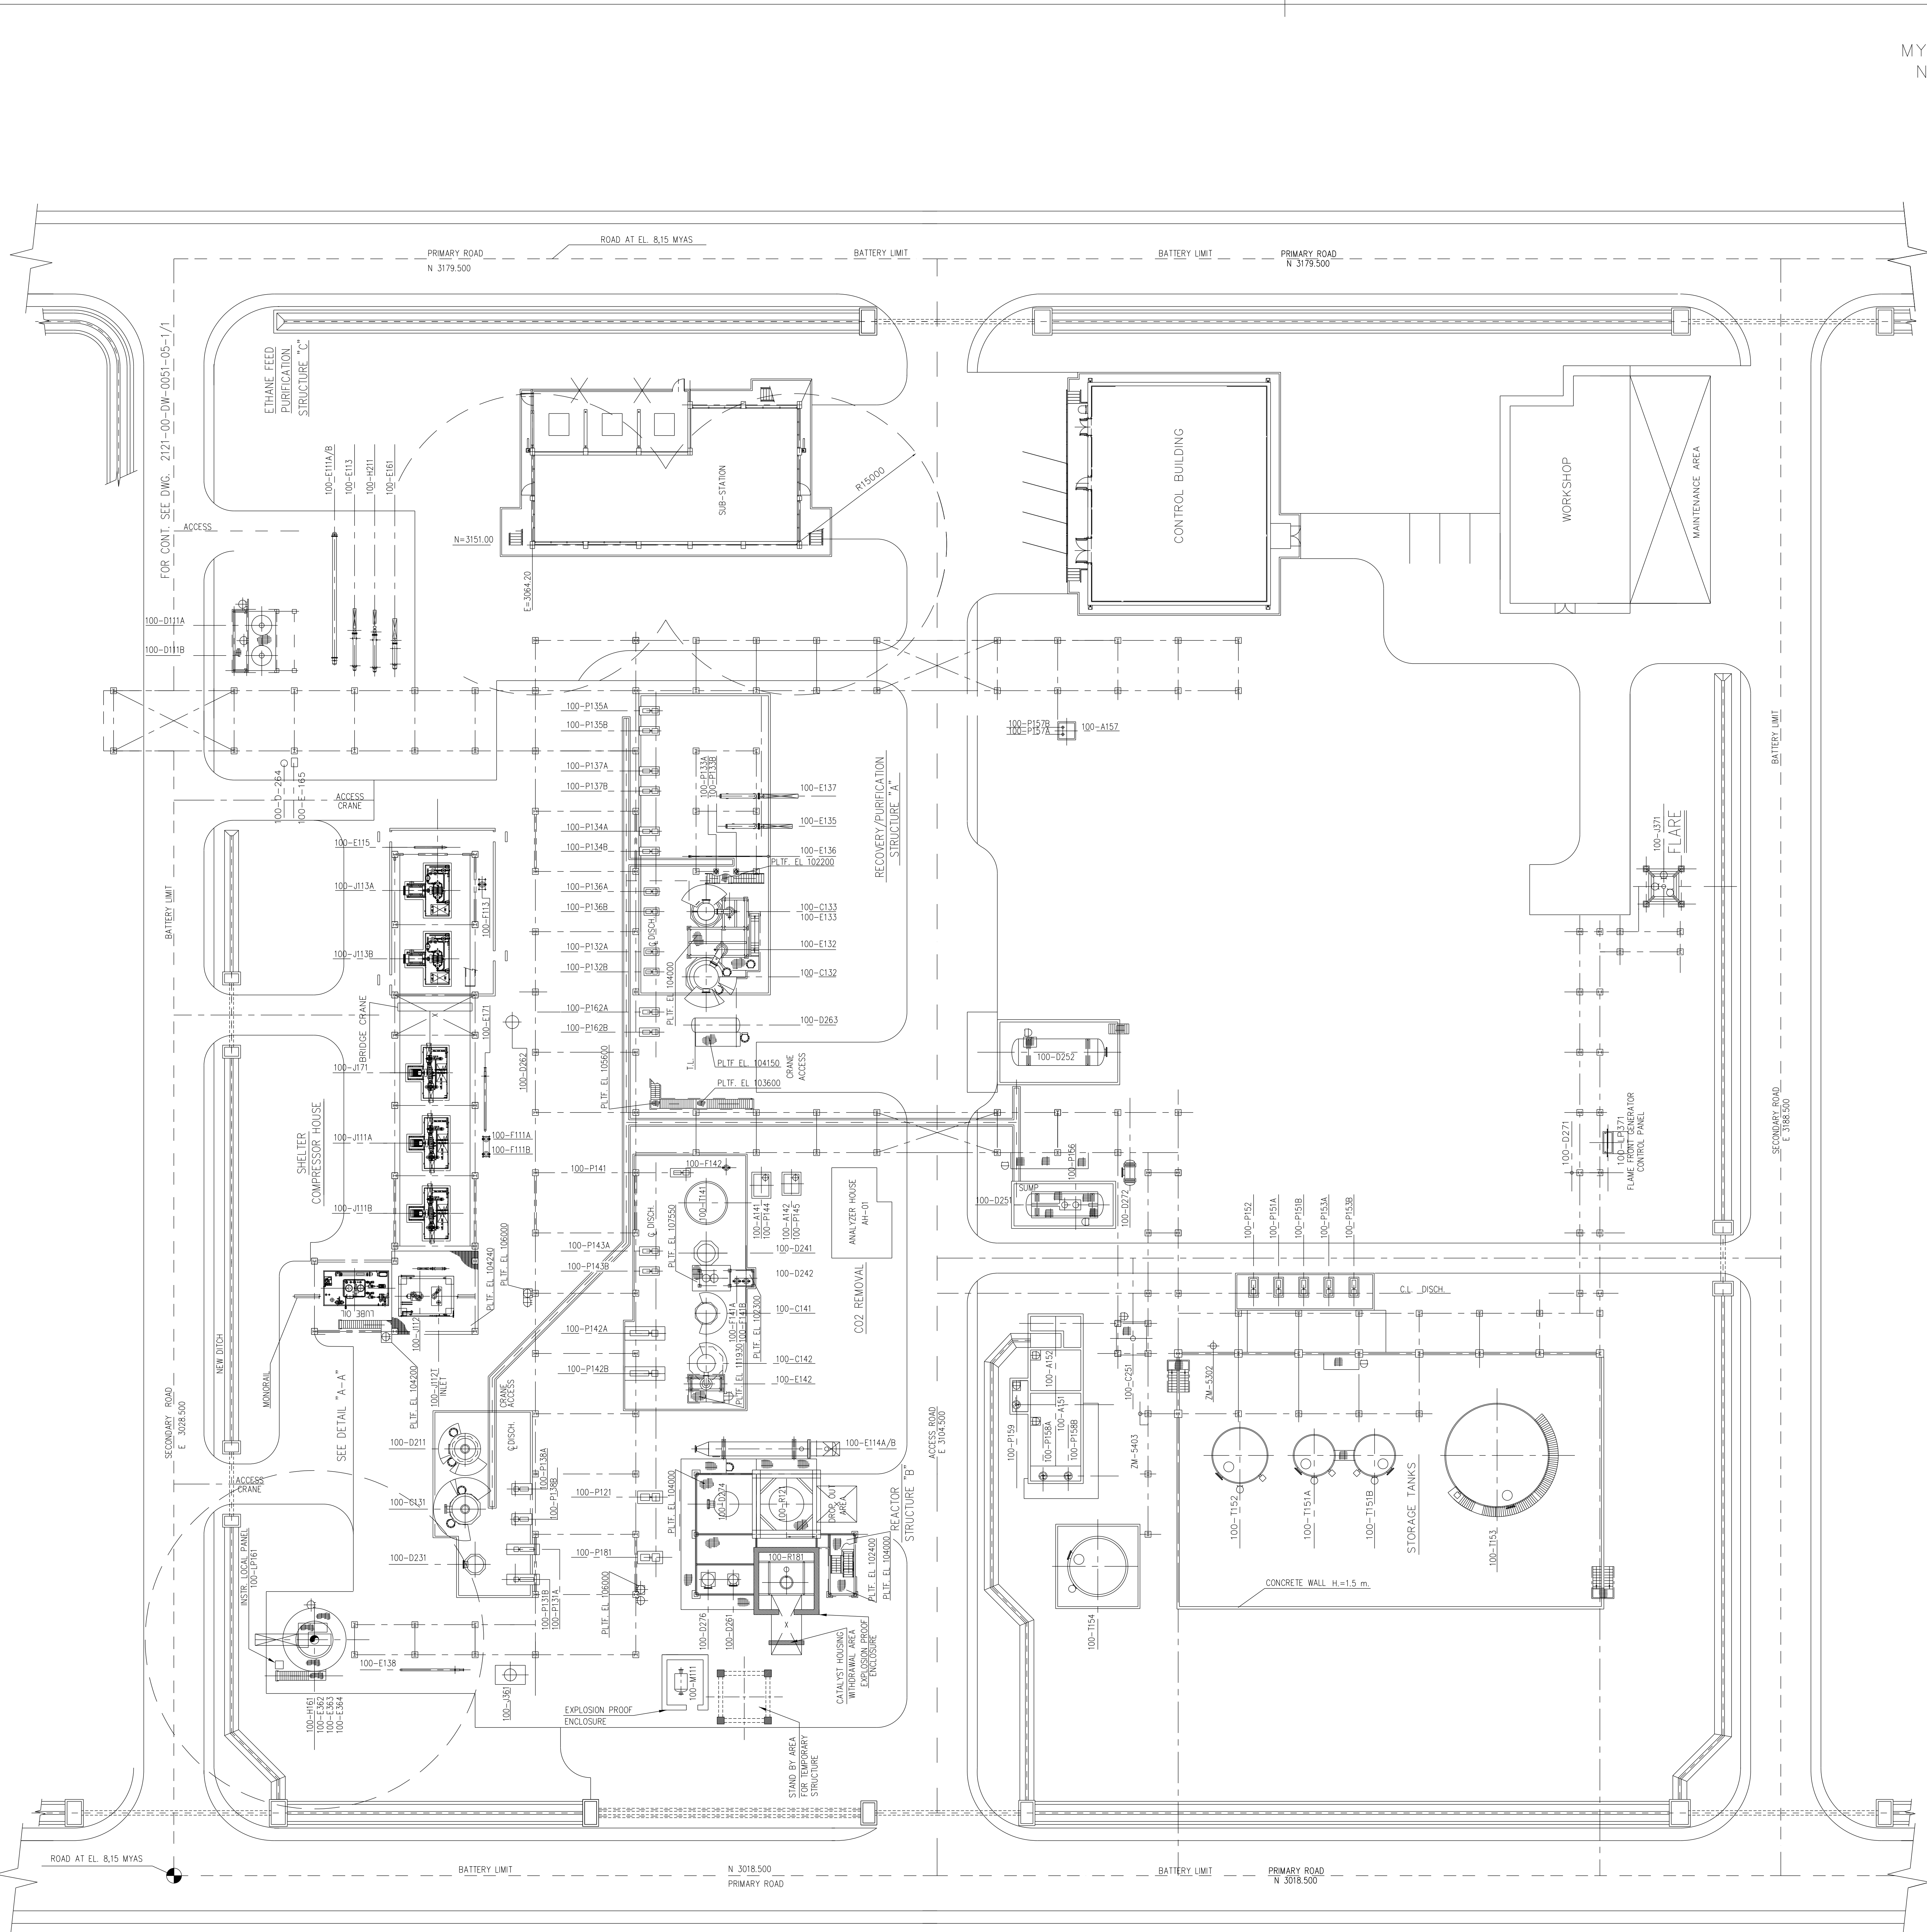

- GENERAL NOTES
1. CO-ORDINATES ARE GIVEN IN METRES RELATIVE TO SITE GRID SYSTEM. SITE GRID CO-ORDINATES E 3000.000; N 3000.000 ARE EQUAL TO E 25628.909; N 37720.922 M.Y.A.S GRID.
 2. ELEVATIONS ARE GIVEN IN METRES RELATIVE TO SITE DATUM. PLANT ELEVATION 100.000 (HIGH POINT OF PAVING) CORRESPONDS TO ELEVATION 8.300 M.Y.A.S

AS BUILT

22854-DR-000-LE-001		OVERALL SITE PLAN	
DRAWING NO.		DESCRIPTION	
		REFERENCE	DRAWINGS

5	10-04-05	FINAL AS BUILT	ROBELINO	CORAZZA	CORAZZA	BAROIO
4	23-03-05	AS BUILT	KAMAL	SALUCCI	CORAZZA	G.BAROIO
3	15-10-03	UPDATED ACCORDING REV.3 TANKAGE AND PROCESS AREAS	I052	A.B.	V.d.S.	B.M.
2	15-06-03	UPDATED ACCORDING REV.2 TANKAGE AND PROCESS AREAS	I052	A.B.	V.d.S.	B.M.
1	25-02-03	UPDATED ACCORDING REV.1 TANKAGE AND PROCESS AREAS	I052	A.B.	V.d.S.	B.M.
0	11-12-02	ISSUED FOR CONSTRUCTION	I052	A.B.	V.d.S.	B.M.
C	19-09-02	ISSUED FOR BASIC DESIGN (UPDATED AS OF 19-09-02)	M.CANNI	A.BATTISTINI	V.DI SANTO	B.MOSCHERA
B	04-06-02	ISSUED FOR BASIC DESIGN INCLUDED SABIC COMMENTS	A.PELLEGRINI	A.BATTISTINI	V.DI SANTO	B.MOSCHERA
A	03-05-02	ISSUED FOR APPROVAL	A.PELLEGRINI	A.BATTISTINI	V.DI SANTO	B.MOSCHERA
REV.	DATE	DESCRIPTION	PREPARED	VERIFIED	APPROVED	AUTHORIZED

TECHNIP-COFLEXIP



SABIC ACETIC ACID PLANT
IBN RUSHO SITE - YANBU - KINGDOM OF SAUDI ARABIA

XXXX	GENERAL PLOT PLAN					
Status						
CAD model						
1:250	2121	00	DW	0051 - 01	1 of 1	5
Scale	Project	Unit	Type of doc.	Code & progressive	Sheet	Rev.